


LOCATION MAP:

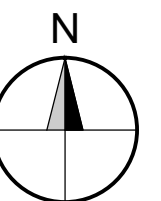

7 TEQUILAS, INC.
5586 OLD HIGHWAY 5
WOODSTOCK, GEORGIA
CONTACT: TRACY GARCIA
PHONE NUMBER: 770.870.0170
EMAIL: TRACYGARCIA.7T@GMAIL.COM

7 TEQUILAS RESTAURANT
5586 OLD HIGHWAY 5 (OLD GEORGIA HIGHWAY 5 AND PAYNE ROAD)
WOODSTOCK, GEORGIA 30188

PREPARED FOR INNOVATIVE CONTRACTING SOLUTIONS
CONSTRUCTION COORDINATION DRAWINGS
5605 GLENDRIIDGE DR. NE
SUITE 345 ATLANTA, GEORGIA 30342

[illegible]

Sheet Name: COVER	
Proj #: 211201	Issue Date: 03-14-2022
Sheet No.: G001	
Drawn By: KC	Checked By: KC/SA

CODE INFORMATION					PLUMBING FIXTURE CALCULATIONS					PROJECT DESCRIPTION					
<div>APPLICABLE CODES – STATE OF GEORGIA</div> <div><div><div><div>INTERNATIONAL BUILDING CODE: 2012 EDITION WITH GEORGIA AMENDMENTS (2020).</div><div>INTERNATIONAL FIRE CODE: 2012 EDITION WITH GEORGIA AMENDMENTS (2020).</div><div>INTERNATIONAL PLUMBING CODE: 2012 EDITION WITH GEORGIA AMENDMENTS (2020).</div><div>INTERNATIONAL MECHANICAL CODE: 2012 EDITION WITH GEORGIA AMENDMENTS (2020).</div><div>INTERNATIONAL FUEL GAS CODE: 2012 EDITION WITH GEORGIA AMENDMENTS (2020).</div><div>INTERNATIONAL ENERGY CONSERVATION CODE: 2009 EDITION WITH GEORGIA SUPPLEMENTS AND AMENDMENTS (2018).</div><div>INTERNATIONAL SWIMMING POOL AND SPA CODE: 2012 EDITION WITH GEORGIA AMENDMENTS (2020).</div><div>NATIONAL ELECTRIC CODE: 2017 EDITION WITH NO GEORGIA AMENDMENTS.</div><div>NFPA 101 LIFE SAFETY CODE: 2012 EDITION WITH STATE AMENDMENTS (2020).</div><div>GEORGIA ACCESSIBILITY CODE 120-3-20 (01-08) / 2010 ADA STANDARDS FOR ACCESSIBLE DESIGN.</div></div><div><div>INTERIOR FLOOR FINISH</div><div>(BC SECTION 804, NFPA 101 [CHECK CHAPTER 7, 10, AND THE THE REQUIREMENTS IN EACH USE GROUP CHAPTER])</div><div>–CRITICAL RADIANCE FLUX:<div>CLASS I OR II, COMPLYING WITH WITH ASTM E84 OR NFPA 253.<div>CLASS 1: 0.45 WATTS/CUBIC CM OR GREATER. CLASS II: 0.22 WATTS/CUBIC CM OR GREATER.</div></div><div>–MINIMUM CRITICAL RADANT FLUX, USE GROUP A-2: CLASS II MIN.</div></div></div></div><div>OCCUPANCY<div><div>IBC:</div><div>USE GROUP A-2.</div></div><div><div>NFPA 101:</div><div>USE GROUP NEW ASSEMBLY.</div></div></div><div>TYPE OF CONSTRUCTION<div><div>IBC:</div><div>II-B. (TABLE 601)</div></div><div><div>NFPA 101:</div><div>TYPE II-000. (NFPA 220 TABLES 4.1.1 A4.1.1)</div></div></div><div>BUILDING HEIGHT (BC TABLES 504.3 & 504.4)<div><div>ALLOWABLE:</div><div>2 STORES, 55 FEET. NOT SPRINKLERED.</div></div><div><div>ACTUAL:</div><div>1 STORY, 33'-6". NOT SPRINKLERED.</div></div></div><div>BUILDING AREA (BC TABLE 506.2)<div><div>ALLOWABLE:</div><div>9,500 S.F. NOT SPRINKLERED, PER STORY.</div></div><div><div>ACTUAL:</div><div>5,330 S.F. FIRST FLOOR + 601 S.F. ROOFTOP PATIO. NOT SPRINKLERED, PER STORY.</div></div></div><div>FIRE RESISTANCE RATING BUILDING ELEMENTS (BC TABLES 601 & 602, NFPA 202, NFPA 220 TABLE 4.1.1)<div><div>PRIMARY STRUCTURAL FRAME:</div><div>0 HOURS</div></div><div><div>BEARING WALLS (INTERIOR AND EXTERIOR):</div><div>0 HOURS</div></div><div><div>NON BEARING WALLS AND PARTITIONS (EXTERIOR):</div><div>0 HOURS</div></div><div><div>(BC TABLE 602, NFPA 220 TABLE 4.1.1)</div><div><div>X < 5</div><div>1 HOURS</div></div><div><div>5 <= X < 10</div><div>1 HOURS</div></div><div><div>10 <= X < 30</div><div>0 HOURS</div></div><div><div>X >= 30</div><div>0 HOURS</div></div></div></div><div><div>NONBEARING WALLS AND PARTITIONS (INTERIOR):</div><div>0 HOURS</div></div><div><div>FLOOR CONSTRUCTION:</div><div>0 HOURS</div></div><div><div>ROOF CONSTRUCTION:</div><div>0 HOURS</div></div></div> <div>INTERIOR FINISH REQUIREMENTS</div> <div><div>INTERIOR WALL AND CEILING FINISHES IBC –ASTM E84 OR UL 723 CLASS, NFPA 101 – NFPA 286 OR ASTM E84</div><div>–CLASS A: FLAME SPREAD INDEX 0-25, SMOKE DEVELOPED INDEX 0-450</div><div>–CLASS B: FLAME SPREAD INDEX 26-75, SMOKE DEVELOPED INDEX 0-450</div><div>–CLASS C: FLAME SPREAD INDEX 76-200, SMOKE DEVELOPED INDEX 0-450</div></div> <div><div>INTERIOR WALL AND CEILING FINISH REQUIREMENTS BY OCCUPANCY (BC TABLE 603.13, NFPA 101 [CHECK REQUIREMENTS IN CHAPTER 7, CHAPTER 10, AND EACH USE GROUP CHAPTER])</div><div><div>USE GROUP XX, SPRINKLERED</div><div>–INTERIOR EXIT STAIRWAYS, RAMPS, AND EXIT PASSAGEWAYS: CLASS A MIN.</div><div>–CORRIDORS AND ENCLOSURE FOR EXIT ACCESS STAIRWAYS AND RAMPS: CLASS A MIN.</div><div>–ROOMS AND ENCLOSED SPACES: CLASS B MIN.</div></div></div>											<div>NEW, FREE STANDING RESTAURANT.</div> <div><div>NOTES:</div><div>1. NO FIRE SUPPRESSION IS INCLUDED IN THE BUILDING. NOT REQUIRED BY CODE.</div><div>2. BUILDING FIRE ALARM IS REQUIRED. CONTRACTOR SHALL CONTRACT DIRECTLY WITH FIRE ALARM CONTRACTOR TO PRODUCE FIRE ALARM DRAWINGS FOR REVIEW AND APPROVAL BY THE AUTHORITY HAVING JURISDICTION.</div><div>3. CONTRACTOR SHALL COORDINATE WITH OWNER'S DATA/AV/TELECOM VENDORS. PROVIDE ALL REQUIRED CONDUITS AND BOXES.</div><div>4. CONTRACTOR SHALL COORDINATE WITH OWNER'S LIGHT FIXTURE VENDOR FOR ALL LIGHT FIXTURES NOT IN THEIR SCOPE OF WORK. PROVIDE ALL REQUIRED CONDUITS AND BOXES. ALL OWNER SUPPLIED LIGHT FIXTURES SHALL BE UL LISTED AND SHALL MEET THE REQUIREMENTS OF THE ENERGY CODE. LED LIGHTS ARE STRONGLY RECOMMENDED.</div></div>				
										ALTERNATES					
										<div>ALTERNATE NO 1: QUICKBRICK BY OLDCASTLE: IN LIEU OF THE SPECIFIED CHEROKEE BRICK (NOMINAL 4"x4"x12"), PROVIDE A PRICING ALTERNATE TO USE QUICK BRICK BY OLDCASTLE, EARTHTONE BLEND (NOMINAL 4"x4"x16"). HOLLOW QUICKBRICK UNITS ARE ACCEPTABLE AT LOCATIONS WHERE THE HOLLOW SECTIONS WILL NOTE BE VISIBLE.</div> <div>ALTERNATE NO 2: QUICKBRICK BY OLDCASTLE: IN LIEU OF THE SPECIFIED CHEROKEE BRICK (NOMINAL 4"x4"x12"), PROVIDE A PRICING ALTERNATE TO USE QUICK BRICK BY OLDCASTLE, GOLDEN WHEAT (NOMINAL 4"x4"x16"). HOLLOW QUICKBRICK UNITS ARE ACCEPTABLE AT LOCATIONS WHERE THE HOLLOW SECTIONS WILL NOTE BE VISIBLE.</div>					
SYMBOLS					MASTER DOCUMENT PHASE LIST					MASTER REVISION LIST					
<div>LEGEND</div> <div>GENERAL SHEET NOTES/KEY NOTES/LEGEND HEADER</div> <div><div><div><div><div>1</div><div>A100</div><div>1/8"=1'-0"</div></div><div>DRAWING TITLE</div><div>DRAWING TITLE AND NORTH ARROW</div></div><div><div><div><div>1</div><div>A200</div><div>1/2"=1'-0"</div></div><div>SINGLE ELEVATION MARK</div></div><div><div><div><div>1</div><div>A300</div><div>1/4"=1'-0"</div></div><div>SMALL SECTION MARK</div></div><div><div><div><div>1</div><div>A300</div><div>1/4"=1'-0"</div></div><div>LARGE SECTION MARK</div></div><div><div><div><div>1</div><div>A400</div><div>1/4"=1'-0"</div></div><div>DETAIL BUBBLE</div></div><div><div><div><div>1</div><div>A400</div><div>1/4"=1'-0"</div></div><div>REVISION CLOUD AND TRIANGLE</div></div><div><div><div><div>1</div><div>A400</div><div>1/4"=1'-0"</div></div><div>ELEVATION DATUM MARKER</div></div><div><div><div><div>1</div><div>A400</div><div>1/4"=1'-0"</div></div><div>BREAK LINE</div></div><div><div><div><div>1</div><div>A400</div><div>1/4"=1'-0"</div></div><div>DOOR TAG</div></div><div><div><div><div>1</div><div>A400</div><div>1/4"=1'-0"</div></div><div>WALL TAG</div></div><div><div><div><div>1</div><div>A400</div><div>1/4"=1'-0"</div></div><div>ROOM FINISH TAG</div></div><div><div><div><div>1</div><div>A400</div><div>1/4"=1'-0"</div></div><div>KEYNOTE 1-HEXAGONAL (PRIMARY KEYNOTE)</div></div><div><div><div><div>1</div><div>A400</div><div>1/4"=1'-0"</div></div><div>KEYNOTE 4-ROUND</div></div><div><div><div><div>1</div><div>A400</div><div>1/4"=1'-0"</div></div><div>DIMENSION WITH TICK MARKS</div></div></div><div><div><div><div>1</div><div>A5	ISSUED FOR PERMIT	03-14-2022
6	ISSUED FOR PERMIT	03-14-2022
7	ISSUED FOR PERMIT	03-14-2022
8	ISSUED FOR PERMIT	03-14-2022
9	ISSUED FOR PERMIT	03-14-2022
10	ISSUED FOR PERMIT	03-14-2022

Sheet No.:	211201	Issue Date:	03-14-2022
Drawn By:	KC	Checked By:	KC/SA

G010


GENERAL SHEET NOTES

- NOT ALL ITEMS MAY BE USED.
- THE ITEMS SHOWN IN THE ACCESSIBILITY STANDARD SHEETS ARE TO CONVEY THE MINIMUM CRITICAL INFORMATION REQUIRED FOR THE PROJECT. THE CONTRACTOR SHALL COMPLY WITH THE REQUIREMENTS INDICATED HERE, AND WITH ALL FEDERAL AND LOCAL ACCESSIBILITY STANDARDS AND REQUIREMENTS.
- THE MINIMUM CLEAR WIDTH OF AN ACCESSIBLE ROUTE, DOORS, AND WALL OPENINGS SHALL NOT BE LESS THAN SHOWN HERE, AND SHALL NOT BE LESS THAN THE CLEAR WIDTH REQUIRED BY LIFE SAFETY FOR EGRESS. WHICHEVER CLEAR WIDTH IS GREATER SHALL APPLY.
- ALL FLOOR SURFACES SHALL BE SLIP-RESISTANT.
- ALL DIMENSIONS ARE TAKEN FROM THE FINISH FACE OF WALL. THIS SHALL INCLUDE PANELING, TILE, AND OTHER FINISHES. CONTRACTOR SHALL VERIFY THE MINIMUM REQUIRED CLEARANCES ARE MAINTAINED, ESPECIALLY AT WALKING SURFACES, DOOR CLEARANCES, PLUMBING FIXTURES, TOILET STALLS, AND SHOWER STALLS.

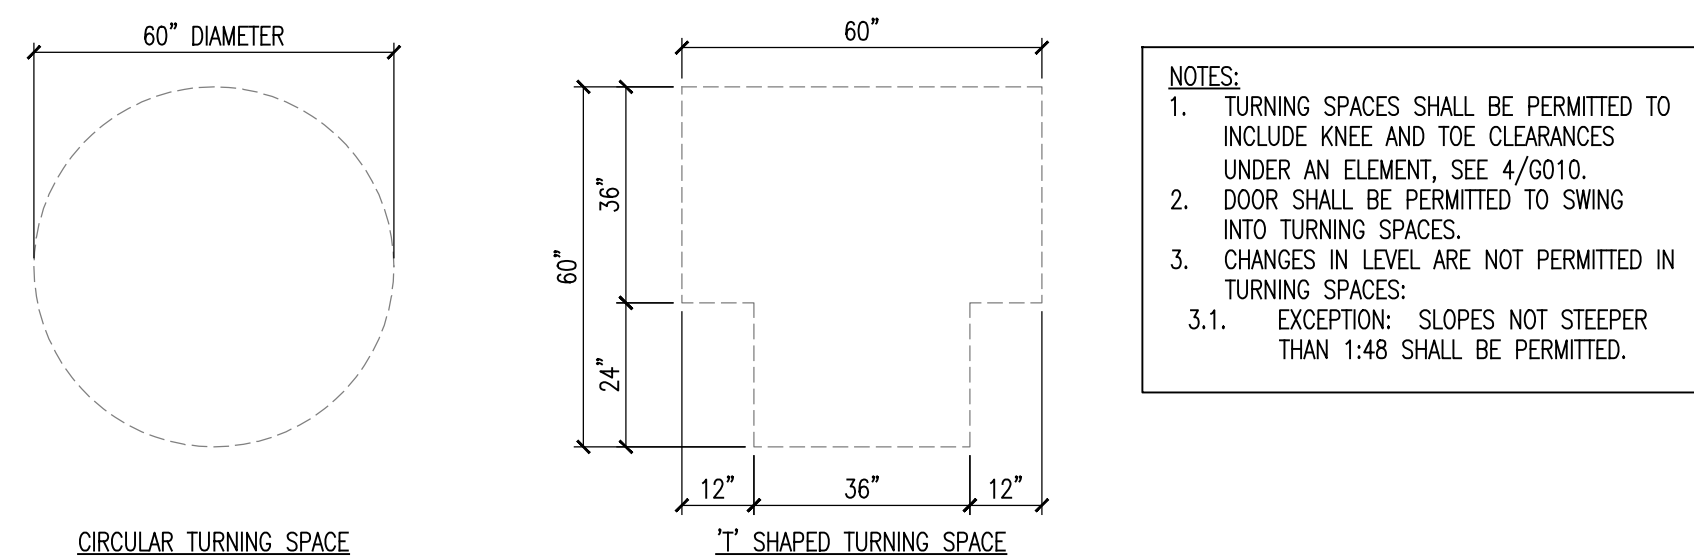


TURNING SPACE

G010 3/8"=1'-0"

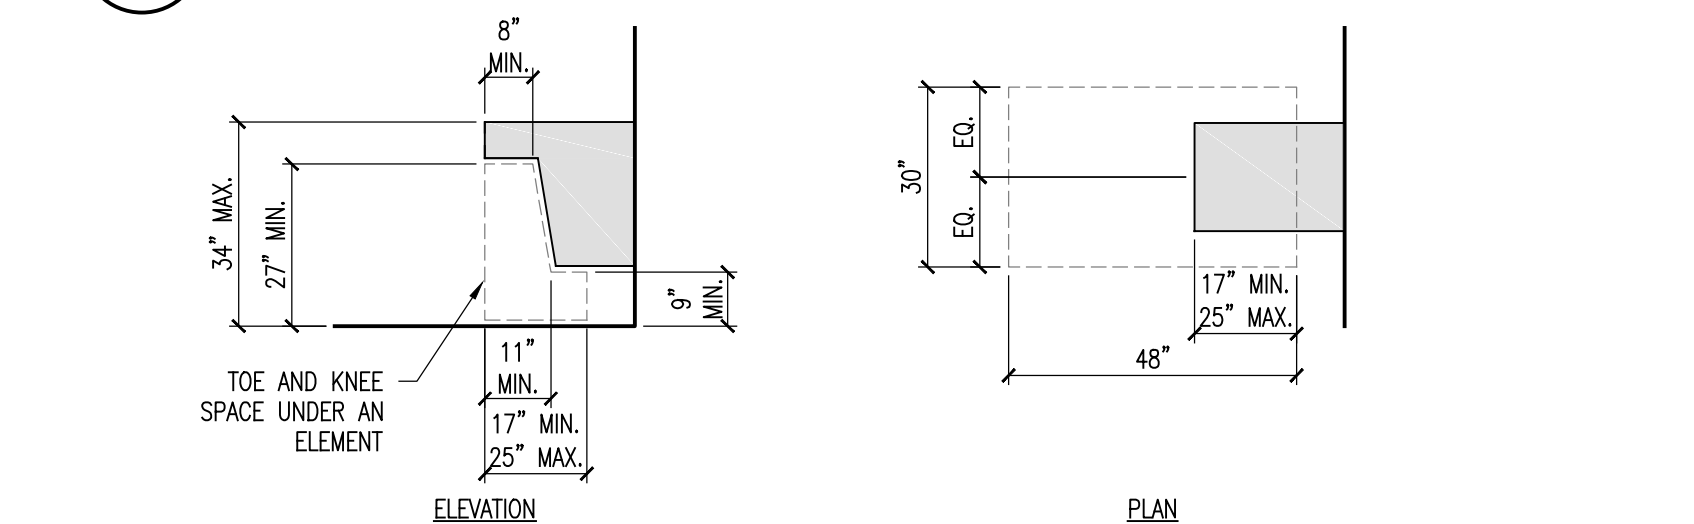


BUILDING BLOCKS - TOE AND KNEE CLEARANCE REQUIREMENTS

G010 3/8"=1'-0"

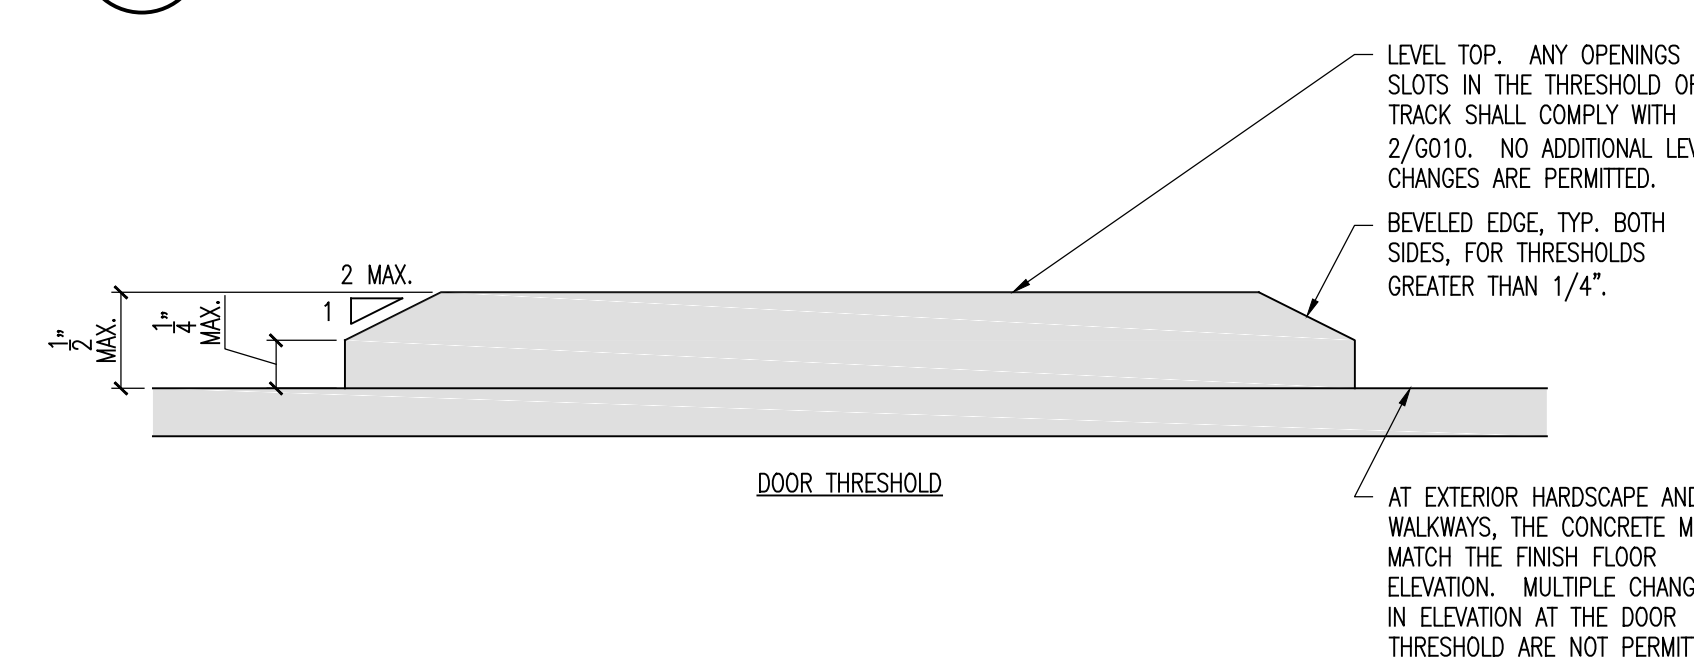


BUILDING BLOCKS - CHANGES IN LEVEL REQUIREMENTS

G010 1'-0"=1'-0"

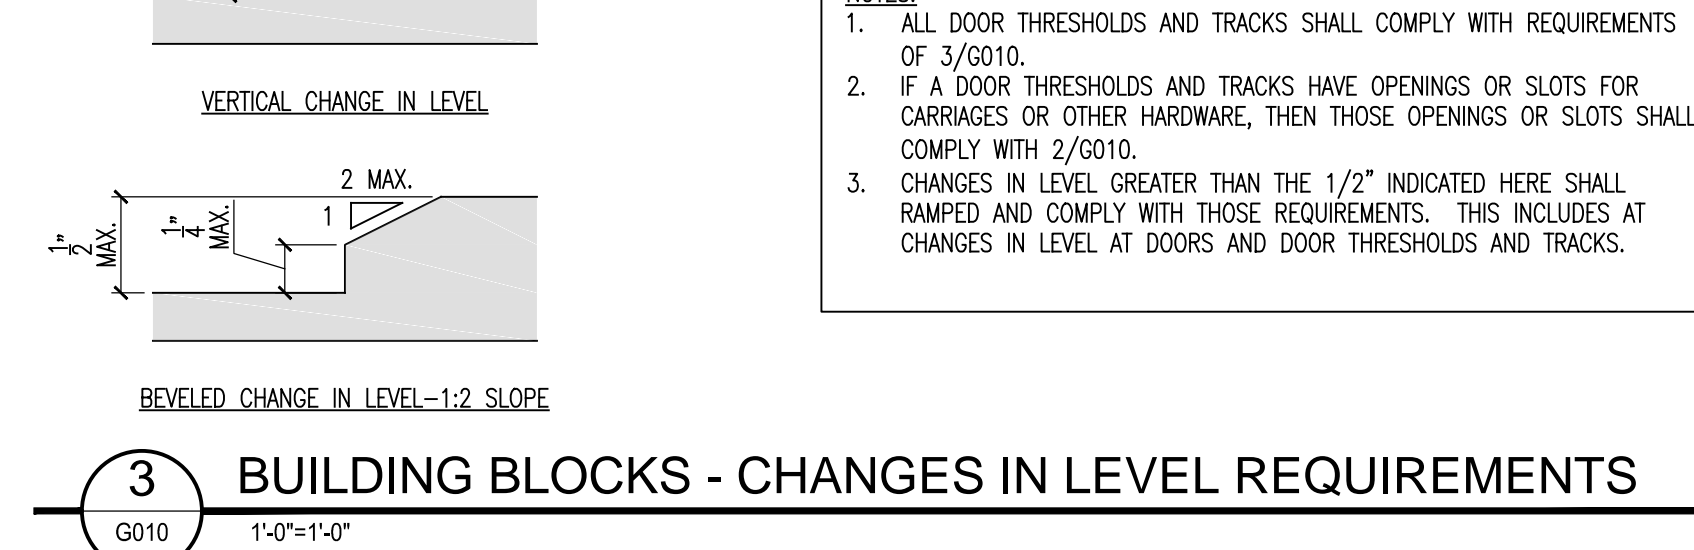


BUILDING BLOCKS - OPENINGS IN FLOOR OR GROUND SURFACES

G010 1'-0"=1'-0"

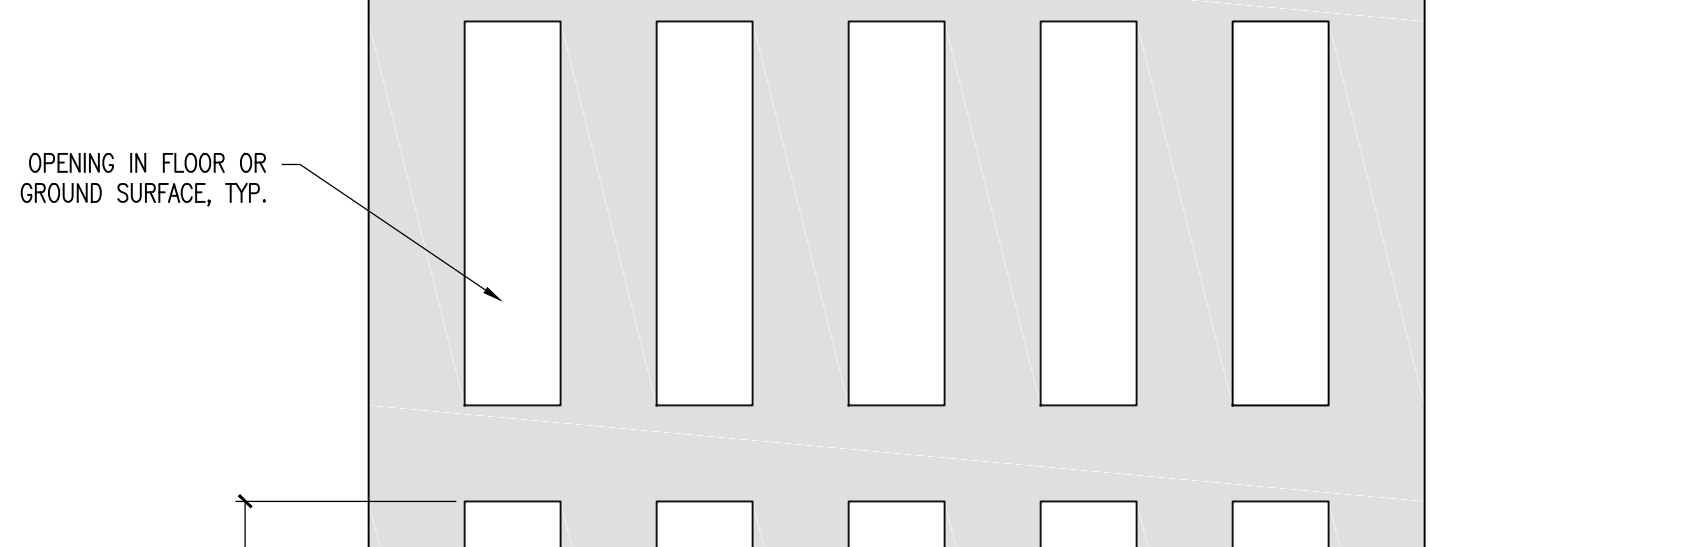


BUILDING BLOCKS - PROTRUDING OBJECTS

G010 3/8"=1'-0"

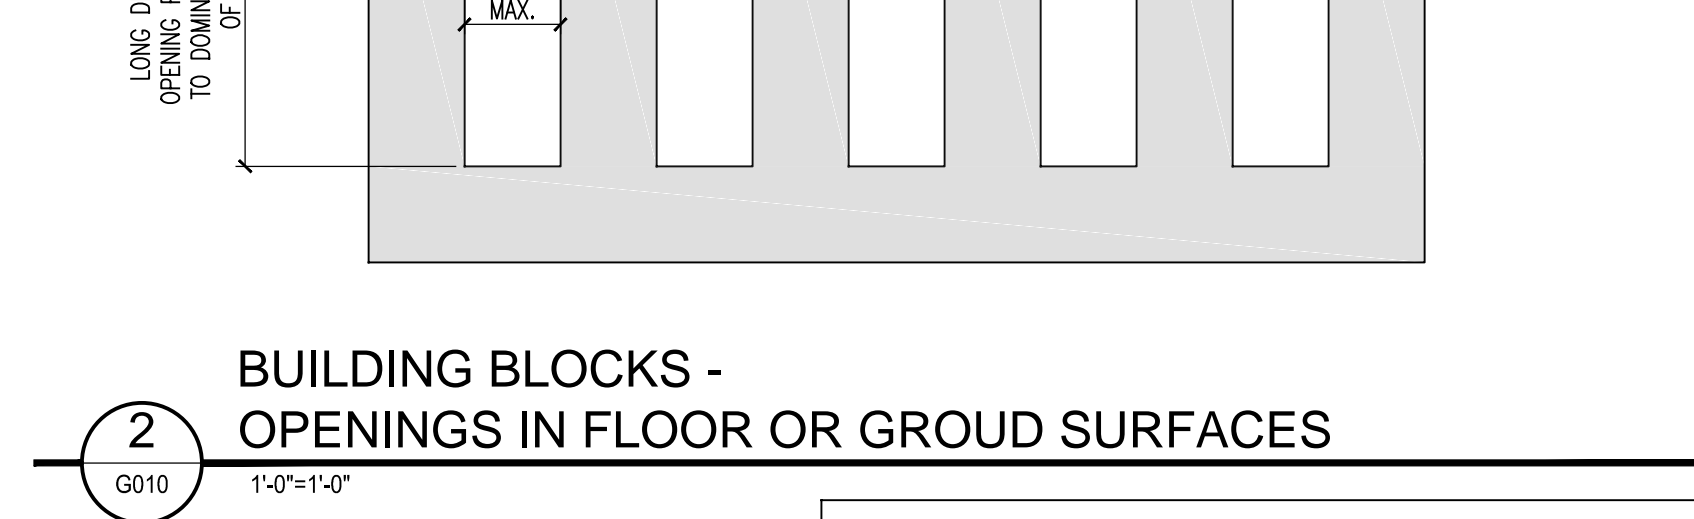

BUILDING BLOCKS - MINIMUM MANEUVERING CLEARANCE REQUIREMENTS

G010 3/8"=1'-0"

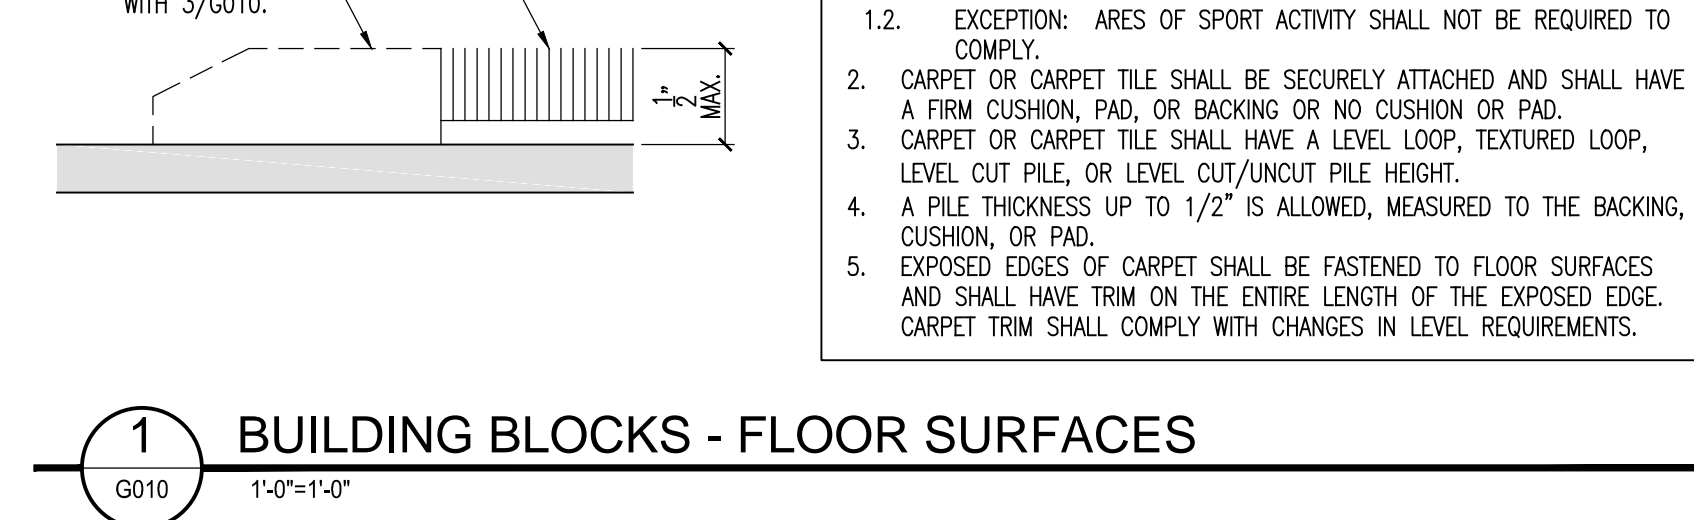

BUILDING BLOCKS - FLOOR SURFACES

G010 1'-0"=1'-0"

CHILDREN'S REACH RANGES

FORWARD OR SIDE REACH	AGES 3 AND 4	AGES 5 THROUGH 8	AGES 9 THROUGH 12
HIGH (MAX.)	36"	40"	44"
LOW (MIN.)	20"	18"	16"



THIS TABLE PROVIDES GUIDANCE ON REACH RANGES FOR CHILDREN ACCORDING TO AGE, WHERE BUILDING ELEMENTS SUCH AS COAT HOOKS, LOCKERS, OR OPERABLE PARTS ARE DESIGNED FOR USE PRIMARILY BY CHILDREN. THESE DIMENSIONS APPLY TO EITHER FORWARD OR SIDE REACHES. ACCESSIBLE ELEMENTS AND OPERABLE PARTS DESIGNED FOR ADULT USE OR CHILDREN OVER AGE 12 CAN BE LOCATED OUTSIDE OF THE CHILDREN'S REACH RANGES, BUT MUST BE WITHIN THE ADULT REACH RANGES INDICATED BELOW.

OPERABLE PARTS NOTES:

- A CLEAR FLOOR SPACE COMPLYING WITH 6/6010 SHALL BE PROVIDED.
- HEIGHT: OPERABLE PARTS SHALL BE PLACED WITHIN THE REACH RANGES IN 8/6010.
- OPERATION: OPERABLE PARTS SHALL BE OPERABLE WITH ONE HAND AND SHALL NOT REQUIRE TIGHT GRASPING, PINCHING, OR TWISTING OF THE WRIST. THE FORCE REQUIRED TO ACTIVATE OPERABLE PARTS SHALL BE 5 POUNDS MAX.



ELECTRICAL NOTES:

- ELECTRICAL POWER/DATA/TELE RECEPTACLES SHALL BE 15" MIN. ABOVE THE FLOOR OR GRADE TO BOTTOM OF DEVICE. MAINTAIN THE SAME ELEVATION FOR ALL RECEPTACLES UNLESS INDICATED OTHERWISE IN THE DRAWINGS.
- SWITCHES AND CONTROLS FOR LIGHTS, APPLIANCES COOLING, HEATING AND VENTILATING EQUIPMENT SHALL BE 44" MAX. ABOVE THE FLOOR OR GRADE TO TOP OF DEVICE. MAINTAIN THE SAME ELEVATION FOR ALL THE RECEPTACLES UNLESS INDICATED OTHERWISE IN THE DRAWINGS.
- FIRE ALARM INITIATING DEVICES SHALL BE 44" MAX. ABOVE THE FLOOR OR GRADE TO THE TOP OF DEVICE. MAINTAIN THE SAME ELEVATION FOR ALL DEVICES UNLESS INDICATED OTHERWISE IN THE DRAWINGS.

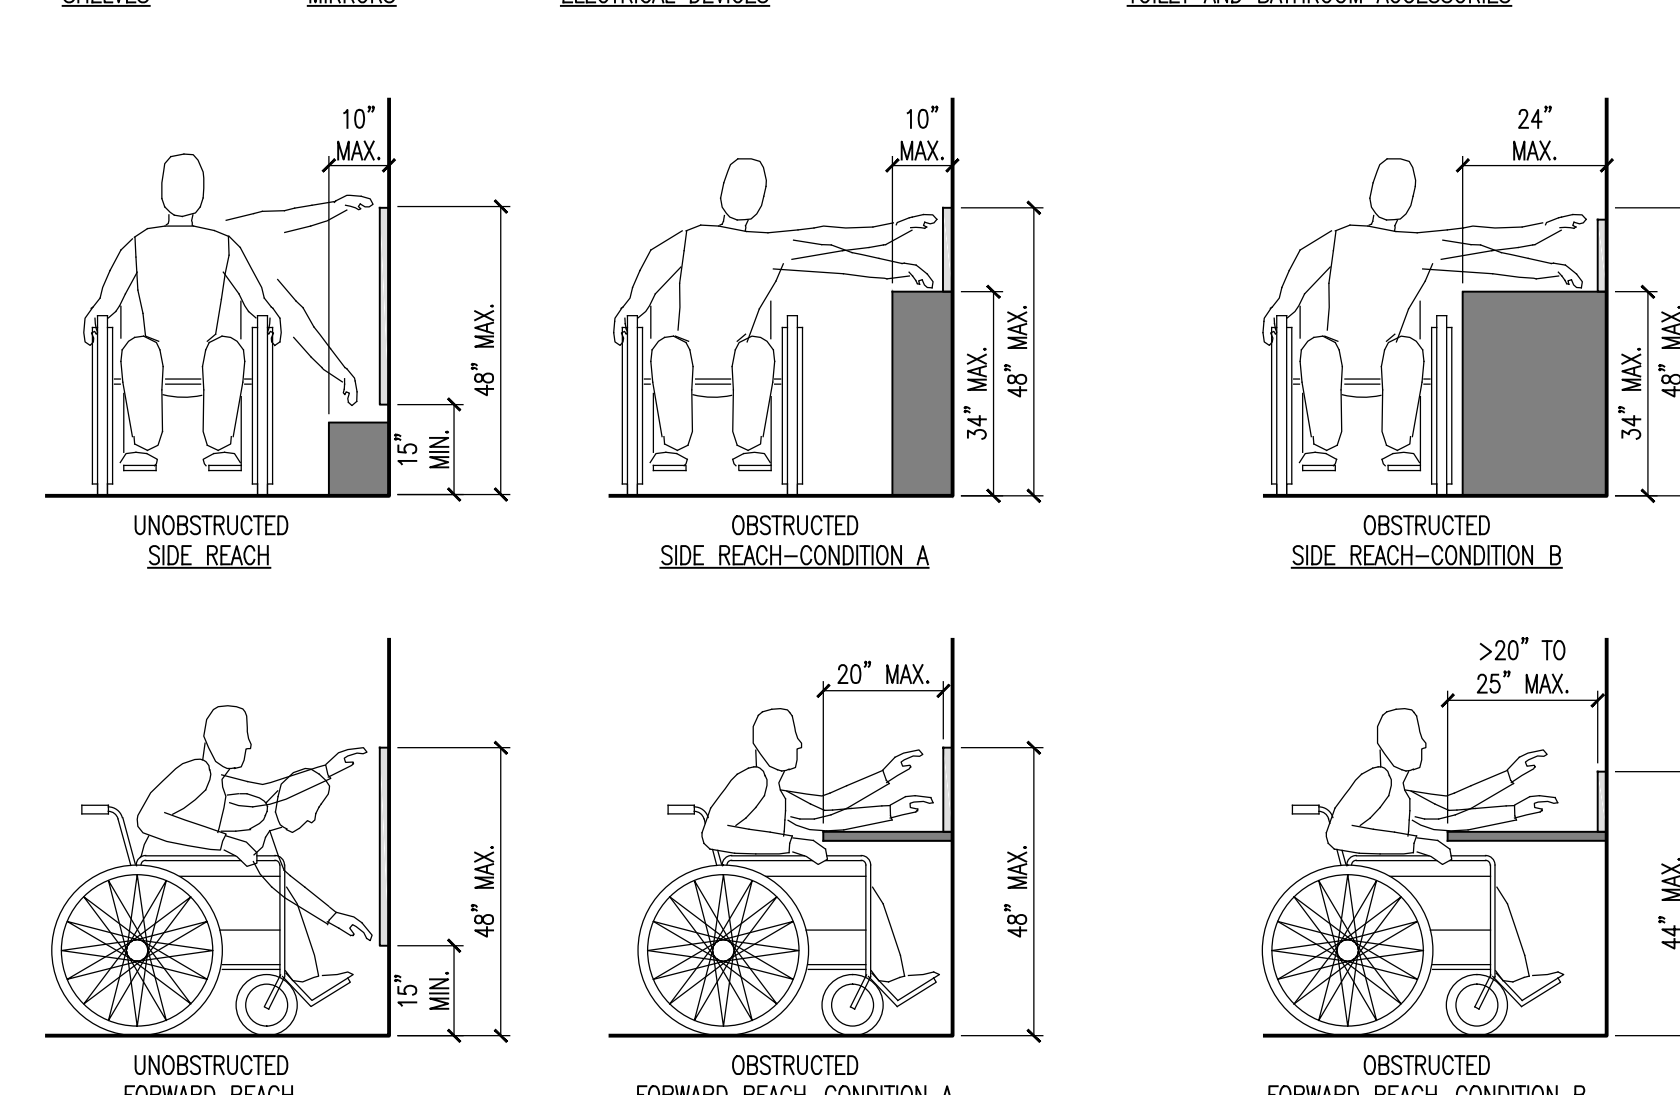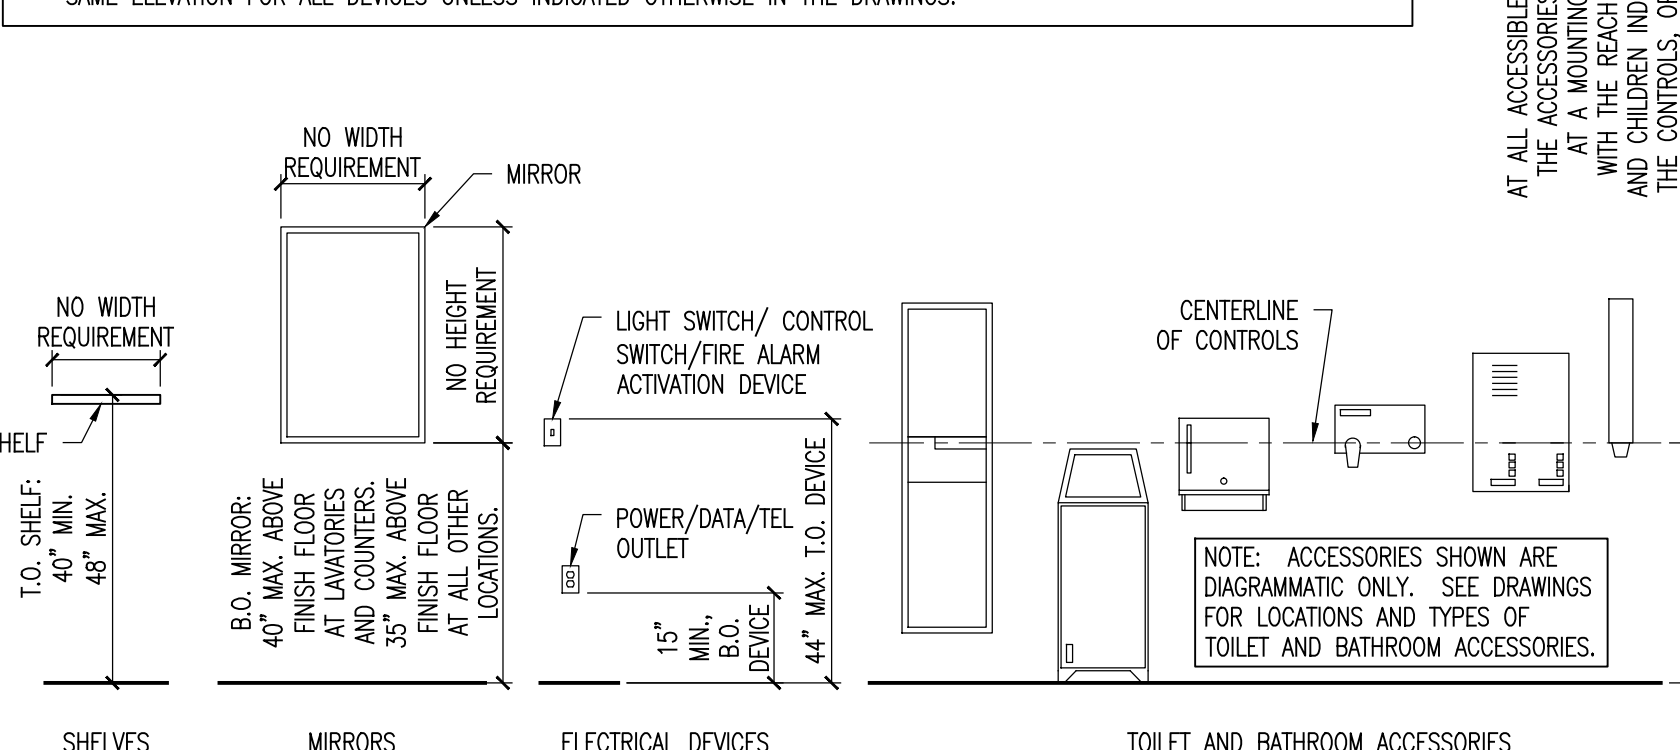


BUILDING BLOCKS - CHILDREN OVER 12 AND ADULT REACH RANGES

G010 3/8"=1'-0"

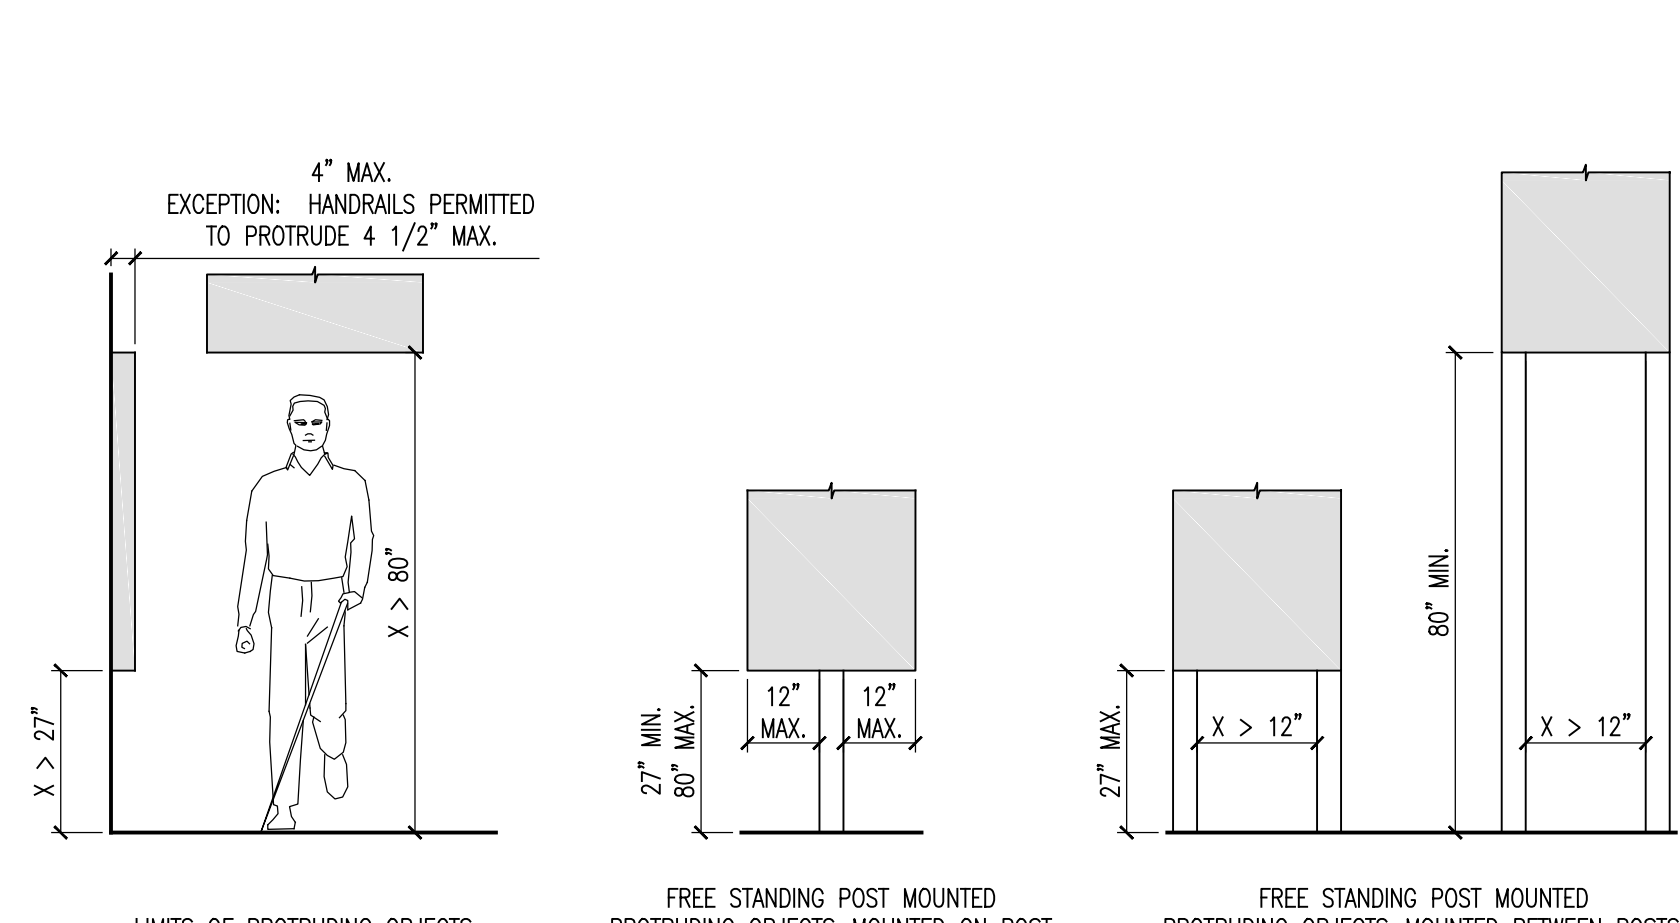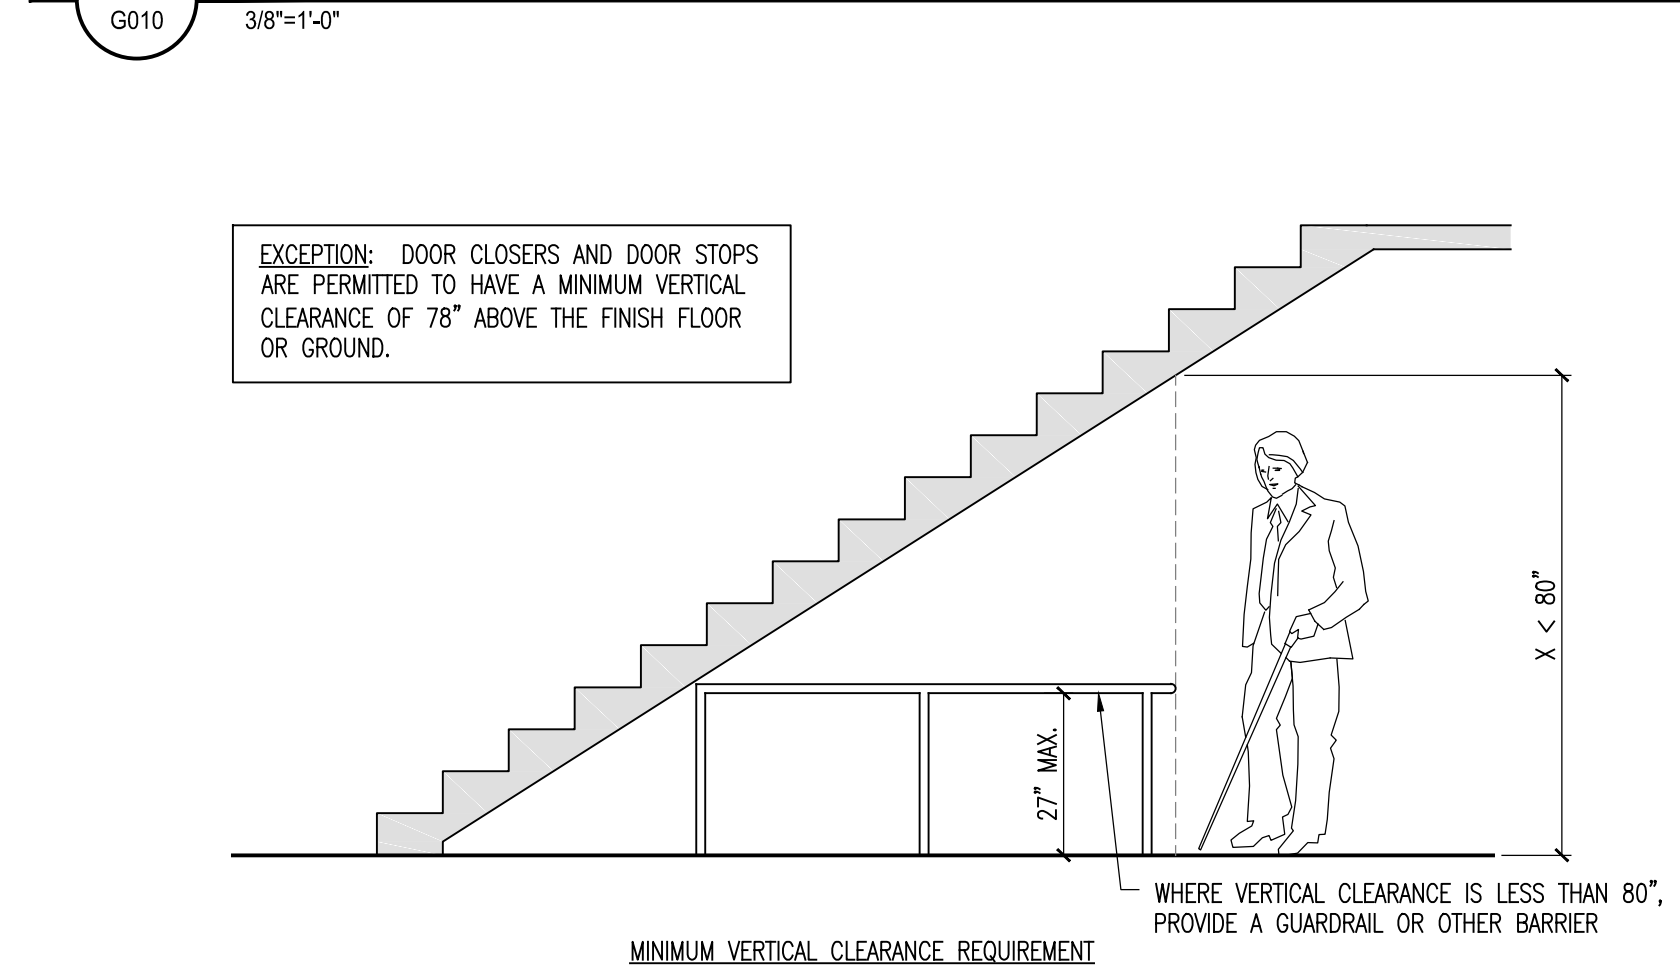


BUILDING BLOCKS - PROTRUDING OBJECTS

G010 3/8"=1'-0"



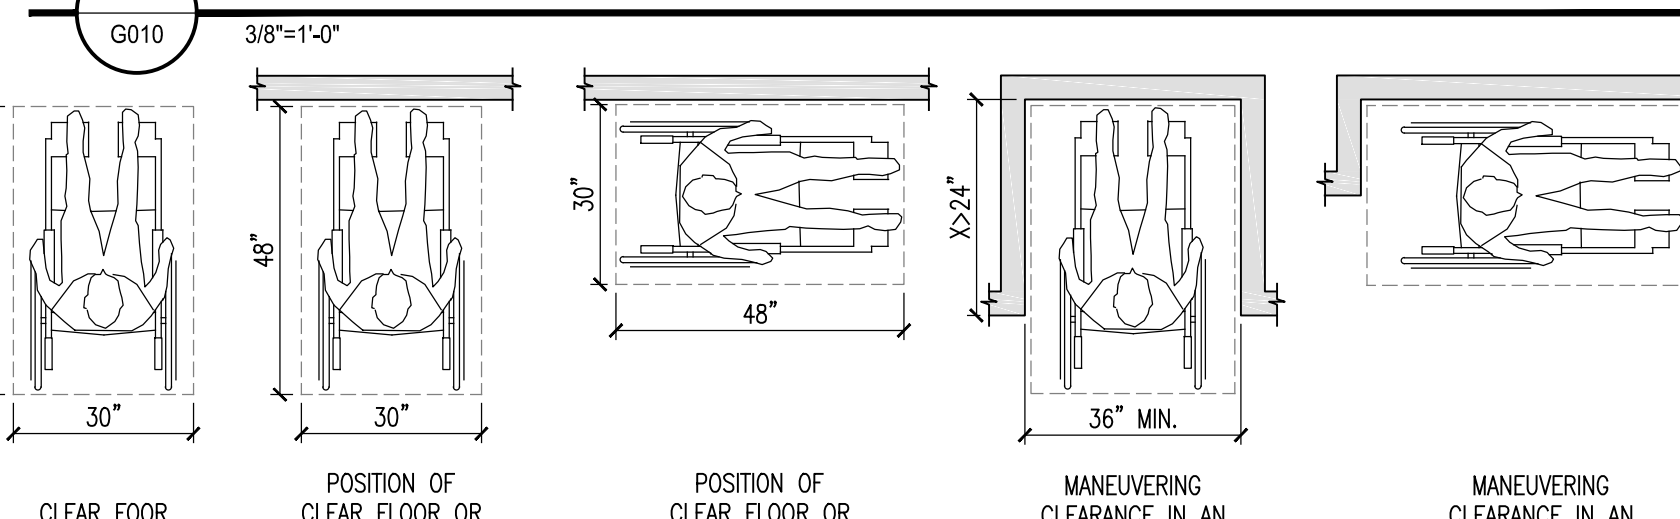


BUILDING BLOCKS - MINIMUM MANEUVERING CLEARANCE REQUIREMENTS

G010 3/8"=1'-0"

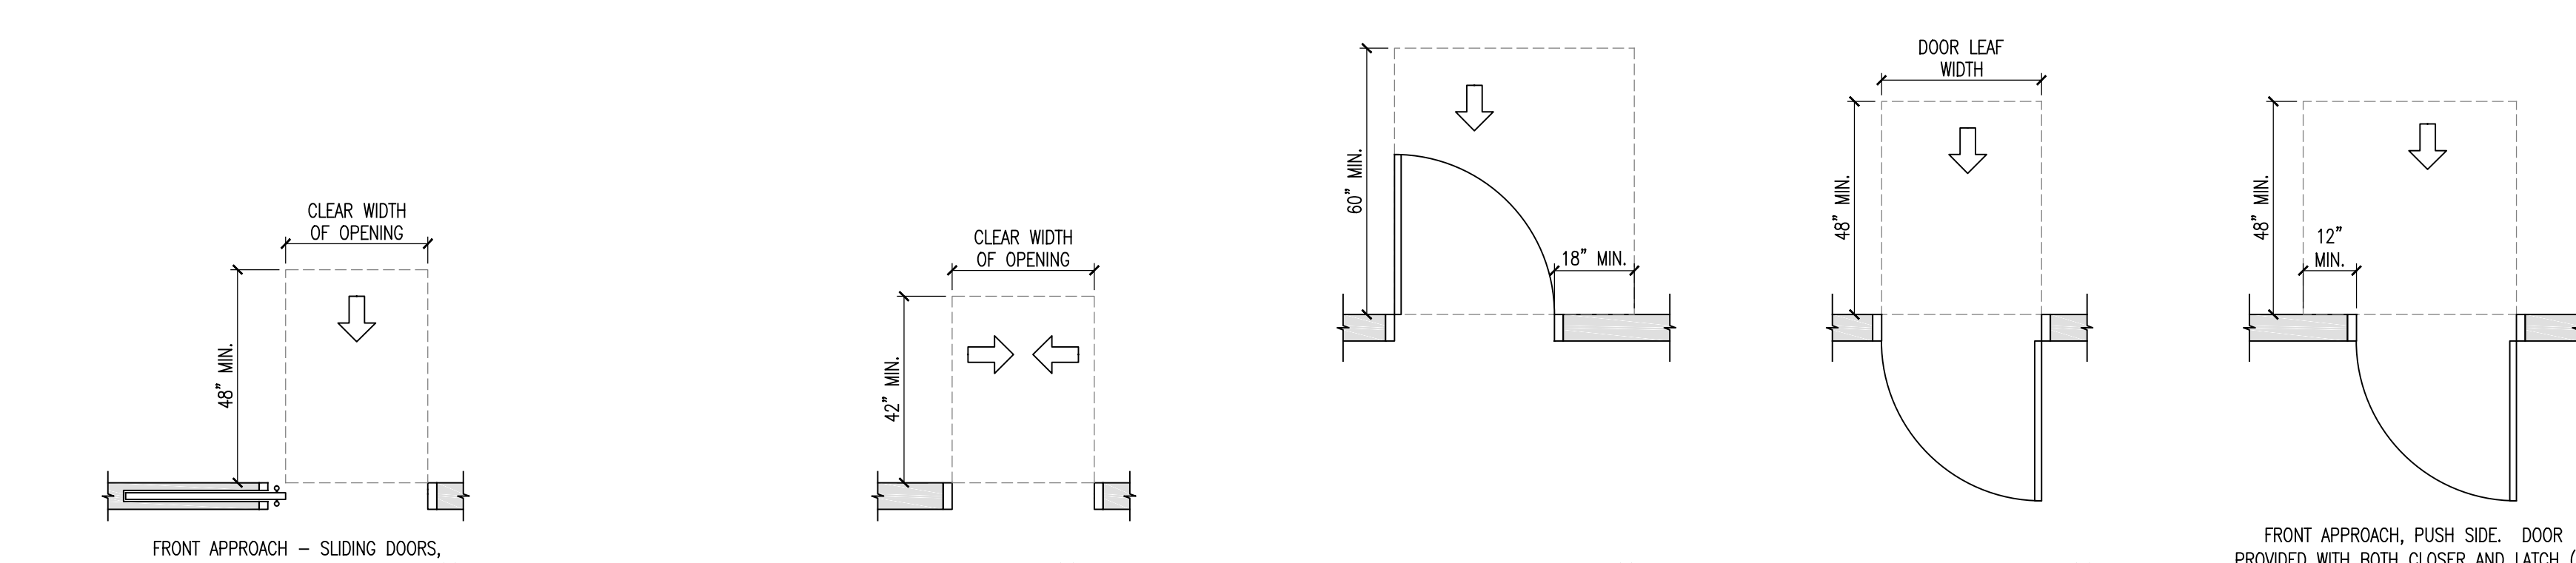



MANEUVERING CLEARANCES AT MANUAL SLIDING DOORS, FOLDING DOORS, AND WALL OPENINGS

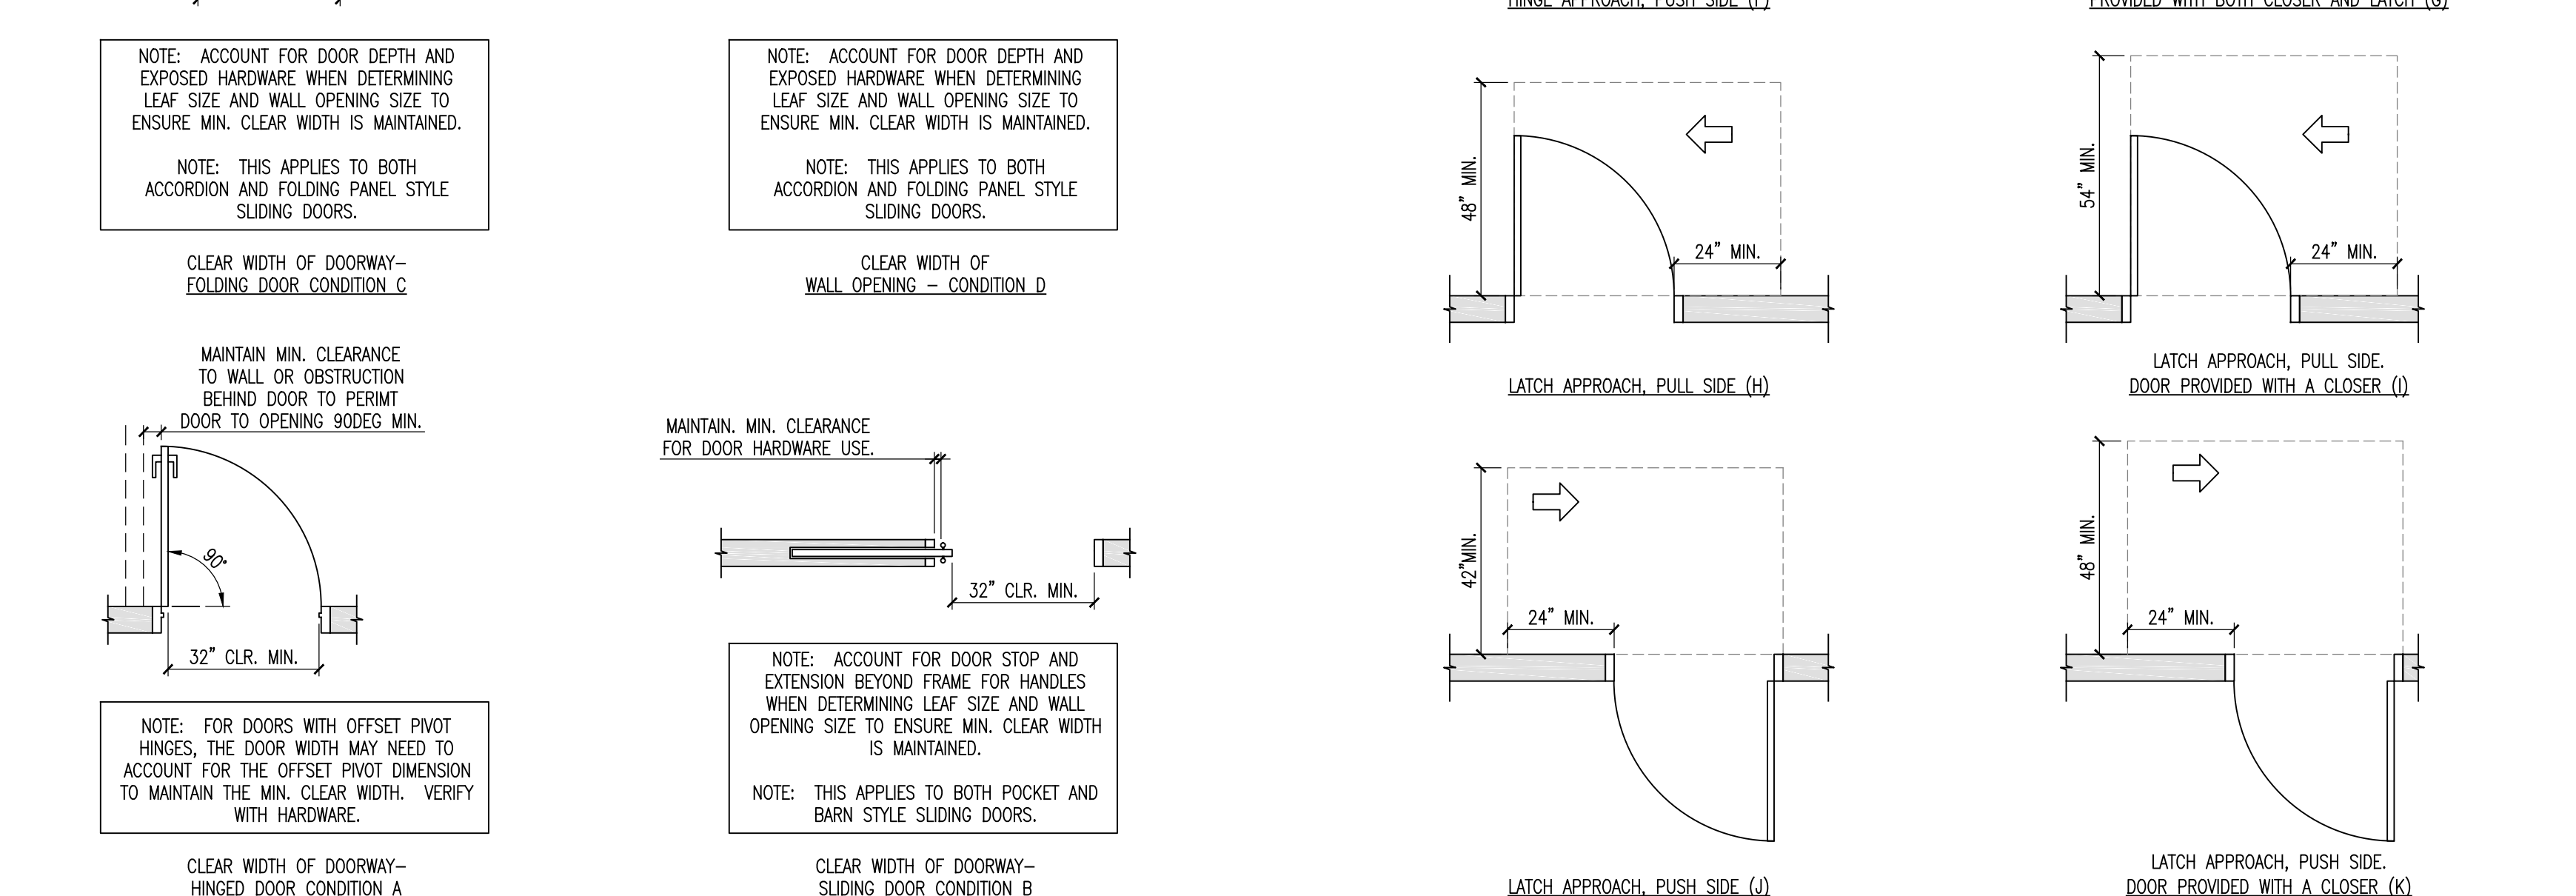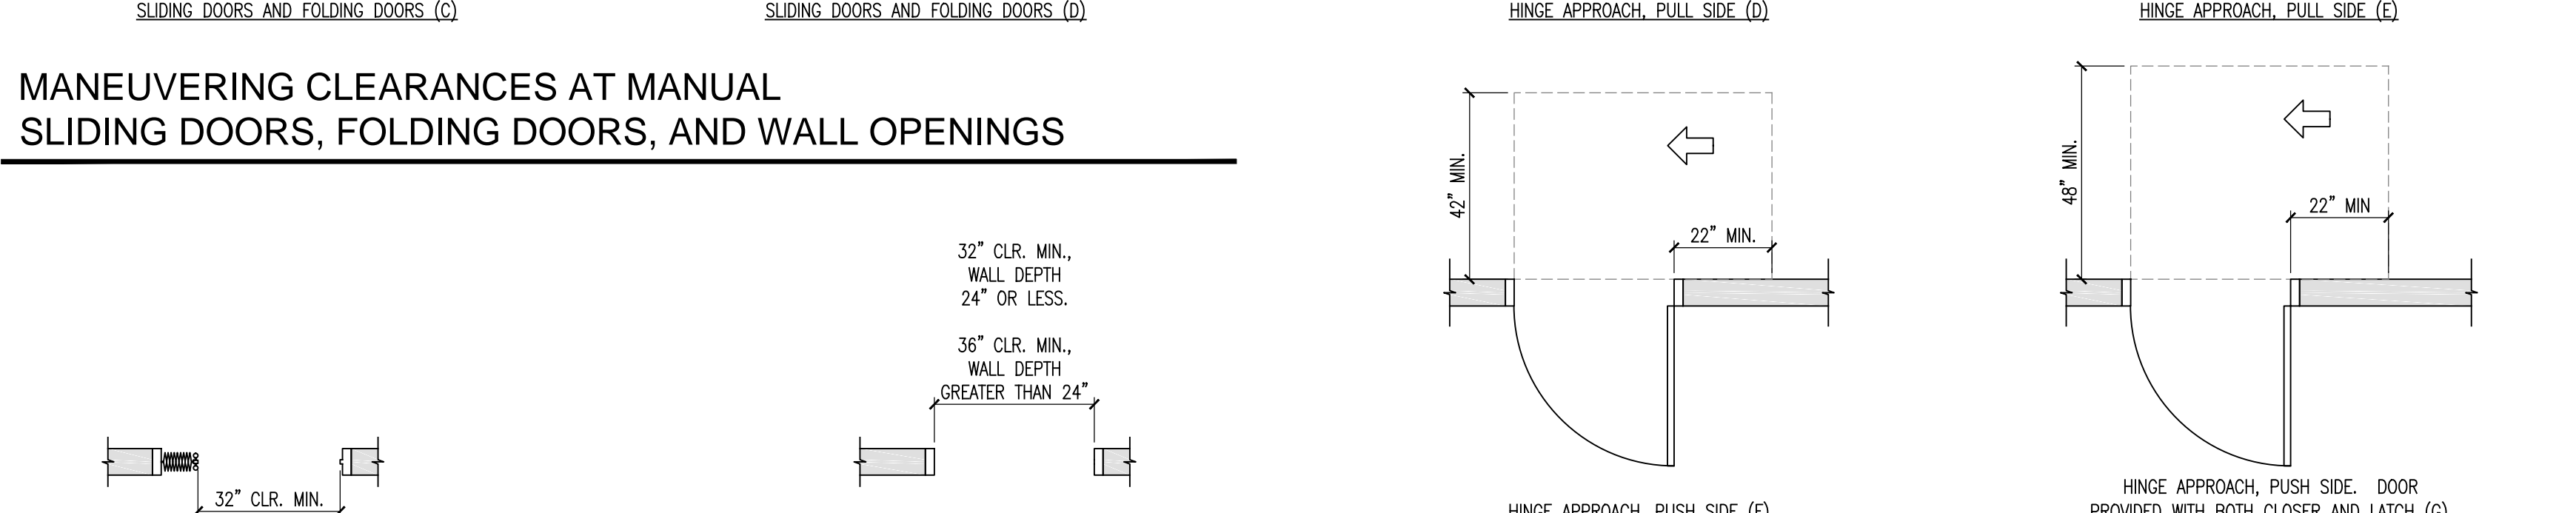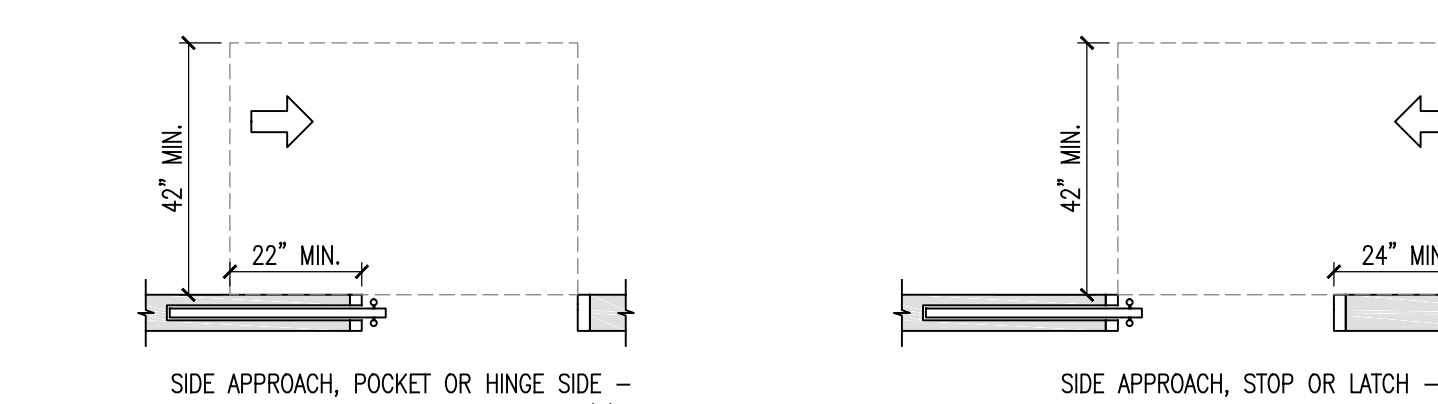

MANEUVERING CLEARANCES AT MANUAL HINGED DOORS

ACCESSIBLE ROUTES - DOORS, GATES, AND WALL OPENINGS





G010 3/8"=1'-0"

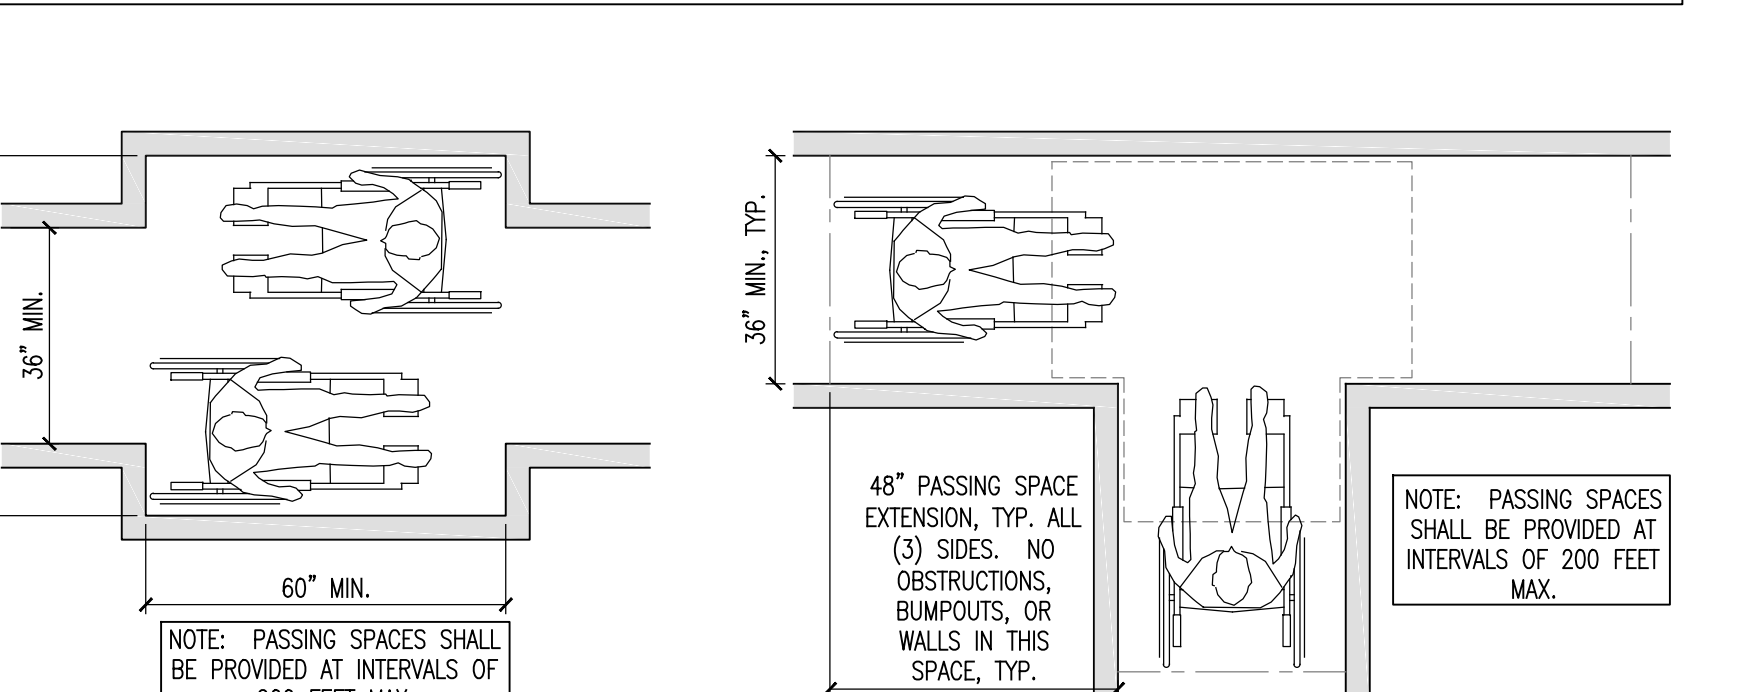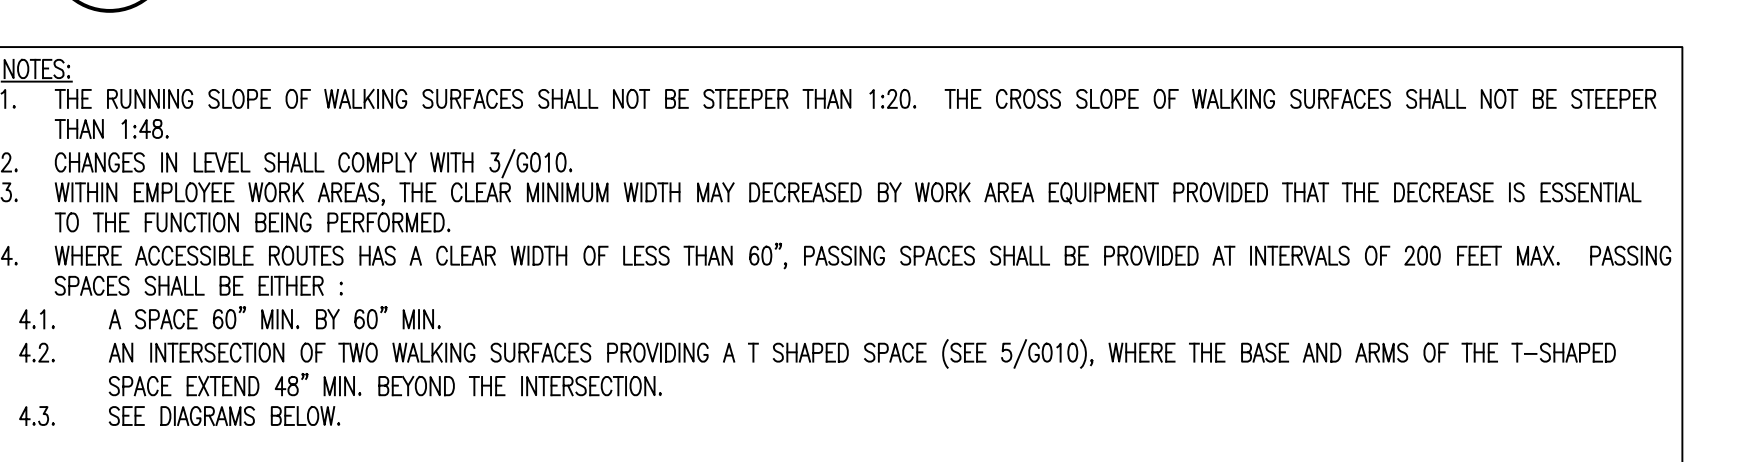

ACCESSIBLE ROUTES - WALKING SURFACES


G010 3/8"=1'-0"



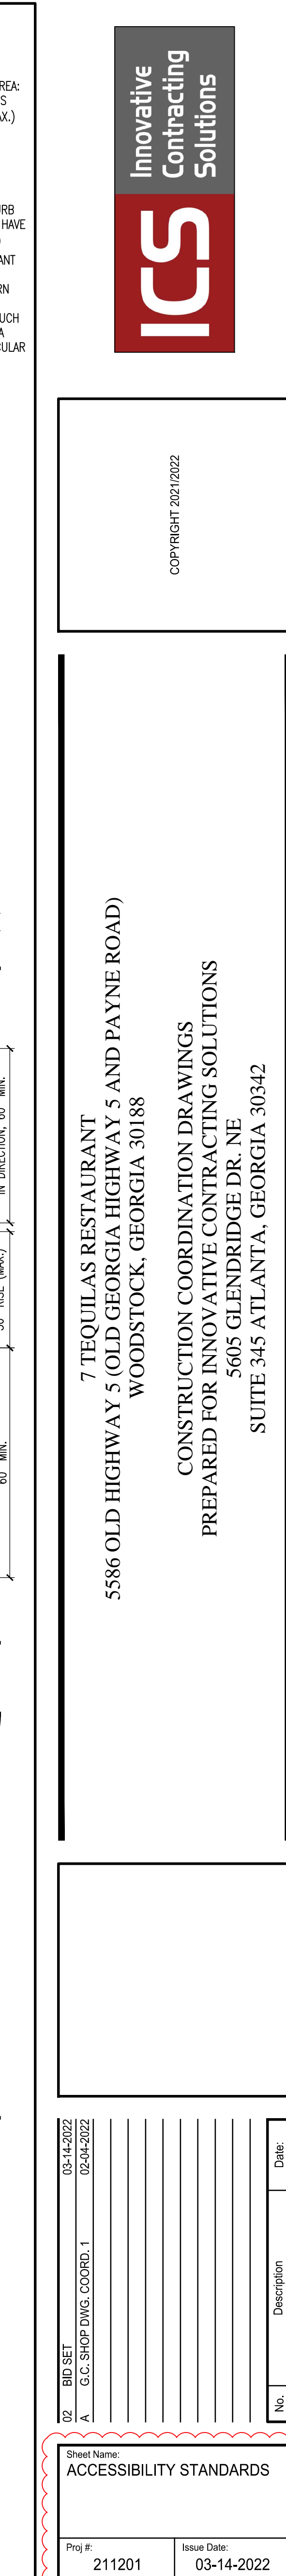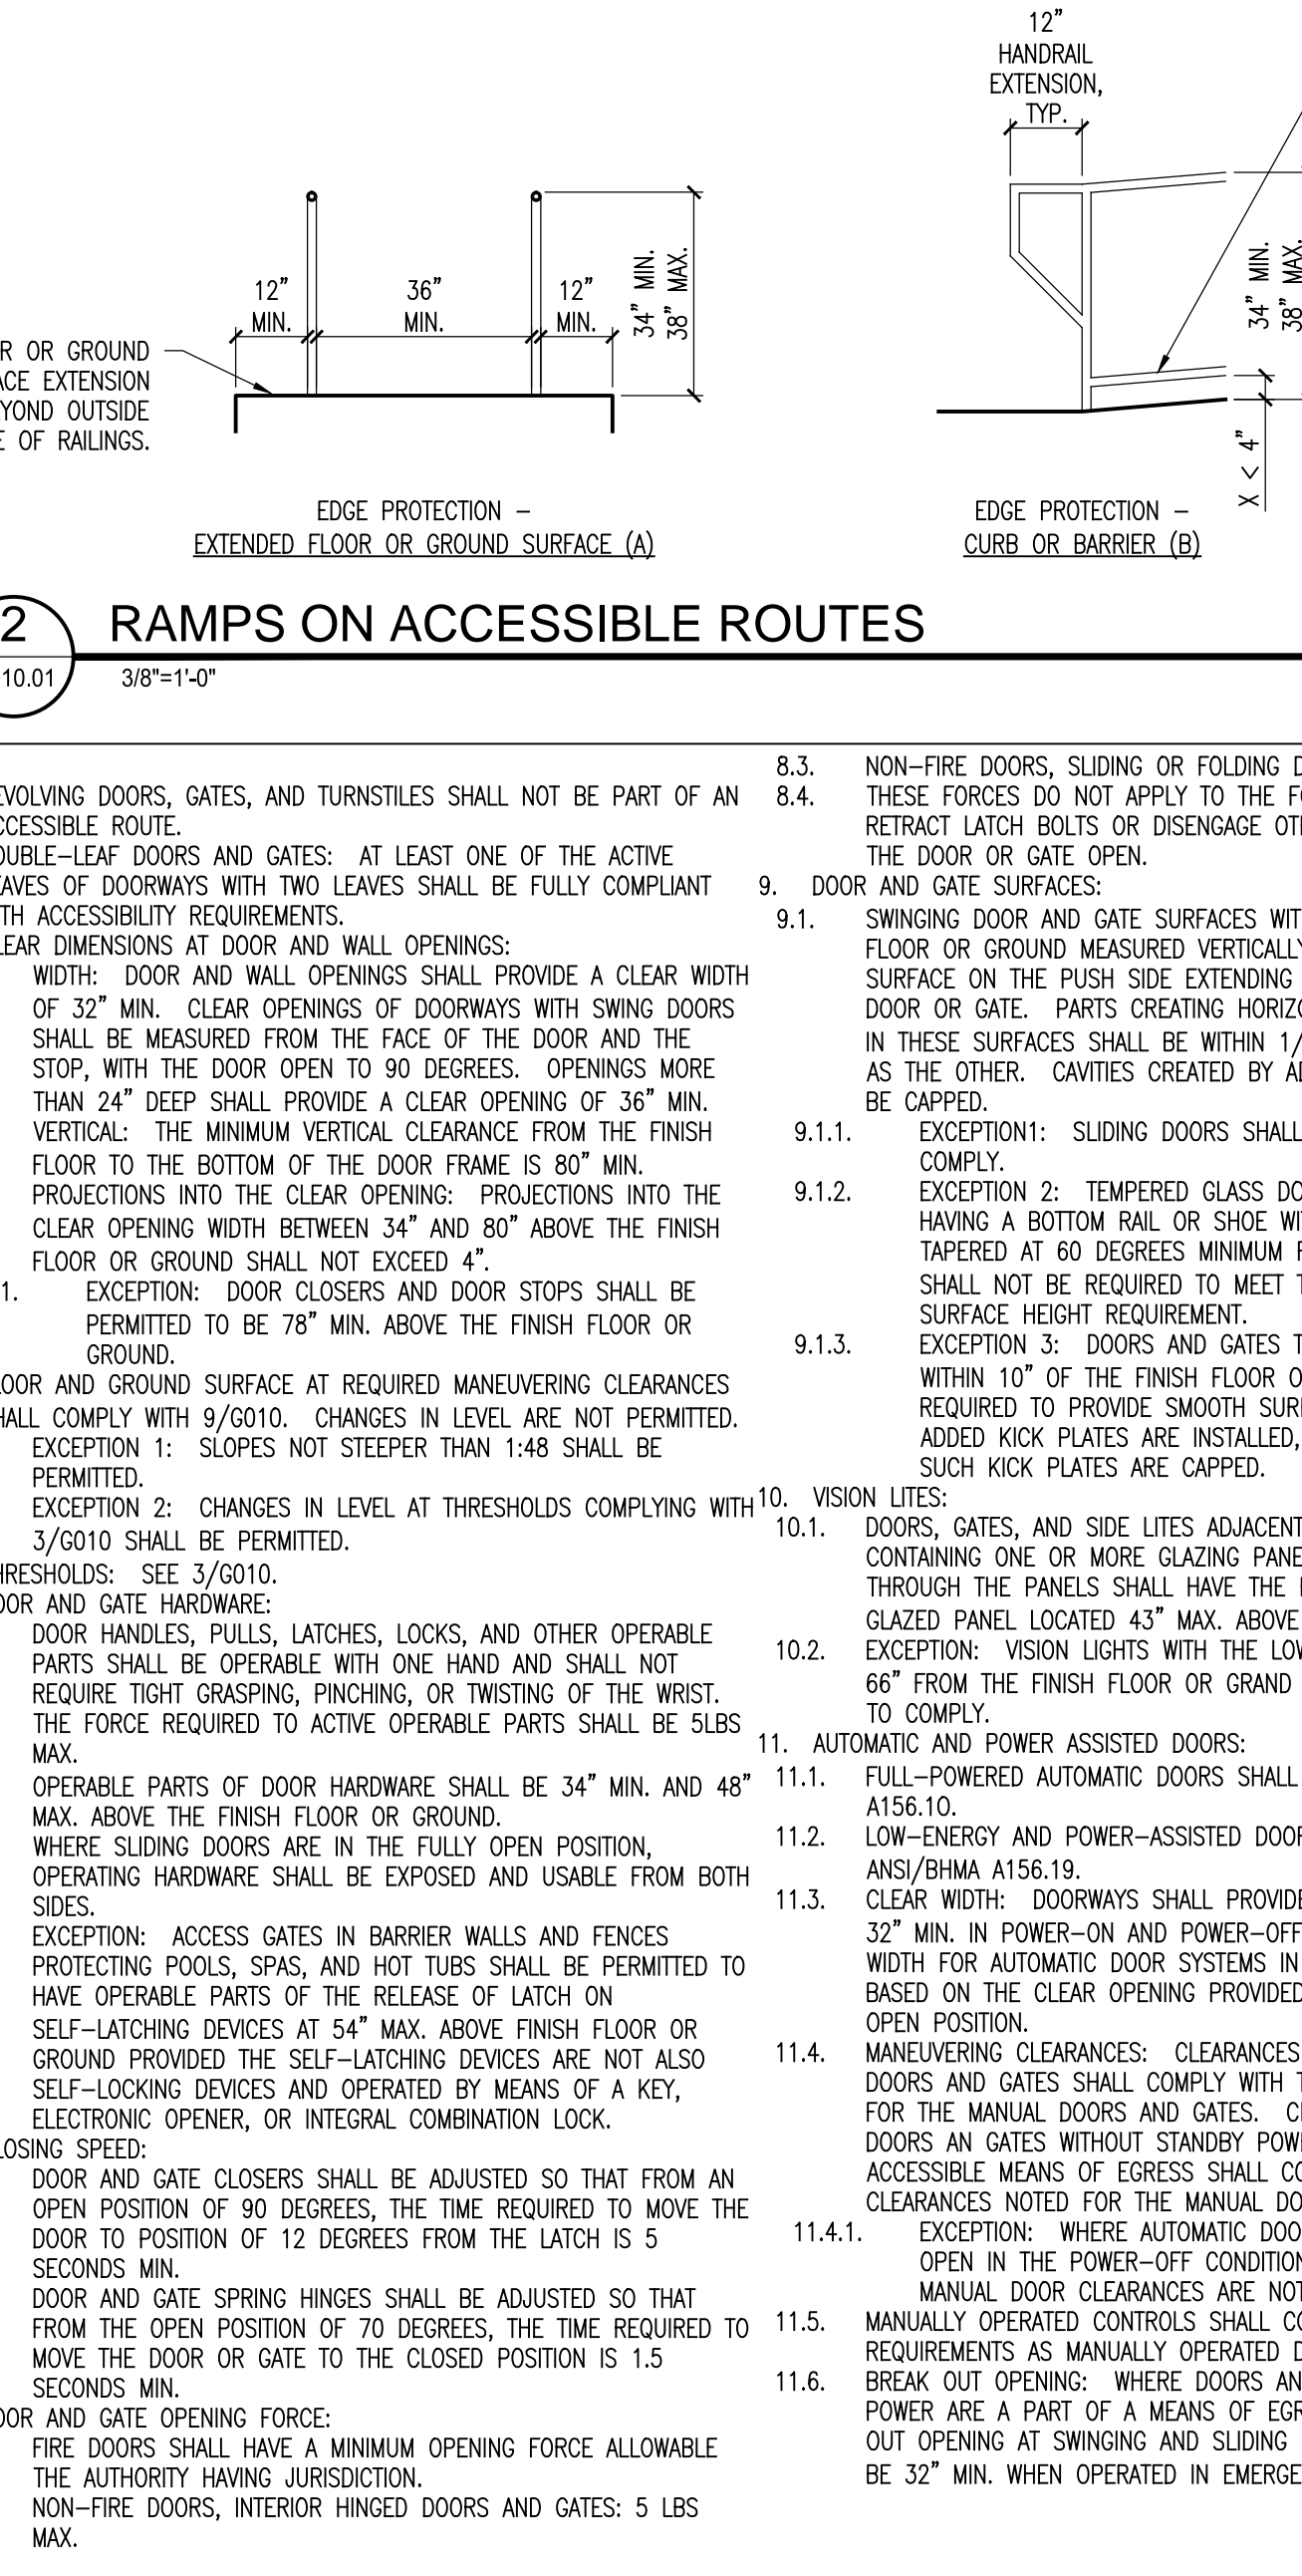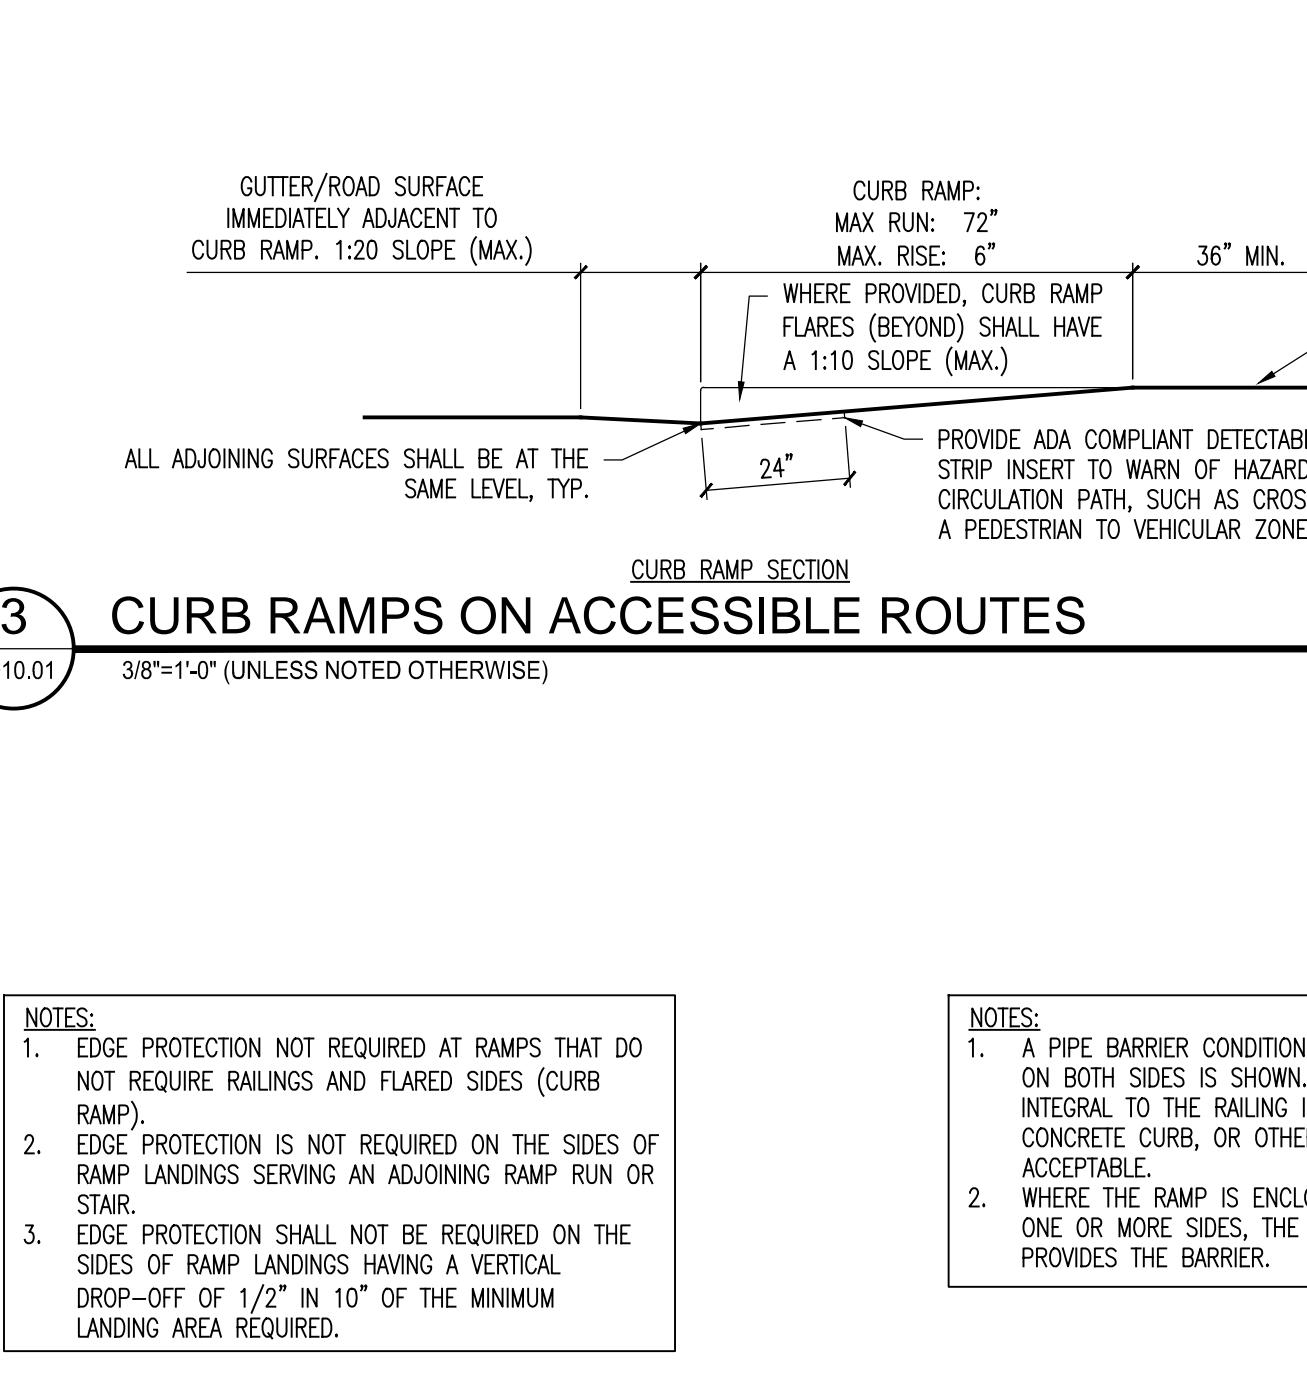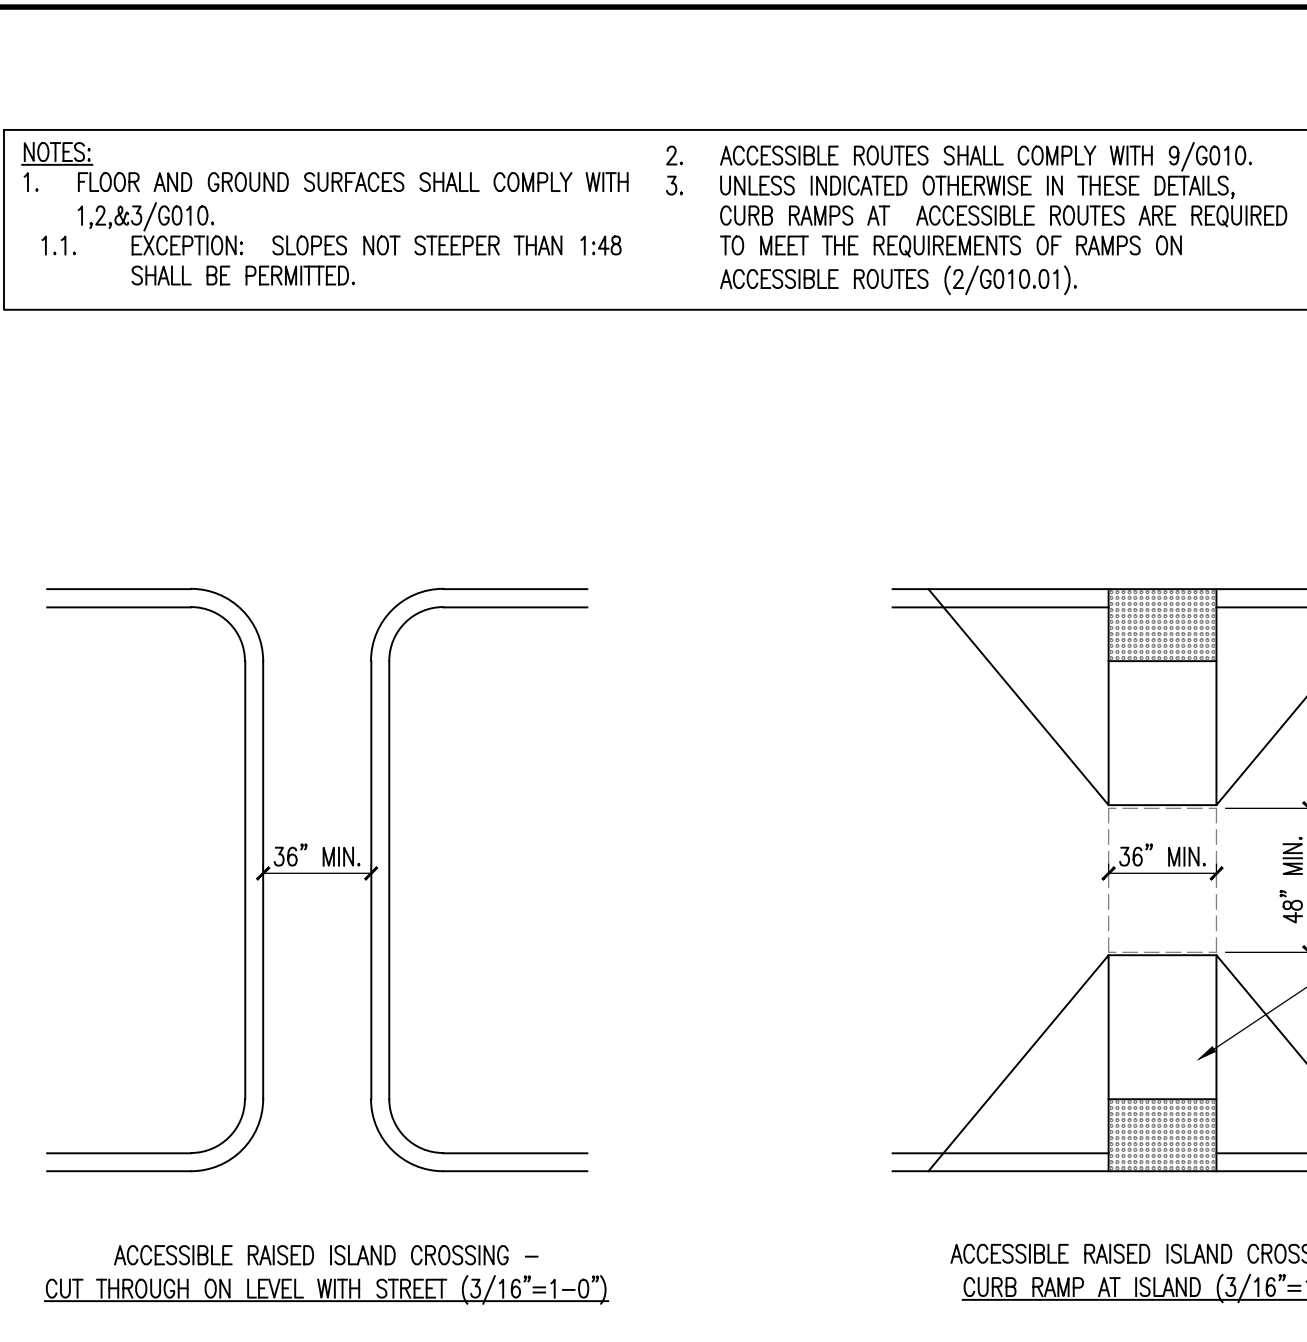


OPERABLE PARTS NOTES:

1. A CLEAR FLOOR SPACE COMPLYING WITH 6/G010 SHALL BE PROVIDED.
2. HEIGHT: OPERABLE PARTS SHALL BE PLACED WITHIN THE REACH RANGES IN 8/G010.
3. OPERATION: OPERABLE PARTS SHALL BE OPERATED WITH ONE HAND AND SHALL NOT REQUIRE TIGHT GRASPING, PINCHING, OR TWISTING OF THE WRIST. THE FORCE REQUIRED TO ACTIVATE OPERABLE PARTS SHALL BE 5 POUNDS MAX.
4. HAND OPERATING METERING FAUCETS SHALL REMAIN OPEN FOR 10 SECONDS.

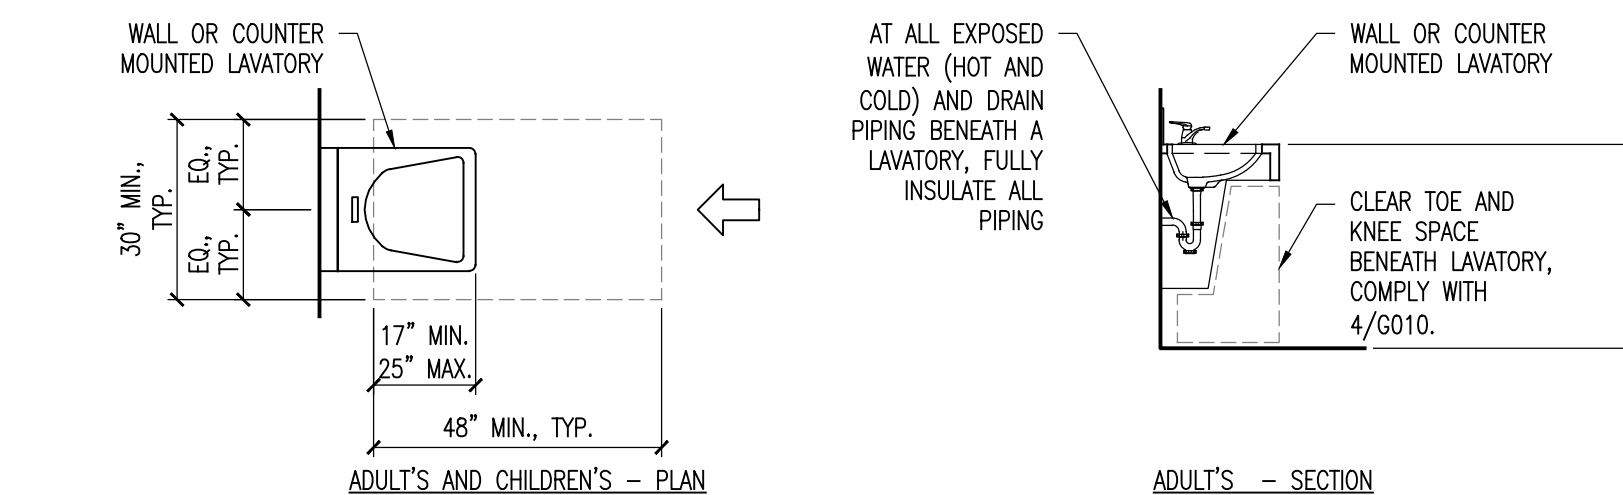


OPERABLE PARTS NOTES:

1. A CLEAR FLOOR SPACE COMPLYING WITH 6/010 SHALL BE PROVIDED.
2. HEIGHT: OPERABLE PARTS SHALL BE PLACED WITHIN THE REACH RANGES IN 8/010.
3. OPERATION: OPERABLE PARTS SHALL BE OPERABLE WITH ONE HAND AND SHALL NOT REQUIRE TIGHT GRASPING, PINCHING, OR TWISTING OF THE WRIST. THE FOR REQUIRED TO ACTIVATE OPERABLE PARTS SHALL BE 5 POUNDS MAX.

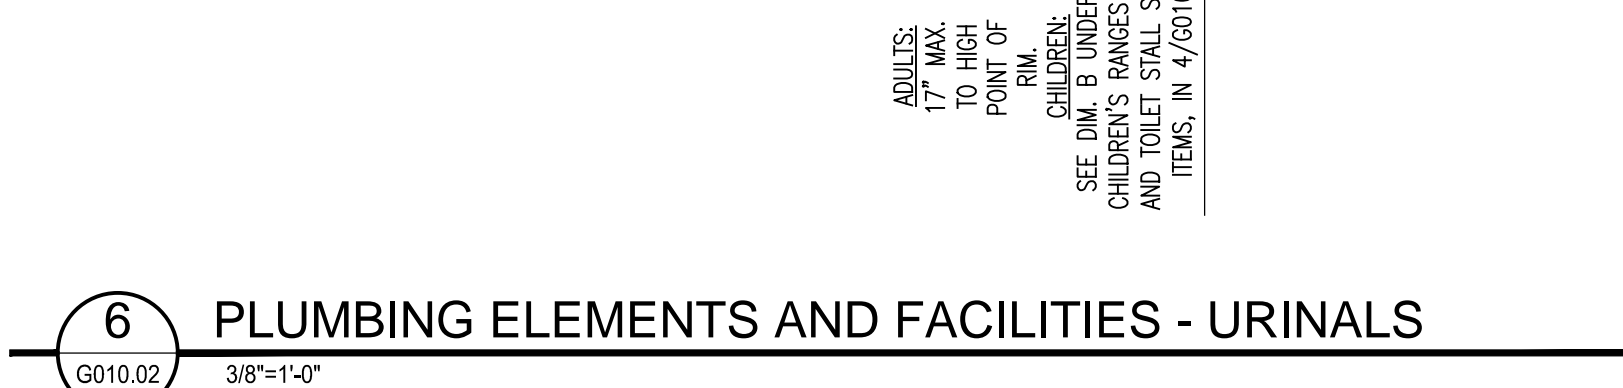

CHILDREN'S REACH RANGES					
FORWARD OR SIDE REACH	AGES 3 AND 4		AGES 5 THROUGH 8		AGES 9 THROUGH 12
HIGH (IN.)	30"	40"	40"	40"	40"
LOW (IN.)	20"	18"	18"	18"	18"
<p>THIS TABLE PROVIDES GUIDANCE ON REACH RANGES FOR CHILDREN ACCORDING TO AGE WHERE BUILDING ELEMENTS SUCH AS COAT HOOKS, LOCKERS, OR OPERABLE PARTS ARE DESIGNED FOR USE PRIMARILY BY CHILDREN. THESE DIMENSIONS APPLY TO EITHER FORWARD OR SIDE REACHES.</p> <p>ACCESSIBLE ELEMENTS AND OPERABLE PARTS DESIGNED FOR ADULT USE OR CHILDREN OVER AGE 12 CAN BE LOCATED OUTSIDE OF THE CHILDREN'S REACH RANGES, BUT MUST BE WITHIN THE ADULT REACH RANGES INDICATED BELOW.</p>					

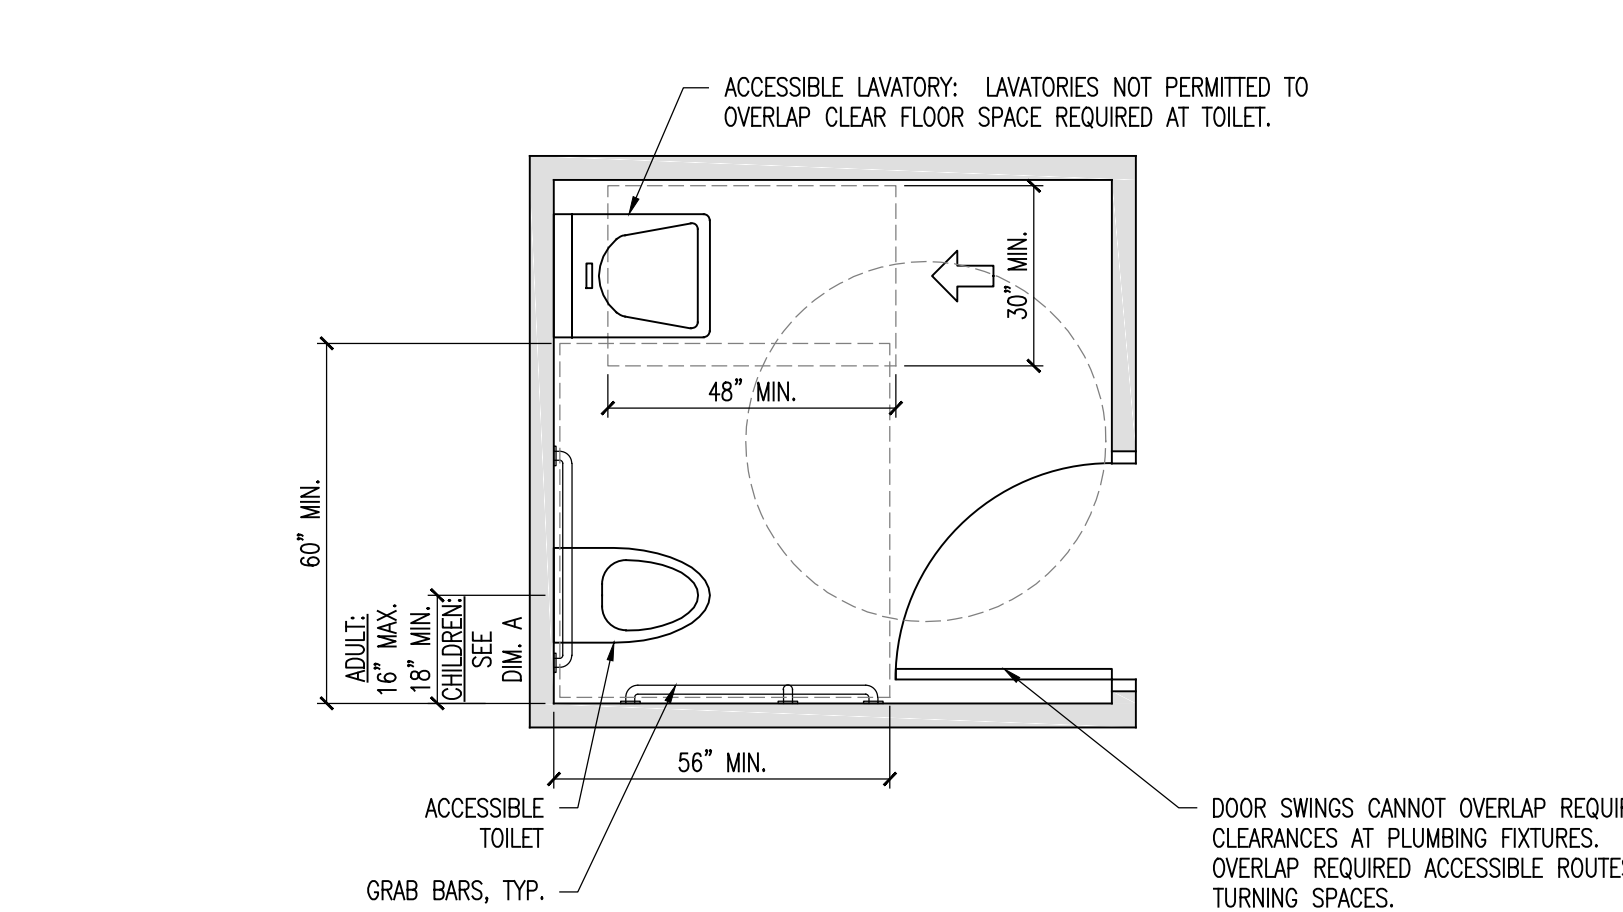

NOTES:

1. FORWARD APPROACH CLEARANCE UNDER 100 (WHEELCHAIR) HEIGHT DRINKING FOUNTAINS SHALL COMPLY WITH 4466/010.

EXCEPTION: A PARALLEL APPROACH COMPLYING WITH 6/010/010 SHALL BE PERMITTED FOR CHILDRENS USE ONLY WHERE THE SLOPE IS 30° OR GREATER. APPROACH FLOOR OF GRASS OR SOFT 1/2" MAXIMUM FROM FRONT EDGE OF THE UNIT, INCLUDING BUMPERS.

2. THE SPOUT SHALL PROVIDE A FLOW OF WATER 4" MIN. AND SHALL BE LOCATED 5" MAX. FROM THE FRONT OF THE UNIT. THE ANGLE OF THE WATER STREAM SHALL BE MEASURED HORIZONTALLY RELATIVE TO THE FRONT FACE OF THE UNIT. WHERE SPOUTS ARE LOCATED LESS THAN 3" OF THE FRONT OF THE UNIT, THE ANGLE OF THE WATER STREAM SHALL BE 30 DEGREES MAX. WHERE SPOUTS ARE LOCATED BETWEEN 3" AND 5" MAX. FROM THE FRONT OF THE UNIT, THE ANGLE OF THE WATER STREAM SHALL BE 15 DEGREES MAX.

GLASS PARTS NOTES:

1. CLEAR FLOOR SPACE COMPLYING WITH 6/010/010 SHALL BE PROVIDED.

2. **GLASSING:** OPERABLE PARTS SHALL BE PLACED WITHIN THE REACH RANGES IN 8/010/010.



 

 



 


3. **GLASSING:** OPERABLE PARTS SHALL BE OPERABLE WITH ONE HAND AND SHALL NOT REQUIRE TIGHT GRASPING, PINCHING, OR TWISTING OF THE WRIST. (THE FORCE REQUIRED TO ACTIVATE OPERABLE PARTS SHALL BE 5 POUNDS MAX.)

Diagram illustrating the required clearances for a toilet stall:

- 60" MIN., ALL ACCESSIBLE AMBULATORY TOILETS**: Dimension for the toilet fixture.
- 48" MIN., ALL ACCESSIBLE URINALS**: Dimension for the urinal fixture.
- 42" CLR. MIN.**: Dimension for the clear space at the urinal.
- 48" MIN., ALL ACCESSIBLE LAVATOIRES**: Dimension for the lavatory fixture.
- DOOR SWINGS CANNOT OVERLAP REQUIRED CLEARANCES AT PLUMBING FIXTURES. IT CAN OVERLAP REQUIRED ACCESSIBLE ROUTES AND TURNING SPACES.**: Note regarding door swing clearance.
- ACCESSIBLE URINAL: URINALS NOT PERMITTED TO OVERLAP CLEAR FLOOR SPACE REQUIRED AT ACCESSIBLE TOILETS AND LAVATOIRES.**: Note regarding urinal placement.
- ACCESSIBLE LAVATORY: LAVATOIRES NOT PERMITTED TO OVERLAP CLEAR FLOOR SPACE REQUIRED AT ACCESSIBLE TOILETS AND URINALS.**: Note regarding lavatory placement.
- ALTERNATIVELY, THE WHEELCHAIR ACCESSIBLE STALL PANELS AND DOOR MAY BE CONFIGURED LIKE THIS. DOOR SHALL NOT SWING INTO THE REQUIRED CLEAR SPACE AT THE TOILET.**: Alternative configuration note.




1 ACCESSIBLE ROUTES - STAIRS

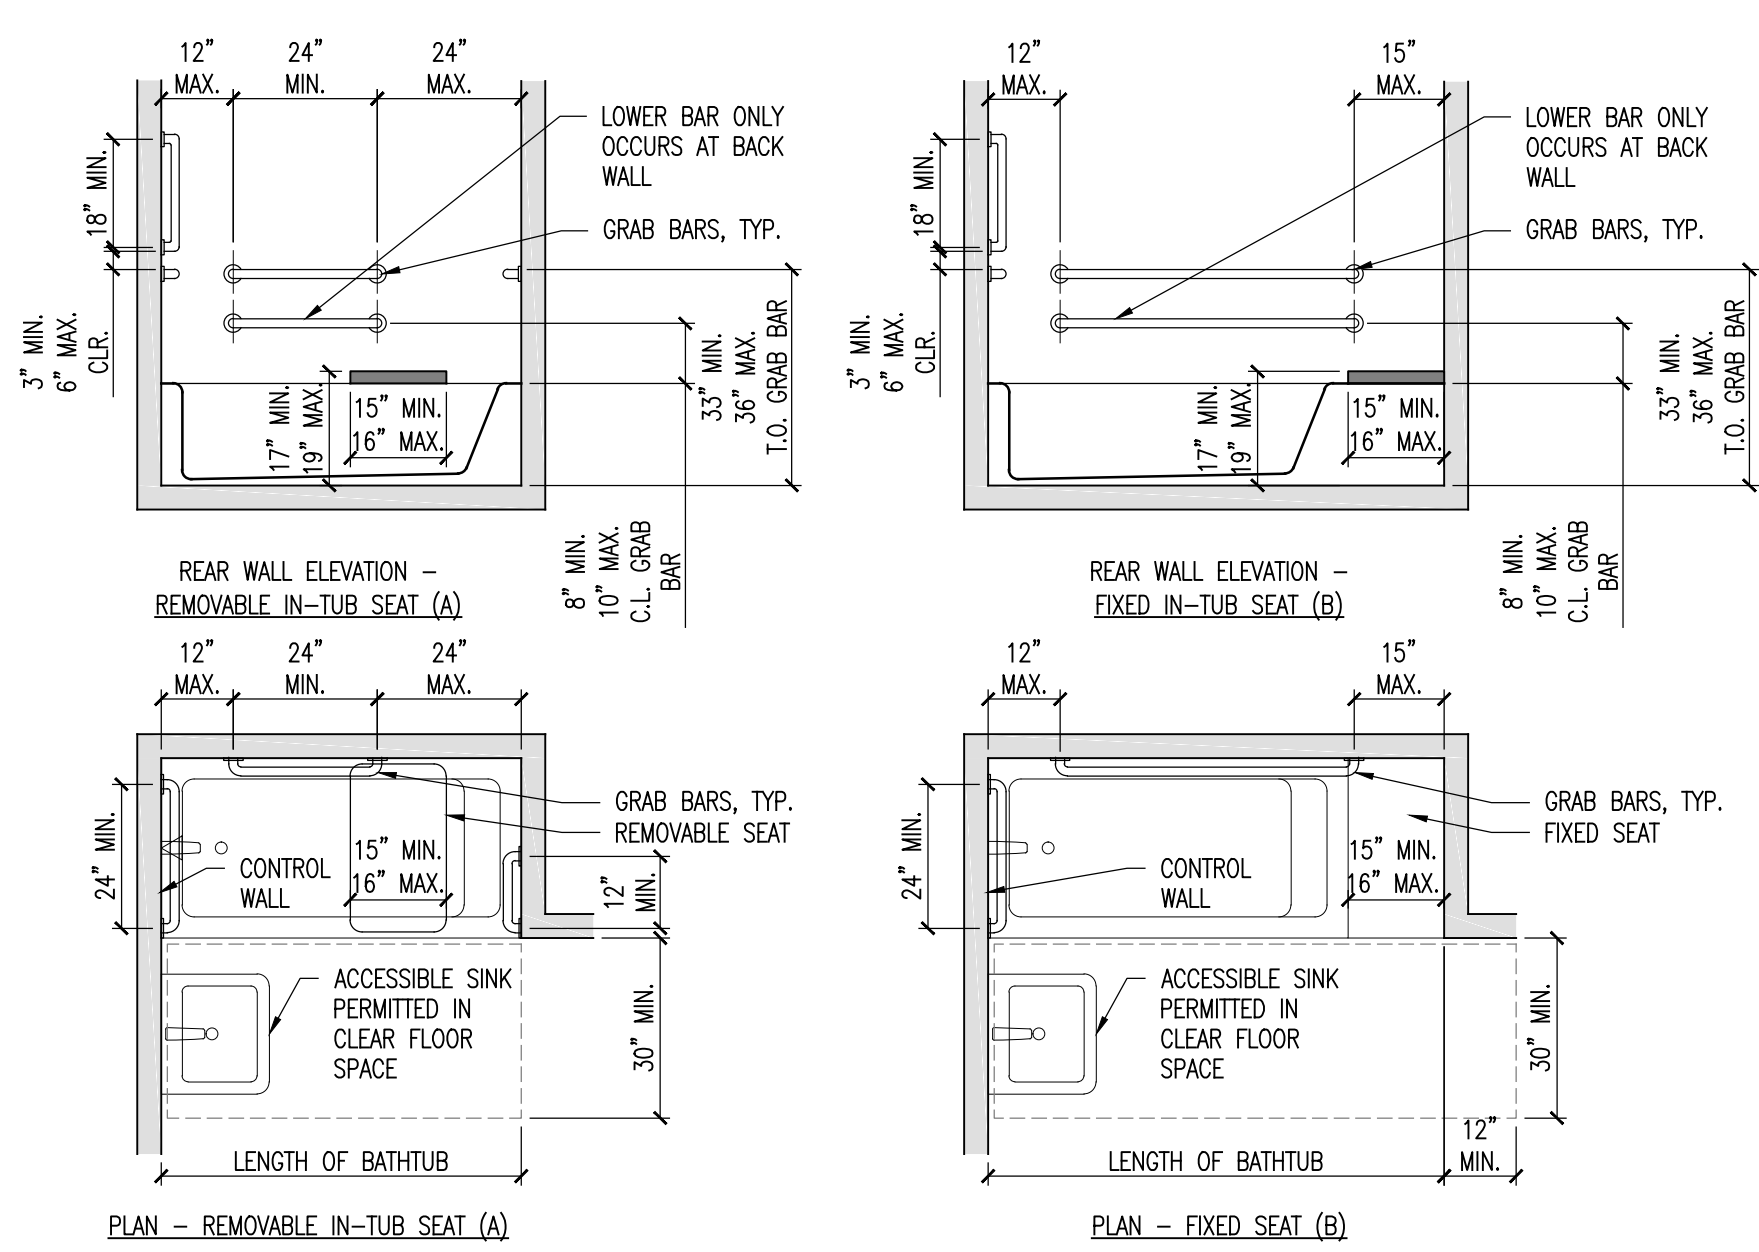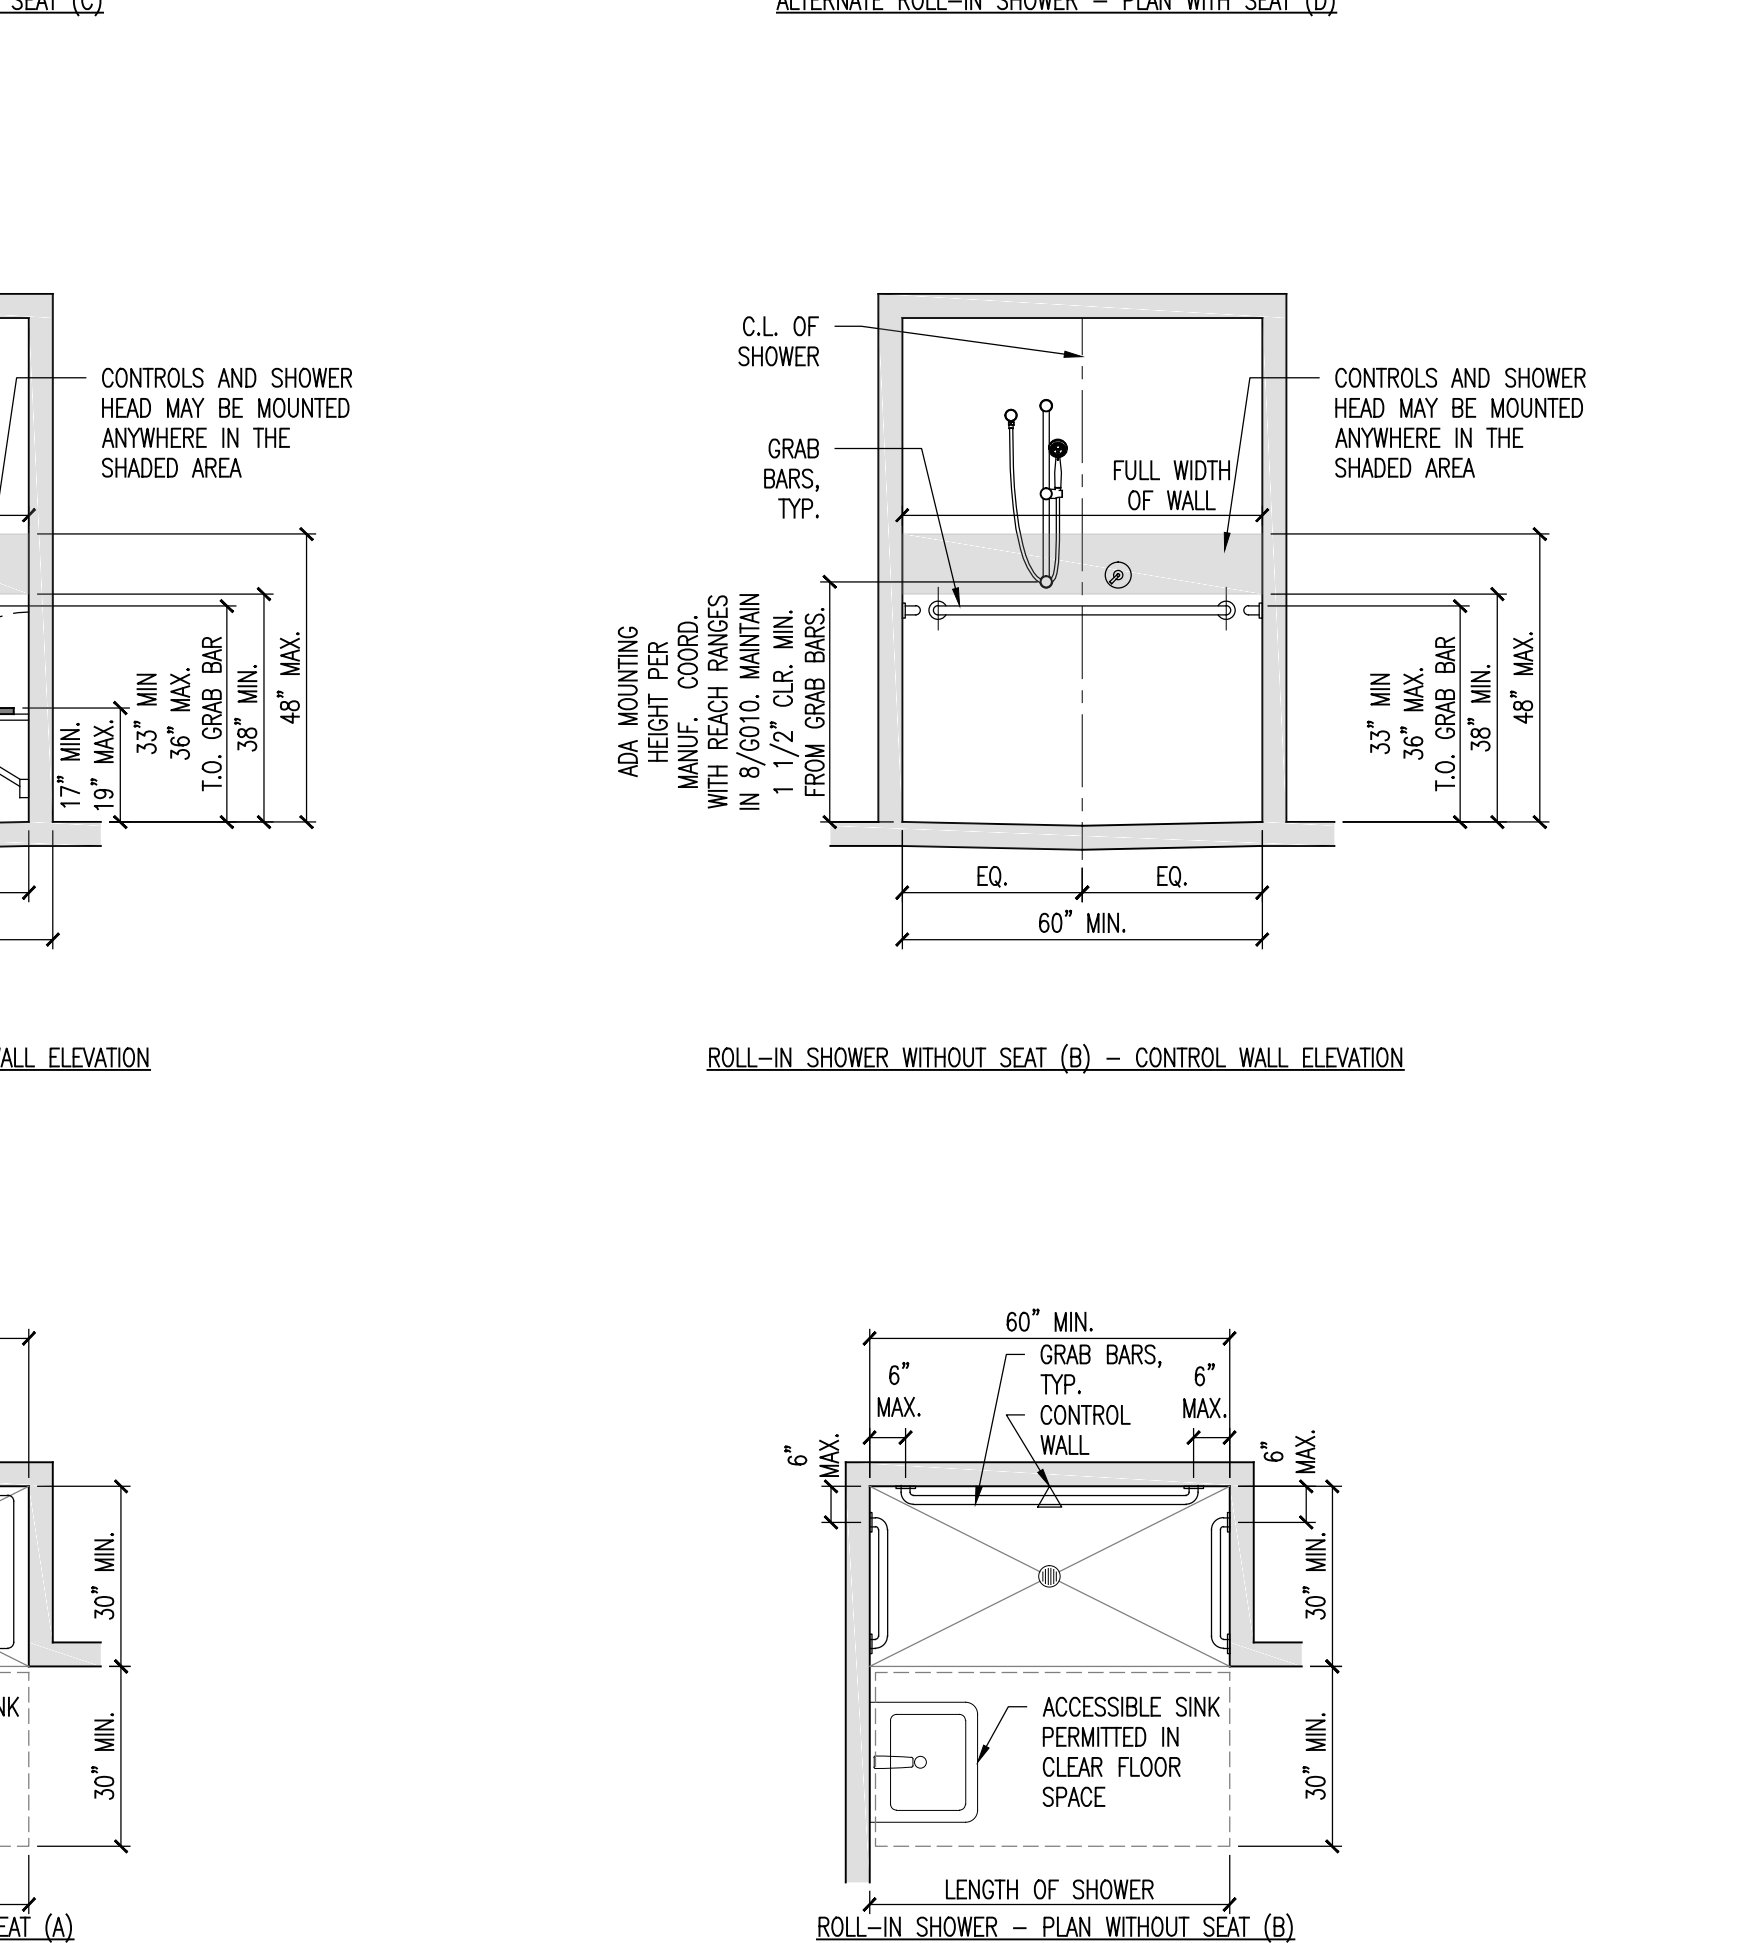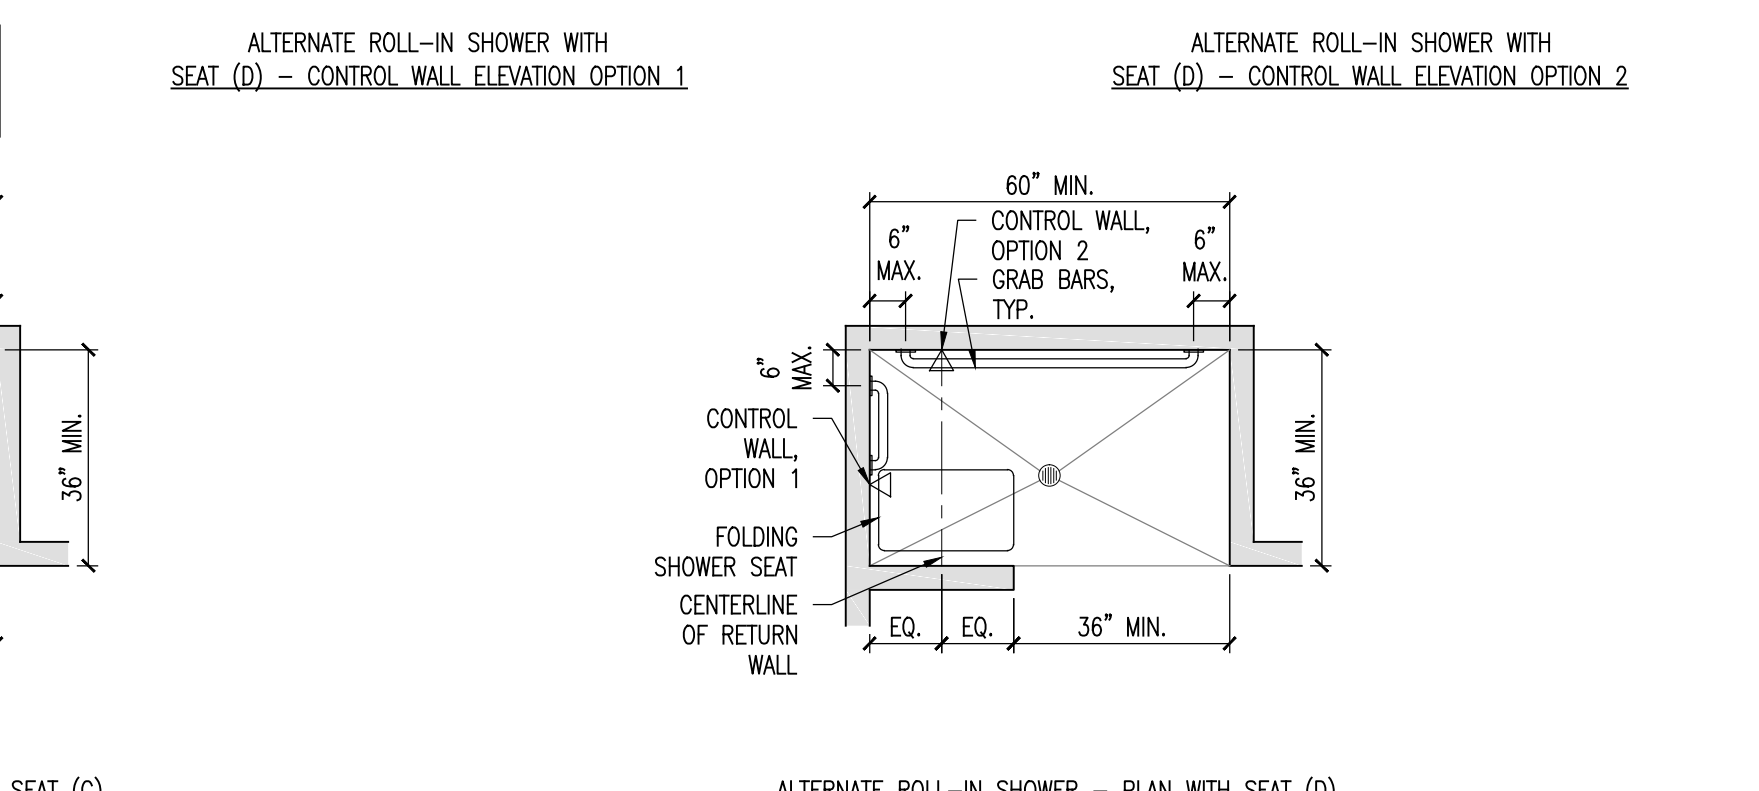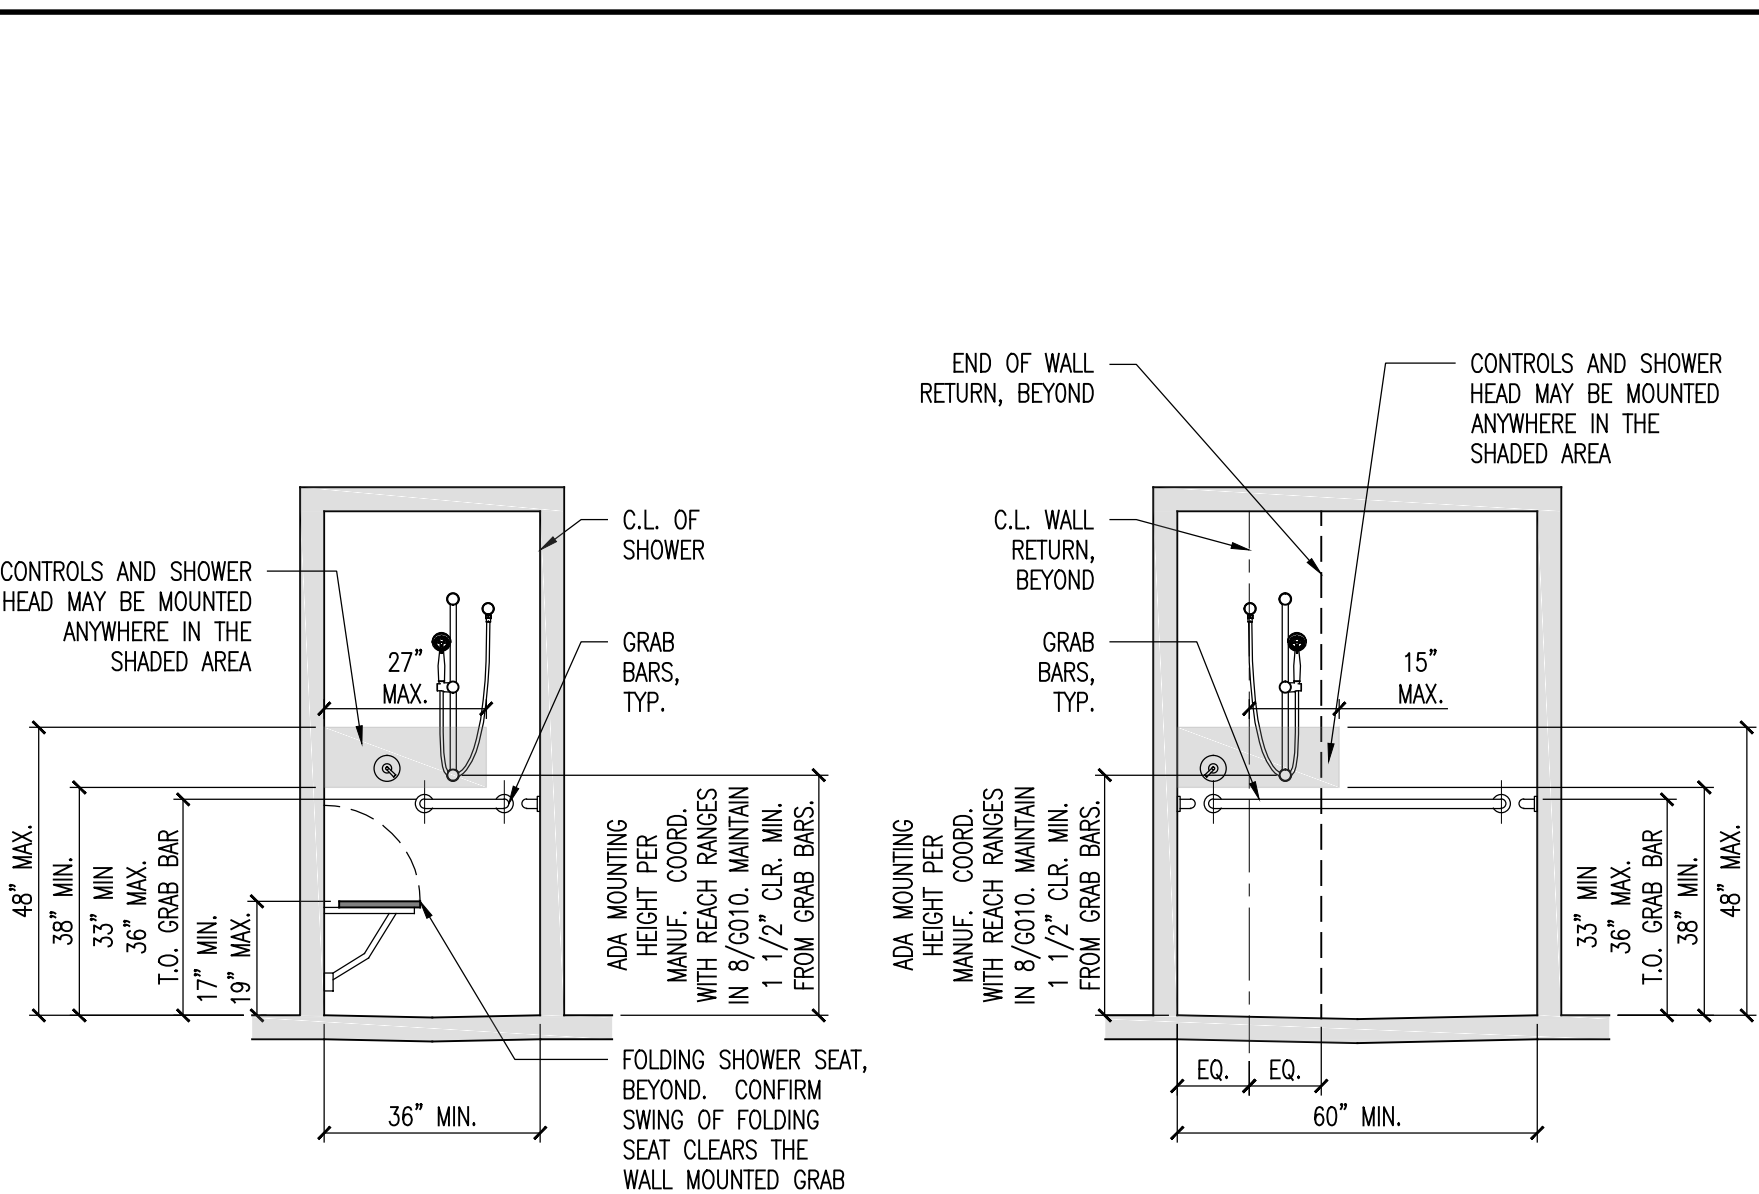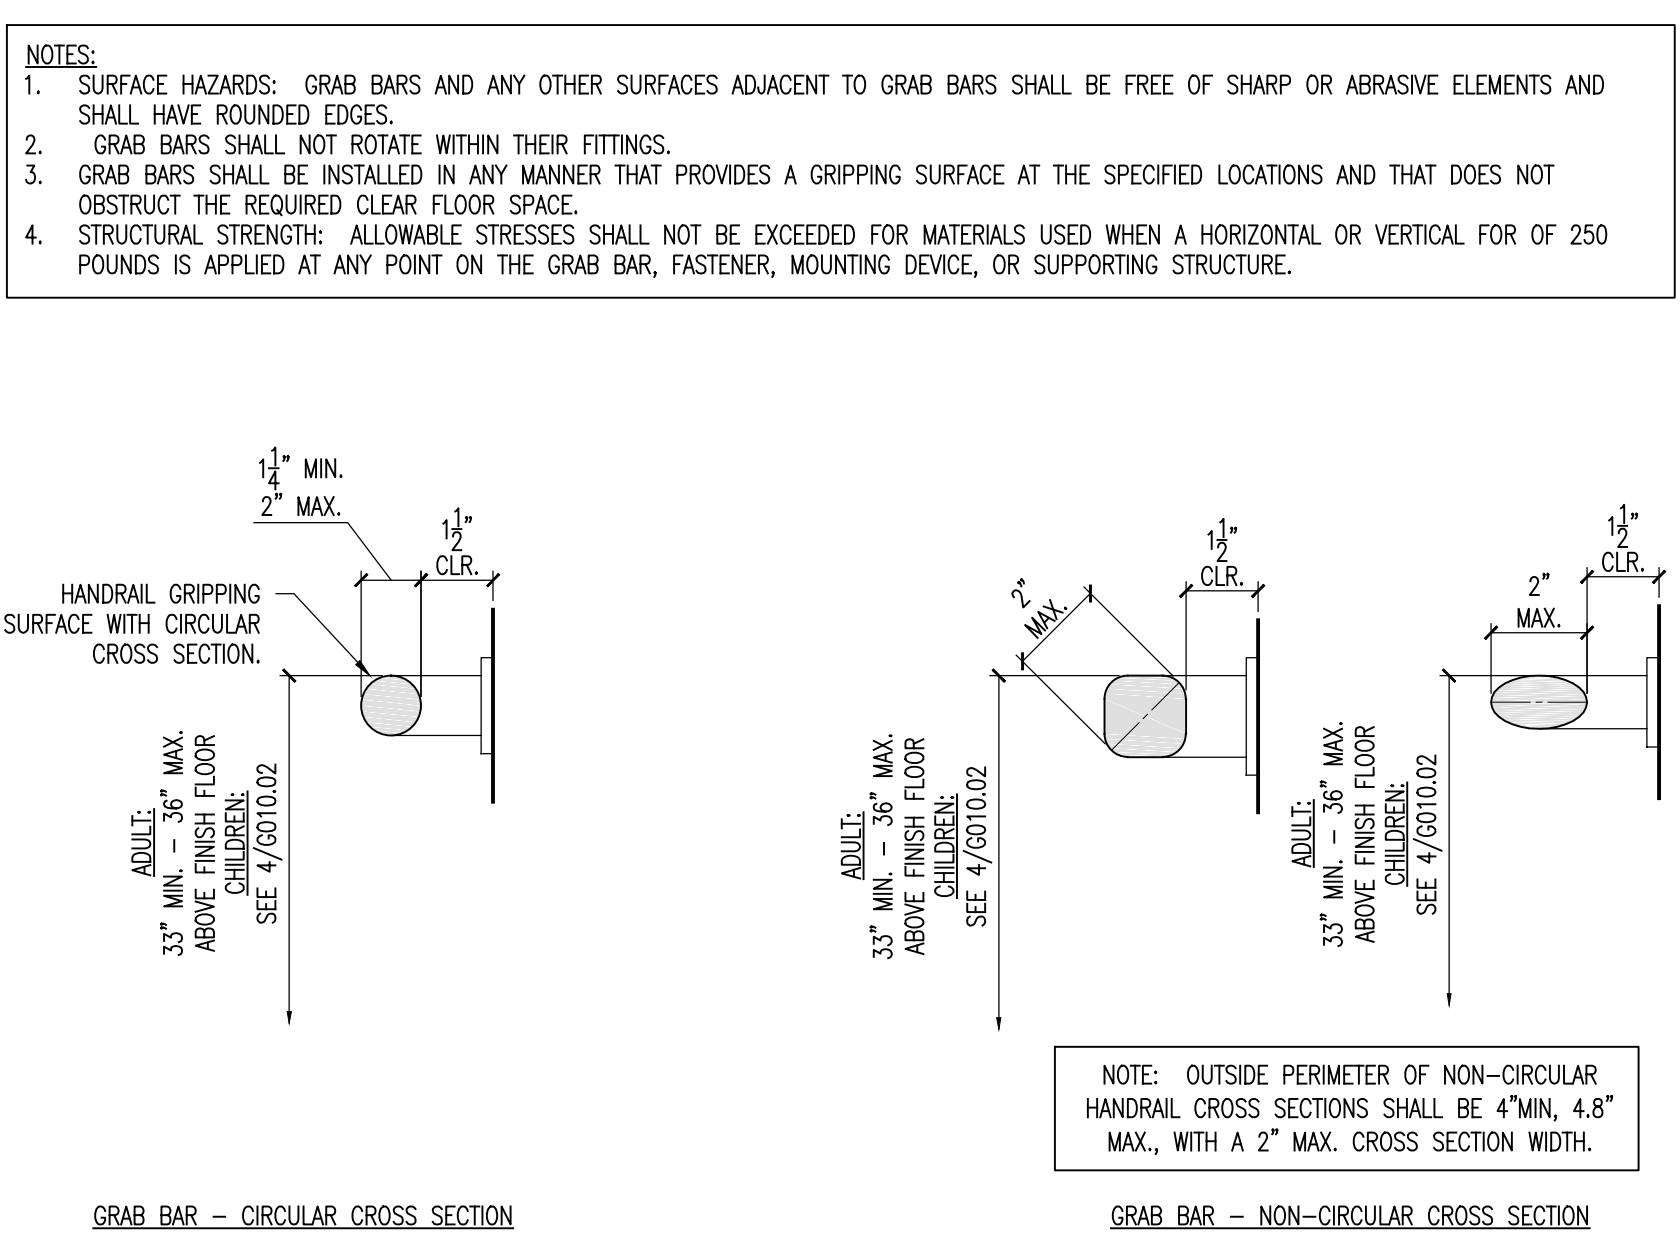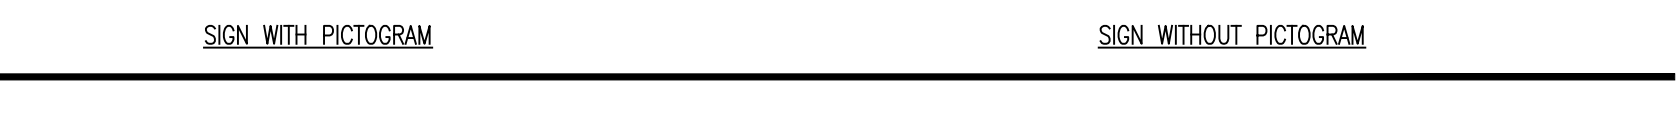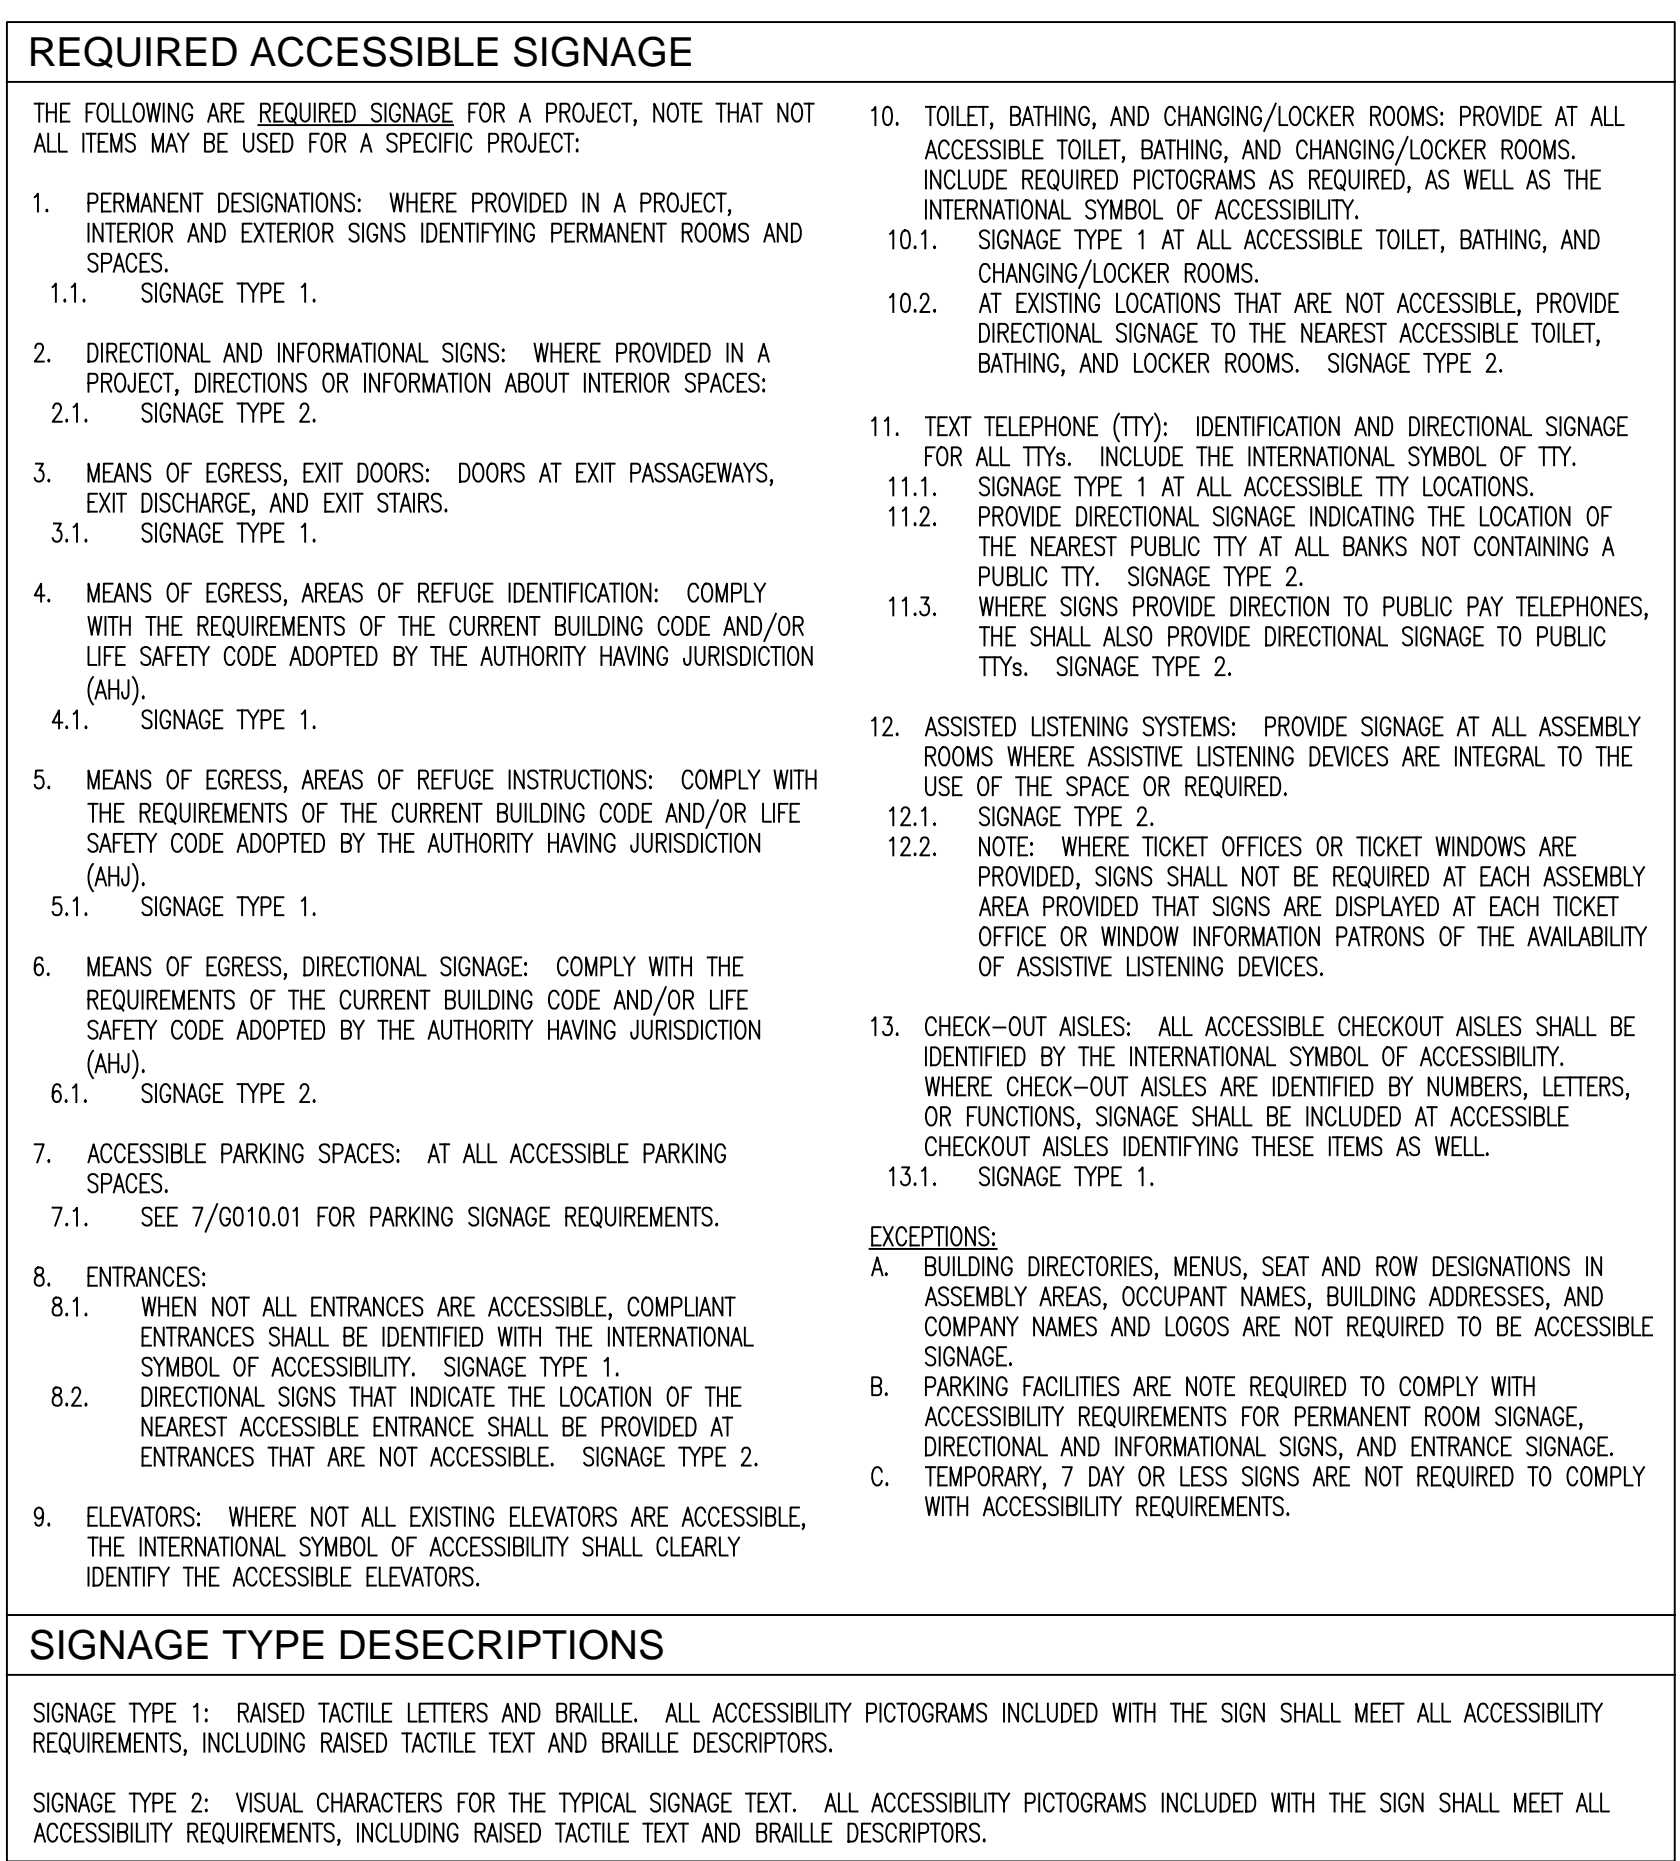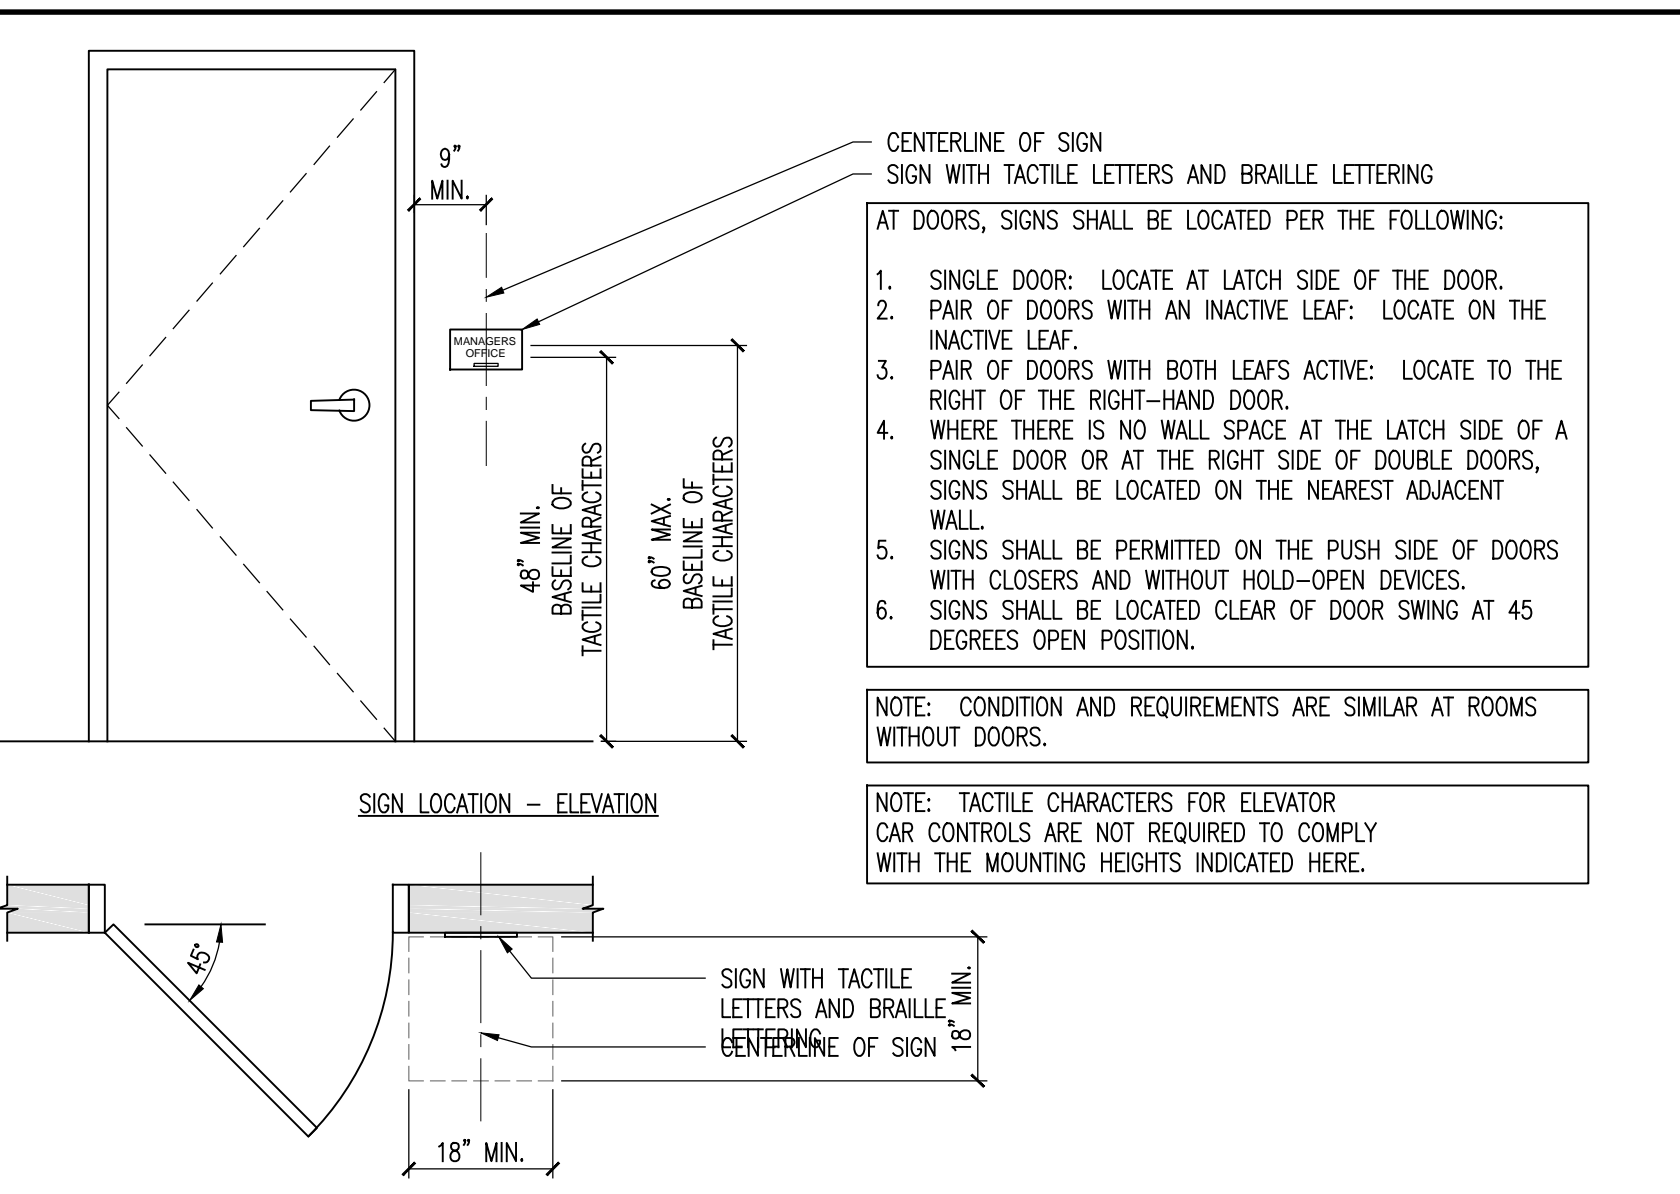

1 FIRST FLOOR PLAN
1/4"=1'-0"

KITCHEN EQUIPMENT SHOWN FOR REFERENCE ONLY. SEE KITCHEN DRAWINGS FOR ALL KITCHEN EQUIPMENT INFORMATION.

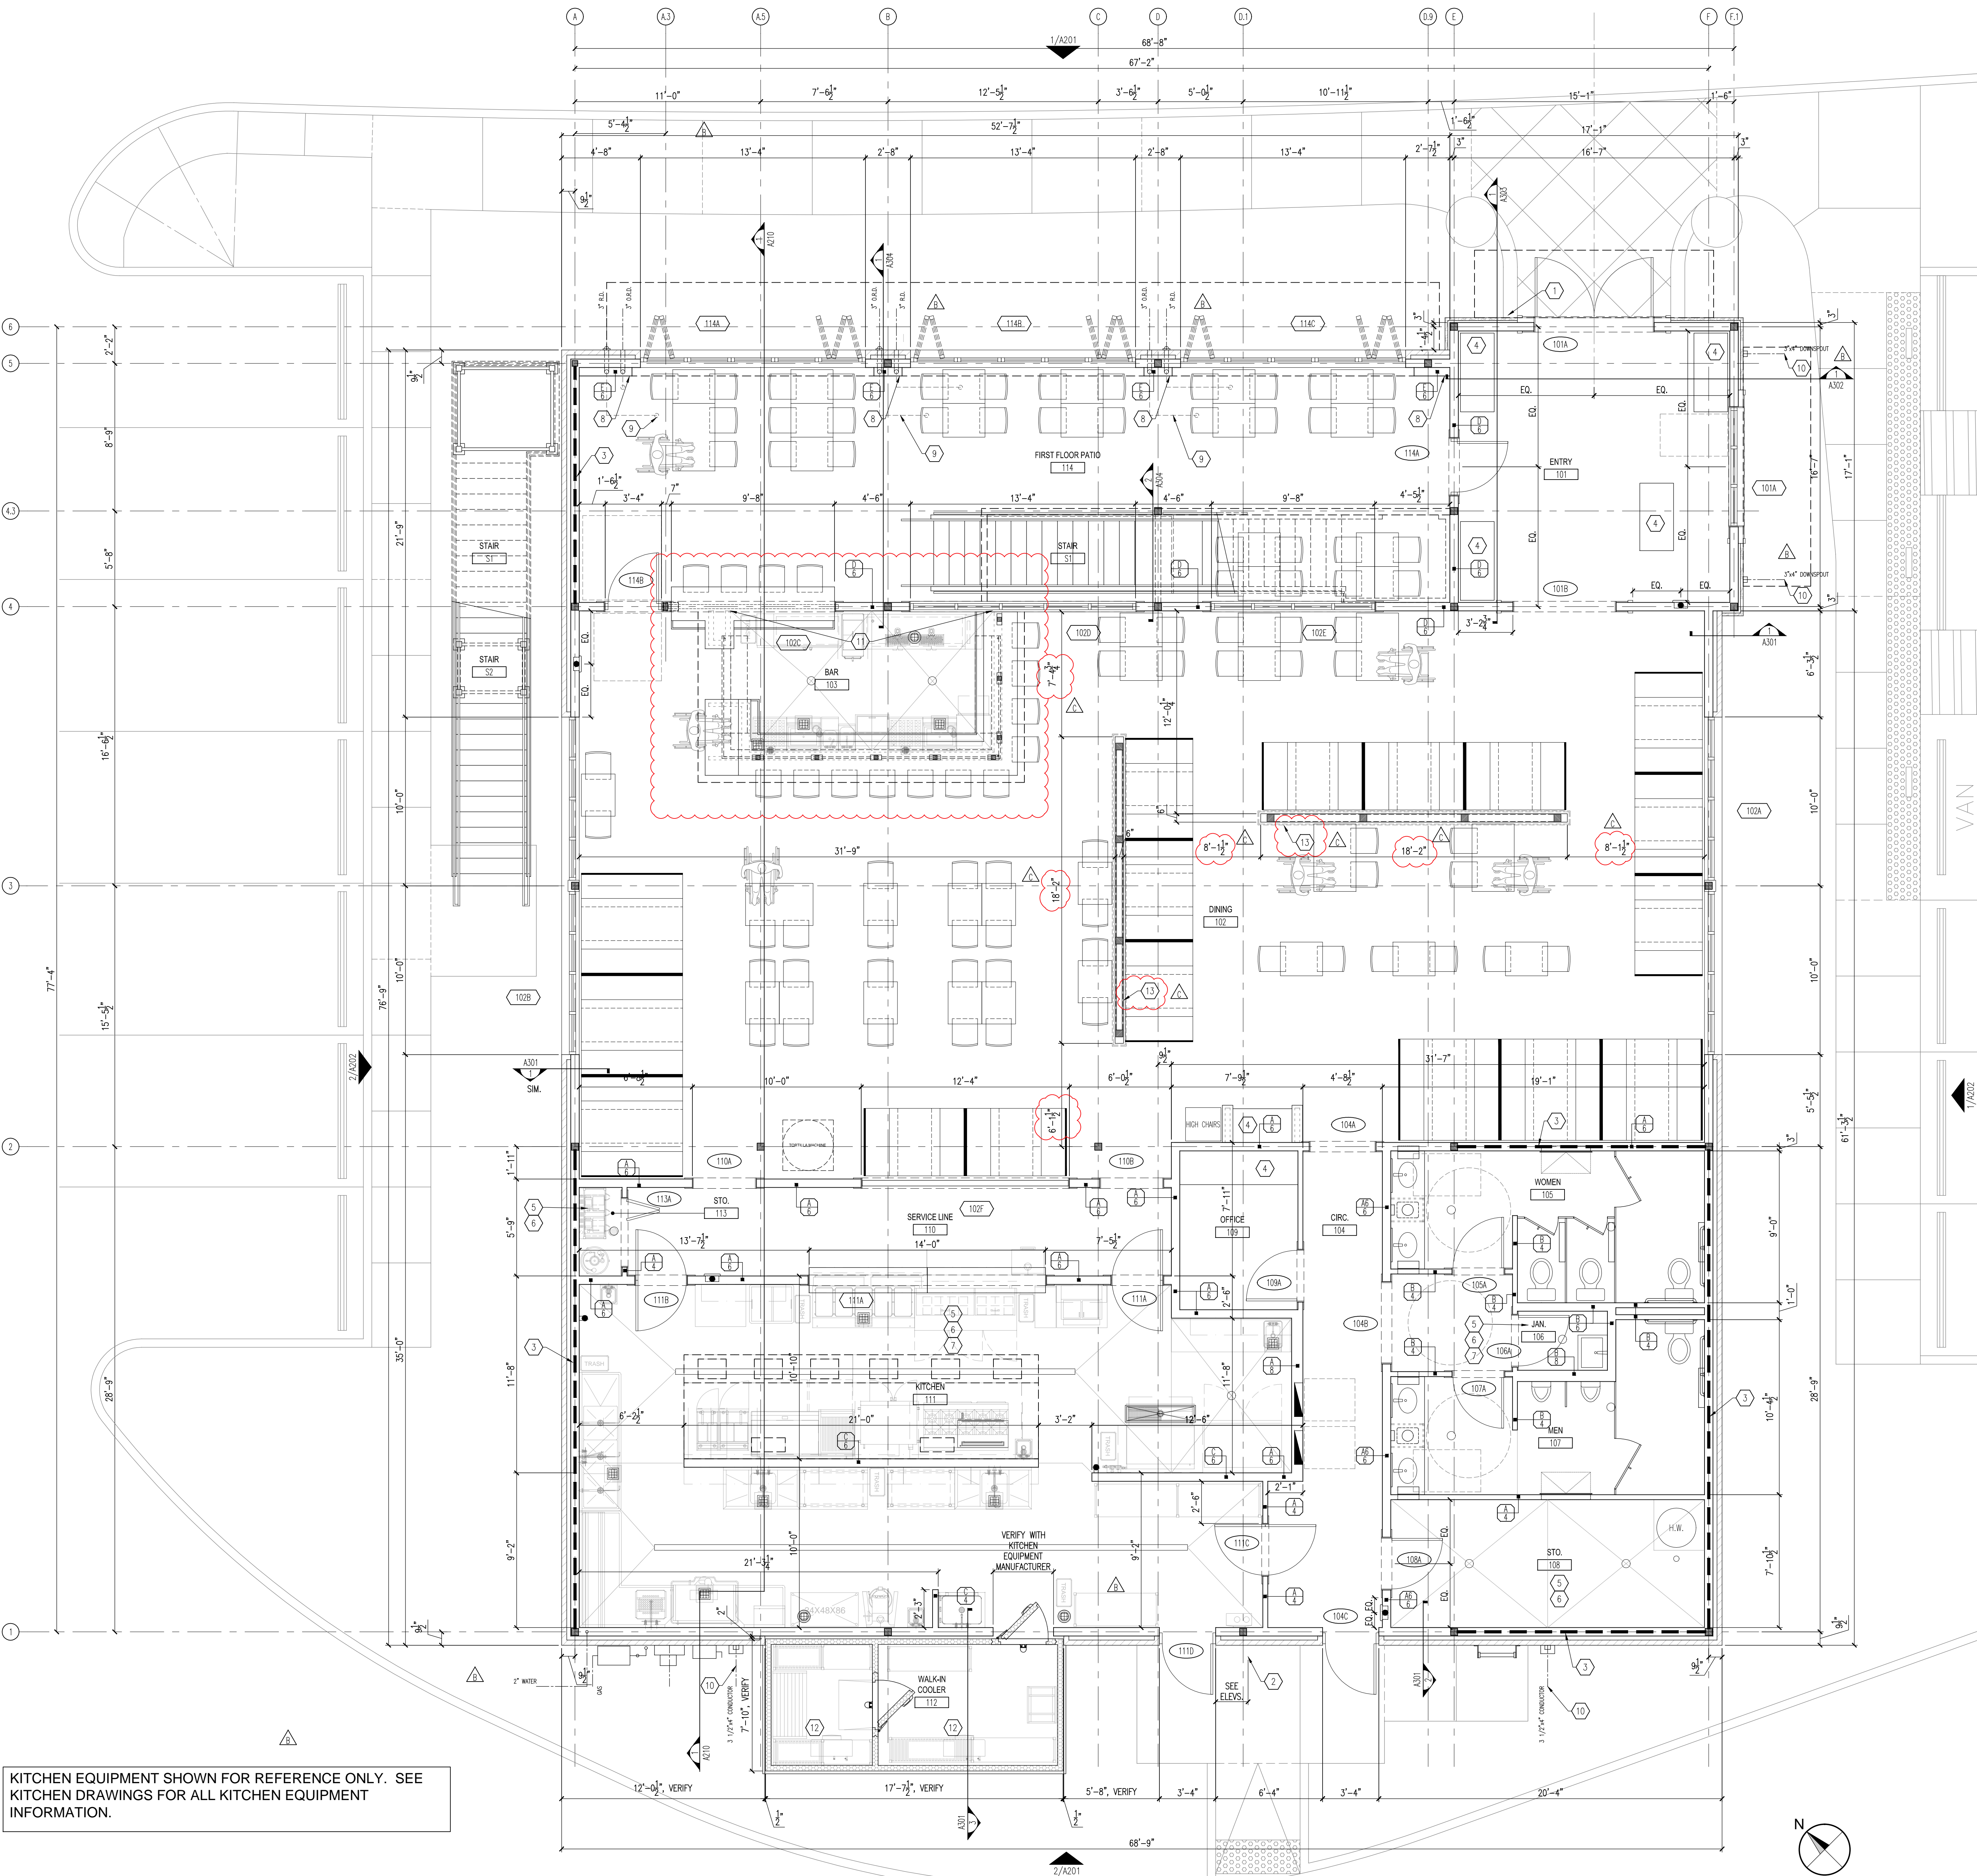

GENERAL SHEET NOTES

- NOT ALL ITEMS MAY BE USED.
- DIMENSIONS ARE TAKEN TO FACE OF STUD, FACE OF MASONRY OR CONCRETE, OR COLUMN CENTERLINE, UNLESS INDICATED OTHERWISE.
- PRIOR TO ROUGH-IN AND WALL ENCLOSURE, COORDINATE ALL WORK WITH TENANT/OWNER VENDOR REQUIREMENTS.
- PRIOR TO ROUGH-IN AND WALL ENCLOSURE, COORDINATE LOCATION OF ALL WALL MOUNTED FIXTURES AND DEVICES WITH FINISH WORK SHOWN IN THE ARCHITECTURAL AND/OR ID DRAWINGS - ALIGN AS INDICATED. THIS SHALL INCLUDE, BUT NOT BE LIMITED TO: ALL CONTRACTOR, TENANT/OWNER, AND TENANT/OWNER VENDOR SUPPLIED ITEMS.
- IF THERE IS A DISCREPANCY BETWEEN THE ARCHITECTURAL AND ID DRAWINGS, NOTIFY THE ARCHITECT FOR RESOLUTION PRIOR TO PROCEEDING WITH THE WORK.
- IF THERE IS A DISCREPANCY WITH THE ACCESSIBILITY STANDARDS, REPORT THE DISCREPANCY TO THE ARCHITECT FOR RESOLUTION PRIOR TO PROCEEDING WITH THE WORK.
- PRIOR TO WALL ENCLOSURE, CONTRACTOR SHALL PROVIDE ALL BLOCKING AS REQUIRED FOR WALL MOUNTED ITEMS. THIS SHALL INCLUDE, BUT NOT BE LIMITED TO: ALL CONTRACTOR, TENANT/OWNER, AND TENANT/OWNER VENDOR SUPPLIED ITEMS.
- COORDINATE FINAL LOCATIONS OF OWNER AND THIRD PARTY VENDOR FURNISHED ITEMS IN THE FIELD WITH TENANT/OWNER REP AND THE VENDOR.
- UNLESS INDICATED OTHERWISE, ALL BLOCKING SHALL BE ENCLOSED INSIDE FINISH CONSTRUCTION.
- BLOCKING AT DRY LOCATIONS: FIRE RETARDANT TREATED WOOD BLOCKING.
- BLOCKING AT WET LOCATIONS: GALVANIZED METAL STRAP BLOCKING, AS PROVIDED BY METAL STUD SUPPLIER/FABRICATOR.
- CONTRACTOR SHALL PROVIDE ALL NECESSARY FRAMING TO ACCOMMODATE THE FINAL LAYOUTS SHOWN FOR ALL FINISHES SHOWN IN THE ARCHITECTURAL AND ID DRAWINGS.
- ALL FIRE RATED PARTITIONS SHALL BE EFFECTIVELY AND PERMANENTLY IDENTIFIED WITH SIGNS OR STENCILING. SUCH IDENTIFICATION SHALL BE ABOVE ANY DECORATIVE CEILING AND IN CONCEALED SPACES. IDENTIFY WITH THE FOLLOWING TEXT: "XX" HOUR RATED FIRE/SMOKE BARRIER. PROTECT ALL OPENINGS AND PENETRATIONS. CONFIRM HOURLY RATING WITH FIRE RESISTANCE RATING OF WALL. AT LOCATIONS WHERE THERE ARE NO CEILINGS OR CONCEALED SPACES, COORDINATE SIGNAGE REQUIREMENT WITH THE AUTHORITY HAVING JURISDICTION (AHJ). AT THESE LOCATIONS, IF SIGNAGE IS REQUIRED BY THE AHJ, CONFIRM WITH TENANT/OWNER IF THEY PREFER SIGNS OR STENCILING.

UNLESS INDICATED OTHERWISE IN THESE DRAWINGS, ALL INTERIOR FINISHES ARE BY THE OWNER. INTERIOR FINISH WORK PROVIDED BY THE CONTRACTOR SHALL INCLUDE, BUT NOT BE LIMITED TO:

- ALL KITCHEN FINISHES.
- ALL JANITORS CLOSET FINISHES.
- ALL STORAGE ROOM FINISHES.
- ALL WOOD TRIM AND FRAMES AT DOORS, WINDOWS, AND CASED OPENINGS.

SEE DRAWINGS FOR FULL EXTENT.

LEGEND

- WALL MOUNTED FIRE EXTINGUISHER AND BRACKET LOCATION. SEE 2/A101A.
- RECESSED/SEMI-RECESSED FIRE EXTINGUISHER AND CABINET LOCATION. SEE 2/A101A.
- SURFACE MOUNT FIRE EXTINGUISHER AND CABINET LOCATION. SEE 2/A101A.

KEYNOTES

- PROPOSED FIRE DEPARTMENT KNOX BOX LOCATION. CONFIRM FINAL LOCATION WITH THE LOCAL AUTHORITY HAVING JURISDICTION.
- ROOF HATCH LADDER LOCATION. ROYALTY ALUMINUM ELSD WITH SECURITY DOOR. MAINTAIN MINIMUM WALL DISTANCE FROM WALL REQUIRED BY MANUFACTURER, PROVIDE EXTENDED BRACKETS AS REQUIRED. AT EPS PROVIDE FIRE RETARDANT TREATED WOOD BLOCKING, CONCEALED IN WALL FRAMING. PROVIDE SMALL DIAMETER STEEL TUBES THROUGH THE EPS TO PREVENT CRUSHING, SIZE AS REQUIRED FOR THE ANCHOR BOLTS.
- STRUCTURAL BUILDING FRAME BRACE LOCATION, SEE STRUCTURAL DRAWINGS.
- CASEWORK, BY OWNER'S VENDOR. N.L.C.
- IN THIS ROOM, PROVIDE SLIP RESISTANT QUARRY TILE. DALTILE QUETREAD 6"x6"x1/2" TEXTURED FINISH SET IN QUARTER TURN PATTERN, COLOR 0092 GRAY, OR EQUAL. THINSET WITH EPOXY GROUT. GROUT COLOR SHALL MATCH TILE COLOR. INCLUDE 6"x6" SANITARY COVE BASE TRIM IN SAME COLOR AND GROUT. INSTALL PER TCA F122. PROVIDE WITH WATERPROOF MEMBRANE, RETURN MEMBRANE BEHIND WALL BASE TILES. USE ANTI-MICROBIAL EPOXY GROUT.
- IN THIS ROOM, PROVIDE FRP PANEL SYSTEM AT ALL WALLS OF THE ROOM. PROVIDE MARLITE STANDARD FRP 4'-0"x6'-0"x3/32" SHEETS OR EQUAL. INCLUDE ALL REQUIRED TRIM AND ACCESSORIES. COLOR AS SELECTED BY OWNER. SEAL TO ADJACENT CONSTRUCTION WITH ANTI-MICROBIAL WHITE SILICONE JOINT SEALANT. PANELS SHALL BE CONTINUOUS FROM TOP OF WALL BASE TO UNDERSIDE OF CEILING ABOVE AND SHALL BE ONE PIECE VERTICALLY. WHERE KITCHEN EQUIPMENT VENDOR IS PROVIDING STAINLESS STEEL WALL PANELS, OMIT THE FRP PANEL SYSTEM.
- IN THIS ROOM, PROVIDE 1/2" FIRE RETARDANT TREATED PLYWOOD BLOCKING FROM 3'-0" A.F.F. TO 7'-0" A.F.F. FOR EQUIPMENT ATTACHMENT. CONCEAL ALL PLYWOOD BLOCKING IN STUD FRAMING.
- WALL FURNISH AT THIS LOCATION TO CONCEAL UTILITIES. ALIGN FINISH FACE OF WALL FURNISH WITH FINISH FACE OF WOOD TRIM AT WINDOWS, V.I.F.
- ROOF DRAIN LINES; SEE PLUMBING.
- CONDUCTOR/DOWNSPOUT LOCATION.
- AT THIS LOCATION, PROVIDE 5/8" CEMENT BOARD FROM FINISH FLOOR TO 1" BELOW UNDERSIDE OF COUNTERTOP. PROVIDE FRP PANEL SYSTEM FROM TOP OF WALL BASE TILE TO UNDERSIDE OF COUNTER. CONFIRM FINAL EXTENTS WITH OWNER AND KITCHEN EQUIPMENT VENDOR.
- IN THE WALK-IN, PROVIDE SLIP RESISTANT QUARRY TILE WITH FLEXIBLE SETTING BED AND GROUT.
 - INSTALL TILE AT ROOM TEMPERATURE. DO NOT INSTALL TILE IN CHILLED WALK-IN.
 - DALTILE QUETREAD 6"x6"x1/2" TEXTURED FINISH SET IN QUARTER TURN PATTERN, COLOR 0092 GRAY, OR EQUAL. INCLUDE 6"x6" SANITARY COVE BASE TRIM IN SAME COLOR AND GROUT.
 - INSTALL OVER SEPARATION SHEET.
 - FLEXIBLE SETTING BED: MAPEI PANOCRETE W.
 - FLEXIBLE EPOXY GROUT: MAPEI KERAPoxy CO. THINSET WITH EPOXY GROUT. GROUT COLOR SHALL MATCH TILE COLOR.
 - PROVIDE 1/2" COLD JOINT BETWEEN WALK-IN TILE AND KITCHEN TILE. PROVIDE JOINT SEALANT IN JOINT.
 - SEAL TOP OF WALL BASE AND JOINT BETWEEN WALK-IN FLOOR AND KITCHEN FLOOR WITH MAPEI MAPESIL T JOINT SEALANT.
 - TCA DOES NOT HAVE A SPECIFIC INSTALLATION DETAIL FOR WALK-INS, BUT IT WILL BE SIMILAR TO F122.
- SEE 5.6.8.7/A401 FOR SCREEN WALL DETAILS.

WALL AND CEILING SHEATHING SCHEDULE

- EXTERIOR SHEATHING
- 1/2" GLASS MAT FACED EXTERIOR GYPSUM SHEATHING BOARD.
 - TAPE AND SEAL ALL SEAMS.
 - NOTE: WHERE INDICATED IN THE DOCUMENTS, AND AT ALL FLASHING/TRIM LOCATIONS SECURED TO THE WALL, PROVIDE 1/2" FIRE RETARDANT TREATED PLYWOOD SHEATHING.
 - NOTE: PROVIDE 1/2" FIRE RETARDANT TREATED PLYWOOD SHEATHING BEHIND ALL BUILDING MOUNTED SIGNAGE. COORDINATE EXTENT AND LOCATION IN FIELD WITH OWNER AND OWNER'S SIGNAGE VENDOR.

- TYPICAL INTERIOR ROOMS
- 5/8" GYPSUM BOARD.
 - TAPE AND SEAL ALL JOINTS. USE DRYING TYPE COMPOUND AND TAPE. PROVIDE LEVEL 4 FINISH.

- KITCHEN AND JANITORS CLOSET
- 1/2" CEMENT BOARD.
 - PREP CEMENT BOARD AS REQUIRED TO RECEIVE FRP FINISH BOARD.

- STORAGE ROOMS
- 1/2" FIRE RETARDANT TREATED PLYWOOD SHEATHING.
 - PREP PLYWOOD AS REQUIRED TO RECEIVE FRP FINISH BOARD.

- RESTROOMS
- BEHIND TILE: 5/8" GLASS MAT FACED MOLD AND MOISTURE RESISTANT TILE BACKER BOARD. PREPARE AS REQUIRED TO RECEIVE TILE FINISHES.
 - EXPOSED GYPSUM BOARD: 5/8" GYPSUM BOARD. TAPE AND SEAL ALL JOINTS. USE DRYING TYPE COMPOUND AND TAPE. PROVIDE LEVEL 4 FINISH.

- FIRST FLOOR PATIO
- BEHIND TILE: 5/8" GLASS MAT FACED MOLD AND MOISTURE RESISTANT GYPSUM BOARD. USC MOLD TOUGH, OR EQUAL.
 - TAPE AND SEAL ALL JOINTS. USE SETTING TYPE COMPOUND AND TAPE.

WALL TYPES SCHEDULE

- WALL TYPE A4 - FULL HEIGHT SHEATHING, ACOUSTICAL INSULATION
- 3 5/8" METAL STUDS AT 16" O.C., FULL HEIGHT TO UNDERSIDE OF DECK ABOVE. GAUGE AS REQUIRED FOR HEIGHT.
 - 3 1/2" ACOUSTIC BATT INSULATION, FULL HEIGHT TO UNDERSIDE OF DECK ABOVE.
 - SCHEDULED SHEATHING, FULL HEIGHT TO UNDERSIDE OF DECK ABOVE, BOTH SIDES OF WALL. SEE WALL AND CEILING SCHEDULE ABOVE FOR TYPE BY LOCATION.

- WALL TYPE A6 - FULL HEIGHT SHEATHING, ACOUSTICAL INSULATION
- 6" METAL STUDS AT 16" O.C., FULL HEIGHT TO UNDERSIDE OF DECK ABOVE. GAUGE AS REQUIRED FOR HEIGHT.
 - 3 1/2" ACOUSTIC BATT INSULATION, FULL HEIGHT TO UNDERSIDE OF DECK ABOVE.
 - SCHEDULED SHEATHING, FULL HEIGHT TO UNDERSIDE OF DECK ABOVE, BOTH SIDES OF WALL. SEE WALL AND CEILING SCHEDULE ABOVE FOR TYPE BY LOCATION.

- WALL TYPE A8 - FULL HEIGHT SHEATHING, ACOUSTICAL INSULATION
- 8" METAL STUDS AT 16" O.C., FULL HEIGHT TO UNDERSIDE OF DECK ABOVE. GAUGE AS REQUIRED FOR HEIGHT.
 - 3 1/2" ACOUSTIC BATT INSULATION, FULL HEIGHT TO UNDERSIDE OF DECK ABOVE.
 - SCHEDULED SHEATHING, FULL HEIGHT TO UNDERSIDE OF DECK ABOVE, BOTH SIDES OF WALL. SEE WALL AND CEILING SCHEDULE ABOVE FOR TYPE BY LOCATION.

- WALL TYPE B4 - PARTIAL HEIGHT SHEATHING, ACOUSTICAL INSULATION
- 5 5/8" METAL STUDS AT 16" O.C., FULL HEIGHT TO UNDERSIDE OF DECK ABOVE. GAUGE AS REQUIRED FOR HEIGHT.
 - 3 1/2" ACOUSTIC BATT INSULATION, TO 6" ABOVE HIGHEST CEILING.
 - SCHEDULED SHEATHING, TO 6" ABOVE HIGHEST CEILING. SEE WALL AND CEILING SCHEDULE ABOVE FOR TYPE BY LOCATION.

- WALL TYPE B6 - PARTIAL HEIGHT SHEATHING, ACOUSTICAL INSULATION
- 6" METAL STUDS AT 16" O.C., FULL HEIGHT TO UNDERSIDE OF DECK ABOVE. GAUGE AS REQUIRED FOR HEIGHT.
 - 3 1/2" ACOUSTIC BATT INSULATION, TO 6" ABOVE HIGHEST CEILING.
 - SCHEDULED SHEATHING, TO 6" ABOVE HIGHEST CEILING. SEE WALL AND CEILING SCHEDULE ABOVE FOR TYPE BY LOCATION.

- WALL TYPE C6 - PARTIAL HEIGHT SHEATHING, NO INSULATION
- 6" METAL STUDS AT 16" O.C., FULL HEIGHT TO UNDERSIDE OF DECK ABOVE. GAUGE AS REQUIRED FOR HEIGHT.
 - SCHEDULED SHEATHING, TO 6" ABOVE HIGHEST CEILING. SEE WALL AND CEILING SCHEDULE ABOVE FOR TYPE BY LOCATION.

- WALL TYPE D6 - FULL HEIGHT SHEATHING, THERMAL INSULATION
- 6" METAL STUDS AT 16" O.C., FULL HEIGHT TO UNDERSIDE OF DECK ABOVE. 16 GAUGE AT THESE WALLS.
 - R21 UNFACED THERMAL BATT INSULATION, FULL HEIGHT TO UNDERSIDE OF DECK ABOVE.
 - SCHEDULED SHEATHING, FULL HEIGHT TO UNDERSIDE OF DECK ABOVE, BOTH SIDES OF WALL. SEE WALL AND CEILING SCHEDULE ABOVE FOR TYPE BY LOCATION.
 - AT PATIO SIDE OF WALL, INSTALL AIR-WEATHER BARRIER OVER STUDS, BEHIND WALL SHEATHING.

- WALL TYPE E6 - FULL HEIGHT SHEATHING, THERMAL INSULATION
- 6" METAL STUDS AT 16" O.C., FULL HEIGHT TO UNDERSIDE OF DECK ABOVE. 16 GAUGE AT THESE WALLS.
 - SCHEDULED SHEATHING, FULL HEIGHT TO UNDERSIDE OF DECK ABOVE, EXPOSED SIDE OF WALL ONLY. SEE WALL AND CEILING SCHEDULE ABOVE FOR TYPE BY LOCATION.

No.	Description	Date
1	WALL TYPE A4 - FULL HEIGHT SHEATHING, ACOUSTICAL INSULATION	03-14-2022
2	WALL TYPE A6 - FULL HEIGHT SHEATHING, ACOUSTICAL INSULATION	03-14-2022
3	WALL TYPE A8 - FULL HEIGHT SHEATHING, ACOUSTICAL INSULATION	03-14-2022
4	WALL TYPE B4 - PARTIAL HEIGHT SHEATHING, ACOUSTICAL INSULATION	03-14-2022
5	WALL TYPE B6 - PARTIAL HEIGHT SHEATHING, ACOUSTICAL INSULATION	03-14-2022
6	WALL TYPE C6 - PARTIAL HEIGHT SHEATHING, NO INSULATION	03-14-2022
7	WALL TYPE D6 - FULL HEIGHT SHEATHING, THERMAL INSULATION	03-14-2022
8	WALL TYPE E6 - FULL HEIGHT SHEATHING, THERMAL INSULATION	03-14-2022

Sheet Name: FIRST FLOOR PLAN		Issue Date: 03-14-2022	
Proj #: 211201		Issue Date: 03-14-2022	
Sheet No.:		A101	
Drawn By: KC	Checked By: KC/SA		

GENERAL SHEET NOTES

1. SEE A101 FOR GENERAL SHEET NOTES.
2. COORDINATE ALL TOILET AND BATHROOM ACCESSORY INSTALLATION WITH OWNER PROVIDED FINISH WORK IN ROOM.

KEYNOTES

1. 6" CONCRETE EQUIPMENT PAD AT HOT WATER TANK. PROVIDE WITH WELDED WIRE FABRIC, DOWEL INTO FLOOR SLAB. COORDINATE FINAL SIZE WITH TANK.

TOILET AND BATHROOM ACCESSORIES


- A. FLOOR MOUNTED, OVERHEAD BRACED TOILET PARTITIONS AND DOORS. GENERAL PARTITIONS SERIES 40 HIGH DENSITY POLYMER FLOOR SUPPORTED - HEAVYDUTY. COLOR AS SELECTED BY OWNER FROM MANUFACTURER'S FULL RANGE. BY G.C.
B. WALL HUNG URINAL SCREENS. GENERAL PARTITIONS SERIES 40 HIGH DENSITY POLYMER WALL MOUNTED. COLOR AS SELECTED BY OWNER FROM MANUFACTURER'S FULL RANGE. BY G.C.
C. GRAB BAR-42" LONG HORIZ. BOBRICK B5806x42, SATIN FINISH, OR EQUAL. BY G.C.
D. GRAB BAR-36" LONG HORIZ. BOBRICK B5806-36, SATIN FINISH, OR EQUAL. BY G.C.
E. GRAB BAR-18" LONG VERT. BOBRICK B5806-18, SATIN FINISH, OR EQUAL. BY G.C.
F. CLOTHES HOOK/DOOR STOP, PROVIDED AS PART OF TOILET PARTITION SYSTEM. BY G.C.
G. TOILET PAPER DISPENSER, TOILET SEAT COVER DISPENSER, AND WASTE RECEPTACLE UNIT(S). BY OWNER. COMPLY WITH ADA MOUNTING HEIGHT AND LOCATION REQUIREMENTS.
H. BABY CHANGING STATION. BOBRICK KOALA KARE KB110-SSRE HORIZONTAL STAINLESS STEEL RECESS MOUNTED, OR EQUAL.
I. NOT USED.
J. ADA COMPLIANT LAVATORY COUNTER. BY G.C. (SEE 1,2,3,8,4/A401)
K. MIRROR, BY G.C. (SEE 1,2,3,8,4/A401)
L. UNDERCOUNTER WASTE BASKET, (RUBBERMAID 410T LARGE WASTEBASKET BLACK, MODEL FG29700BK, BY G.C.)
M. PAPER TOWEL DISPENSER. BY OWNER. COMPLY WITH ADA MOUNTING HEIGHT AND LOCATION REQUIREMENTS.
N. SOAP DISPENSER. BY OWNER. COMPLY WITH ADA MOUNTING HEIGHT AND LOCATION REQUIREMENTS.

- FIRE EXTINGUISHER GENERAL NOTES:
- LOCATIONS AND QUANTITIES OF FIRE EXTINGUISHERS SHOWN ON THE PLANS ARE BASED UPON A 50FT TRAVEL RADIUS AND 3,000 S.F. AREA. SHOULD THE AUTHORITY HAVING JURISDICTION REQUIRE ADDITIONAL LOCATIONS, OR DIFFERING LOCATIONS FROM THOSE SHOWN IN THESE DOCUMENTS, REVIEW THE REVISIONS WITH THE ARCHITECT AND THE OWNER'S REPRESENTATIVE PRIOR TO PROCEEDING.
 - ALL FIRE EXTINGUISHER CABINETS THROUGHOUT THE BUILDING SHALL BE THE SAME TYPE/STYLE. COORDINATE CABINET TYPES ANY FIRE EXTINGUISHER FRAME PROTRUSIONS REQUIRED PRIOR TO SUBMITTING SHOP DRAWINGS AND ORDERING.
 - AT ALL NET LOCATIONS, PROVIDE CLEAR ANODIZED ALUMINUM FIRE EXTINGUISHER CABINETS. AT ALL OTHER LOCATIONS, PROVIDE BAKED ENAMEL ON MANUFACTURER'S STANDARD STEEL BODY.
 - WHERE FIRE EXTINGUISHERS ARE INDICATED TO BE INSTALLED IN A RATED WALL, PROVIDE FIRE RATE FIRE EXTINGUISHER CABINETS.
 - MINIMUM FIRE EXTINGUISHER RATING REQUIRED BY CODE IS 2A-20BC (MODERATE HAZARD). SIZE INDICATED IS SPECIFIC TO THE MANUFACTURER'S AVAILABLE SIZES FOR THE SPECIFIED CABINET. SUBSTITUTIONS ARE ACCEPTABLE PROVIDED THEY MEET THE PERFORMANCE CRITERIA AND CABINET CLEAR INSIDE BOX DIMENSIONS.
 - CONFIRM FINAL QUANTITIES AND LOCATIONS WITH THE AUTHORITY HAVING JURISDICTION. NOTIFY ARCHITECT OF ANY CHANGES PRIOR TO PROCEEDING WITH THE WORK.


- INTERIOR FIRE EXTINGUISHER CABINET SPECIFICATIONS:
- LARSEN'S ARCHITECTURAL SERIES, MODEL2409-SR, SEMI-RECESSED. OR EQUAL, MATCHING THESE CRITERIA.
 - FACE DIMENSIONS: 27 1/2"x13"W
 - TRIM PROJECTION: 1 1/2", SQUARE EDGE.
 - INSIDE BOX DIMENSIONS: 24"x9 1/2"x5"D.
 - WHITE ENAMEL STEEL. FIELD PAINT TO MATCH ADJACENT WALL COLOR.
 - SOLID DOOR.
 - BLACK, VERTICAL, DIE-CUT LETTERING. DO NOT APPLY IN FACTORY, SHIP LOOSE FOR APPLICATION IN FIELD AFTER FIELD PAINTING OF CABINET. CONFIRM FINAL COLOR IS ACCEPTABLE TO THE AUTHORITY HAVING JURISDICTION PRIOR TO ORDERING.
 - PROVIDE WITH RECESSED HANDLE.
 - PROVIDE WITH LARSEN'S MPS-A MULTI-PURPOSE DRY CHEMICAL FIRE EXTINGUISHER (3A-40B:C). FIRE EXTINGUISHER IS 4 1/4"D, 15 1/4"H, AND HAS AN OVERALL WIDTH OF 7 1/4".

- EXTERIOR FIRE EXTINGUISHER CABINET SPECIFICATIONS:
- LARSEN'S ARCHITECTURAL SERIES, MODEL2409-SM SURFACE MOUNT. OR EQUAL, MATCHING THESE CRITERIA.
 - FACE DIMENSIONS: 27 1/2"x13"W
 - PROJECTION: 6".
 - INSIDE BOX DIMENSIONS: 24"x9 1/2"x5"D.
 - SATIN ALUMINUM.
 - SOLID DOOR.
 - BLACK, VERTICAL, DIE-CUT LETTERING.
 - PROVIDE WITH RECESSED HANDLE.
 - PROVIDE WITH LARSEN'S MPS-A MULTI-PURPOSE DRY CHEMICAL FIRE EXTINGUISHER (3A-40B:C). FIRE EXTINGUISHER IS 4 1/4"D, 15 1/4"H, AND HAS AN OVERALL WIDTH OF 7 1/4". CONFIRM TYPE IS ACCEPTABLE FOR EXTERIOR USE.

- WALL MOUNTED FIRE EXTINGUISHER AND BRACKET SPECIFICATIONS:
- TYPICAL LOCATIONS: LARSEN'S MPS-A MULTI-PURPOSE DRY CHEMICAL FIRE EXTINGUISHER (3A-40B:C). FIRE EXTINGUISHER IS 4 1/4"D, 15 1/4"H, AND HAS AN OVERALL WIDTH OF 7 1/4".
 - KITCHEN LOCATIONS: PROVIDE TYPE K FIRE EXTINGUISHERS IN SIZE, QUANTITY, AND LOCATIONS REQUIRED BY THE AUTHORITY HAVING JURISDICTION.
 - PROVIDE WITH LARSEN'S STANDARD BRACKET 1659

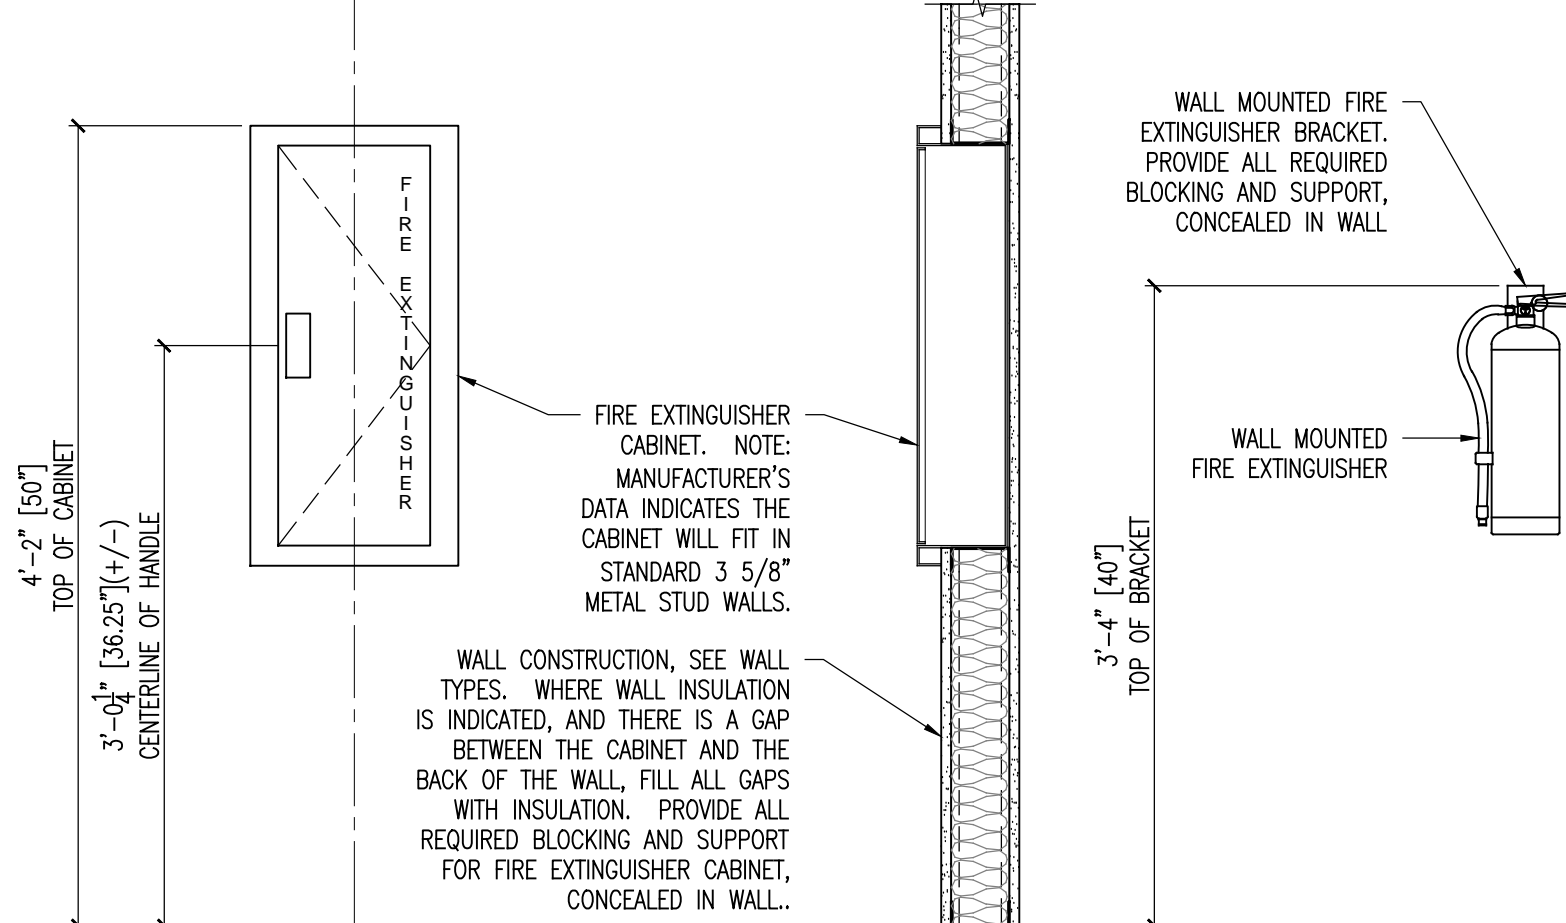


2 FIRE EXTINGUISHER AND CABINET DETAILS
1"=1'-0"

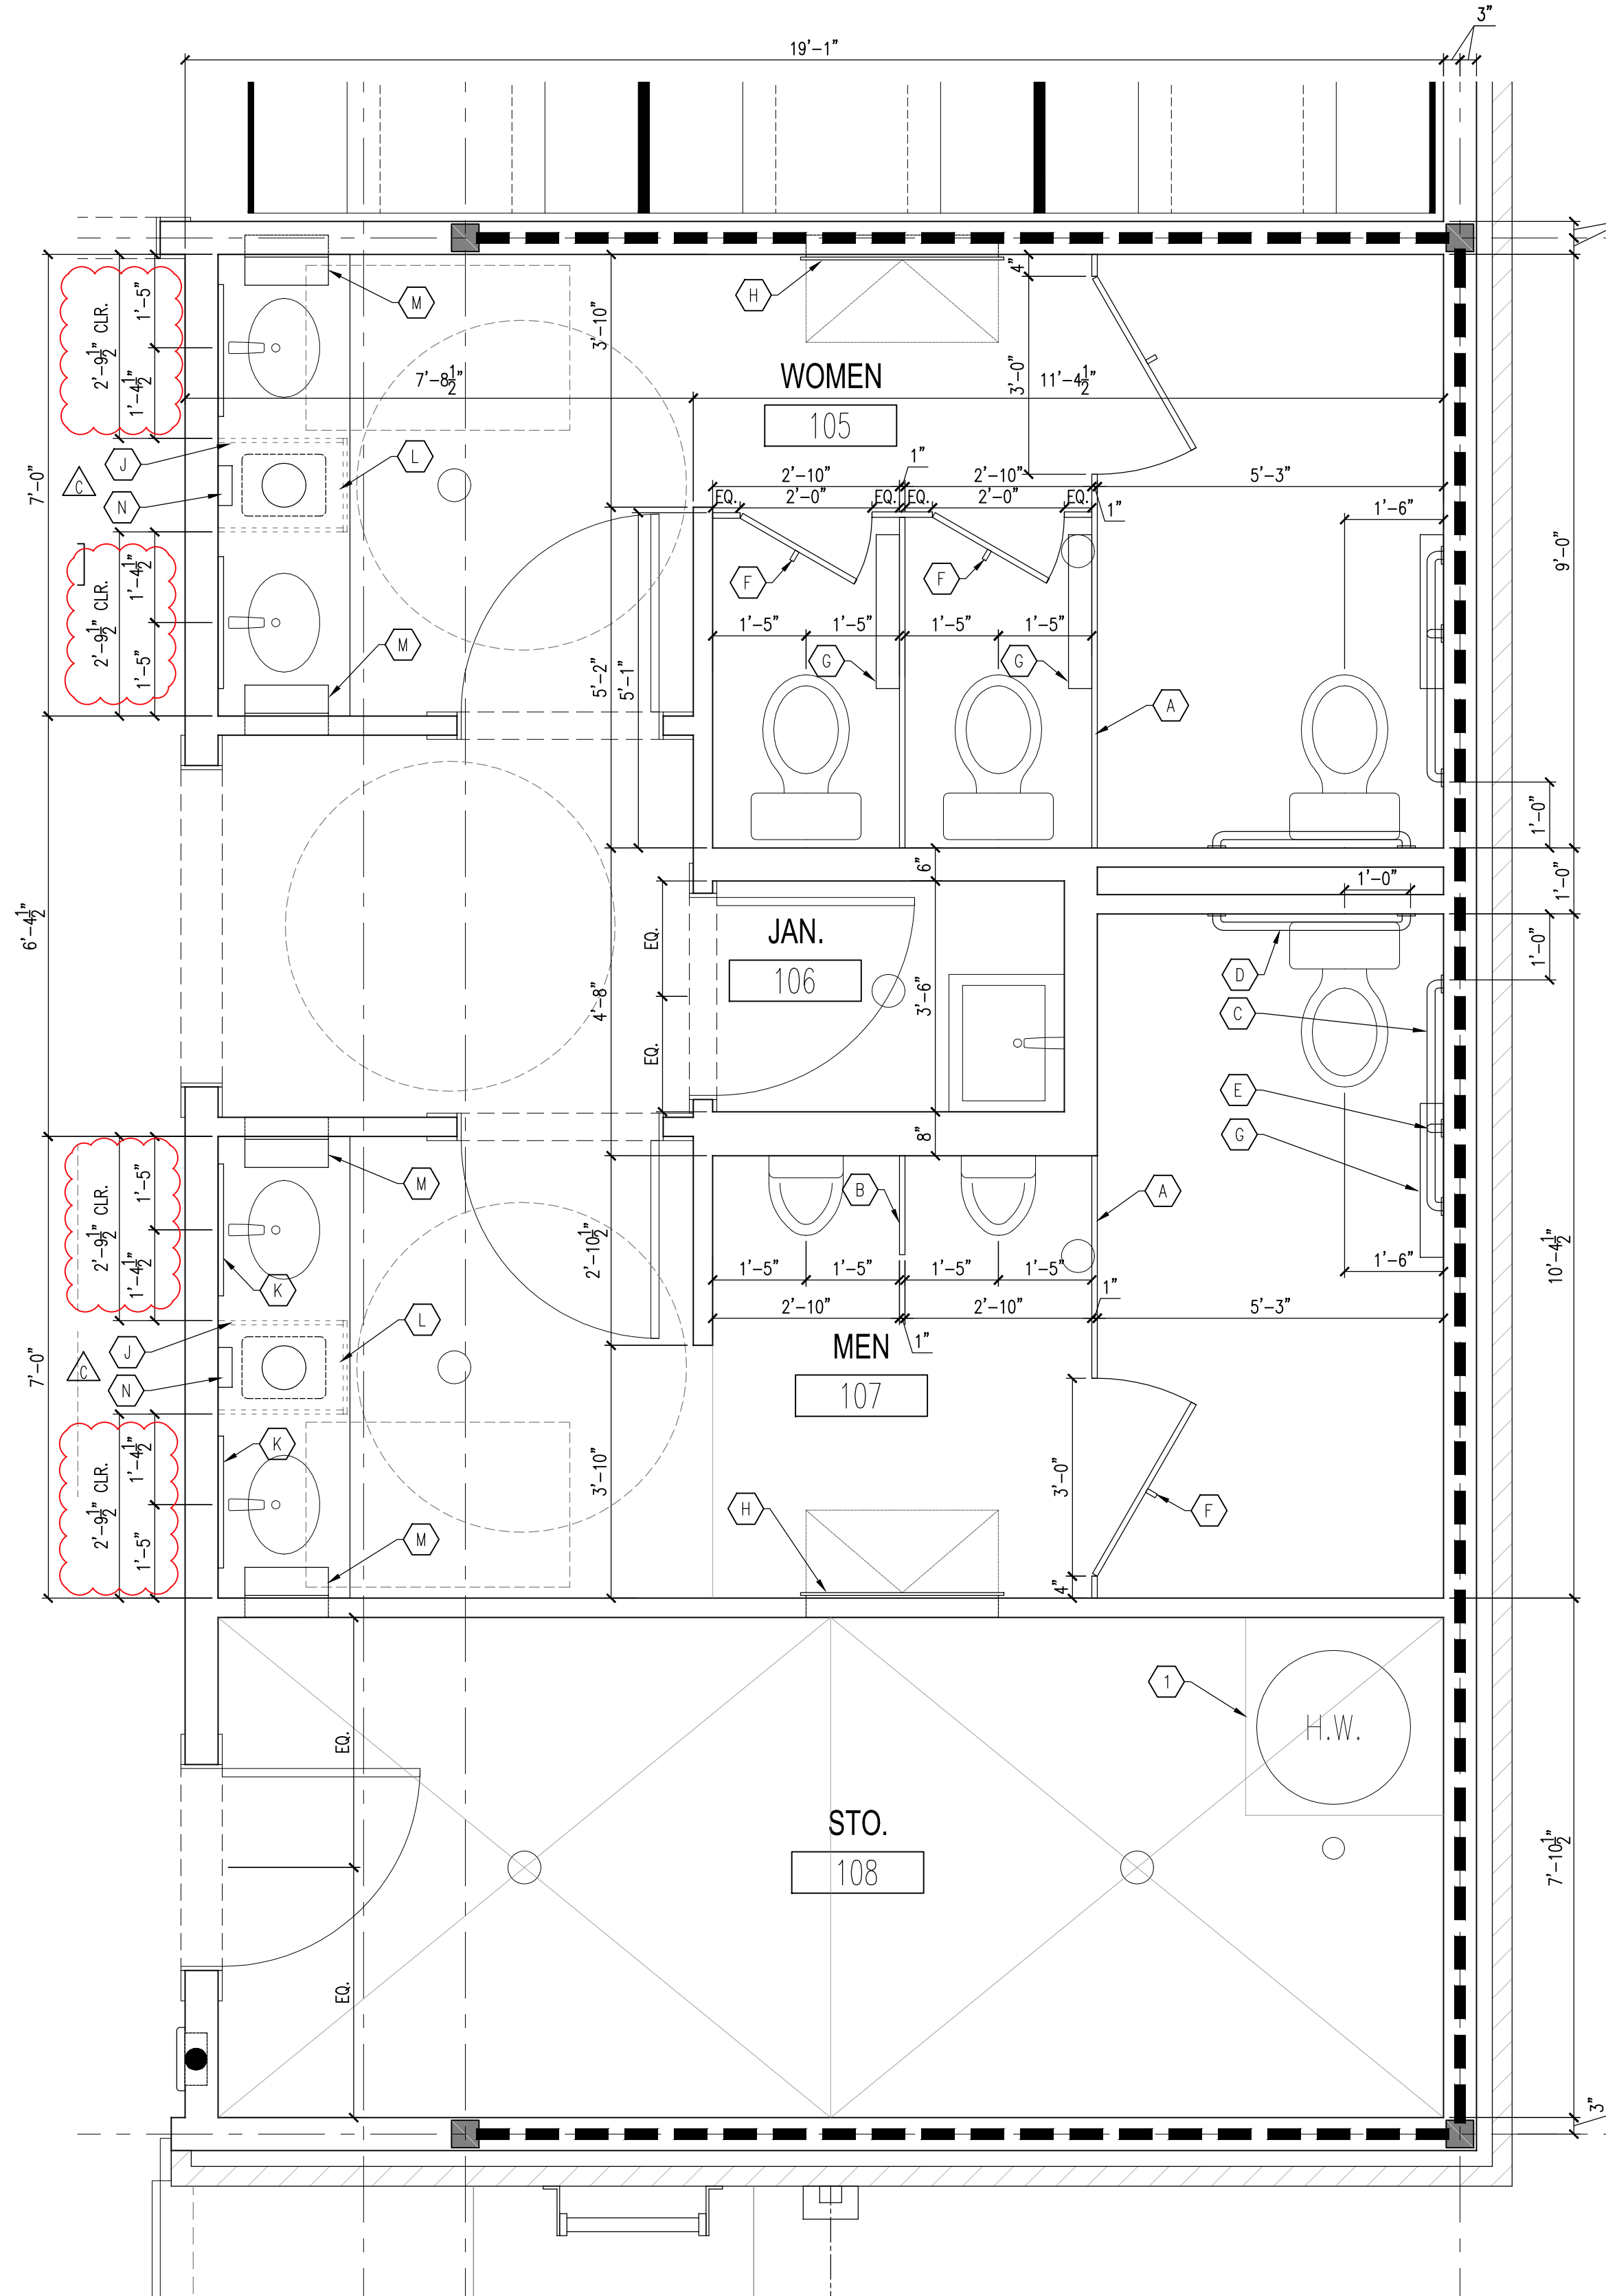

1 ENLARGED PLAN
1/4"=1'-0"

BY	DATE	BY	DATE
BD SET	03-14-2022	BD SET	03-14-2022
CLG SHOP ENG. CORRD. 1		CLG SHOP ENG. CORRD. 1	
CLG SHOP ENG. CORRD. 3	04-22-2022	CLG SHOP ENG. CORRD. 3	04-22-2022

Sheet Name: ENLARGED PLAN AND DETAILS		No.	Description	Date
Proj #:	Issue Date:			
211201	03-14-2022			
Sheet No.:		A101A		
Drawn By:	Checked By:			
KC	KC/SA			

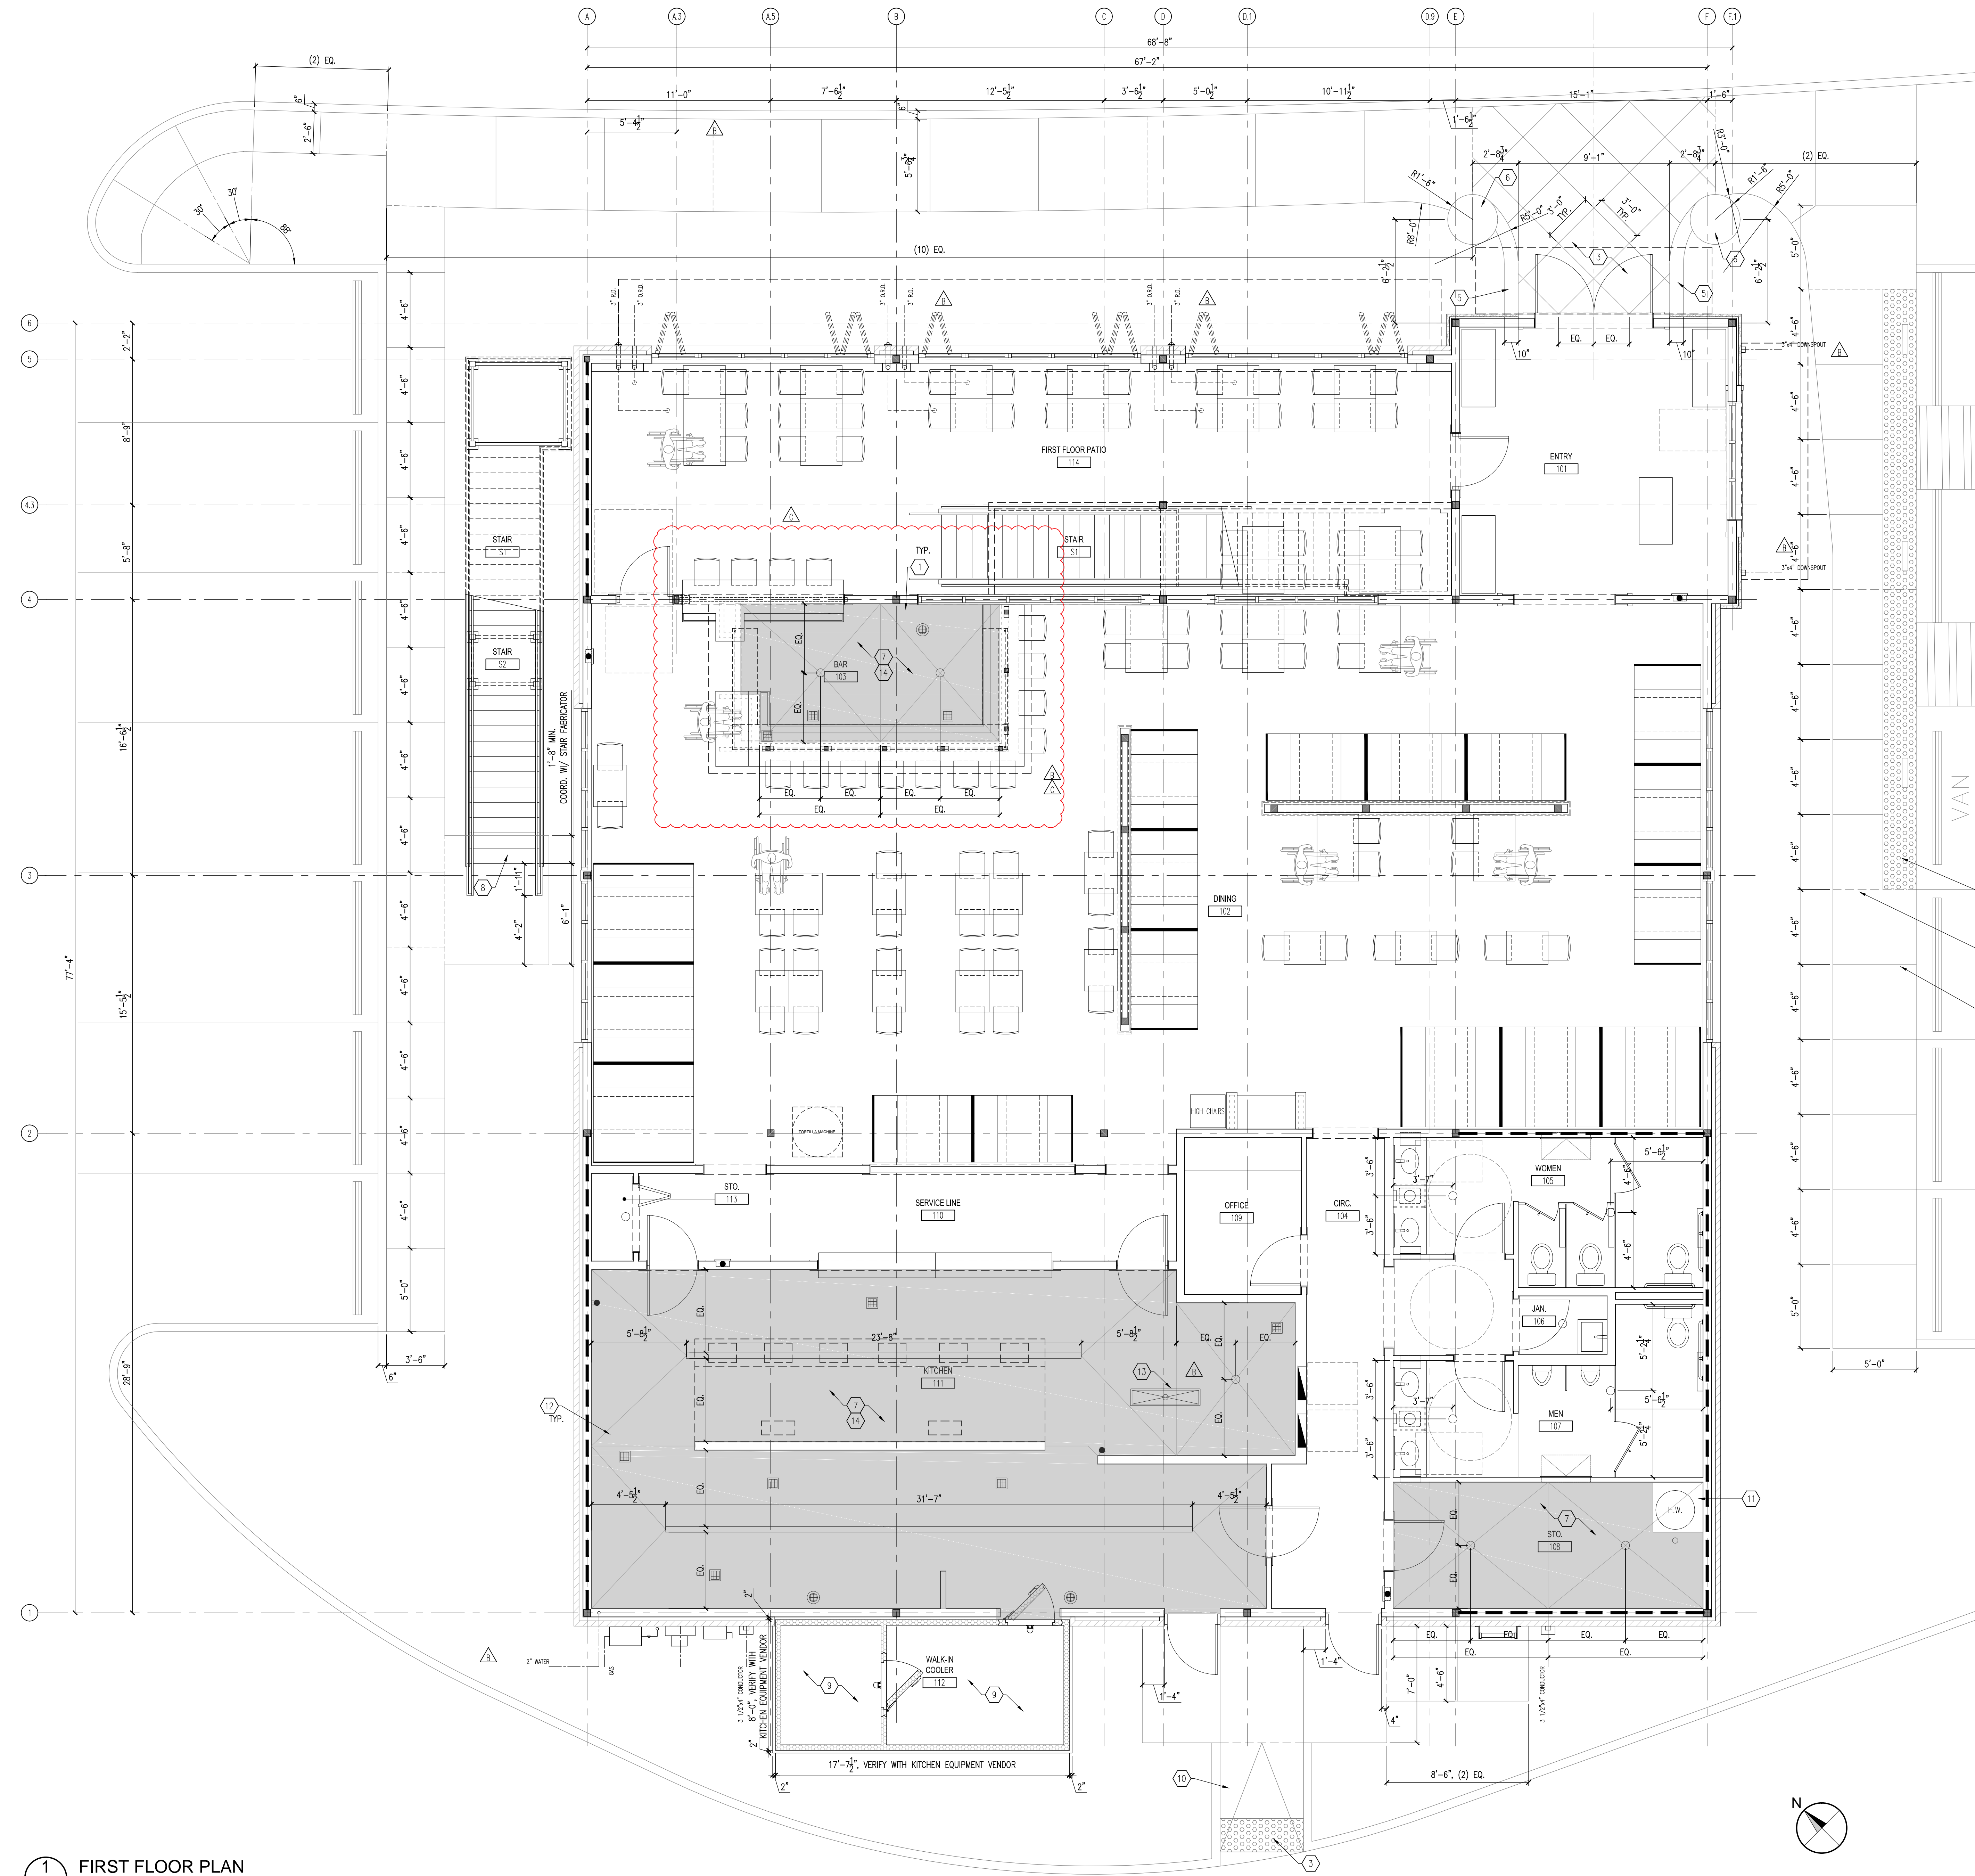

GENERAL SHEET NOTES

- SEE A101 FOR GENERAL SHEET NOTES.
- COORDINATE ALL UNDERGROUND UTILITY LOCATIONS WITH THE OWNER AND THE KITCHEN EQUIPMENT VENDOR.

KEYNOTES

- 1/2" SAWCUT CONCRETE CONTROL JOINT.
- 1/2" FORMED CONCRETE EXPANSION JOINT. SEAL JOINT WITH TRAFFIC RATED EXTERIOR SEALANT.
- ADA-COMPLIANT TACTILE WARNING STRIP. SEE CIVIL.
- 3'-0"x3'-0" DIAMOND JOINT PATTERN AT MAIN ENTRANCE. HAND TOOLED.
- CURB AT ENTRANCE: +6" ABOVE ADJACENT SIDEWALK. SET TOP LEVEL.
- PLANTER PEDESTAL AT ENTRANCE: +12" ABOVE ADJACENT SIDEWALK. SET TOP LEVEL.
- AT THIS LOCATION, INTEGRALLY SLOPE FLOORS TO DRAINS. 1/4" PER FOOT (MAX.).
- AT BOTTOM OF STAIR, PROVIDE THICKENED SLAB. SEE STRUCTURAL DRAWINGS. COORDINATE EXTENT WITH STAIR FABRICATOR.
- CONCRETE SLAB AT WALK-IN IS DEPRESSURED FOR INSULATED WALK-IN FLOOR, +/-4". CONFIRM WITH KITCHEN EQUIPMENT VENDOR PRIOR TO POURING.
- ADA COMPLIANT CURB RAMP WITH CURBED SIDES. COORDINATE WITH CIVIL.
- 6" REINFORCED CONCRETE EQUIPMENT SLAB. COORDINATE FINAL DIMENSIONS WITH FINAL EQUIPMENT REQUIREMENTS.
- FLOOR SINK LOCATION, COORDINATE ALL FINAL LOCATIONS AND QUANTITIES WITH KITCHEN EQUIPMENT VENDOR.
- THIS TRENCH DRAIN IS BY KITCHEN EQUIPMENT VENDOR. COORDINATE INSTALLATION AND LOCATION WITH KITCHEN EQUIPMENT VENDOR.
- COORDINATE FINAL LOCATIONS OF FLOOR SINKS AND HUB DRAINS IN THIS SPACE WITH KITCHEN EQUIPMENT VENDOR PRIOR TO INSTALLATION.

REV	DESCRIPTION	DATE
1	ISSUED FOR PERMIT	03-14-2022
2	FOR SHOP DRAWINGS	03-14-2022
3	FOR SHOP DRAWINGS	03-14-2022

Sheet Name:
SLAB AND HARDSCAPE PLAN

Proj #:
211201


Issue Date:
03-14-2022

Sheet No.:

A101B

Drawn By:
KC

Checked By:
KC/SA

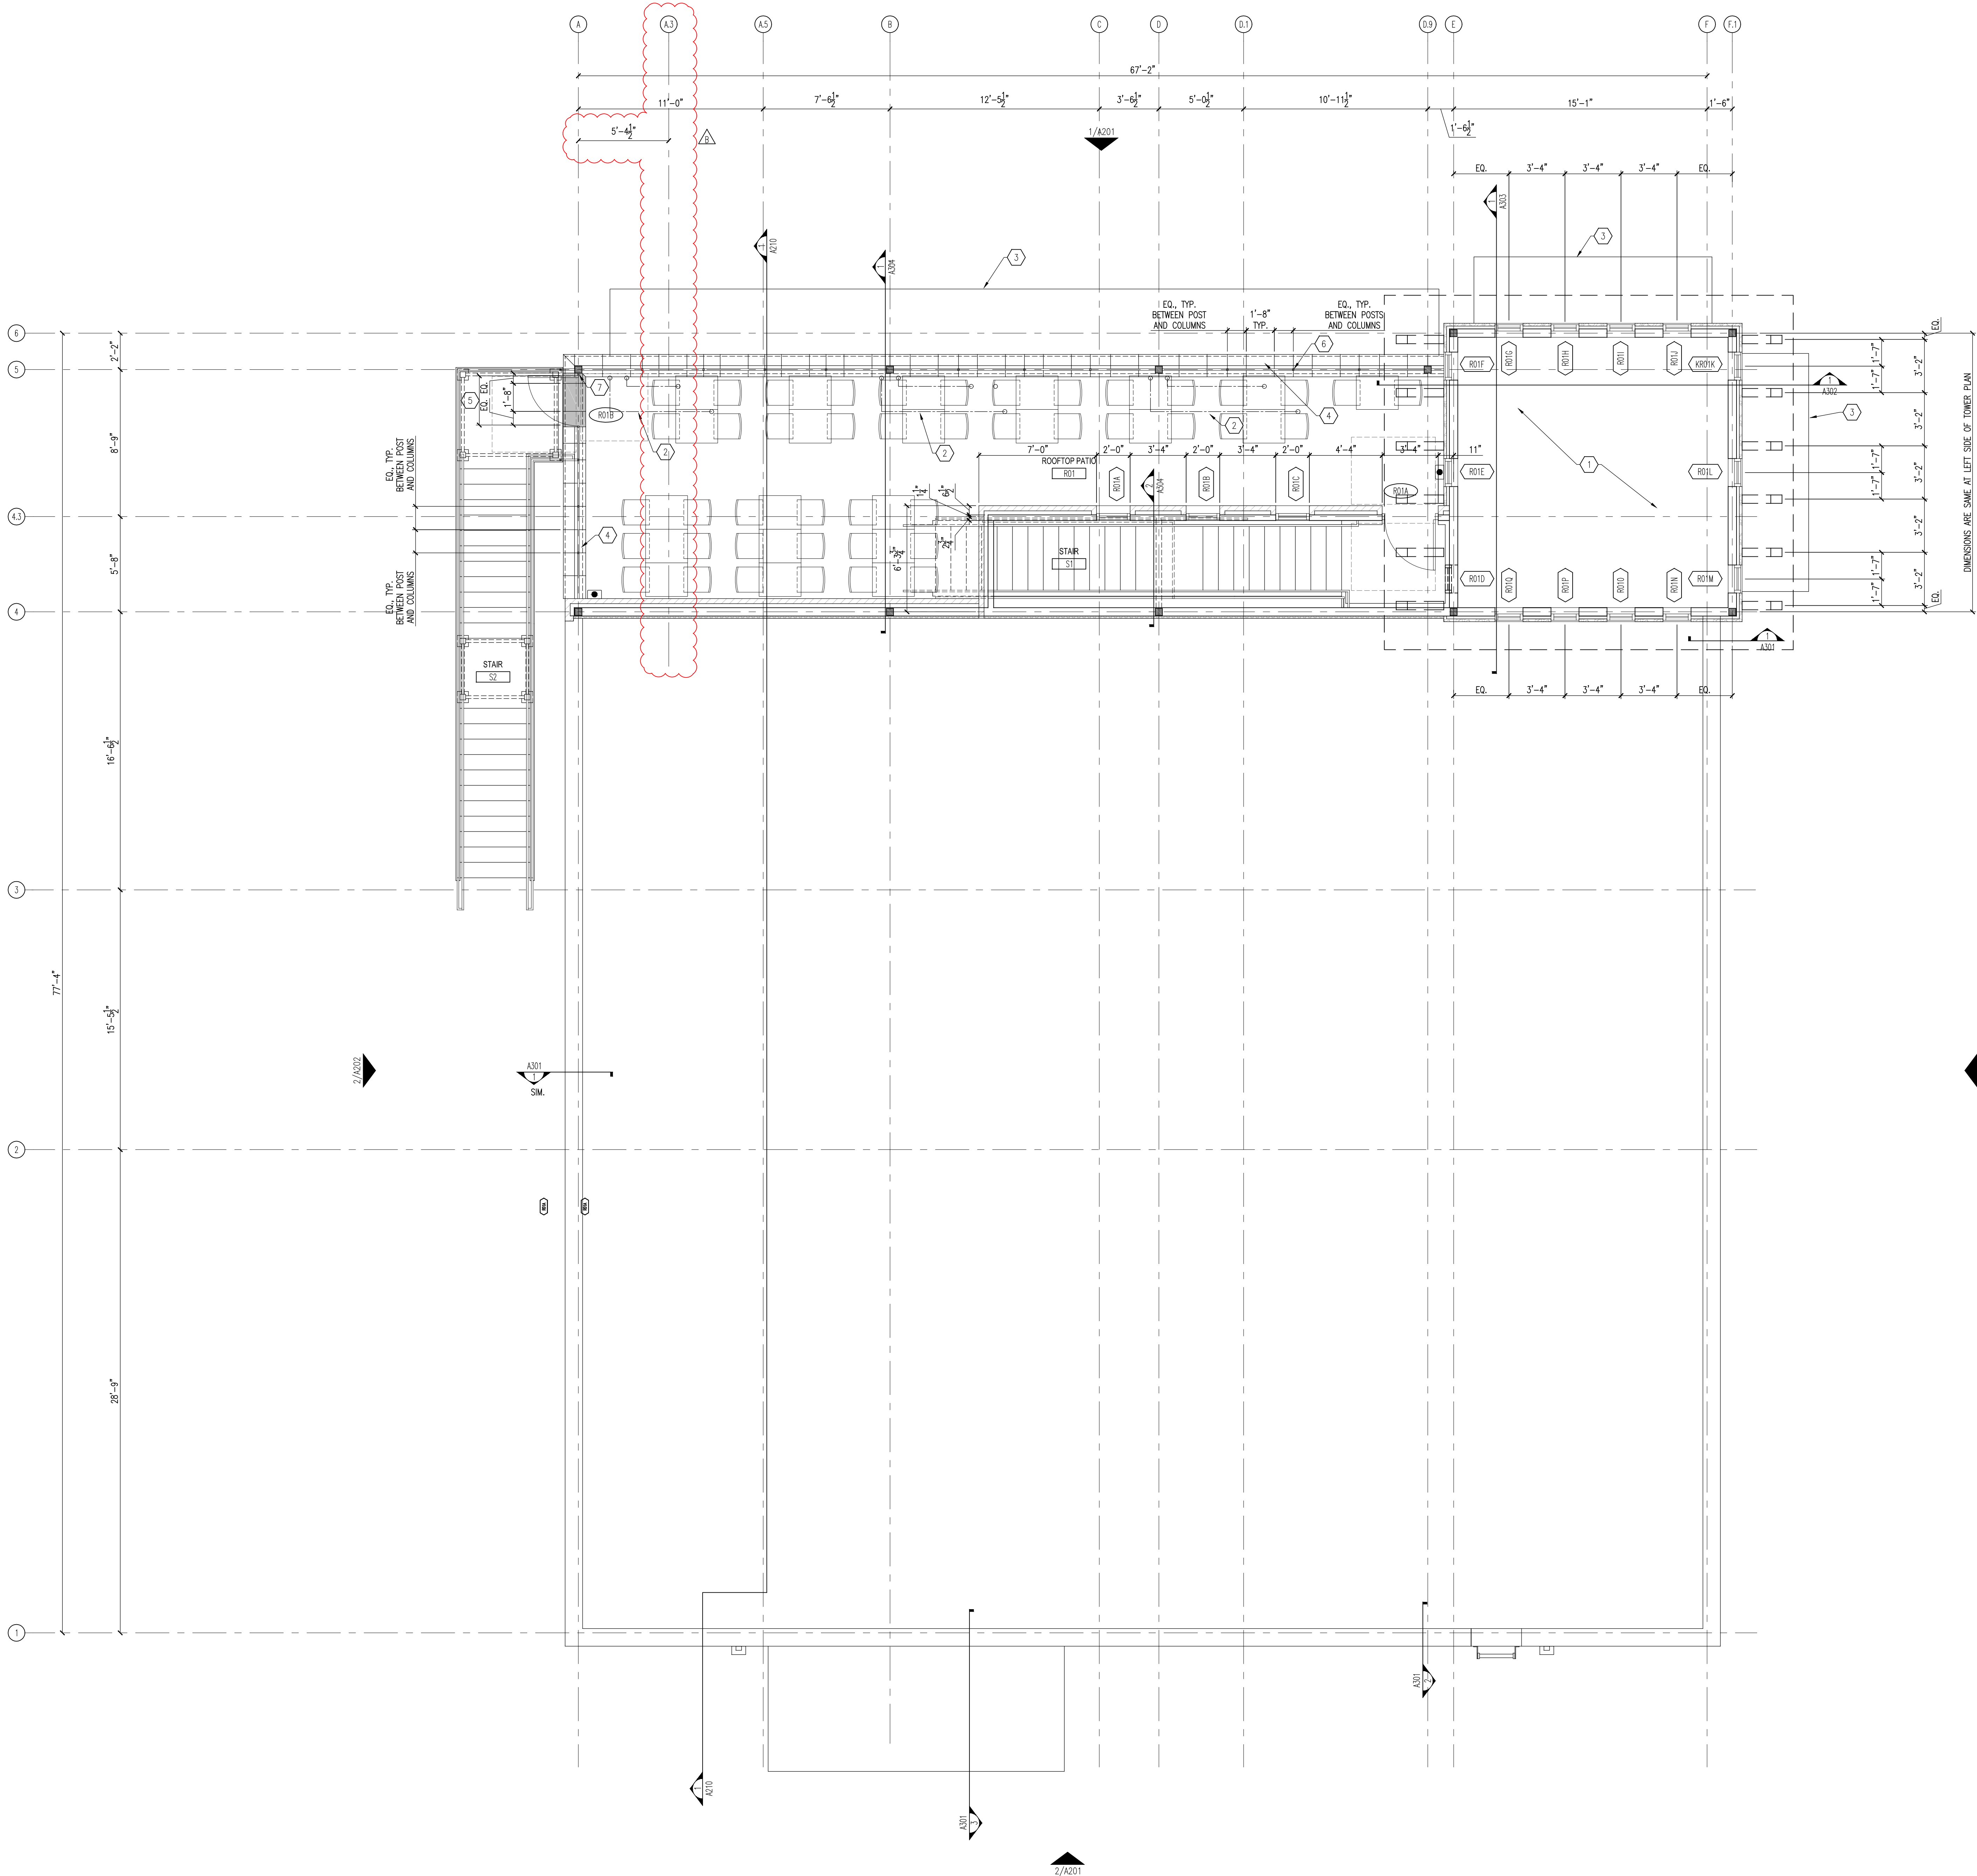


GENERAL SHEET NOTES

1. SEE A101 FOR GENERAL SHEET NOTES, LEGEND, AND WALL AND SHEATHING SCHEDULE.

KEYNOTES

- OPEN TO BELOW.
- ROOF DRAIN LINES BELOW SLAB, SHOWN FOR REFERENCE.
- WINDOW CANOPY BELOW.
- SLOPED CAPSTONE AT WALL PARAPET. SEE 1A3/A310.
- FLAT CAPSTONES AT STAIR ACCESS GATE. SEE 4/A310.
- GUARDRAIL POST LOCATION.
- AT GATE, PROVIDE 1 1/4" SQ. TUBE SPACE AT HINGE SIDE OF DOOR, CAP BOTH ENDS. LENGTH+HINGE LENGTH+1/2". PROVIDE (1) AT EACH GATE HINGE. WELD TO STEEL COLUMN.

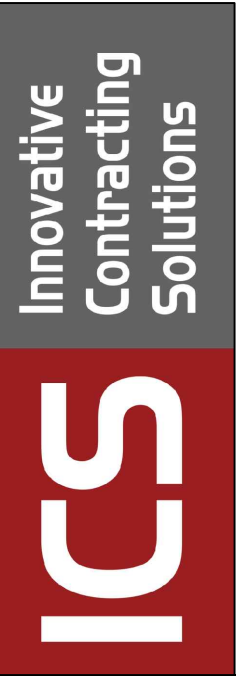


COPYRIGHT 2021/2022

7 TEQUILAS RESTAURANT
5586 OLD HIGHWAY 5 (OLD GEORGIA HIGHWAY 5 AND PAYNE ROAD)
WOODSTOCK, GEORGIA 30188

CONSTRUCTION COORDINATION DRAWINGS
PREPARED FOR INNOVATIVE CONTRACTING SOLUTIONS
5605 GLENDRIDGE DR. NE
SUITE 345 ATLANTA, GEORGIA 30342

REV	DESCRIPTION	DATE
1	ISSUED FOR PERMIT	03-14-2022
2	FOR SHOP DRAWING CORRECTION 1	03-14-2022
3	FOR SHOP DRAWING CORRECTION 2	03-14-2022

Sheet Name: ROOFTOP PATIO PLAN	
Proj #: 211201	Issue Date: 03-14-2022
Sheet No.: A102	
Drawn By: KC	Checked By: KC/SA

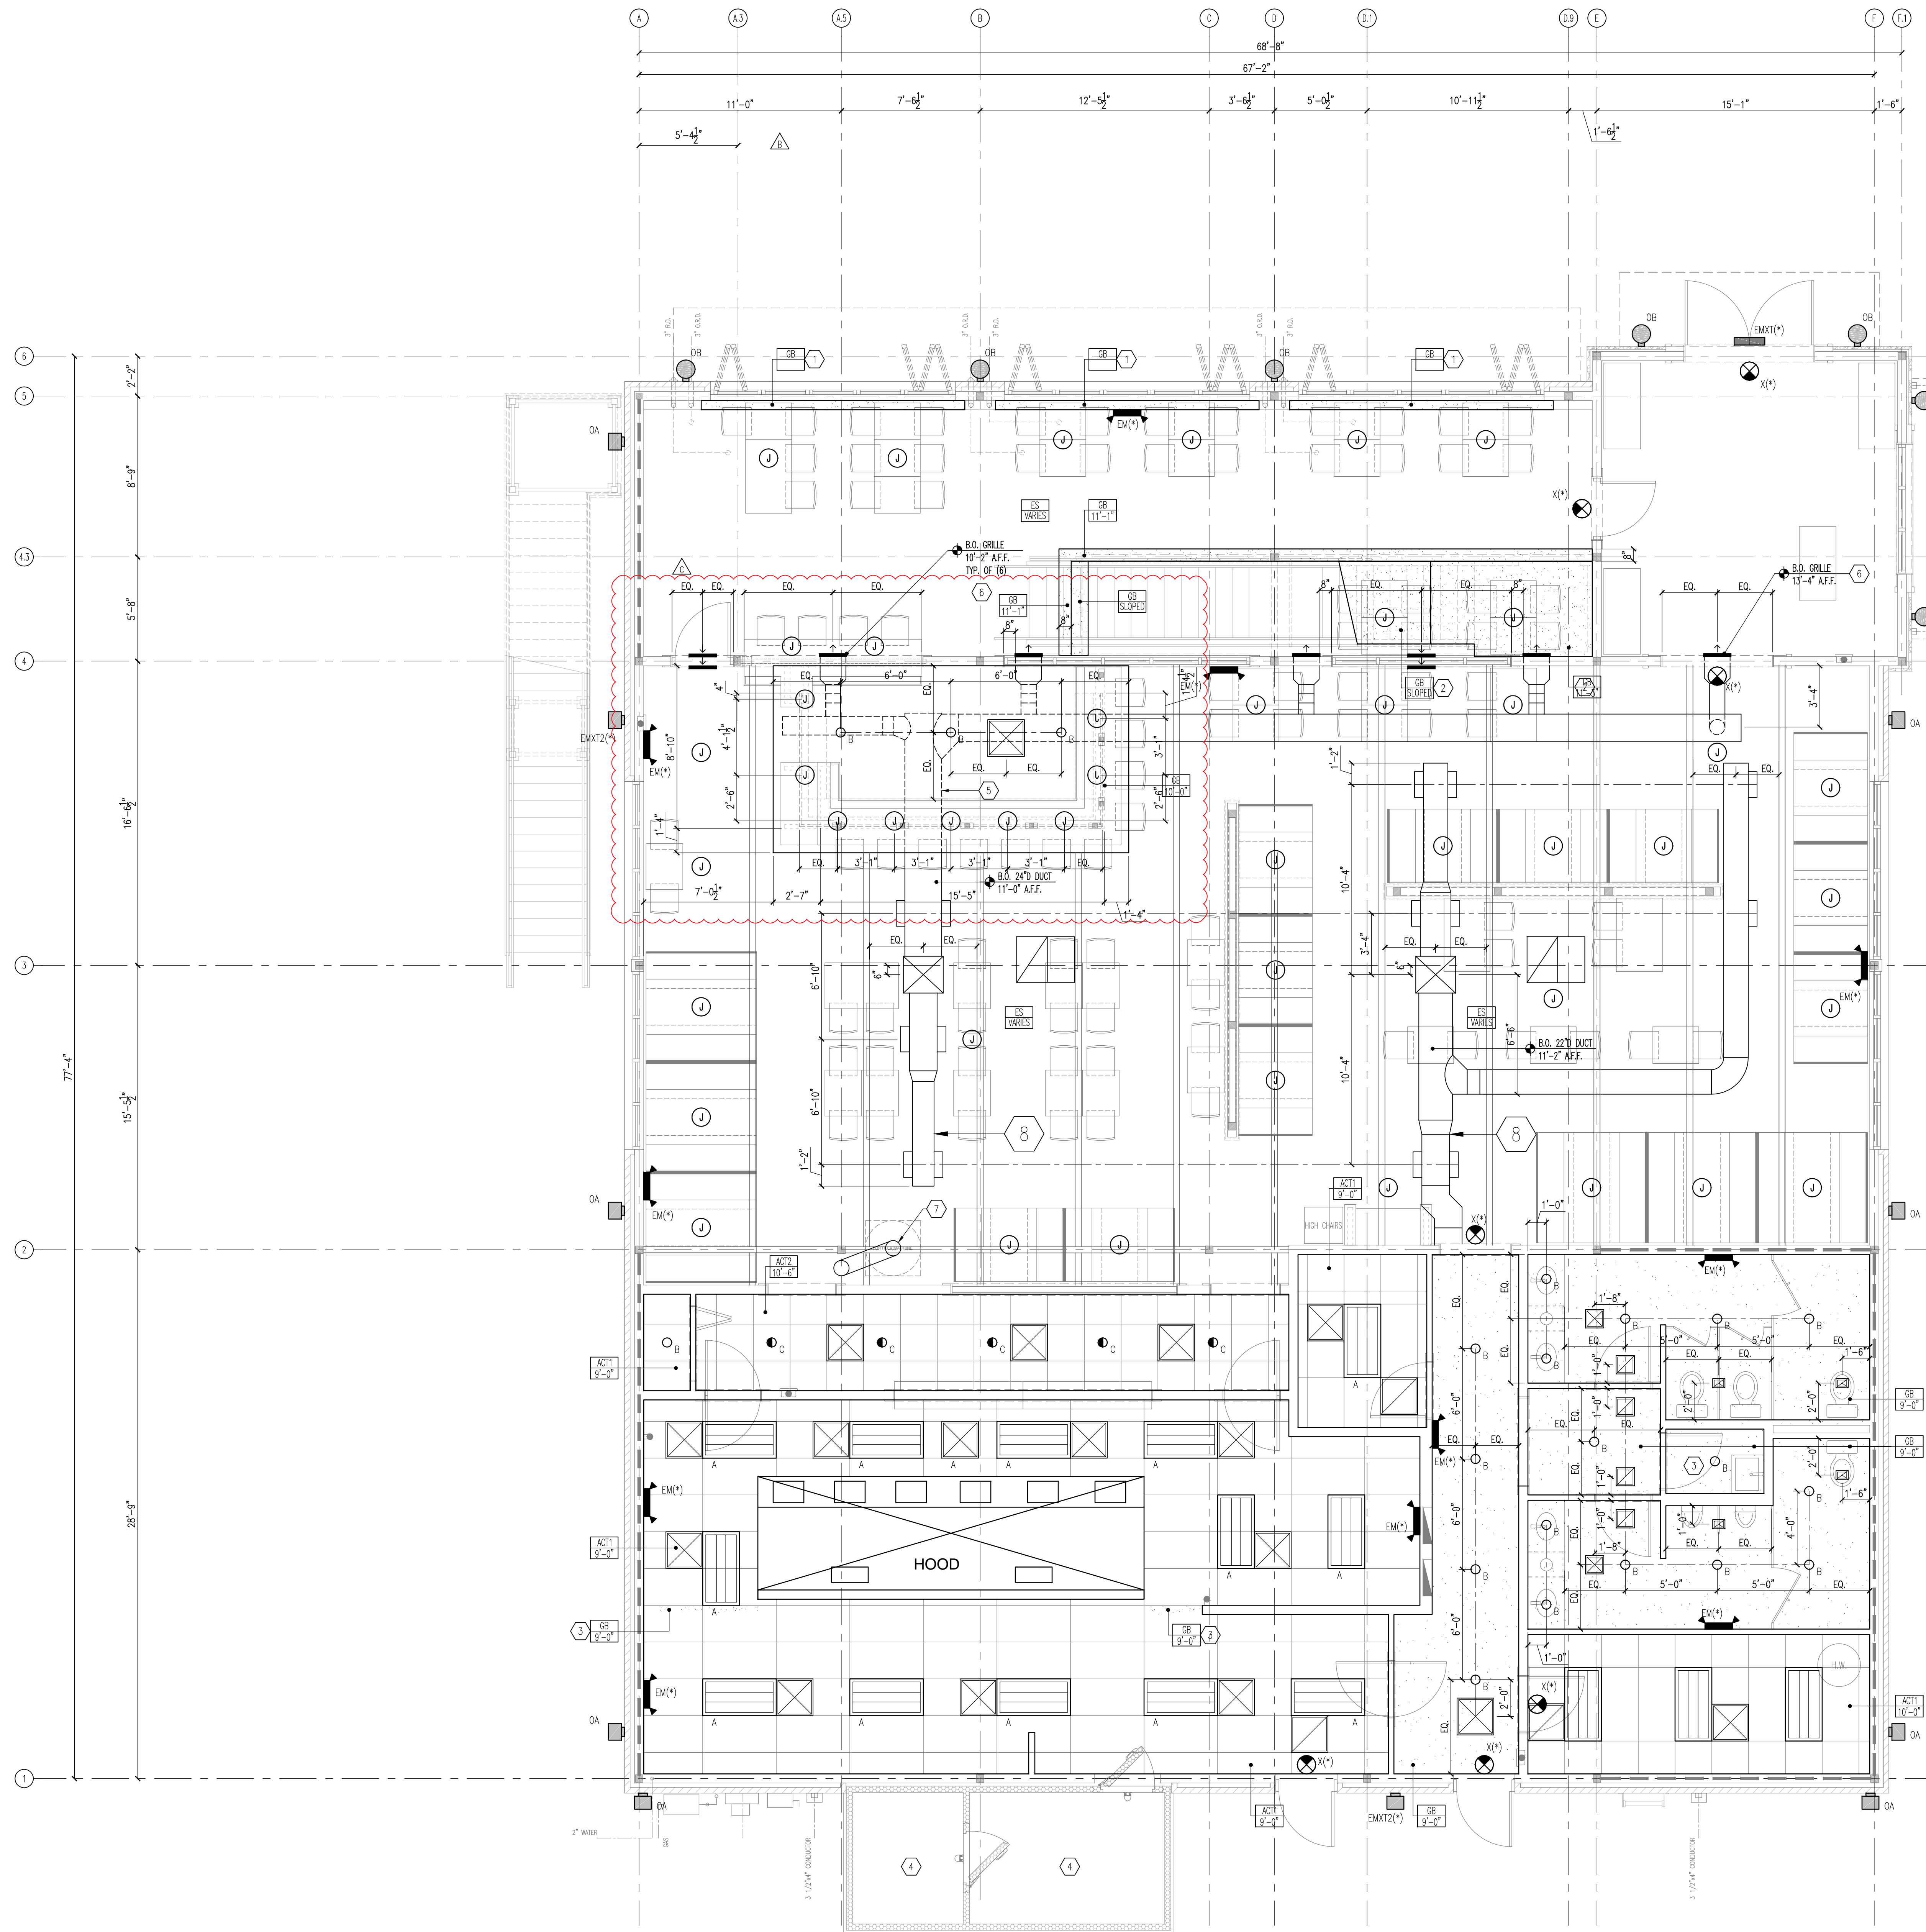

GENERAL SHEET NOTES

- NOT ALL ITEMS MAY BE USED.
- DIMENSIONS ARE TAKEN TO FACE OF STUD, FACE OF MASONRY OR CONCRETE, CENTERLINE OF LIGHT FIXTURE, OR COLUMN CENTERLINE, UNLESS INDICATED OTHERWISE.
- PRIOR TO ROUGH-IN AND CEILING ENCLOSURE, COORDINATE ALL WORK WITH TENANT/OWNER VENDOR REQUIREMENTS.
- PRIOR TO ROUGH-IN AND CEILING ENCLOSURE, COORDINATE LOCATION OF ALL WALL MOUNTED FIXTURES AND DEVICES WITH FINISH WORK SHOWN IN THE ARCHITECTURAL AND/OR ID DRAWINGS - ALIGN AS INDICATED. THIS SHALL INCLUDE, BUT NOT BE LIMITED TO: ALL CONTRACTOR, TENANT/OWNER, AND TENANT/OWNER VENDOR SUPPLIED ITEMS.
- IF THERE IS A DISCREPANCY BETWEEN THE ARCHITECTURAL AND ID DRAWINGS, NOTIFY THE ARCHITECT FOR RESOLUTION PRIOR TO PROCEEDING WITH THE WORK.
- IF THERE IS A DISCREPANCY WITH THE ACCESSIBILITY STANDARDS, REPORT THE DISCREPANCY TO THE ARCHITECT FOR RESOLUTION PRIOR TO PROCEEDING WITH THE WORK.
- PRIOR TO CEILING ENCLOSURE, CONTRACTOR SHALL PROVIDE ALL BLOCKING AND/OR SUPPORT AS REQUIRED FOR WALL MOUNTED ITEMS. THIS SHALL INCLUDE, BUT NOT BE LIMITED TO: ALL CONTRACTOR, TENANT/OWNER, AND TENANT/OWNER VENDOR SUPPLIED ITEMS.
- COORDINATE FINAL LOCATIONS OF TENANT/OWNER AND THIRD PARTY VENDOR FURNISHED ITEMS IN THE FIELD WITH TENANT/OWNER REP AND THE VENDOR.
- UNLESS INDICATED OTHERWISE, ALL BLOCKING SHALL BE ENCLOSED INSIDE FINISH CONSTRUCTION.
- BLOCKING AT DRY LOCATIONS: FIRE RETARDANT TREATED WOOD BLOCKING.
- BLOCKING AT WET LOCATIONS: GALVANIZED METAL STRAP BLOCKING, AS PROVIDED BY METAL STUD SUPPLIER/FABRICATOR.
- CONTRACTOR SHALL PROVIDE ALL NECESSARY FRAMING TO ACCOMMODATE THE FINAL LAYOUTS SHOWN FOR ALL FINISHES SHOWN IN THE ARCHITECTURAL AND ID DRAWINGS.
- ALL FIRE RATED HORIZONTAL ASSEMBLIES SHALL BE EFFECTIVELY AND PERMANENTLY IDENTIFIED WITH SIGNS OR STENCILING. SUCH IDENTIFICATION SHALL BE ABOVE ANY DECORATIVE CEILING AND IN CONCEALED SPACES. IDENTIFY WITH THE FOLLOWING TEXT: "XX" HOUR RATED FIRE/SMOKE BARRIER. PROTECT ALL OPENINGS AND PENETRATIONS. CONFIRM HOURLY RATING WITH FIRE RESISTANCE RATING OF WALL. AT LOCATIONS WHERE THERE ARE NO CEILINGS OR CONCEALED SPACES, COORDINATE SIGNAGE REQUIREMENT WITH THE AUTHORITY HAVING JURISDICTION (AHJ). AT THESE LOCATIONS, IF SIGNAGE IS REQUIRED BY THE AHJ, CONFIRM WITH TENANT/OWNER IF THEY PREFER SIGNS OR STENCILING.
- CONTRACTOR SHALL COORDINATE CEILING HEIGHTS WITH ALL EQUIPMENT AND DEVICES MOUNTED IN THE CEILING, AS SHOWN IN THE OTHER DISCIPLINE'S DRAWINGS. PRIOR TO THE START OF ALL CEILING WORK, INCLUDING DUCT FABRICATION AND PLUMBING ROUGH-IN, THE CONTRACTOR SHALL PREPARE COORDINATION DRAWINGS FOR REVIEW AND COMMENT. INCLUDE ALL PERTINENT ELEVATION INFORMATION FOR ALL THE DISCIPLINES AND ALL CEILING/SOFT heights. INDICATE ALL OFFSETS AND TRANSITIONS REQUIRED TO CLEAR STRUCTURAL ELEMENTS. ALL POTENTIAL CONFLICTS WITH CEILING HEIGHTS OR ALIGNMENTS SHALL BE CIRCLED AND NOTED IN THE DOCUMENTS FOR RESOLUTION BY THE ARCHITECT.
- ALL ELECTRICAL AND MECHANICAL ITEMS LOCATED IN ACoustICAL CEILING PANELS SHALL BE POSITIONED AT THE MID OR QUARTER POINTS OF THE PANEL.
- ALL LIGHTS, EMERGENCY LIGHTS, STROBES, DIFFUSERS, ETC., SHALL BE CENTERED. ALL STROBES SHALL BE CEILING MOUNTED.
- ALL FIXTURES, CONDUITS, PIPING, DUCTWORK, ETC. SHALL BE MOUNTED AS HIGH AS POSSIBLE TO ENSURE PROPER CLEARANCES AND CEILING HEIGHTS ARE MAINTAINED. CONTRACTOR SHALL LOCATE ALL CONDUITS AND PIPING IN THE JOIST SPACE, AS CLOSE TO THE FLOOR/ROOF DECK ABOVE, TO MAXIMIZE SPACE FOR DUCT INSTALLATION.
- OPEN STRUCTURE CEILING AREAS VISIBLE TO THE PUBLIC, CONTRACTOR SHALL TAKE GREAT CARE TO CAREFULLY LAY OUT ALL UTILITIES/SYSTEMS IN A NEAT AND ORDERLY FASHION, SEE 9/A-7.5 FOR REQUIREMENTS. CONTRACTOR SHALL PROVIDE A MOCK-UP IN THE FIELD OF TYPICAL INSTALLATION CONDITIONS. ACCEPTED MOCK-UP MAY BE PART OF THE FINISH WORK.
- MECHANICAL DIFFUSERS AND GRILLES SHALL BE FINISHED IN WHITE TO MATCH THE CEILING TILES. WHERE DIFFUSERS AND GRILLES OCCUR IN PAINTED GYPSUM BOARD SOFFITS, FIELD PAINT THE DIFFUSERS TO MATCH THE SOFFIT COLOR.
- ADDITIONAL DIRECTIONAL EXIT SIGNS MAY BE REQUIRED. CONTRACTOR TO VERIFY QUANTITIES AND LOCATIONS WITH THE LOCAL AUTHORITY HAVING JURISDICTION.
- SEE ELECTRICAL DRAWINGS FOR ALL LIGHT FIXTURE TYPES AND MODELS.
- SEE MECHANICAL DRAWINGS FOR ALL DIFFUSER TYPES AND SIZES.

NOTE: ALL OWNER SUPPLIED LIGHT FIXTURES SHALL COMPLY WITH INTERNATIONAL ENERGY CODE REQUIREMENTS. LED LIGHT FIXTURES ARE STRONGLY RECOMMENDED.

TO GREATEST EXTENT POSSIBLE, LIGHT FIXTURE LOCATIONS IN OPEN CEILING AREAS HAVE BEEN COORDINATED TO MISS OTHER CEILING MOUNTED UTILITIES AND SYSTEMS. WHERE CONFLICTS CANNOT BE AVOIDED, CONTRACTOR SHALL PROVIDE SECONDARY SUPPORT AS REQUIRED USING UNISTRUT OR EQUAL SYSTEMS.


LEGEND

ARCHITECTURAL


CEILING FINISH TAG. TOP LINE INDICATES MATERIAL TYPE. BOTTOM LINE INDICATES CEILING HEIGHT.

- ACT1: LAY-IN ACoustICAL CEILING 1:
- VINYL FACED CLEAN ROOM UNPERFORATED 2'x4', VINYL FACED, SQUARE EDGE.
 - ARMSTRONG CLEARFORM XL 870, OR EQUAL. COLOR: WHITE.
 - PROVIDE WITH 15/16" ALUMINUM GRID. ARMSTRONG PRELUDE XL ALUMINUM, OR EQUAL. COLOR: WHITE.
- ACT2: LAY-IN ACoustICAL CEILING 2:
- 2'x2' ACoustICAL STANDARD CONSTRUCTION, TEGULAR EDGE.
 - ARMSTRONG CIRCUS S34, OR EQUAL. COLOR: BLACK.
 - PROVIDE WITH 15/16" GRID. ARMSTRONG PRELUDE XL, OR EQUAL. COLOR: BLACK. NOTE: CONFIRM COLOR WITH OWNER PRIOR TO ORDERING.
- ACT3: LAY-IN ACoustICAL CEILING 2:
- 2'x2' ACoustICAL STANDARD CONSTRUCTION, TEGULAR EDGE.
 - ARMSTRONG CIRCUS S34, OR EQUAL. COLOR: WHITE.
 - PROVIDE WITH 15/16" GRID. ARMSTRONG PRELUDE XL, OR EQUAL. COLOR: WHITE.
- OB: 5/8" GYPSUM BOARD.
- ES: EXPOSED STRUCTURE. PAINTED/STAINED.
- AT INTERIOR LOCATIONS, FIELD PAINTING IS BY OWNER.
 - AT ROOFTOP PATIO PAINTING AND STAINING IS BY G.C.


EXPOSED STEEL FRAMING

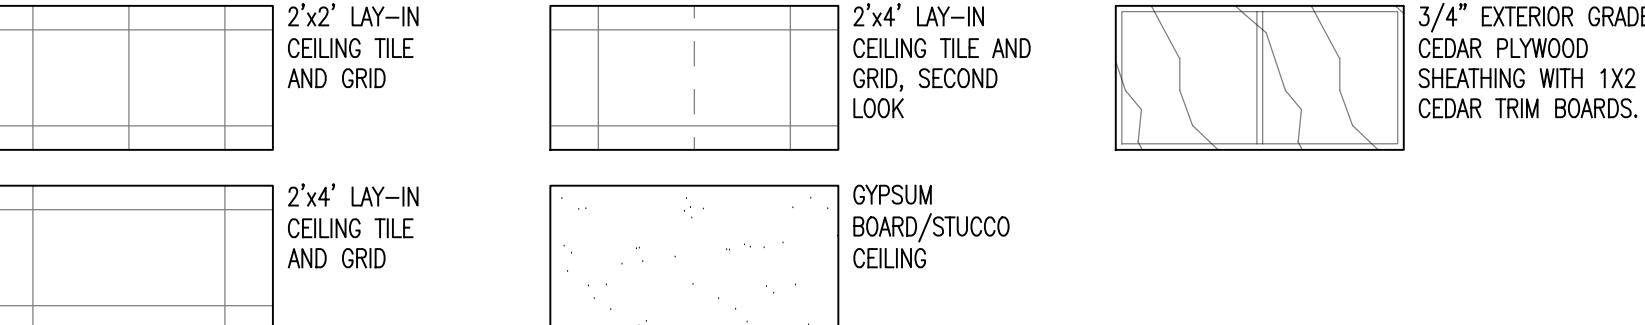

MECHANICAL

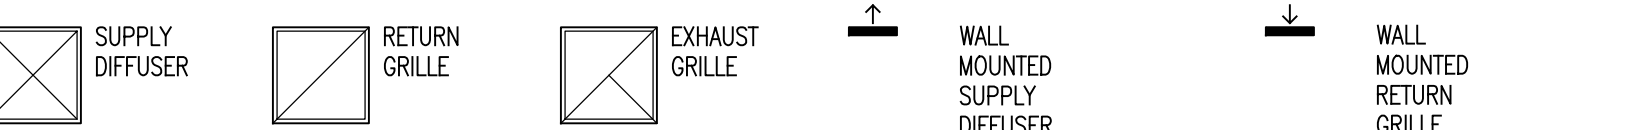

ELECTRICAL

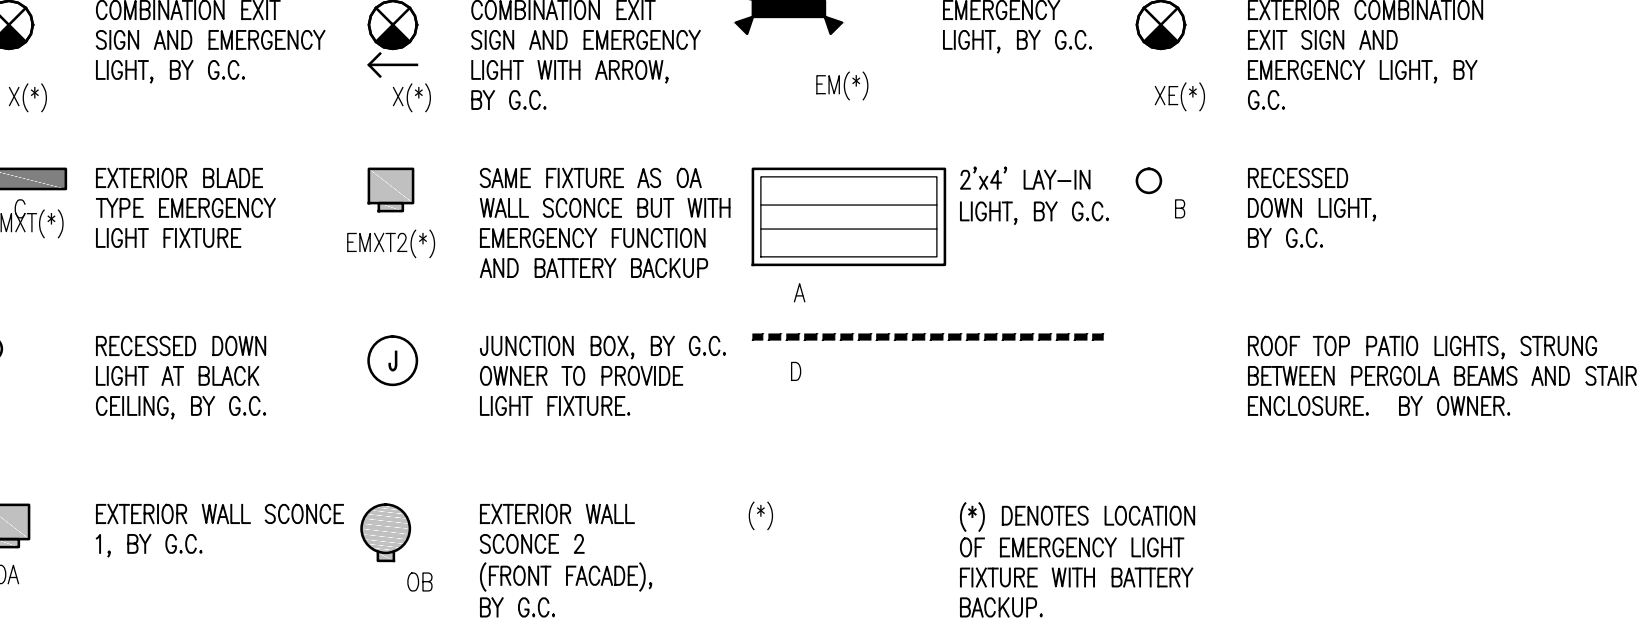

KEYNOTES

- ALIGN FINISH FACE OF BOTTOM OF SOFFIT WITH FINISH FACE OF WOOD TRIM AT WINDOW HEAD. VERIFY IN FIELD.
- SEE STAIR SECTIONS FOR FURTHER INFORMATION ON SOFFIT CONSTRUCTION UNDER STAIR FRAMING.
- AT THIS LOCATION, INSTALL FRP PANEL AND TRIM AT CEILING CONSTRUCTION. MATCH WALL FRP COLOR.
- WALK-IN LIGHTS ARE BY KITCHEN EQUIPMENT VENDOR.
- HOLD DUCTWORK ABOVE BAR CEILING.
- PROVIDE DUCTWORK TRANSITIONS AS REQUIRED TO PROVIDE WALL LOUVERS AT ELEVATIONS SHOWN.
- EXHAUST FLUE AT TORTILLA MACHINE. TYPE AND SIZE AS REQUIRED BY MANUFACTURER. OFFSET AS REQUIRED TO MAINTAIN REQUIRED CLEARANCE TO COMBUSTIBLES AND TO MAINTAIN 10'-0" CLEAR FROM ROOFTOP EQUIPMENT. B-VENT IS MOST LIKELY REQUIRED.
- EXPOSED DUCTWORK IN DINING AREA - ALL EXPOSED DUCTWORK SHALL BE SUSPENDED BY AIRCRAFT CABLE DUCT HANGERS. UNISTRUT OR METAL STRAP HANGERS SHALL NOT BE ACCEPTED.


No.	Description	Date
1	Sheet Name:	
2	Sheet Title:	
3	Sheet Number:	
4	Sheet Date:	
5	Sheet Scale:	
6	Sheet Author:	
7	Sheet Checker:	
8	Sheet Designer:	
9	Sheet Engineer:	
10	Sheet Architect:	
11	Sheet Structural:	
12	Sheet Mechanical:	
13	Sheet Electrical:	
14	Sheet Plumbing:	
15	Sheet Fire Protection:	
16	Sheet Other:	

FIRST FLOOR
REFLECTED CEILING PLAN

Proj #: 211201 Issue Date: 03-14-2022

Sheet No.: A103

Drawn By: KC Checked By: KC/SA

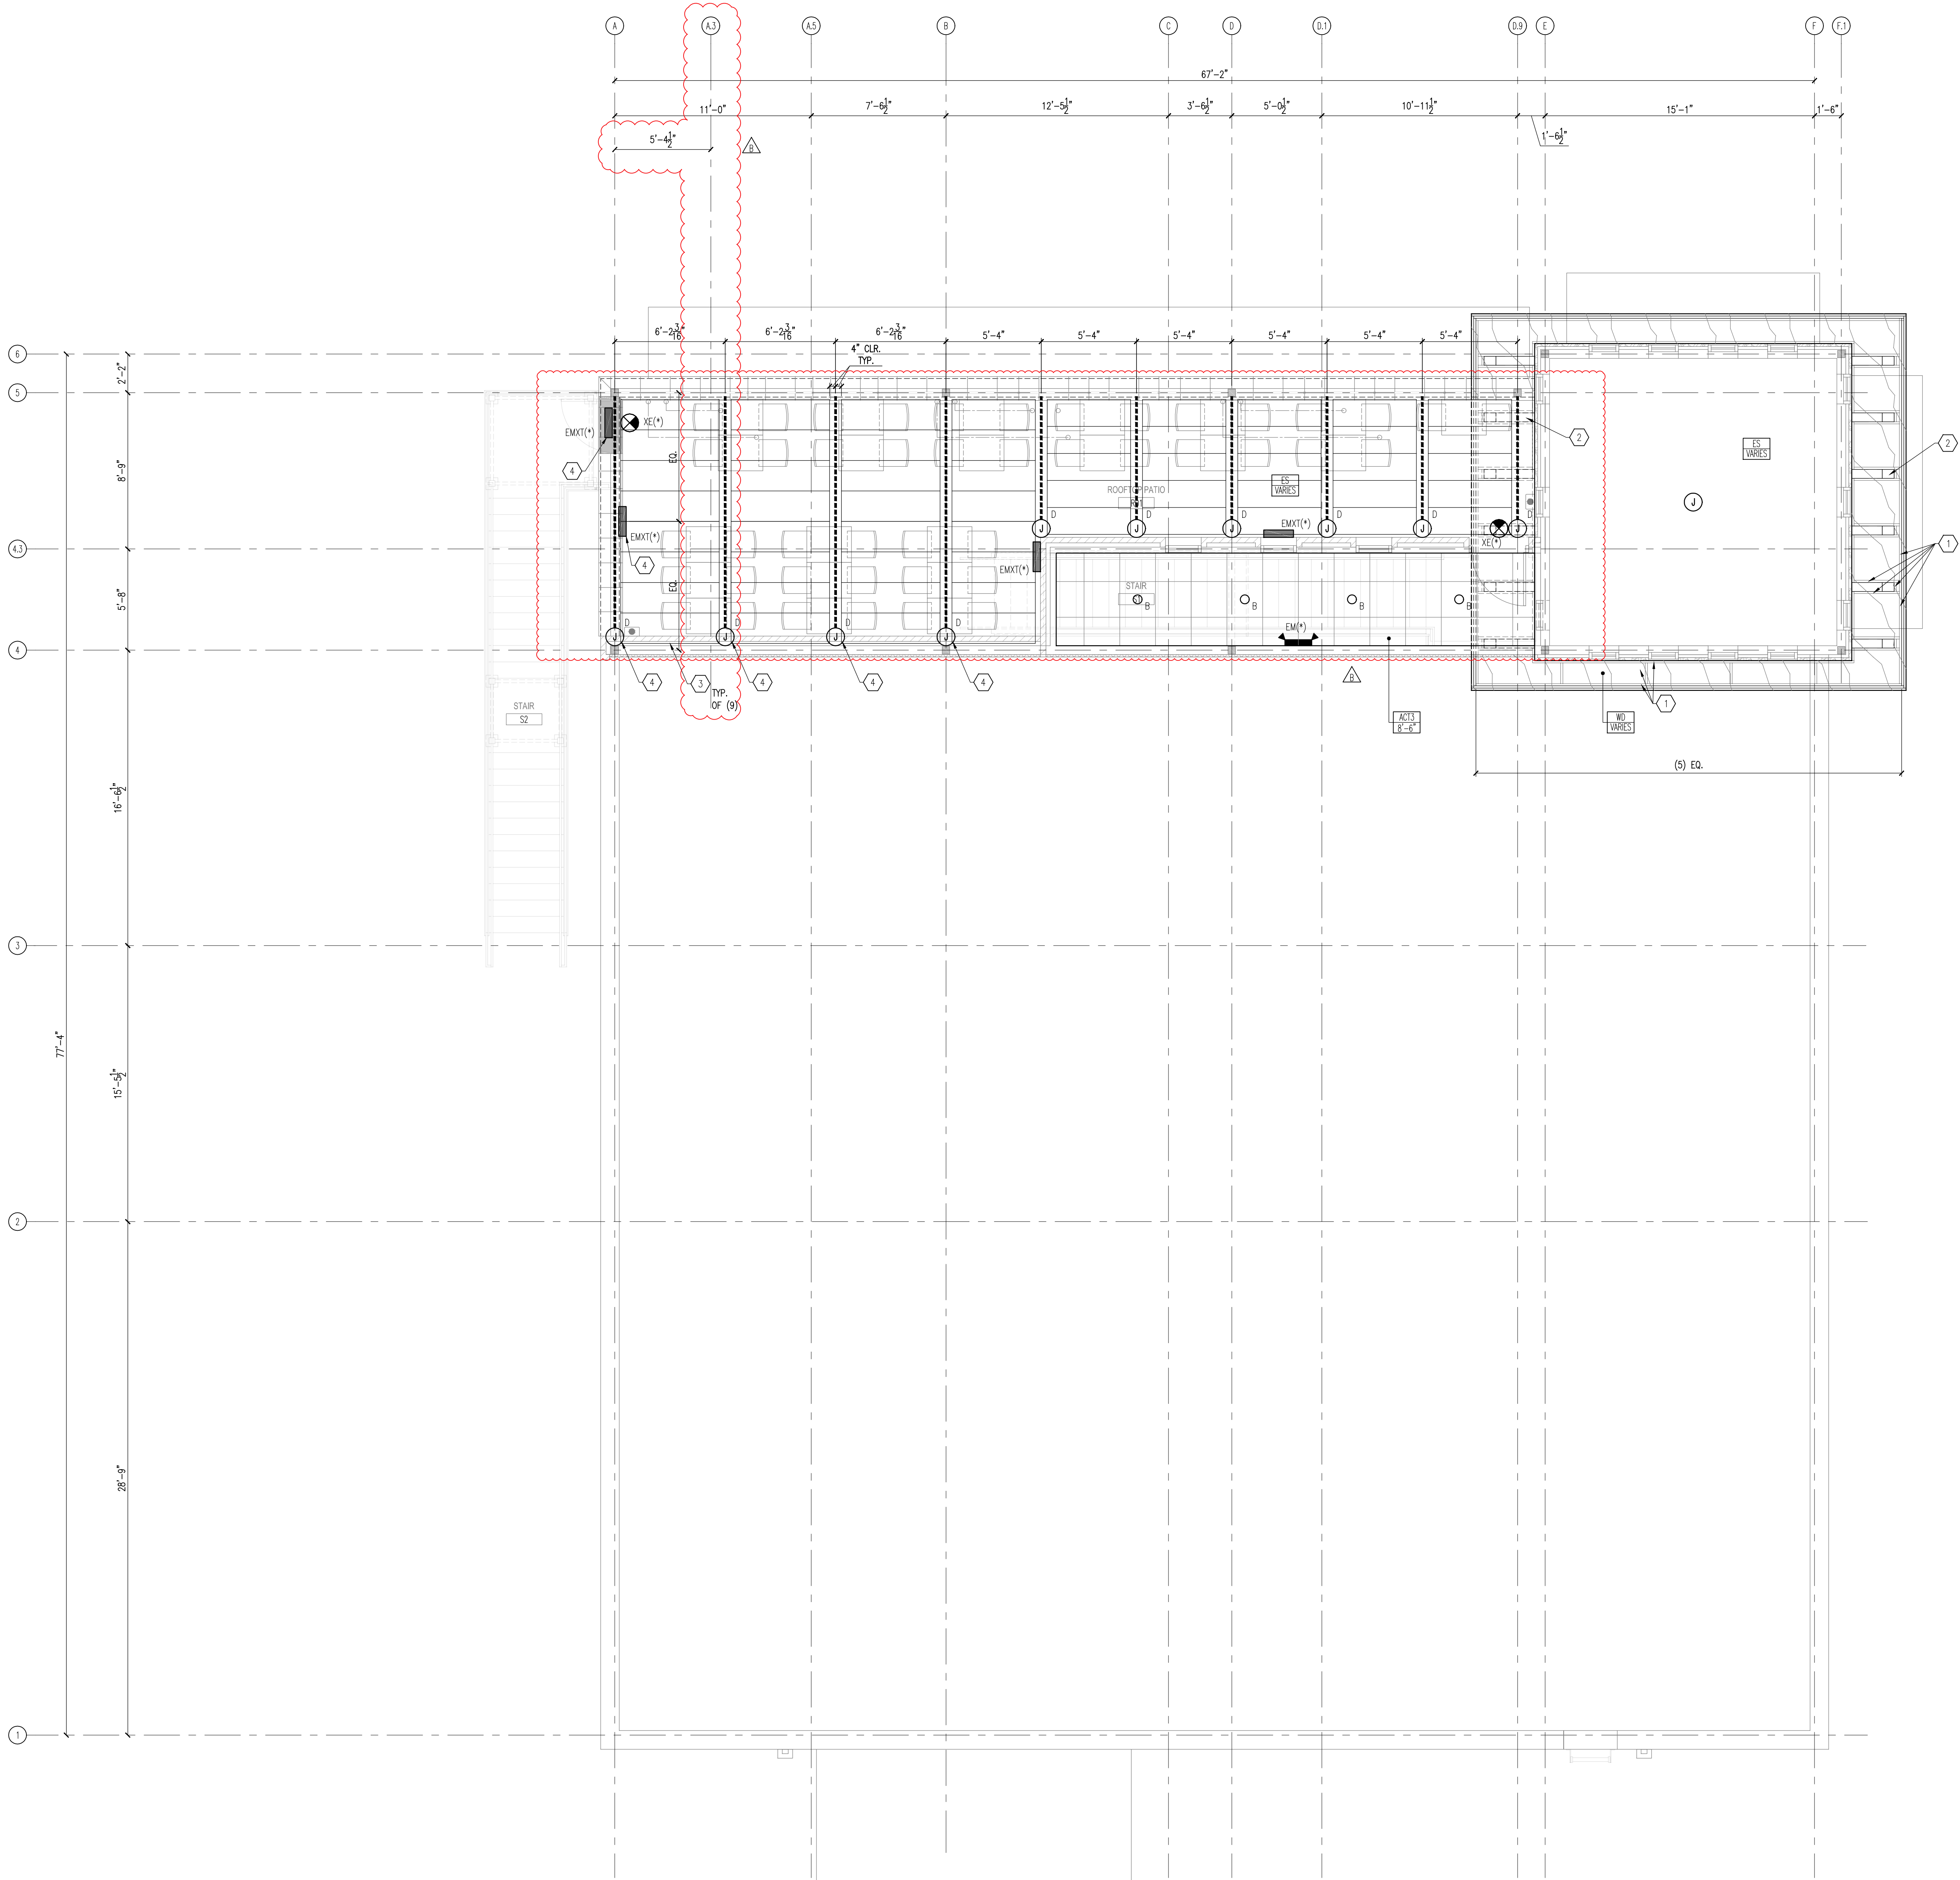


GENERAL SHEET NOTES

1. SEE A103 FOR GENERAL SHEET NOTES AND LEGEND.


KEYNOTES

1. PROVIDE 1x2 CEDAR WOOD TRIM BOARDS AT THE PERIMETER OF THE WOOD SOFFIT AND AT ALL PANEL JOINTS. PROVIDE IN LAYOUT SHOWN, CUT WOOD SOFFIT TO FIT.
2. STEEL BRACKET, SEE ELEVATIONS AND SECTIONS FOR FURTHER INFORMATION.
3. CABLE SHADE, COORDINATE LAYOUT WITH LIGHTING LAYOUT. MAINTAIN CLEARANCE INDICATED.
4. ROUTE ELECTRICAL CONDUITS AND BOXES AT INSIDE FACE OF PERGOLA BEAMS AND JOIST FRAMING. DO NOT EXPOSE ON THE OUTSIDE FACE OF THE PERGOLA CONSTRUCTION.

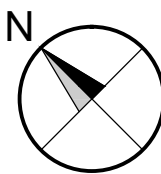

REV	DESCRIPTION	DATE
1	ISSUED FOR PERMIT	03-14-2022
2	ISSUED FOR CONSTRUCTION	03-14-2022

Sheet Name: ROOFTOP PATIO REFLECTED CEILING PLAN	
Proj #: 211201	Issue Date: 03-14-2022
Sheet No.: A104	
Drawn By: KC	Checked By: KC/SA

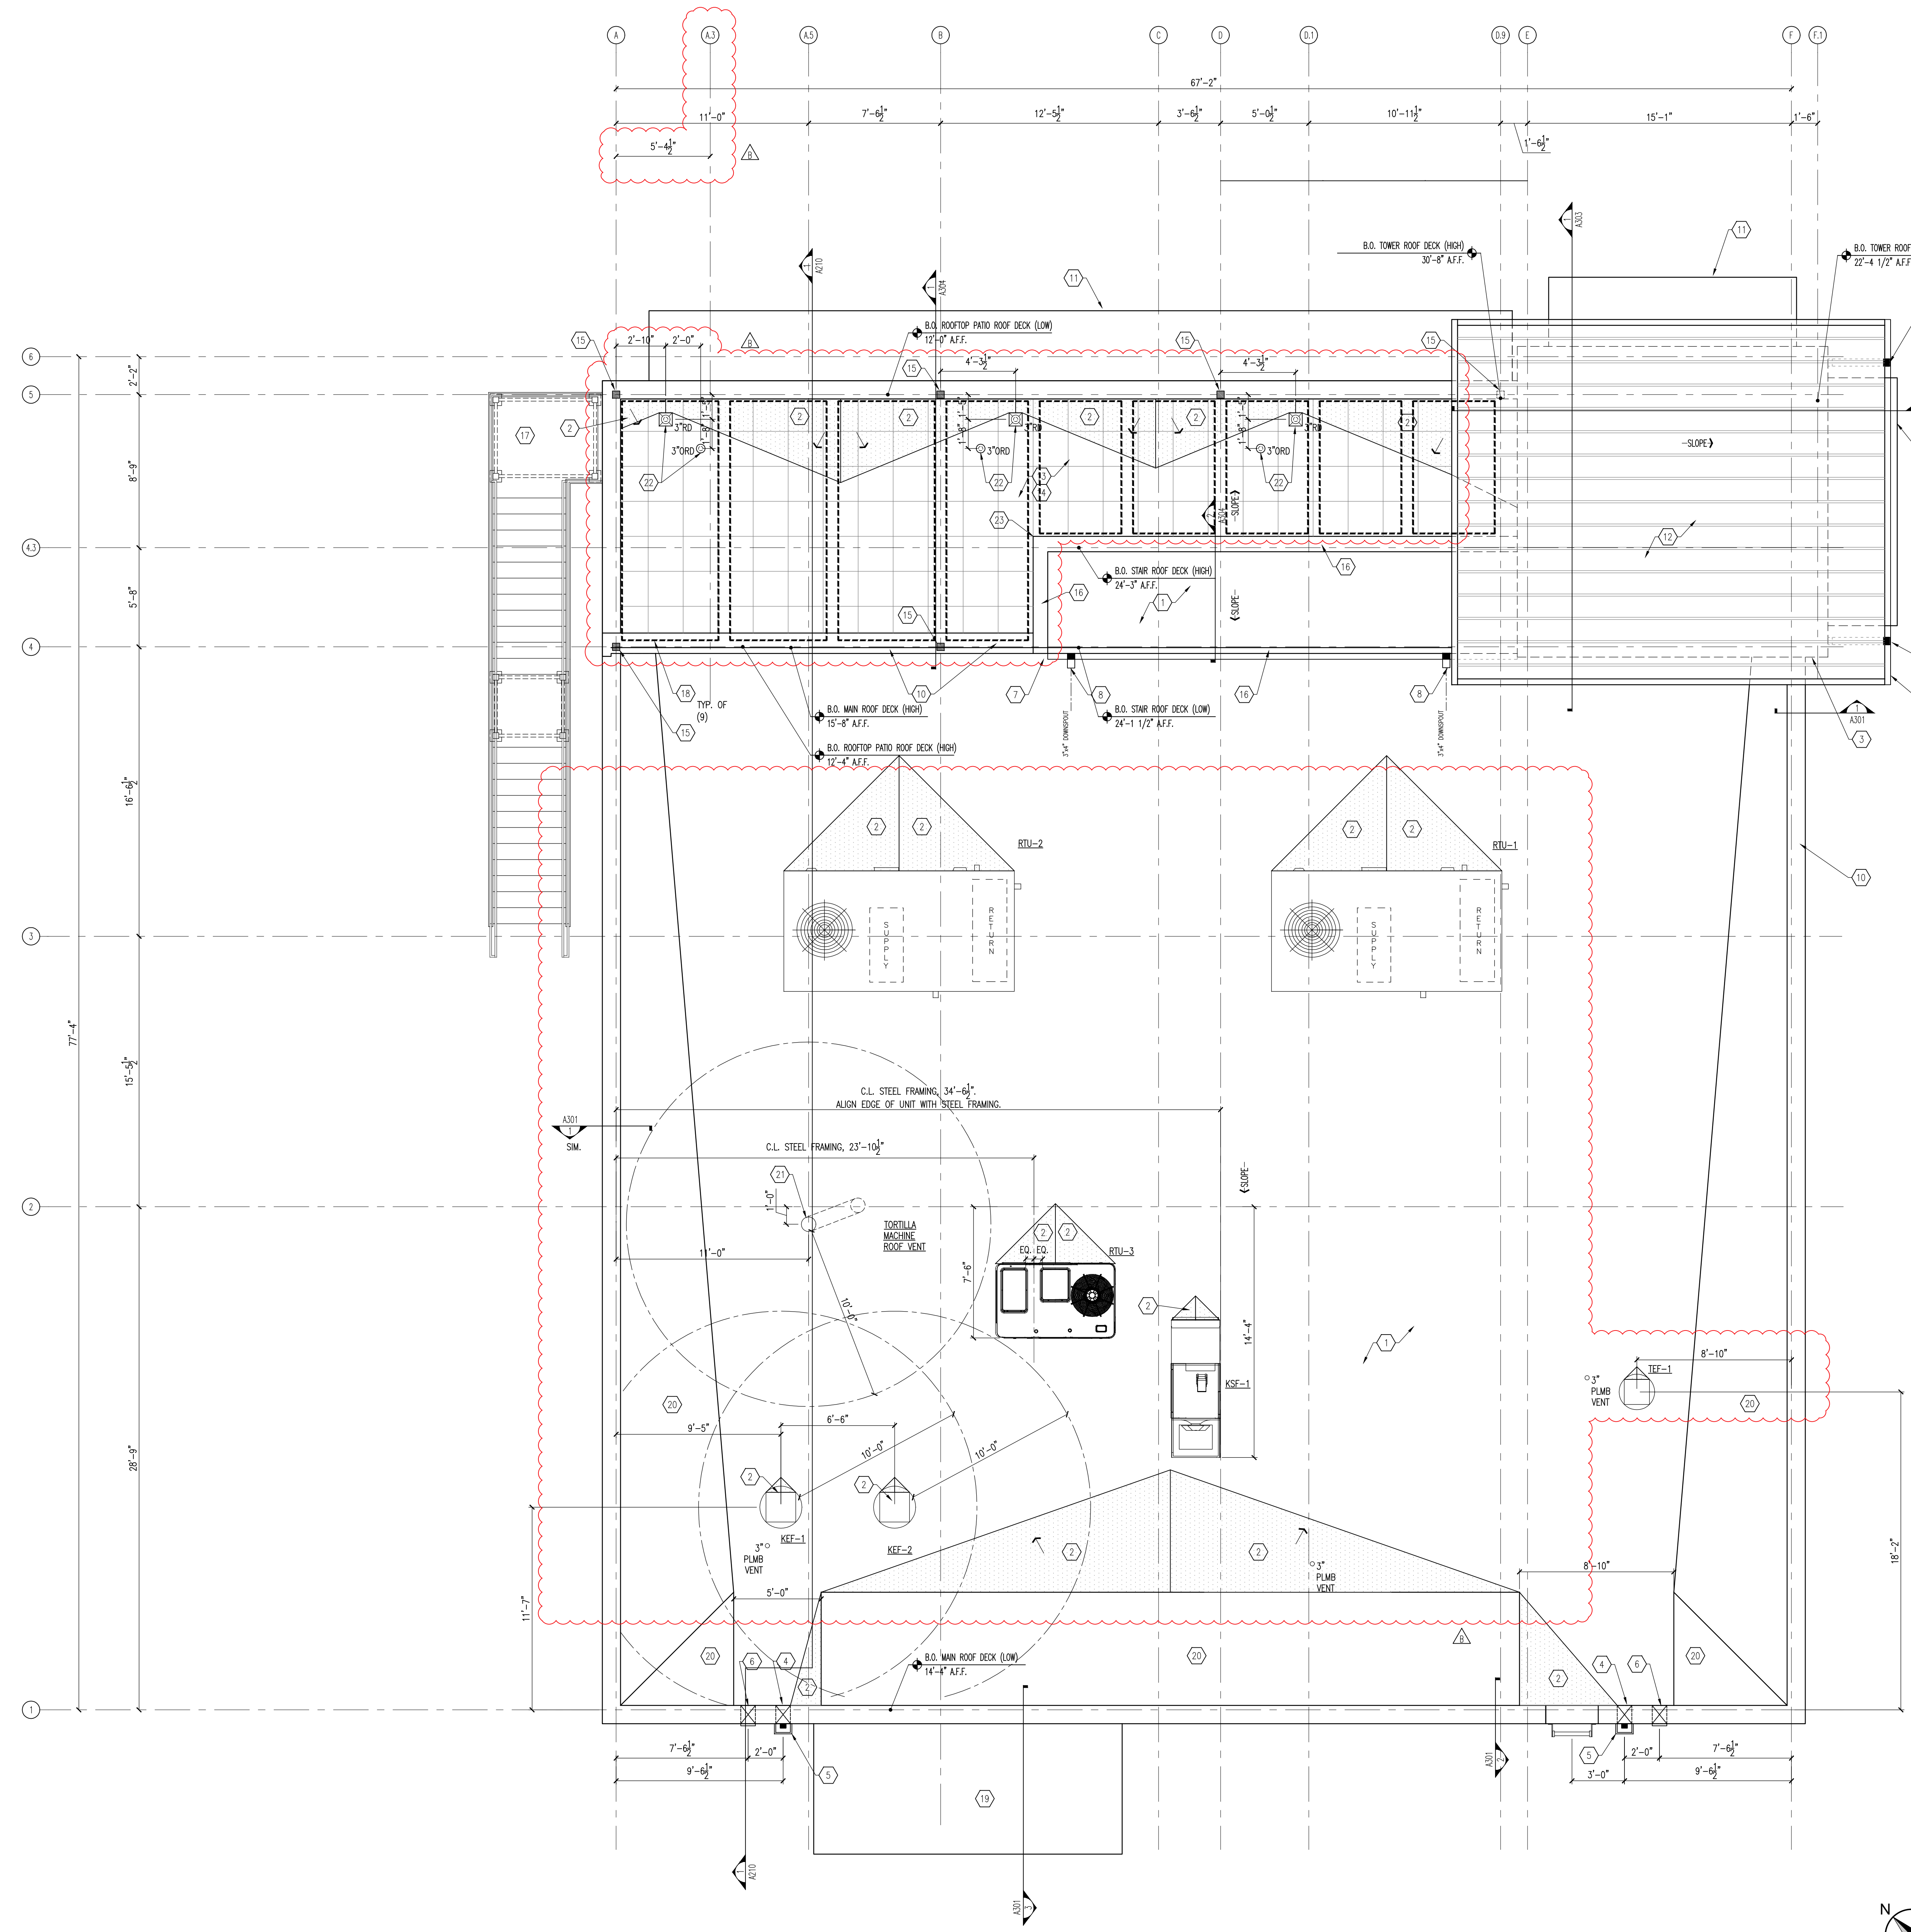

GENERAL SHEET NOTES

- ALL ROOFING DETAILS SHALL BE PER ROOFING MANUFACTURER AND NRCA ROOFING MANUAL, STANDARD DETAILS AND WRITTEN INSTRUCTIONS.
- NOT ALL ITEMS MAY BE USED.
- DIMENSIONS ARE TAKEN TO FACE OF STUD, FACE OF MASONRY OR CONCRETE, CENTERLINE OF EQUIPMENT/SKYLIGHT, OR COLUMN CENTERLINE, UNLESS INDICATED OTHERWISE.
- ALL HEIGHTS SHOWN ARE FROM FIRST FLOOR FINISH SLAB.
- PRIOR TO ROUGH-IN AND ROOF ENCLOSURE, COORDINATE ALL WORK WITH TENANT/OWNER VENDOR REQUIREMENTS.
- PRIOR TO ROUGH-IN AND ROOF ENCLOSURE, COORDINATE LOCATION OF ALL ROOF MOUNTED EQUIPMENT AND DEVICES. THIS SHALL INCLUDE, BUT NOT BE LIMITED TO: CONDENSATE, TENANT/OWNER, AND TENANT/OWNER VENDOR SUPPLIED ITEMS.
- PRIOR TO ROOF ENCLOSURE, CONTRACTOR SHALL PROVIDE ALL BLOCKING AND/OR SUPPORT AS REQUIRED FOR ROOF MOUNTED ITEMS. THIS SHALL INCLUDE, BUT NOT BE LIMITED TO: ALL CONTRACTOR, TENANT/OWNER, AND TENANT/OWNER VENDOR SUPPLIED ITEMS.
- COORDINATE FINAL LOCATIONS OF OWNER AND THIRD PARTY VENDOR FURNISHED ITEMS IN THE FIELD WITH TENANT/OWNER REP AND THE VENDOR.
- UNLESS INDICATED OTHERWISE, ALL BLOCKING SHALL BE ENCLOSED INSIDE FINISH CONSTRUCTION. PROVIDE FIRE RETARDANT TREATED WOOD BLOCKING.
- SEE ELECTRICAL DRAWINGS FOR ALL ELECTRICAL AND LIGHT FIXTURE TYPES AND MODELS.
- SEE MECHANICAL DRAWINGS FOR ALL MECHANICAL EQUIPMENT.
- ALL ROOF EQUIPMENT AND PENETRATIONS SHALL BE PROVIDED WITH STRUCTURAL SUPPORT, SEE STRUCTURAL DRAWINGS FOR FRAMING INFORMATION AND LOCATIONS.
- VERIFY LOCATIONS OF ALL VENTS AND ROOF PENETRATIONS WITH ALL DISCIPLINES.
- VERIFY LOCATIONS OF ALL MECHANICAL EQUIPMENT WITH STRUCTURAL DRAWINGS.
- NO EQUIPMENT SHALL BE LOCATED WITHIN 10'-0" OF THE EDGE OF THE ROOF. THIS INCLUDES, BUT IS NOT LIMITED TO, RTUs, EXHAUST FANS, CONDENSING UNITS, AND VENTS.
- THE MECHANICAL CONTRACTOR SHALL COORDINATE INSTALLATION AND ACCEPTANCE OF PREFABRICATED CURBS AND PENETRATIONS WITH THE ROOFING CONTRACTOR AND THE G.C. IN ORDER TO PROVIDE ALL NECESSARY BLOCKING, NAILING, FLASHING, ETC. AS REQUIRED FOR A WATER-TIGHT INSTALLATION.
- ALL ROOF EQUIPMENT SHALL BE MOUNTED ON ELEVATED, INSULATED PREFABRICATED CURBS. WHERE EQUIPMENT SITS ON A SLOPED SURFACE, PROVIDE A CURB MATCHED TO THE SLOPED SURFACE. ALL EQUIPMENT SHALL SIT LEVEL, MAINTAIN 8" MIN. FROM TOP OF FINISH ROOF TO TOP OF CURB. ALL CURBS SHALL BE SET LEVEL, PROVIDE FACTORY FABRICATED CURBS WITH SLOPED BOTTOMS MATCHING THE ROOF SLOPE. ALL CURBS SHALL BE INSTALLED AND FLASHED PER THE MANUFACTURER'S RECOMMENDATIONS.
- ROOFING REQUIREMENTS:
 - THE CONTRACTOR, AND ANY ROOFING SUBCONTRACTOR WORKING UNDER THE CONTRACTOR, SHALL BE RESPONSIBLE FOR PROVIDING A COMPLETE WARRANTED, WATER-TIGHT ROOFING SYSTEM. THIS SHALL INCLUDE, BUT NOT BE LIMITED TO, SEPARATION BOARDS, VAPOR BARRIERS, NAILERS AND BLOCKING, ROOF INSULATION, TAPERED OVERBUILD INSULATION, TAPERED OVERBUILD CRICKETS, ROOF MEMBRANE, WALL FLASHING, TERMINATIONS AND FLASHING, ETC. AS REQUIRED FOR PROVIDING A COMPLETE WARRANTED, WATER-TIGHT ROOFING SYSTEM. COMPLY WITH MANUFACTURER'S AND NRCA'S REQUIREMENTS. COORDINATE THESE DETAILS WITH THE ROOFING SYSTEM PROVIDED AND FIELD CONDITIONS.
 - ALL ROOFING SLOPES SHALL HAVE A MINIMUM 1/4" PER FOOT SLOPE. ALL TAPERED OVERBUILD INSULATION AND TAPERED OVERBUILD CRICKETS SHALL HAVE THE SAME MINIMUM SLOPE. WHERE VALLEYS OCCUR IN CRICKETS AND TAPERED INSULATION, THE TAPERED INSULATION SHALL BE PROVIDED IN SUFFICIENT DEPTH AND SLOPE TO ENSURE A MINIMUM 1/4" PER FOOT SLOPE IN THE VALLEY TO THE ROOF DRAIN; ALL AREAS SHALL BE PROVIDED WITH POSITIVE DRAINAGE. THE CONTRACTOR SHALL NOTIFY THE ARCHITECT OF ANY DISCREPANCIES PRIOR TO BID. NO CHANGE ORDERS SHALL BE ACCEPTED FOR ADDITIONAL ROOFING MATERIAL REQUIRED TO CREATE THE SLOPES.
 - PROVIDE ROOF INSULATION IN THE THICKNESS REQUIRED TO MEET THE MINIMUM R VALUE INDICATED. WHERE INDICATED R VALUE DOES NOT CONCLUDE WITH THE MANUFACTURER'S STANDARD INSULATION THICKNESS, ROUND UP TO THE NEXT EVEN NUMBER. ALL CRICKETS AND TAPERED INSULATION SHALL BE INSTALLED OVER THE MINIMUM THICKNESS OF THE BASE INSULATION.
 - PROVIDE MANUFACTURER'S STANDARD CONTINUOUS WALKWAY/TRAFFIC PADS FROM THE ROOF HATCH TO ALL ROOF TOP MECHANICAL EQUIPMENT AND TO ALL ROOF LADDERS. AT MECHANICAL EQUIPMENT PROVIDE WALKWAY PADS AT ALL (4) SIDES OF THE EQUIPMENT.
 - PROVIDE CRICKETS AT THE UPSLOPE SIDE OF ALL ROOFTOP EQUIPMENT. THIS INCLUDES, BUT IS NOT LIMITED TO, SKYLIGHTS, ROOF HATCHES, RTUs, EXHAUST FANS, AND OTHER LARGE ITEMS. CRICKETS ARE NOT REQUIRED AT PLUMBING PENETRATIONS.

- CURB NOTES:**
- ALL ROOFTOP EQUIPMENT CURBS AND UNITS SHALL BE SET LEVEL. BLOCK CURBS AS REQUIRED WITH FIRE RETARDANT TREATED WOOD BLOCKING.
 - FLASHING FLANGE ON ALL ROOFTOP EQUIPMENT CURBS SHALL BE 8" MIN. ABOVE THE TOP OF THE ADJACENT ROOF.

LEGEND

	TAPERED INSULATION		ROOF ACCESS HATCH		ROOF LADDER
	ROOF DRAIN - PRIMARY		ROOF DRAIN - OVERFLOW		GUTTER AND DOWNSPOUT
	ROOF PRIMARY SCUPPER AND CONDUCTOR		ROOF OVERFLOW SCUPPER		ROOF ACCESS PANEL
	SKYLIGHT		WEATHERPROOF PARAPET WALL VENT		ROOF SLOPE ARROWS, LARGE AND SMALL

ABBREVIATIONS

B.O.D.	BOTTOM OF DECK	T.O.D.	TOP OF CONCRETE
L.P.	LOW POINT	T.O.M.	TOP OF MASONRY
H.P.	HIGH POINT	T.O.P.	TOP OF PARAPET
		T.O.S.	TOP OF STEEL

KEYNOTES

- MAIN ROOF SYSTEM, FIRESTONE ULTRALY TPO, OR EQUAL.
 - SINGLE-PLY, 60 MIL, FULLY-ADHERED, WHITE TPO ROOF SYSTEM OVER:
 - R25 (MIN.) POLYISOCYANURATE RIGID FOAM ROOF INSULATION OVER:
 - METAL ROOF DECK.
 - PROVIDE TAPERED INSULATION WHERE SHOWN AND AS REQUIRED FOR DRAINAGE.
- AREA OF TAPERED INSULATION/CRICKET TO BE INSTALLED OVER BASE ROOFING INSULATION. SLOPE 1/4" PER FOOT MINIMUM.
- DASHED LINE INDICATES FACE OF WALL BELOW.
- 8"X10" W PREFINISHED ALUMINUM ROOF SCUPPER. PROVIDE WITH 1" FACE TRIM. SHOP FABRICATE AND WELD ALL JOINTS. KYNAR COAT AFTER FABRICATION. SET B.O. OF SCUPPER AT TOP OF ROOFING SYSTEM. VERIFY ELEVATION IN FIELD.
- 3 1/2"X4" W PREFINISHED ALUMINUM CONDUCTOR WITH 10"X8"X16" CONDUCTOR HEAD. SHOP FABRICATE CONDUCTOR HEAD AND WELD ALL JOINTS. KYNAR COAT AFTER FABRICATION. CONNECT CONDUCTOR TO UNDERGROUND STORM PIPING WITH MANUFACTURED BOOT.
- 6"X10" W PREFINISHED ALUMINUM ROOF OVERFLOW SCUPPER. PROVIDE WITH 1" FACE TRIM AND 1" DRAIN EDGE. SHOP FABRICATE AND WELD ALL JOINTS. KYNAR COAT AFTER FABRICATION. SET B.O. OVERFLOW SCUPPER 2" MIN. TO 4" MAX. ABOVE SCUPPER ELEVATION. VERIFY IN FIELD.
- 4"X5" PREFINISHED ALUMINUM GUTTER.
- 3"X4" PREFINISHED ALUMINUM DOWNSPOUT. DISCHARGE ONTO ROOF BELOW.
- 3"X4" PREFINISHED ALUMINUM DOWNSPOUT. CONNECT CONDUCTOR TO UNDERGROUND STORM PIPING WITH MANUFACTURED BOOT.
- PREFINISHED ALUMINUM COPING.
- WINDOW CANOPY, BELOW.
- STANDING SEAM METAL ROOF (16" EXPOSURE) OVER ICE AND WATER SHIELD OVER R25 (MIN.) POLYISOCYANURATE RIGID FOAM ROOF INSULATION OVER METAL ROOF DECK. PROVIDE FIRE RETARDANT TREATED WOOD BLOCKING AT THE PERIMETER OF THE INSULATION, AND AT THE INTERIOR OF THE INSULATION WHERE REQUIRED FOR PLYWOOD ATTACHMENT.
- 24"X24" PEDESTAL PAVES SYSTEM OVER ADJUSTABLE PEDESTALS. COLOR AND TEXTURE AS SELECTED BY OWNER.
 - PAVERS: WESTILE 25"X24"X 1 7/8" CLASSIC PLAZA SLAB. COLOR AND TEXTURE AS SELECTED BY OWNER.
 - PEDESTAL SYSTEM: BISON INNOVATIVE PRODUCTS SCORNBACH PEDESTAL SYSTEM. PROVIDE ALL REQUIRED PARTS, TRIMS, AND ACCESSORIES.
- ROOF TOP PATIO ROOFING SYSTEM, FIRESTONE ULTRALY TPO, OR EQUAL.
- SINGLE PLY, 45 MIL, TPO SACRIFICIAL SHEET LOOSE LAID OVER:
- SINGLE PLY, 80 MIL, FULLY ADHERED TPO MEMBRANE OVER:
- 1/2" DENS DECK PRIMED AND ADHERE OVER:
- HIGH-DENSITY (MIN. 25 PS), CLOSED-CELL, R25 (MIN.) POLYISOCYANURATE RIGID FOAM ROOF INSULATION ADHERED TO DECK OVER:
- CONCRETE AND METAL DECK WITH INTEGRAL ROOF SLOPE.
- PROVIDE TAPERED INSULATION AS SHOWN AND AS REQUIRED FOR DRAINAGE.
- STEEL COLUMN, EXPOSED ABOVE ROOF.
- PREFINISHED ALUMINUM ROOF EDGE TERMINATION.
- EXTERIOR STAR TO ROOFTOP PATIO, BELOW.
- CABLE SHADE MOUNTED BELOW PERGOLA STRUCTURE.
- WALK-IN COOLER, BELOW.
- COLD FORMED METAL STUD DIAGONAL BRACING TO SUPPORT PARAPET CONSTRUCTION, MIN. SLOPE 1H:1V, MAX. SLOPE 1H:1.5V. SEE WALL SECTIONS FOR FURTHER INFORMATION.
- EXHAUST FLUE FOR TORTILLA MACHINE, BELOW. TYPE AND SIZE AS REQUIRED BY MANUFACTURER. OFFSET AS REQUIRED TO MAINTAIN CLEARANCE TO COMBUSTIBLES AND MAINTAIN 10'-0" CLEAR OF ROOFTOP EQUIPMENT.
- COORDINATE FINAL LOCATIONS OF ROOF DRAINS AND OVERFLOW ROOF DRAINS IN FIELD WITH ROOFING CONTRACTOR. LOCATE TO MISS THE BASES AND SUPPORTS FOR THE PEDESTAL PAVES SYSTEM.
- START LAYOUT OF ROOFTOP PAVES SYSTEM FROM THIS CORNER.

Innovative Contracting Solutions

ICS

COPYRIGHT 2021/2022

7 TEQUILAS RESTAURANT
5586 OLD HIGHWAY 5 (OLD GEORGIA HIGHWAY 5 AND PAYNE ROAD)
WOODSTOCK, GEORGIA 30188

CONSTRUCTION COORDINATION DRAWINGS
PREPARED FOR INNOVATIVE CONTRACTING SOLUTIONS
3605 GLENDRIDGE DR. NE
SUITE 345 ATLANTA, GEORGIA 30342


NO.	DESCRIPTION	DATE
1	ROOF PLAN	03-14-2022
2	ROOF PLAN	03-14-2022
3	ROOF PLAN	03-14-2022
Sheet Name: ROOF PLAN

Proj #: 211201 Issue Date: 03-14-2022

Sheet No.: A105

Drawn By: KC Checked By: KC/SA

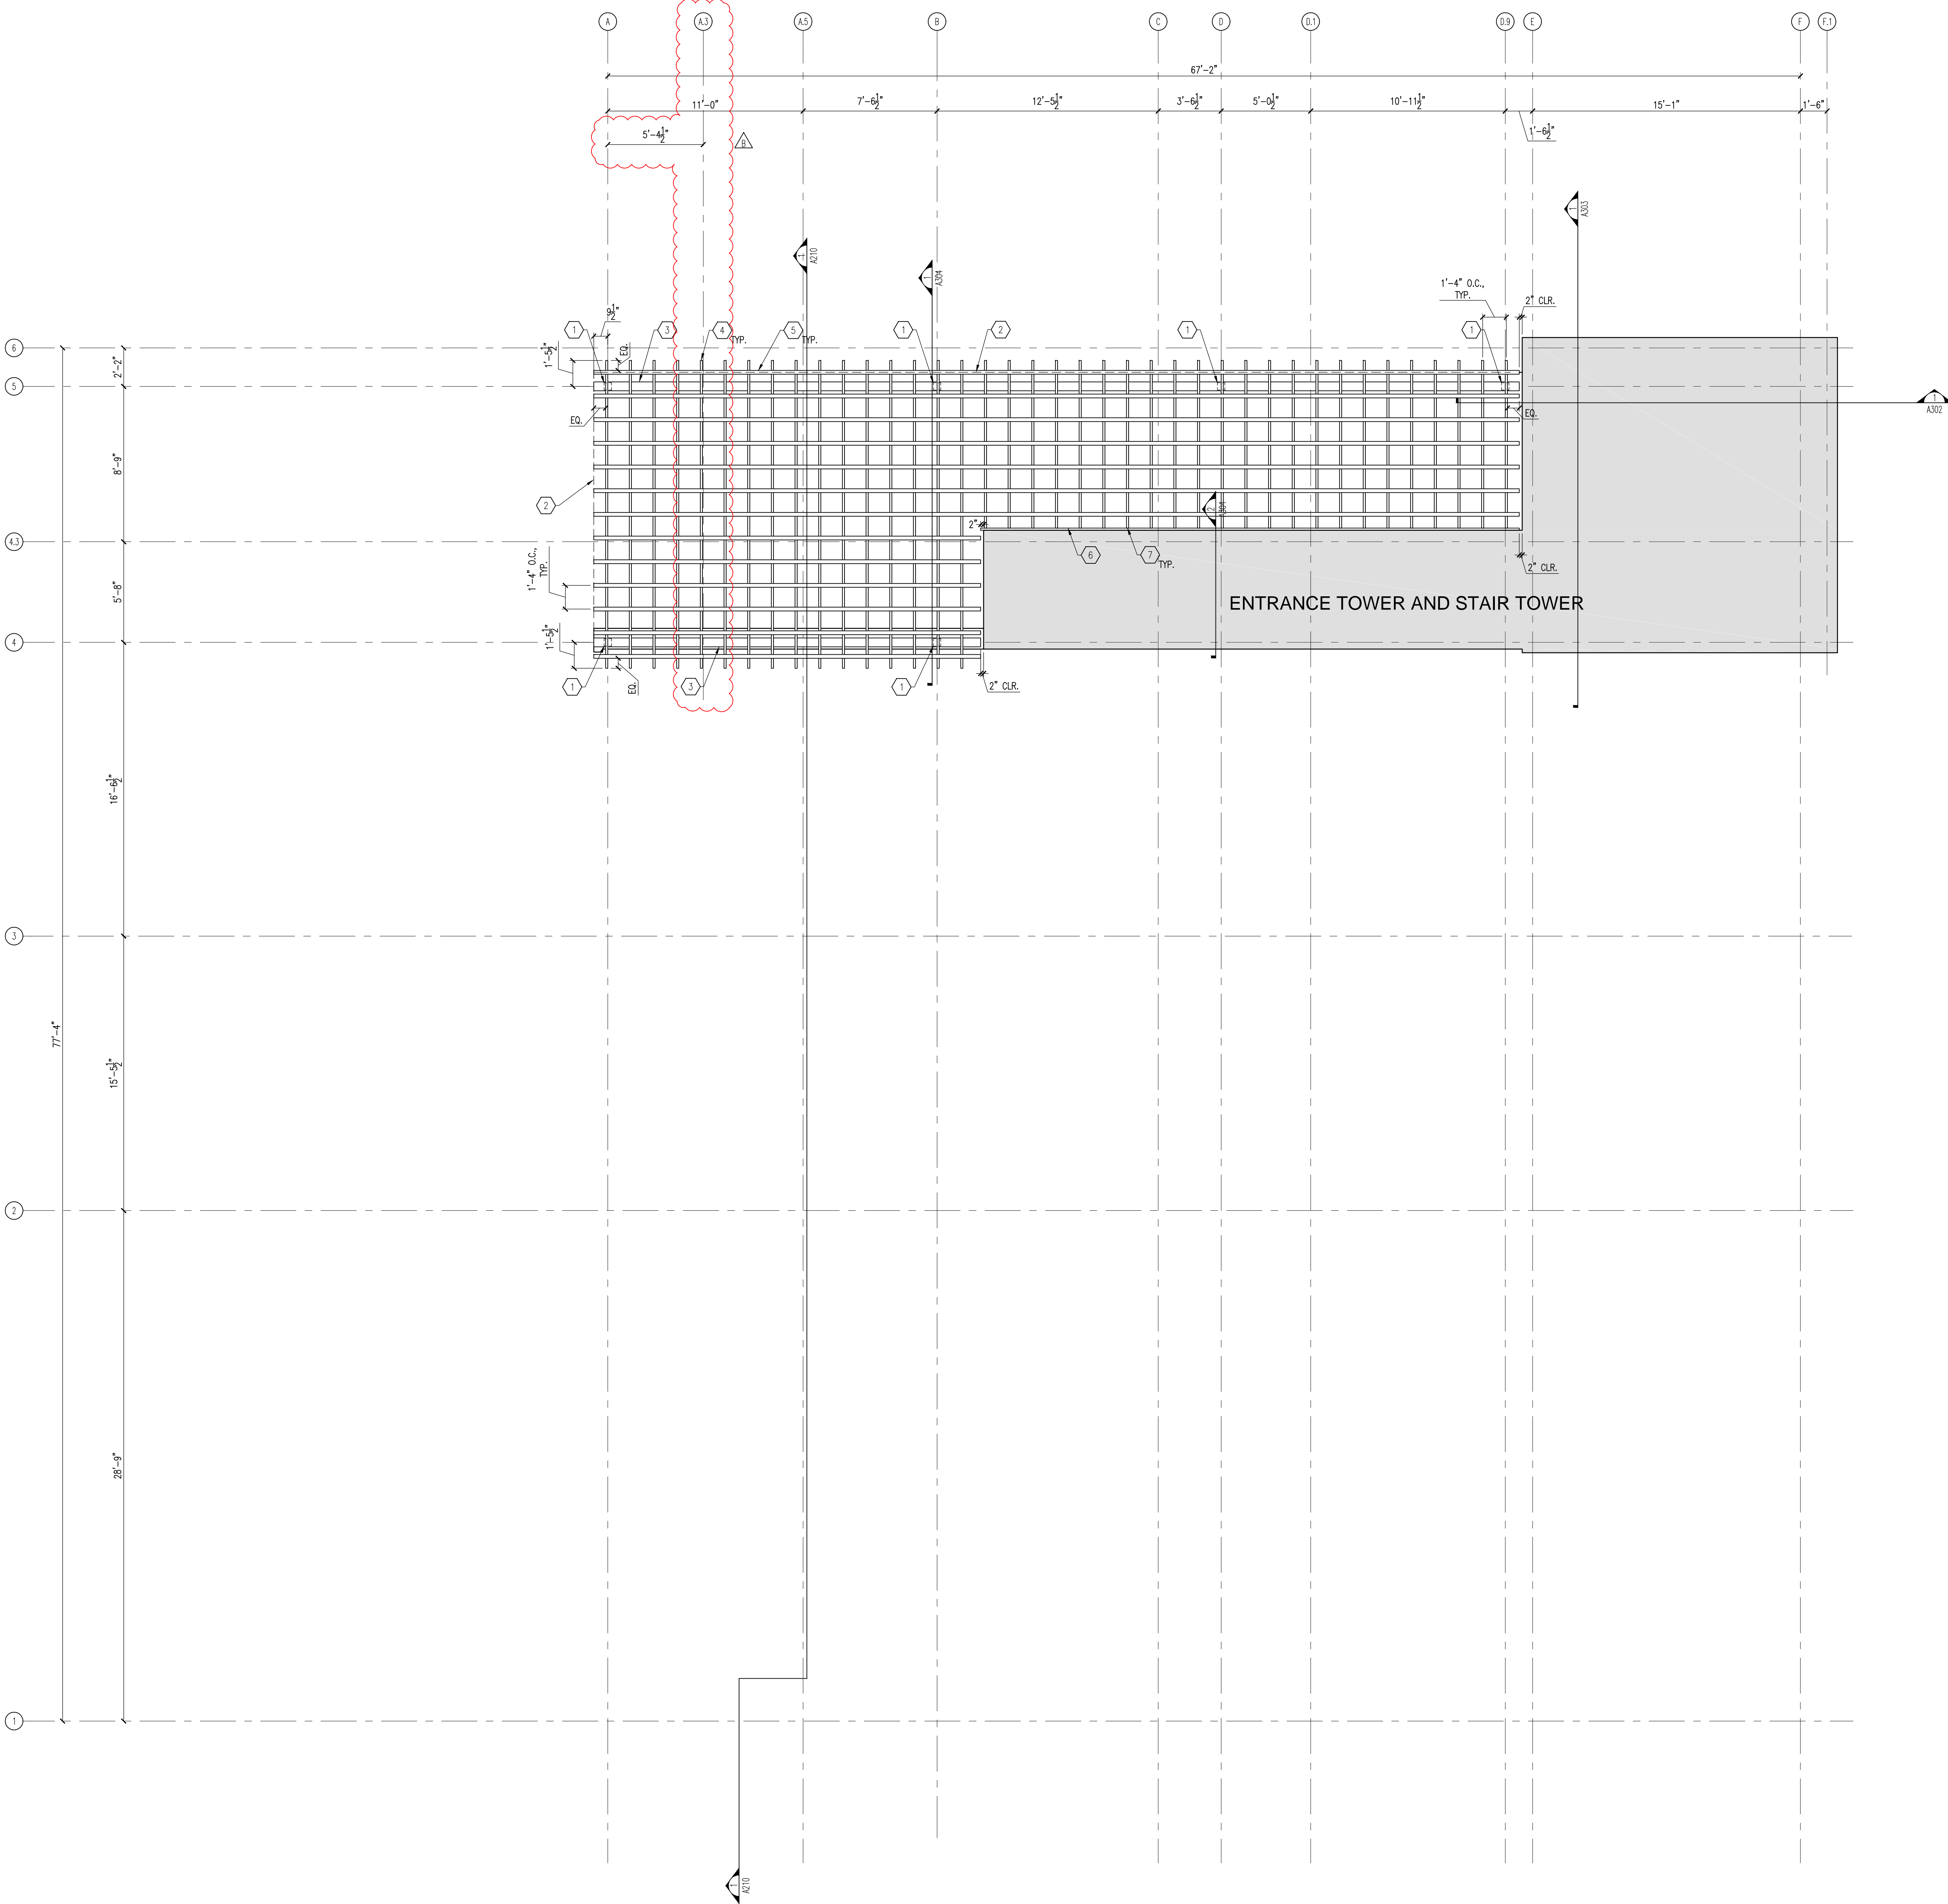


GENERAL SHEET NOTES

1. NOT ALL ITEMS MAY BE USED.
2. DIMENSIONS ARE TAKEN TO FACE OF STUD, FACE OF MASONRY OR CONCRETE, CENTERLINE OF EQUIPMENT/SKYLIGHT, OR COLUMN CENTERLINE, UNLESS INDICATED OTHERWISE.
3. CONFIRM WITH CODE OFFICIAL IF THEY WILL REQUIRE THE WOOD MEMBERS OF THE PERGOLA TO BE FIRE RETARDANT TREATED. IF THEY DO, FIELD APPLY THE FIRE RETARDANT TREATMENT. DO NOT USE TINTED FIRE RETARDANT TREATMENT FOR FIELD APPLICATION.

KEYNOTES

1. METAL COLUMNS, BELOW.
2. EDGE OF ROOFTOP PATIO, BELOW.
3. 6X12 LLV (NOM.) CEDAR WOOD BEAMS, SET IN BRACKETS AT METAL POSTS.
4. 2x8 LLV (NOM.) CEDAR WOOD RAFTERS. (2) 1/4" LAG SCREW, TOE SCREWED. INSTALL (1) ON EACH SIDE, STAGGERED. PROVIDED GALVANIZED STEEL FASTENER.
5. 2x3 LLV (NOM.) CEDAR WOOD SHADE BARS. (1) 2/4" LAG SCREW, SCREWED FROM TOP. PROVIDED GALVANIZED STEEL FASTENER.
6. 2x8 LLV (NOM.) CEDAR WOOD LEDGER BOARD, SHIM RIM JOIST FROM FACE OF MASONRY WITH 1/4" PLASTIC SHIMS. SECURE TO MASONRY WALL WITH 1/4" MASONRY SCREW AT 16" O.C. CENTERED BETWEEN RAFTERS. MIN. 1" EMBED. PROVIDE WITH 1/4" WASHER. PROVIDED GALVANIZED STEEL FASTENER.
7. WHERE RAFTERS ANCHOR INTO LEDGER BOARD, USE SIMPSON STRONG-TIE 2 APLH CONCEALED FLANGE LIGHT JOIST HANGERS, WITH BLACK POWDER COAT.

ENTRANCE TOWER AND STAIR TOWER

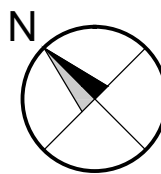

REV	DATE	DESCRIPTION
1	03-14-2022	PERGOLA PLAN
2	03-14-2022	PERGOLA PLAN
3	03-14-2022	PERGOLA PLAN

Sheet Name: PERGOLA PLAN	
Proj #: 211201	Issue Date: 03-14-2022
Sheet No.: A106	
Drawn By: KC	Checked By: KC/SA

EXTERIOR FINISH SCHEDULE


SYMBOL	DESCRIPTION
A	BRICK VENEER.
B	THIN STONE VENEER.
C	EXTERIOR INSULATION AND FINISH SYSTEM (EIFS).
D	STANDING SEAM METAL ROOF.
E	THERMALLY BROKEN ALUMINUM STOREFRONT/ENTRANCE.
F	THERMALLY BROKEN ALUMINUM BI-FOLD WINDOWS.
G	INSULATED GLASS UNITS.
H	MANUFACTURED ALUMINUM CANOPY SYSTEM.
J	PREFINISHED ALUMINUM COPING/ROOF EDGE TERMINATION.
K	PREFINISHED ALUMINUM FLASHING.
L	PREFINISHED ALUMINUM GUTTER AND DOWNSPOUT.
M	PREFINISHED ALUMINUM ROOF SCUPPER, CONDUCTOR HEAD, AND CONDUCTOR.
N	PREFINISHED ALUMINUM OVERFLOW SCUPPER.
P	GALVANIZED STEEL STAIR AND RAILING.
Q	GALVANIZED STEEL STRUCTURE.
R	GALVANIZED STEEL RAILING.
S	CEDAR WOOD PERGOLA.
T	CEDAR WOOD TRIM.
U	CEDAR WOOD DOOR.
V	GALVANIZED STEEL HOLLOW METAL DOOR AND FRAME.
W	WALK-IN REFRIGERATOR/FREEZER. COLOR AND FINISH BY KITCHEN EQUIPMENT VENDOR.
X	MANUFACTURED ALUMINUM ROOF ACCESS LADDER.
Y	LIGHT FIXTURE.
Z	THIN STONE VENEER LINTEL BAND.
AA	THIN STONE VENEER WALL CAP.
AB	THIN STONE VENEER FLAT PANEL PIECE FOR LIGHT FIXTURE MOUNTING.

SYMBOL	DESCRIPTION
1	CHEROKEE BRICK, ARCHITECTURAL COLLECTION. COLOR: VELOUR DARK GREY. NOMINAL 4"x4"x12"
2	OWENS CORNING CULTURED STONE VENEER, COUNTRY LEDGESTONE. COLOR AS SELECTED BY OWNER FROM MANUFACTURER'S FULL RANGE. APPROX. DIMENSIONS: 1/5"-6.5"x4.25"-22", AVERAGE THICKNESS 1 3/4". PROVIDE WITH MANUFACTURED CORNER PIECES.
3	STO, STOTHERM CI EIFS SYSTEM WITH DRAINABLE INSULATION. FINE TEXTURE. COLOR: MATCH PPG CHINA WHITE PPG1101-1. CONFIRM WITH OWNER.
4	PAC-CLAD PETERSON, A CARLISLE ROOFING COMPANY, SNAP-CLAD METAL ROOFING PANELS, 16" CENTERS. COLOR: BLACK ALUMINUM.
5	ALUMINUM FINISH: KYNAR COATED MATTE BLACK.
6	INSULATED GLASS UNITS: CLEAR, LOW-E. COMPLY WITH ENERGY CODE REQUIREMENTS.
7	AWNINGS ABOVE (WWW.AWNINGSABOVEUS.COM, DULUTH GEORGIA), MANUFACTURED ALUMINUM HUNG CANOPIES WITH DIAGONAL HANGER ARMS. 8" H. CHANNEL PROFILE FASCIA WITH FRONT DRAINAGE/SCUPPERS. COLOR: POWDER COAT MATTE BLACK.
8	ALUMINUM FINISH: KYNAR COATED ALUMINUM, MATCH EIFS COLOR.
9	WOOD FINISH: STAIN COAT(S) AND CLEAR WATER REPELLENT SEALER. PROVIDE NUMBER OF COATS AS RECOMMENDED BY THE MANUFACTURER FOR THE APPLICATION. COLOR AND GLOSS AS SELECTED BY THE OWNER. NOTE: CONFIRM WITH OWNER IF THEY WANT THE WOOD STAINED OR IF JUST A CLEAR SEALER IS REQUIRED.
10	EXTERIOR METAL PAINT FINISH: (1) COAT OF ALKID ENAMEL COMPATIBLE PRIMER AND (2) COATS ALKID ENAMEL FINISH COATS. COLOR: MATCH MATTE BLACK ELSEWHERE ON THE BUILDING. GLOSS: SATIN/SEMIGLOSS.
11	ROYALITE, ELSD-W ROOF ACCESS LADDER WITH SECURITY GATE. FINISH: MILL FINISH ALUMINUM.
12	LIGHT FIXTURE COLOR: BLACK KYNAR/POWDER COAT.
13	EXTERIOR METAL PAINT FINISH: (1) COAT OF ALKID ENAMEL COMPATIBLE PRIMER AND (2) COATS ALKID ENAMEL FINISH COATS. COLOR: MATCH ADJACENT EIFS COLOR ON THE BUILDING. GLOSS: SATIN/SEMIGLOSS.
14	CONCRETE STAIR PAN/DECK FILL: CLEAR WATERPROOFING SEALER. DO NOT PAINT.
15	OWENS CORNING CULTURED STONE VENEER, TUSCAN LINTEL. COLOR: RECOMMEND CHAMPAGNE OR TAUPE, CONFIRM FINAL COLOR WITH OWNER. SIZE: 6"x22"x2 5/8", CUT TO FIT AS REQUIRED.
16	OWENS CORNING CULTURED STONE VENEER, FLAGSTONE SLOPED WALL CAP. COLOR: RECOMMEND CHAMPAGNE OR TAUPE, CONFIRM FINAL COLOR WITH OWNER. SIZE: 16"x22"xL, 2"H AT EDGE, 2 3/4"H AT CENTER.
17	OWENS CORNING CULTURED STONE VENEER, FLAT TEXTURED CAPSTONES. COLOR: RECOMMEND CHAMPAGNE OR TAUPE, CONFIRM FINAL COLOR WITH OWNER. SIZE: 10"x20"x2"H. NOTE: CORE AS REQUIRED FOR LIGHT FIXTURE MOUNTING.

KEY NOTES

- OVERFLOW ROOF DRAIN DISCHARGE, SEE PLUMBING. PROVIDE CONT. JOINT SEALANT AT ALL PENETRATIONS THROUGH THE WALL. CONSTRUCTION AND FINISH MATERIALS.
- EIFS JOINT, ALIGN MASONRY CONTROL JOINTS.
- ROOFLINE, BEYOND.
- 2x4 (NOM.) CEDAR TOP TRIM. ALIGN VERTICAL PIECES WITH CENTERLINE OF WINDOW FRAMING.
- 2x12 (NOM.) CEDAR BASE TRIM.
- 2x6 (NOM.) CEDAR BACK INFILL BOARDS.
- AT SIGN LOCATION, PROVIDE PLYWOOD SHEATHING IN LIEU OF THE EXTERIOR GYPSUM BOARD. COORDINATE THE EXTENT WITH THE OWNER'S SIGNAGE VENDOR.
- ALL WIRING AND DEVICES REQUIRED FOR THE SIGNAGE SHALL BE CONCEALED WITHIN THE WALL CONSTRUCTION. PROVIDE FLUSH ACCESS PANEL AT INTERIOR FACE OF WALL FOR ACCESS/MAINTENANCE. TO GREATEST EXTENT POSSIBLE, CENTER ACCESS PANEL ON WALL HORIZONTALLY.

LEGEND

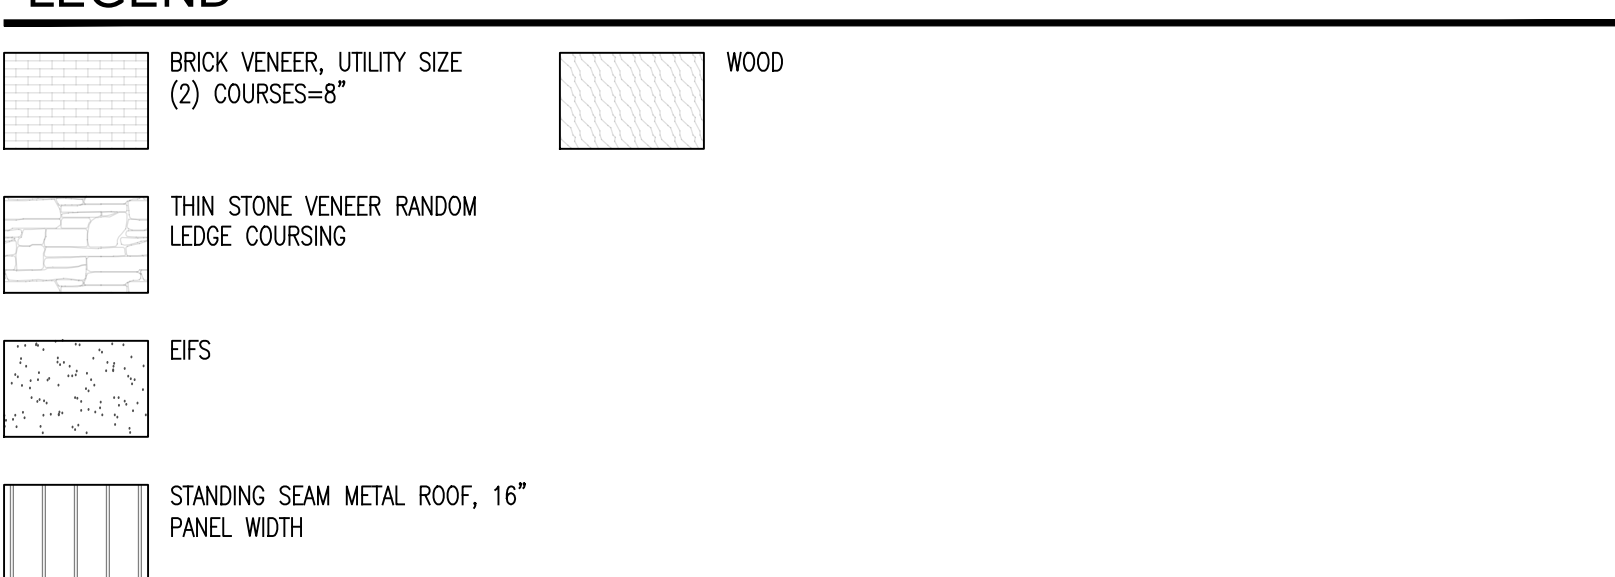


GENERAL SHEET NOTES

- NOT ALL MATERIALS MAY BE USED.
- NOT ALL KEYNOTES MAY BE USED.
- LIGHT FIXTURE DIMENSIONS ARE TAKEN TO CENTERLINE OF THE FIXTURE, UNLESS NOTED OTHERWISE.
- MASONRY/CONCRETE DIMENSIONS ARE TAKEN TO FINISH FACE OF MATERIAL(S).
- ALL HEIGHTS SHOWN ARE FROM FIRST FLOOR FINISH SLAB ELEVATION.
- GENERAL CONTRACTOR TO VERIFY MOUNTING HEIGHT WITH ARCHITECT PRIOR TO INSTALLATION OF ALL PERIMETER LIGHTING.
- C.J. = CONTROL JOINT.
- AT E.I.F.S. INSTALL CONTROL JOINT PER MANUFACTURER'S RECOMMENDATION, JOINT SHALL BE 1/2" WIDE WITH JOINT SEALANT AND BACKER ROD. JOINT SEALANT COLOR SHALL MATCH E.I.F.S. COLOR.
- AT BRICK VENEER CONTROL JOINTS, PROVIDE 1/2" CLEAR JOINT WITH JOINT SEALANT AND BACKER ROD. JOINT SEALANT COLOR SHALL MATCH GROUT COLOR.
- AT THRU-WALL C.M.U. CONTROL JOINTS, PROVIDE 1/2" CLEAR JOINT WITH CONT. INORGANIC CONTROL JOINT GASKET, JOINT SEALANT, AND BACKER ROD.
- AT TILT-UP CONCRETE CONTROL JOINTS, PROVIDE 1/2" CLEAR JOINT WITH CONT. INORGANIC CONTROL JOINT GASKET, JOINT SEALANT, AND BACKER ROD.
- AT ALL BUILDING SIGNAGE AND GRAPHIC PANELS OCCURRING AT STUD WALL FRAMING, PROVIDE 5/8" FIRE-TREATED PLYWOOD SHEATHING AS REQUIRED FOR PROPER SIGNAGE AND GRAPHIC PANEL SUPPORT. COORDINATE WITH L.A.F. SIGNAGE VENDOR.
- COORDINATE ALL ELECTRICAL REQUIREMENTS AND LOCATIONS WITH LAF SIGNAGE VENDOR PRIOR TO PROCEEDING WITH THE WORK. ALL ELECTRICAL SERVICE POINTS SHALL BE LOCATED IN AN ACCESSIBLE AREA AND CONCEALED FROM PUBLIC VIEW.
- COPINGS/ROOF EDGE TERMINATIONS.
- COPINGS/ROOF EDGE TERMINATIONS AT E.I.F.S. SHALL MATCH ADJACENT E.I.F.S. COLOR(S).
- COPINGS/ROOF EDGE TERMINATIONS AT METAL PANELS SHALL MATCH ADJACENT METAL PANEL COLOR.
- GUTTERS AND DOWNSPOUTS: COLOR SHALL MATCH ADJACENT ROOF EDGE TERMINATION COLOR.
- HOLLOW METAL DOORS AND FRAMES: SHALL BE PAINTED TO MATCH ADJACENT WALL COLOR.


CONFIRM ALL FINAL FINISH SELECTIONS WITH THE OWNER PRIOR TO ORDERING MATERIALS OR PROCEEDING WITH THE WORK.

APPROVED EQUALS FOR ALL NAMED PRODUCTS SHALL BE CONSIDERED AT THE OWNER'S DISCRETION.

ALL MASONRY CONTROL JOINTS SHALL ALIGN WITH NATURAL MORTAR JOINTS TO THE GREATEST EXTENT POSSIBLE. VERIFY IN FIELD.

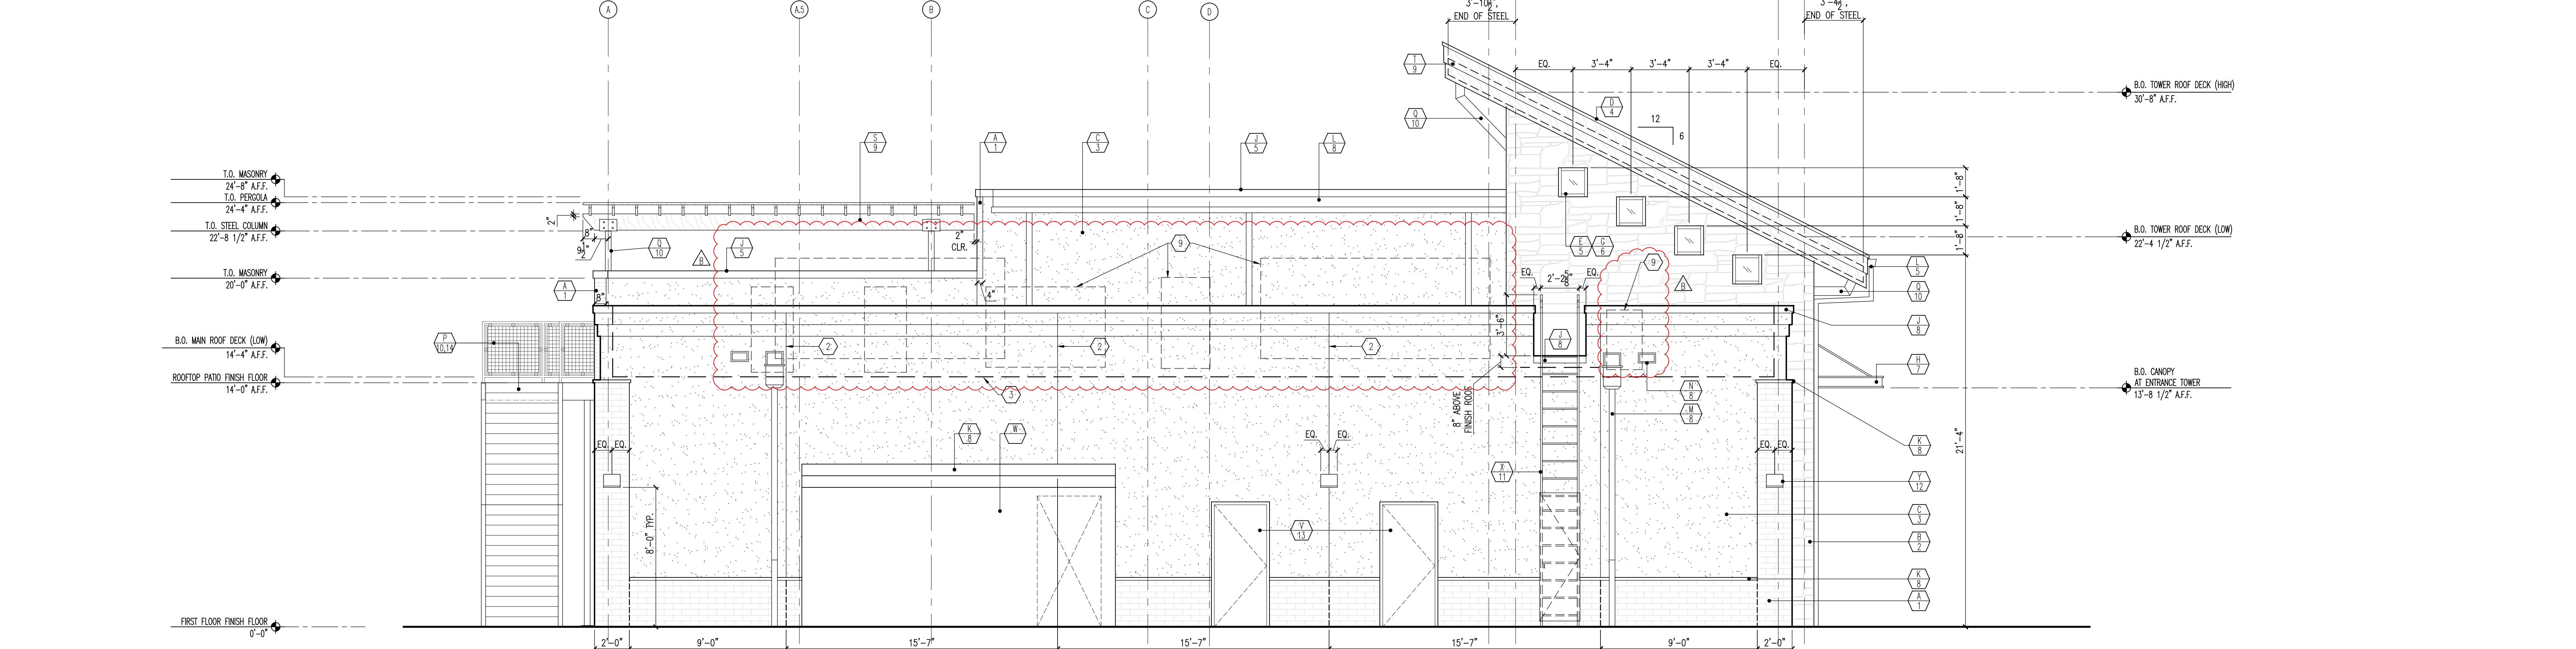

2 REAR ELEVATION
1/4"=1'-0"

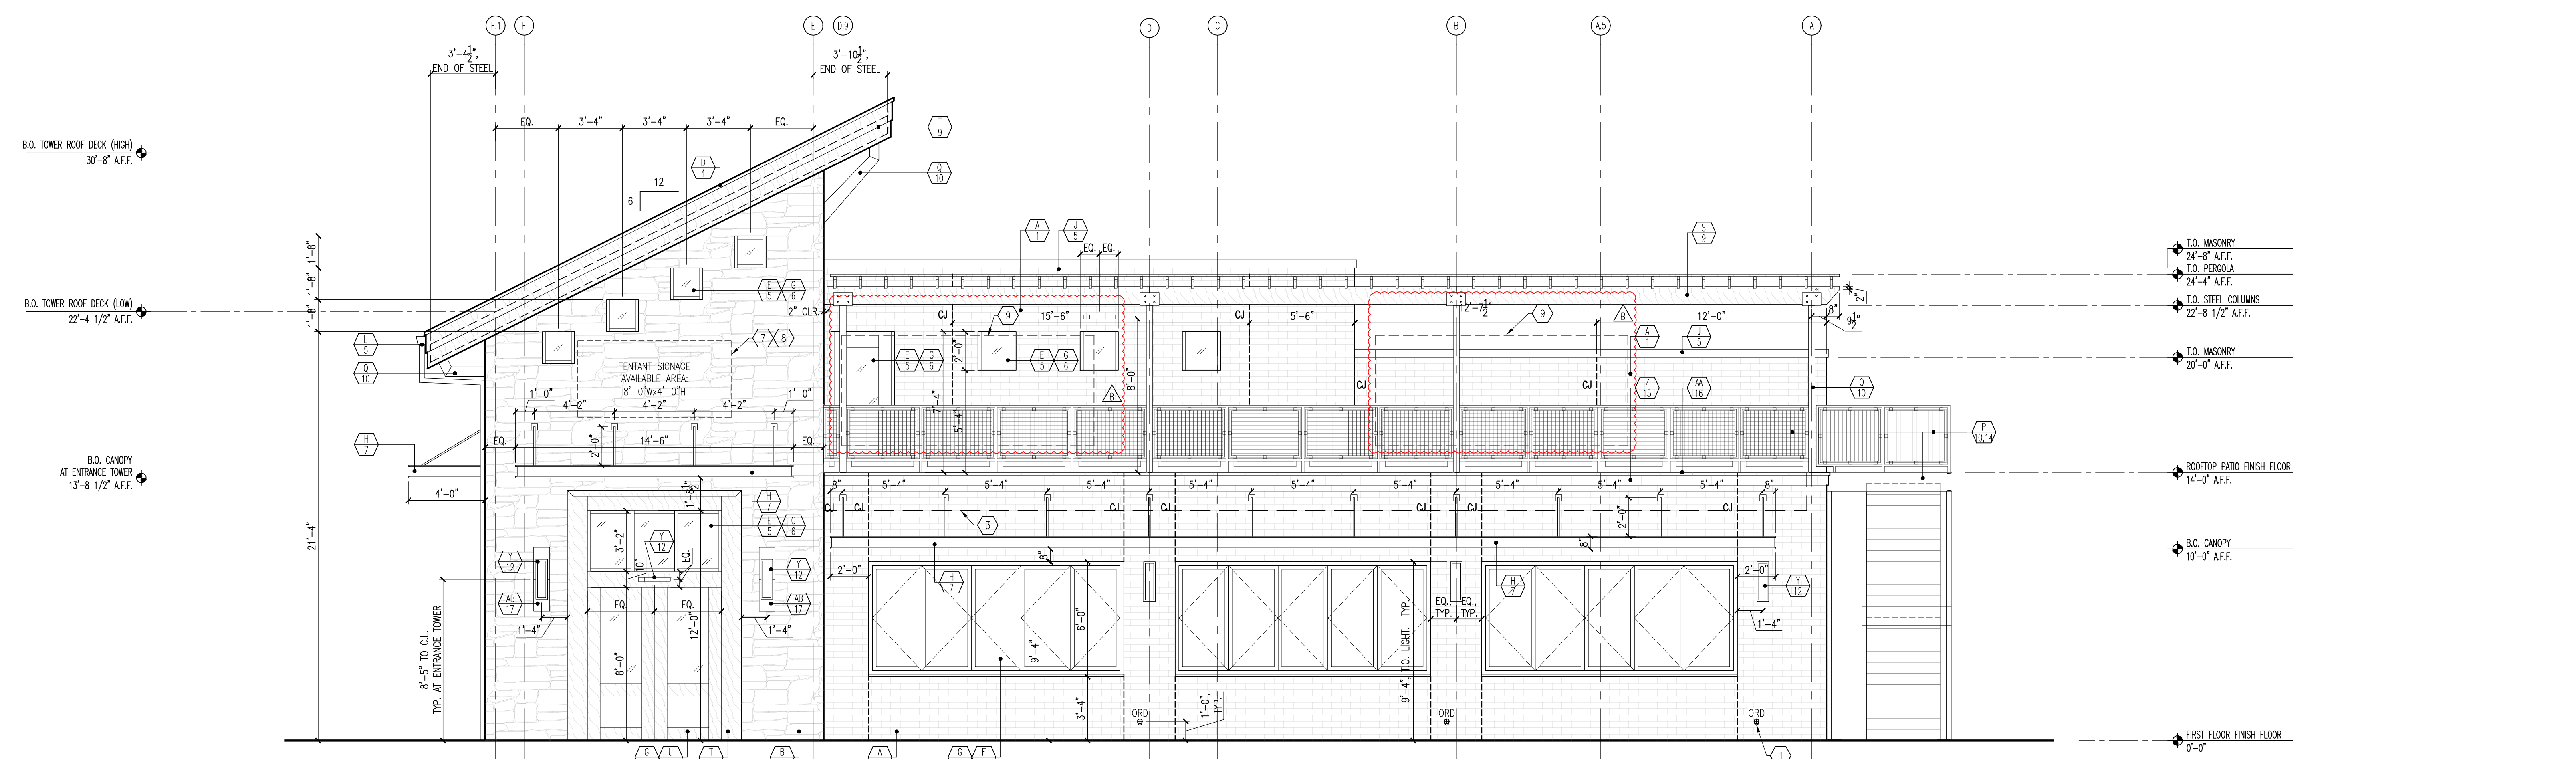

1 FRONT ELEVATION
1/4"=1'-0"

EXTERIOR FINISH SCHEDULE


SYMBOL	DESCRIPTION
A	BRICK VENEER.
B	THIN STONE VENEER.
C	EXTERIOR INSULATION AND FINISH SYSTEM (EIFS).
D	STANDING SEAM METAL ROOF.
E	THERMALLY BROKEN ALUMINUM STOREFRONT/ENTRANCE.
F	INSULATED GLASS UNITS.
H	MANUFACTURED ALUMINUM CANOPY SYSTEM.
J	PREFINISHED ALUMINUM COPING/ROOF EDGE TERMINATION.
K	PREFINISHED ALUMINUM FLASHING.
L	PREFINISHED ALUMINUM GUTTER AND DOWNSPOUT.
M	PREFINISHED ALUMINUM ROOF SCUPPER, CONDUCTOR HEAD, AND CONDUCTOR.
N	PREFINISHED ALUMINUM OVERFLOW SCUPPER.
P	GALVANIZED STEEL STAIR AND RAILING.
Q	GALVANIZED STEEL STRUCTURE.
R	GALVANIZED STEEL RAILING.
S	CEDAR WOOD PERGOLA.
T	CEDAR WOOD TRIM.
U	CEDAR WOOD DOOR.
V	GALVANIZED STEEL HOLLOW METAL DOOR AND FRAME.
W	WALK-IN REFRIGERATOR/FREEZER. COLOR AND FINISH BY KITCHEN EQUIPMENT VENDOR.
X	MANUFACTURED ALUMINUM ROOF ACCESS LADDER.
Y	LIGHT FIXTURE.
Z	THIN STONE VENEER LINTEL BAND.
AA	THIN STONE VENEER WALL CAP.
AB	THIN STONE VENEER FLAT PANEL PIECE FOR LIGHT FIXTURE MOUNTING.

SYMBOL	DESCRIPTION
1	CHEROKEE BRICK, ARCHITECTURAL COLLECTION. COLOR: VELOUR DARK GREY. NOMINAL 4"x4"x12"
2	OWENS CORNING CULTURED STONE VENEER, COUNTRY LEDGESTONE. COLOR AS SELECTED BY OWNER FROM MANUFACTURER'S FULL RANGE. APPROX. DIMENSIONS: 1/5"-6.5"x4.25"-22"L. AVERAGE THICKNESS 1 3/4". PROVIDE WITH MANUFACTURED CORNER PIECES.
3	STO, STOTHELM CI EIFS SYSTEM WITH DRAINABLE INSULATION. FINE TEXTURE. COLOR: MATCH PPG CHINA WHITE PPG1101-1. CONFIRM WITH OWNER.
4	PAC-CLAD PETERSON, A CARLISLE ROOFING COMPANY, SNAP-CLAD METAL ROOFING PANELS, 16" CENTERS. COLOR: BLACK ALUMINUM.
5	ALUMINUM FINISH: KYMAR COATED MATTE BLACK.
6	INSULATED GLASS UNITS: CLEAR, LOW-E. COMPLY WITH ENERGY CODE REQUIREMENTS.
7	AWNINGS ABOVE (WWW.AWNINGSABOVEUS.COM, DULUTH GEORGIA), MANUFACTURED ALUMINUM HUNG CANOPIES WITH DIAGONAL HANGER ARMS. 8" CHANNEL PROFILE FASCIA WITH FRONT DRAINAGE/SCUPPERS. COLOR: POWDER COAT MATTE BLACK.
8	ALUMINUM FINISH: KYMAR COATED ALUMINUM, MATCH EIFS COLOR.
9	WOOD FINISH: STAIN COAT(S) AND CLEAR WATER REPELLENT SEALER. PROVIDE NUMBER OF COATS AS RECOMMENDED BY THE MANUFACTURER FOR THE APPLICATION. COLOR AND GLOSS AS SELECTED BY THE OWNER. NOTE: CONFIRM WITH OWNER IF THEY WANT THE WOOD STAINED OR IF JUST A CLEAR SEALER IS REQUIRED.
10	EXTERIOR METAL PAINT FINISH: (1) COAT OF ALKID ENAMEL COMPATIBLE PRIMER AND (2) COATS ALKID ENAMEL FINISH COATS. COLOR: MATCH MATTE BLACK ELSEWHERE ON THE BUILDING. GLOSS: SATIN/SEMIGLOSS.
11	ROYALITE, ELSD-W ROOF ACCESS LADDER WITH SECURITY GATE. FINISH: MILL FINISH ALUMINUM.
12	LIGHT FIXTURE COLOR: BLACK KYMAR/POWDER COAT.
13	EXTERIOR METAL PAINT FINISH: (1) COAT OF ALKID ENAMEL COMPATIBLE PRIMER AND (2) COATS ALKID ENAMEL FINISH COATS. COLOR: MATCH ADJACENT EIFS COLOR ON THE BUILDING. GLOSS: SATIN/SEMIGLOSS.
14	CONCRETE STAIR PAN/DECK FILL: CLEAR WATERPROOFING SEALER. DO NOT PAINT.
15	OWENS CORNING CULTURED STONE VENEER, TUSCAN LINTEL. COLOR: RECOMMEND CHAMPAGNE OR TAUPE, CONFIRM FINAL COLOR WITH OWNER. SIZE: 6"x22"x2 5/8"D, CUT TO FIT AS REQUIRED.
16	OWENS CORNING CULTURED STONE VENEER, FLAGSTONE SLOPED WALL CAP. COLOR: RECOMMEND CHAMPAGNE OR TAUPE, CONFIRM FINAL COLOR WITH OWNER. SIZE: 16"Wx22"L, 2"H AT EDGE, 2 3/4"H AT CENTER.
17	OWENS CORNING CULTURED STONE VENEER, FLAT TEXTURED CAPSTONES. COLOR: RECOMMEND CHAMPAGNE OR TAUPE, CONFIRM FINAL COLOR WITH OWNER. SIZE: 10"Wx20"Lx2"H. NOTE CORE AS REQUIRED FOR LIGHT FIXTURE MOUNTING.

KEY NOTES

- OVERFLOW ROOF DRAIN DISCHARGE. SEE PLUMBING. PROVIDE CONT. JOINT SEALANT AT ALL PENETRATIONS THROUGH THE WALL.
- EIFS JOINT, ALIGN MASONRY CONTROL JOINTS.
- ROOFLINE, BEYOND.
- 2x4 (NOM.) CEDAR TOP TRIM. ALIGN VERTICAL PIECES WITH CENTERLINE OF WINDOW FRAMING.
- 2x12 (NOM.) CEDAR BASE TRIM.
- 2x6 (NOM.) CEDAR BACK INFILL BOARDS.
- AT SIGN LOCATION, PROVIDE PLYWOOD SHEATHING IN LIEU OF THE EXTERIOR GYPSUM BOARD. COORDINATE THE EXTENT WITH THE OWNER'S SIGNAGE VENDOR.
- ALL WIRING AND DEVICES REQUIRED FOR THE SIGNAGE SHALL BE CONCEALED WITHIN THE WALL CONSTRUCTION. PROVIDE FLUSH ACCESS PANEL AT INTERIOR FACE OF WALL FOR ACCESS/MAINTENANCE. TO GREATEST EXTENT POSSIBLE, CENTER ACCESS PANEL ON WALL HORIZONTALLY.
- ROOF MOUNTED MECHANICAL EQUIPMENT.

LEGEND

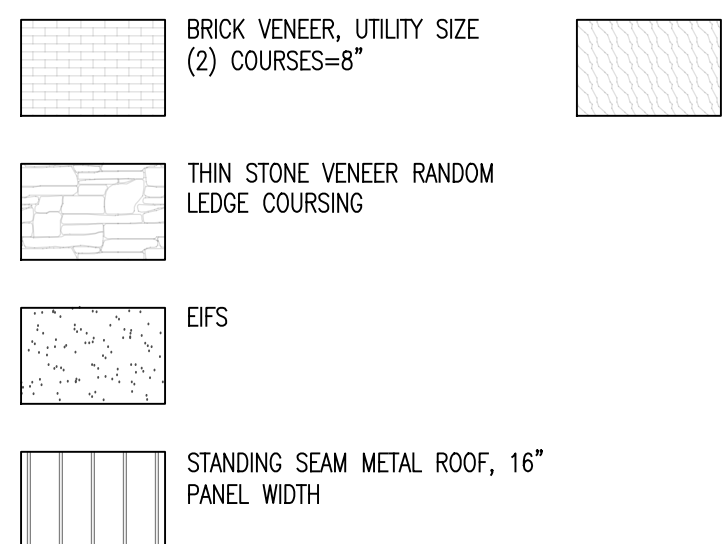


GENERAL SHEET NOTES

- NOT ALL MATERIALS MAY BE USED.
- NOT ALL KEYNOTES MAY BE USED.
- LIGHT FIXTURE DIMENSIONS ARE TAKEN TO CENTERLINE OF THE FIXTURE, UNLESS NOTED OTHERWISE.
- MASONRY/CONCRETE DIMENSIONS ARE TAKEN TO FINISH FACE OF MATERIAL(S).
- ALL HEIGHTS SHOWN ARE FROM FIRST FLOOR FINISH SLAB ELEVATION.
- GENERAL CONTRACTOR TO VERIFY MOUNTING HEIGHT WITH ARCHITECT PRIOR TO INSTALLATION OF ALL PERIMETER LIGHTING.
- C.J. = CONTROL JOINT.
- AT E.I.F.S. INSTALL CONTROL JOINT PER MANUFACTURER'S RECOMMENDATION, JOINT SHALL BE 1/2" WIDE WITH JOINT SEALANT AND BACKER ROD. JOINT SEALANT COLOR SHALL MATCH E.I.F.S. COLOR.
- AT BRICK VENEER CONTROL JOINTS, PROVIDE 1/2" CLEAR JOINT WITH JOINT SEALANT AND BACKER ROD. JOINT SEALANT COLOR SHALL MATCH GROUT COLOR.
- AT THRU-WALL C.M.U. CONTROL JOINTS, PROVIDE 1/2" CLEAR JOINT WITH CONT. INORGANIC CONTROL JOINT GASKET, JOINT SEALANT, AND BACKER ROD.
- AT TILT-UP CONCRETE CONTROL JOINTS, PROVIDE 1/2" CLEAR JOINT WITH CONT. INORGANIC CONTROL JOINT GASKET, JOINT SEALANT, AND BACKER ROD.
- AT ALL BUILDING SIGNAGE AND GRAPHIC PANELS OCCURRING AT STUD WALL FRAMING, PROVIDE 5/8" FIRE-TREATED PLYWOOD SHEATHING AS REQUIRED FOR PROPER SIGNAGE AND GRAPHIC PANEL SUPPORT. COORDINATE WITH L.A.F. SIGNAGE VENDOR.
- COORDINATE ALL ELECTRICAL REQUIREMENTS AND LOCATIONS WITH LAF SIGNAGE VENDOR PRIOR TO PROCEEDING WITH THE WORK. ALL ELECTRICAL SERVICE POINTS SHALL BE LOCATED IN AN ACCESSIBLE AREA AND CONCEALED FROM PUBLIC VIEW.
- COPINGS/ROOF EDGE TERMINATIONS.
- 9.1. COPINGS/ROOF EDGE TERMINATIONS AT E.I.F.S. SHALL MATCH ADJACENT E.I.F.S. COLOR(S).
- 9.2. COPINGS/ROOF EDGE TERMINATIONS AT METAL PANELS SHALL MATCH ADJACENT METAL PANEL COLOR.
- GUTTERS AND DOWNSPOUTS: COLOR SHALL MATCH ADJACENT ROOF EDGE TERMINATION COLOR.
- HOLLOW METAL DOORS AND FRAMES: SHALL BE PAINTED TO MATCH ADJACENT WALL COLOR.


CONFIRM ALL FINAL FINISH SELECTIONS WITH THE OWNER PRIOR TO ORDERING MATERIALS OR PROCEEDING WITH THE WORK.

APPROVED EQUALS FOR ALL NAMED PRODUCTS SHALL BE CONSIDERED AT THE OWNER'S DISCRETION.

ALL MASONRY CONTROL JOINTS SHALL ALIGN WITH NATURAL MORTAR JOINTS TO THE GREATEST EXTENT POSSIBLE. VERIFY IN FIELD.

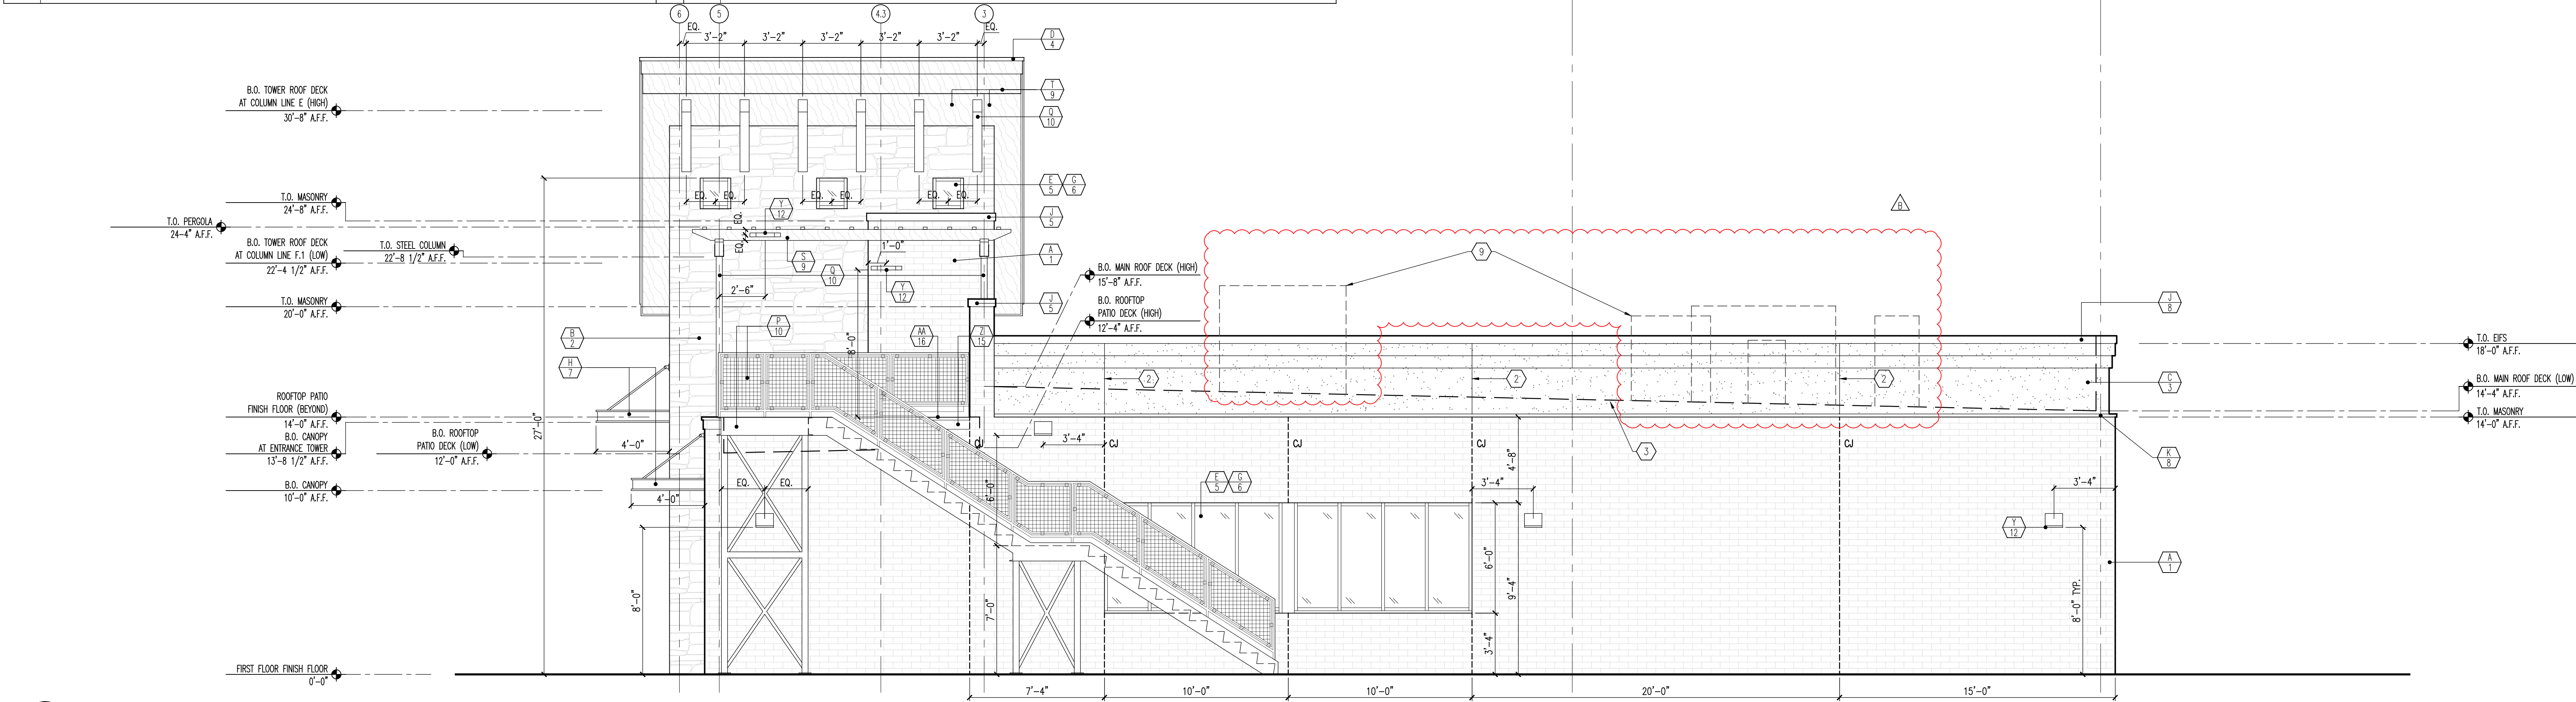

2 RIGHT ELEVATION
1/4"=1'-0"

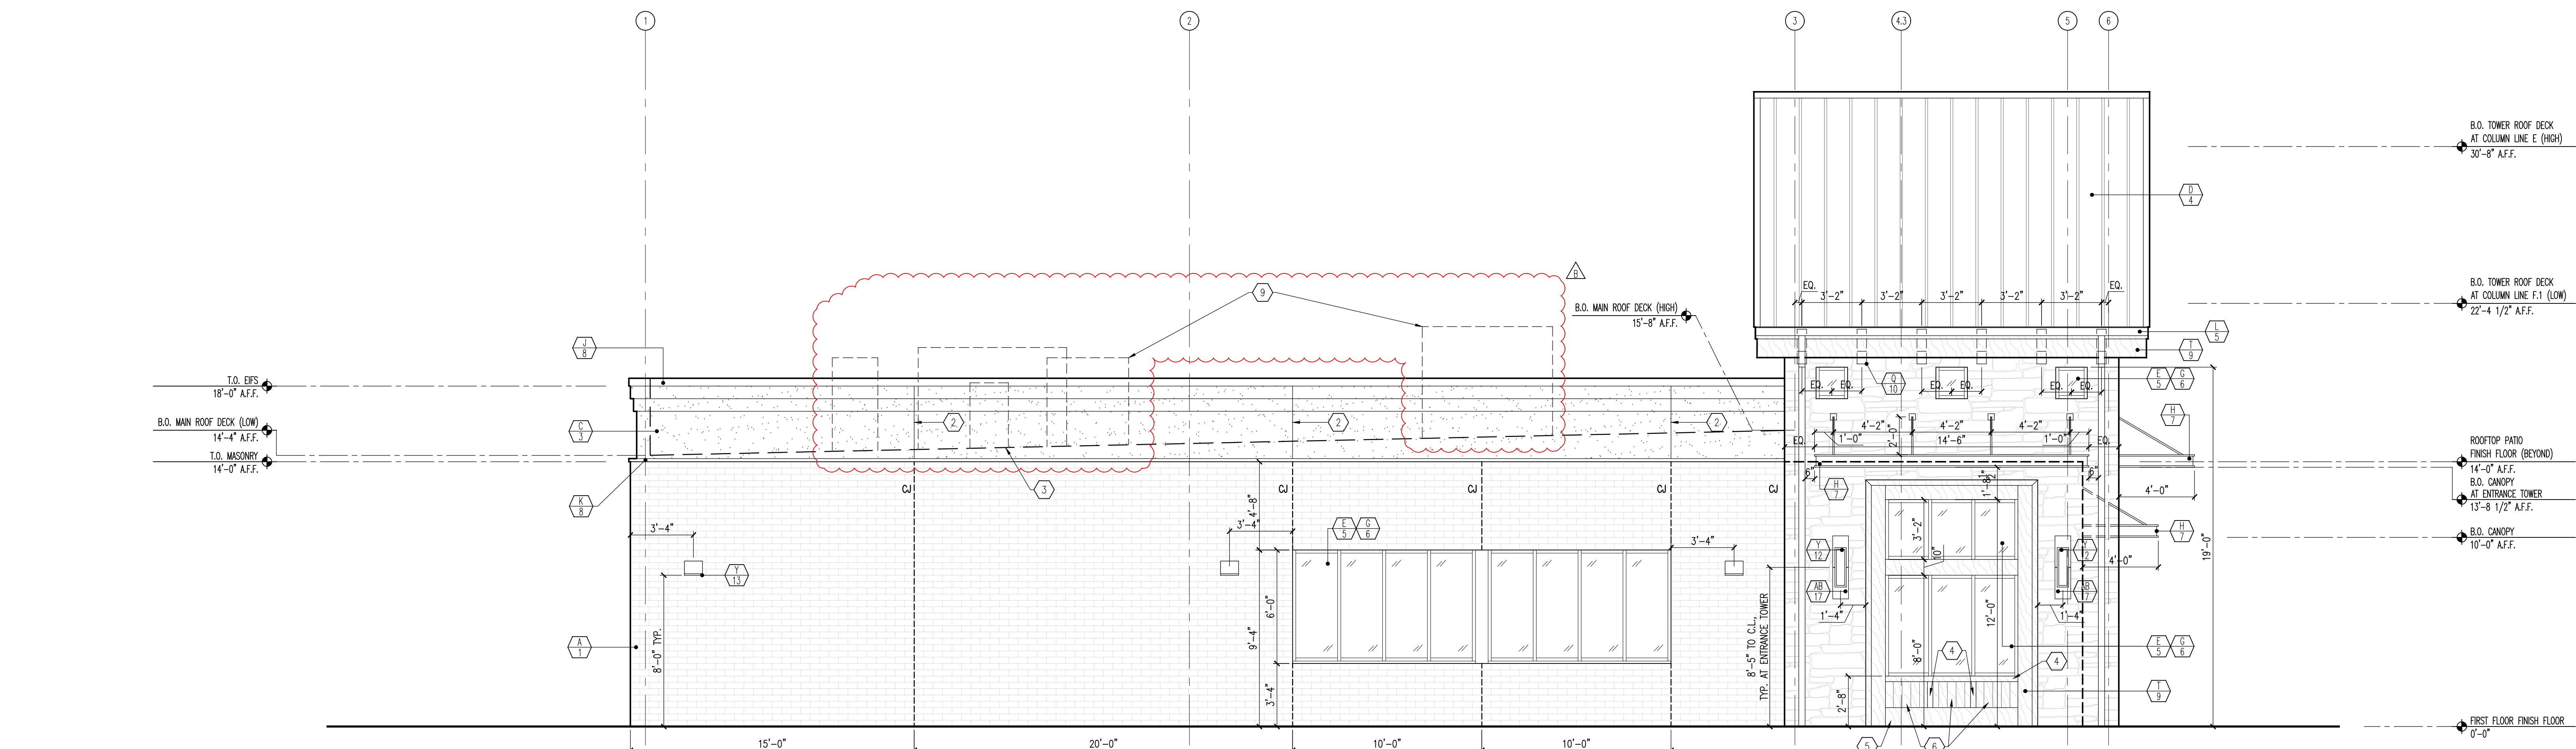

1 LEFT ELEVATION
1/4"=1'-0"

NO.	DESCRIPTION	DATE
1	ISSUED FOR PERMIT	03-14-2022
2	FOR CONSTRUCTION	03-14-2022
3	FOR CONSTRUCTION	03-14-2022
Sheet Name: EXTERIOR ELEVATIONS	
Proj #: 211201	Issue Date: 03-14-2022
Sheet No.: A202	
Drawn By: KC	Checked By: KC/SA

1. NOT ALL ITEMS MAY BE USED.
2. DIMENSIONS ARE TAKEN TO FACE OF STUD, FACE OF MASONRY OR CONCRETE, OR COLUMN CENTERLINE, UNLESS INDICATED OTHERWISE.
3. CONTRACTOR SHALL COORDINATE STUD FRAMING LAAYOUT TO ENSURE PROPER SUPPORT FOR ARCHITECTURAL COMPOSITE PANEL (A.C.M.) SYSTEM. THIS SHALL INCLUDE, BUT NOT BE LIMITED TO: BRACKETS, SUPPORTS, TRIMS, FLASHINGS, AND FASTENERS.
4. EXISTING DRAWINGS ARE NOT AVAILABLE FOR THE ORIGINAL BUILDING. CONTRACTOR SHALL VERIFY ALL FIELD CONDITIONS AND REPORT ALL DISCREPANCIES AND CONFLICTS TO THE ARCHITECT FOR RESOLUTION PRIOR TO PROCEEDING WITH THE WORK.


1. DINING RTU.
2. BAR CEILING.
3. EXPOSED DUCTWORK IN DINING AREA. ALL EXPOSED DUCTWORK SHALL BE SUSPENDED BY AIRCRAFT CABLE DUCT HANGERS. UNINSULATED METAL STACK HANGERS SHALL NOT BE ACCEPTED. MAINTAIN ALL DUCTWORK ABOVE BAR CEILING.
4. TRANSITION DUCTWORK DOWN AT BAR CEILING TO FEED WALL LOUVERS SERVING THE FIRST FLOOR PATIO. COORDINATE BLOCKING AND FRAMING REQUIREMENTS AS REQUIRED.
5. VERIFY WALL LOUVER ELEVATION WITH DAMPER REQUIREMENT. ADJUST HEIGHT OF LOUVER, IF REQUIRED. HOLD ALL WALL LOUVERS AT FIRST FLOOR PATIO AT THE SAME ELEVATION. PROVIDE ACCESS PANELS IN BAR CEILING TO ACCESS DAMPER CONTROLS.
6. KITCHEN RTU.
7. KITCHEN RTU DUCTWORK. TRANSITION DOWN IN THE KITCHEN AS REQUIRED.
8. KITCHEN HOOD MAKE-UP AIR DUCTWORK. COORDINATE LOCATION IN FIELD WITH KITCHEN HOOD CONSTRUCTION AND HANGER RODS. IF REQUIRED, STACK OVER KITCHEN RTU DUCTWORK AS SHOWN.
9. KITCHEN EXHAUST FAN.
10. KITCHEN EXHAUST FAN DUCTWORK.
11. KITCHEN EXHAUST HOOD.
12. KITCHEN EQUIPMENT VENDOR SHALL PROVIDE STAINLESS STEEL CLOSURE PANELS ABOVE HOOD AS REQUIRED. TYPICAL ALL SIDES.

[illegible]

1. SEE SHEET A301 FOR GENERAL SHEET NOTES AND GENERAL MATERIAL NOTES.

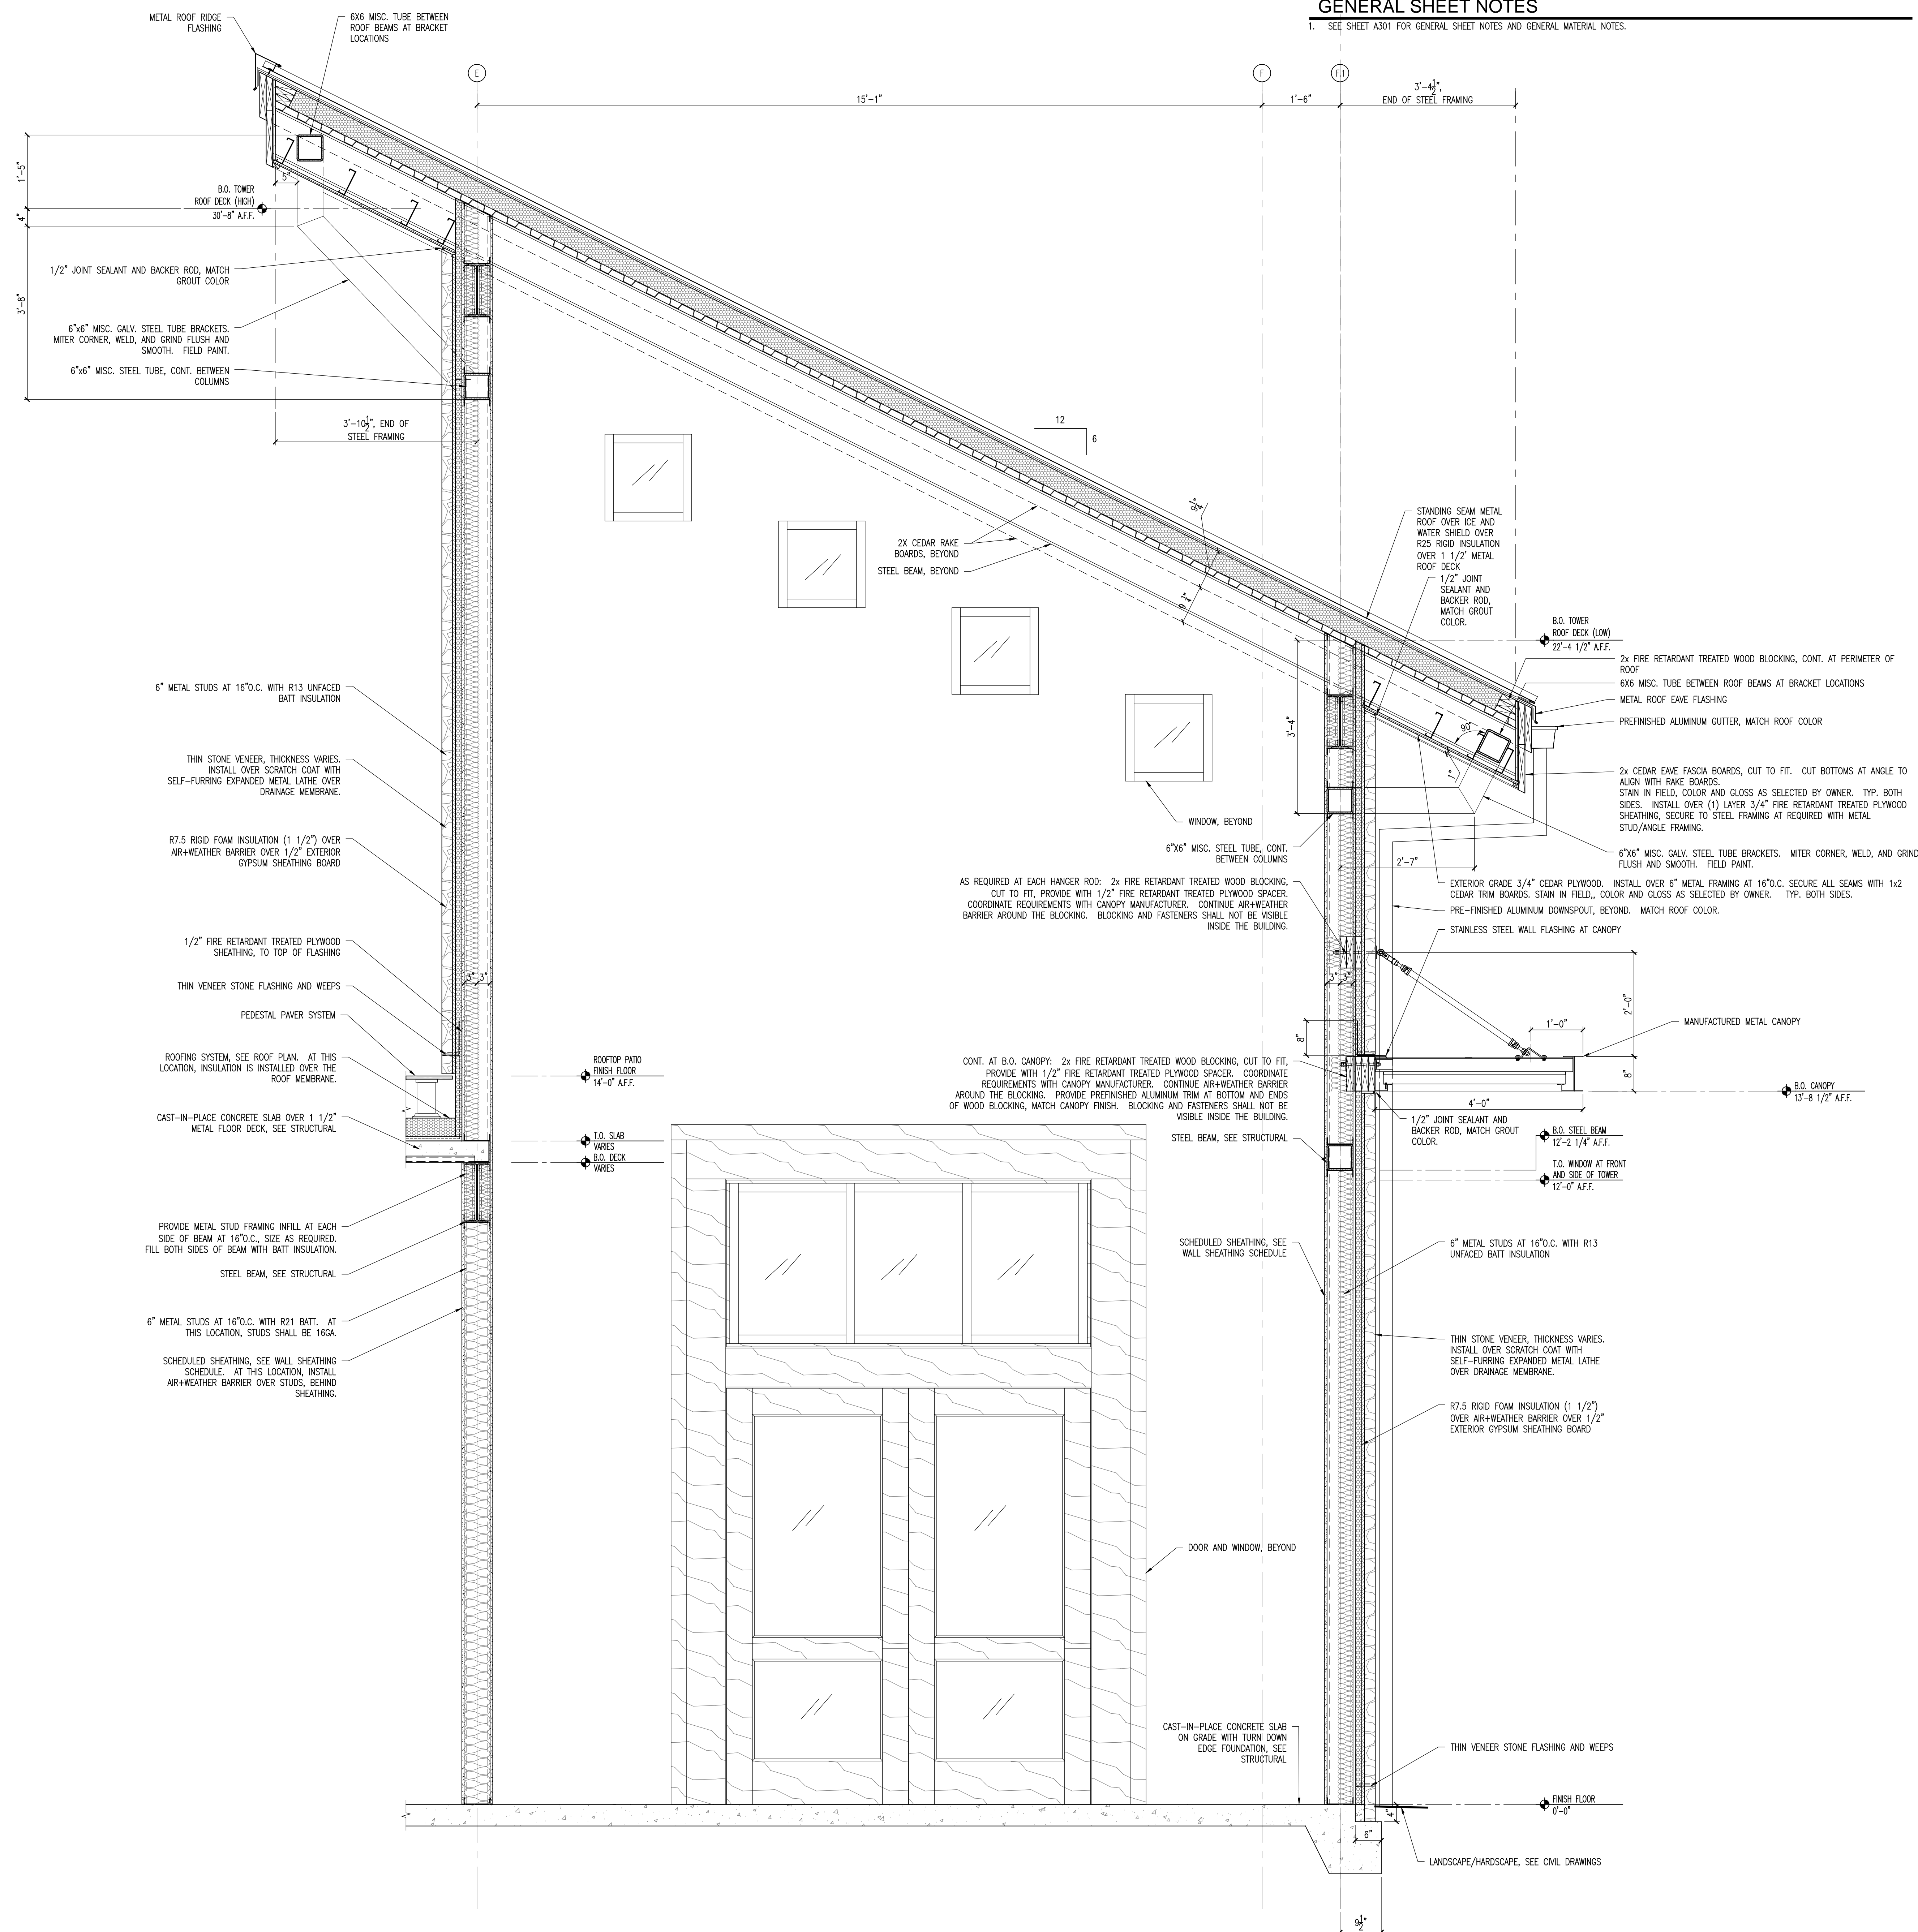

1 WALL SECTION AT ENTRANCE TOWER

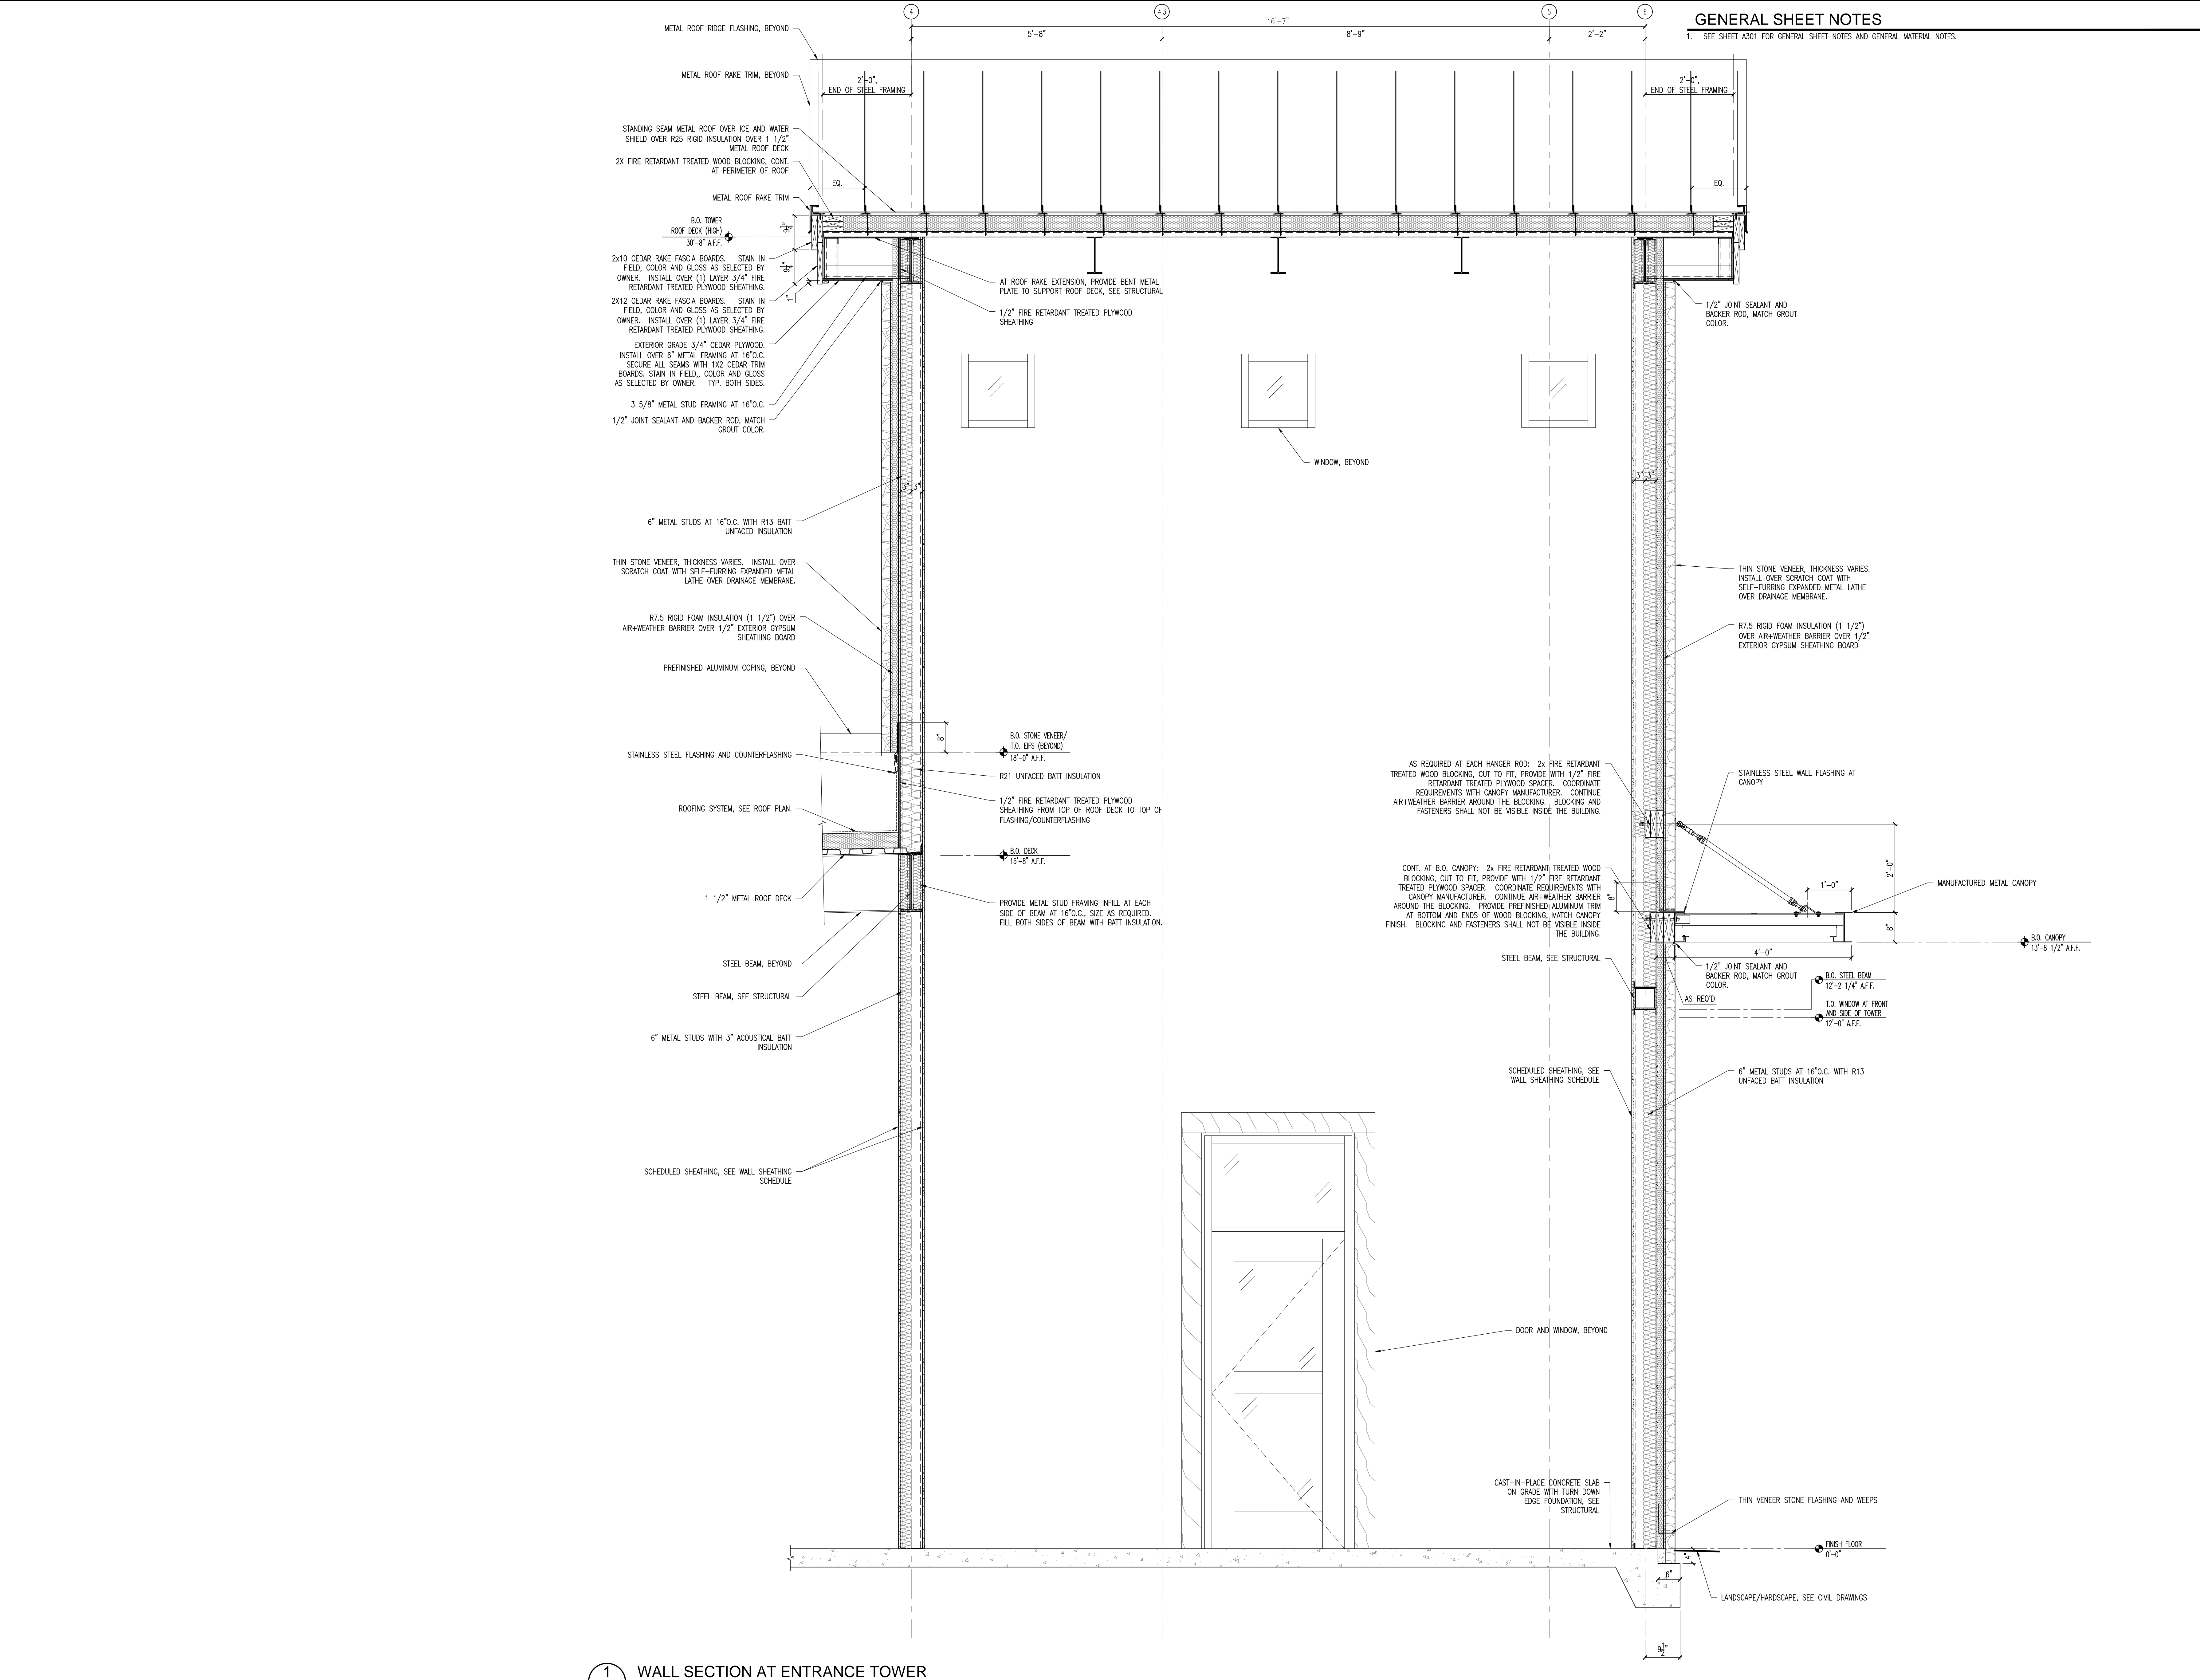

GENERAL SHEET NOTES

1. SEE SHEET A301 FOR GENERAL SHEET NOTES AND GENERAL MATERIAL NOTES.

COPYRIGHT 2021/2022

7 TEQUILAS RESTAURANT
5586 OLD HIGHWAY 5 (OLD GEORGIA HIGHWAY 5 AND PAYNE ROAD)
WOODSTOCK, GEORGIA 30188



CONSTRUCTION COORDINATION DRAWINGS
PREPARED FOR INNOVATIVE CONTRACTING SOLUTIONS
3605 GLENDRIDGE DR. NE
SUITE 345 ATLANTA, GEORGIA 30342

No.	Description	Date
01	03-14-2022	03-14-2022
02	03-14-2022	03-14-2022
03	03-14-2022	03-14-2022
Sheet Name: WALL SECTIONS	
Proj #: 211201	Issue Date: 03-14-2022
Sheet No.: A303	
Drawn By: KC	Checked By: KC/SA

GENERAL SHEET NOTES

1. SEE SHEET A301 FOR GENERAL SHEET NOTES AND GENERAL MATERIAL NOTES.

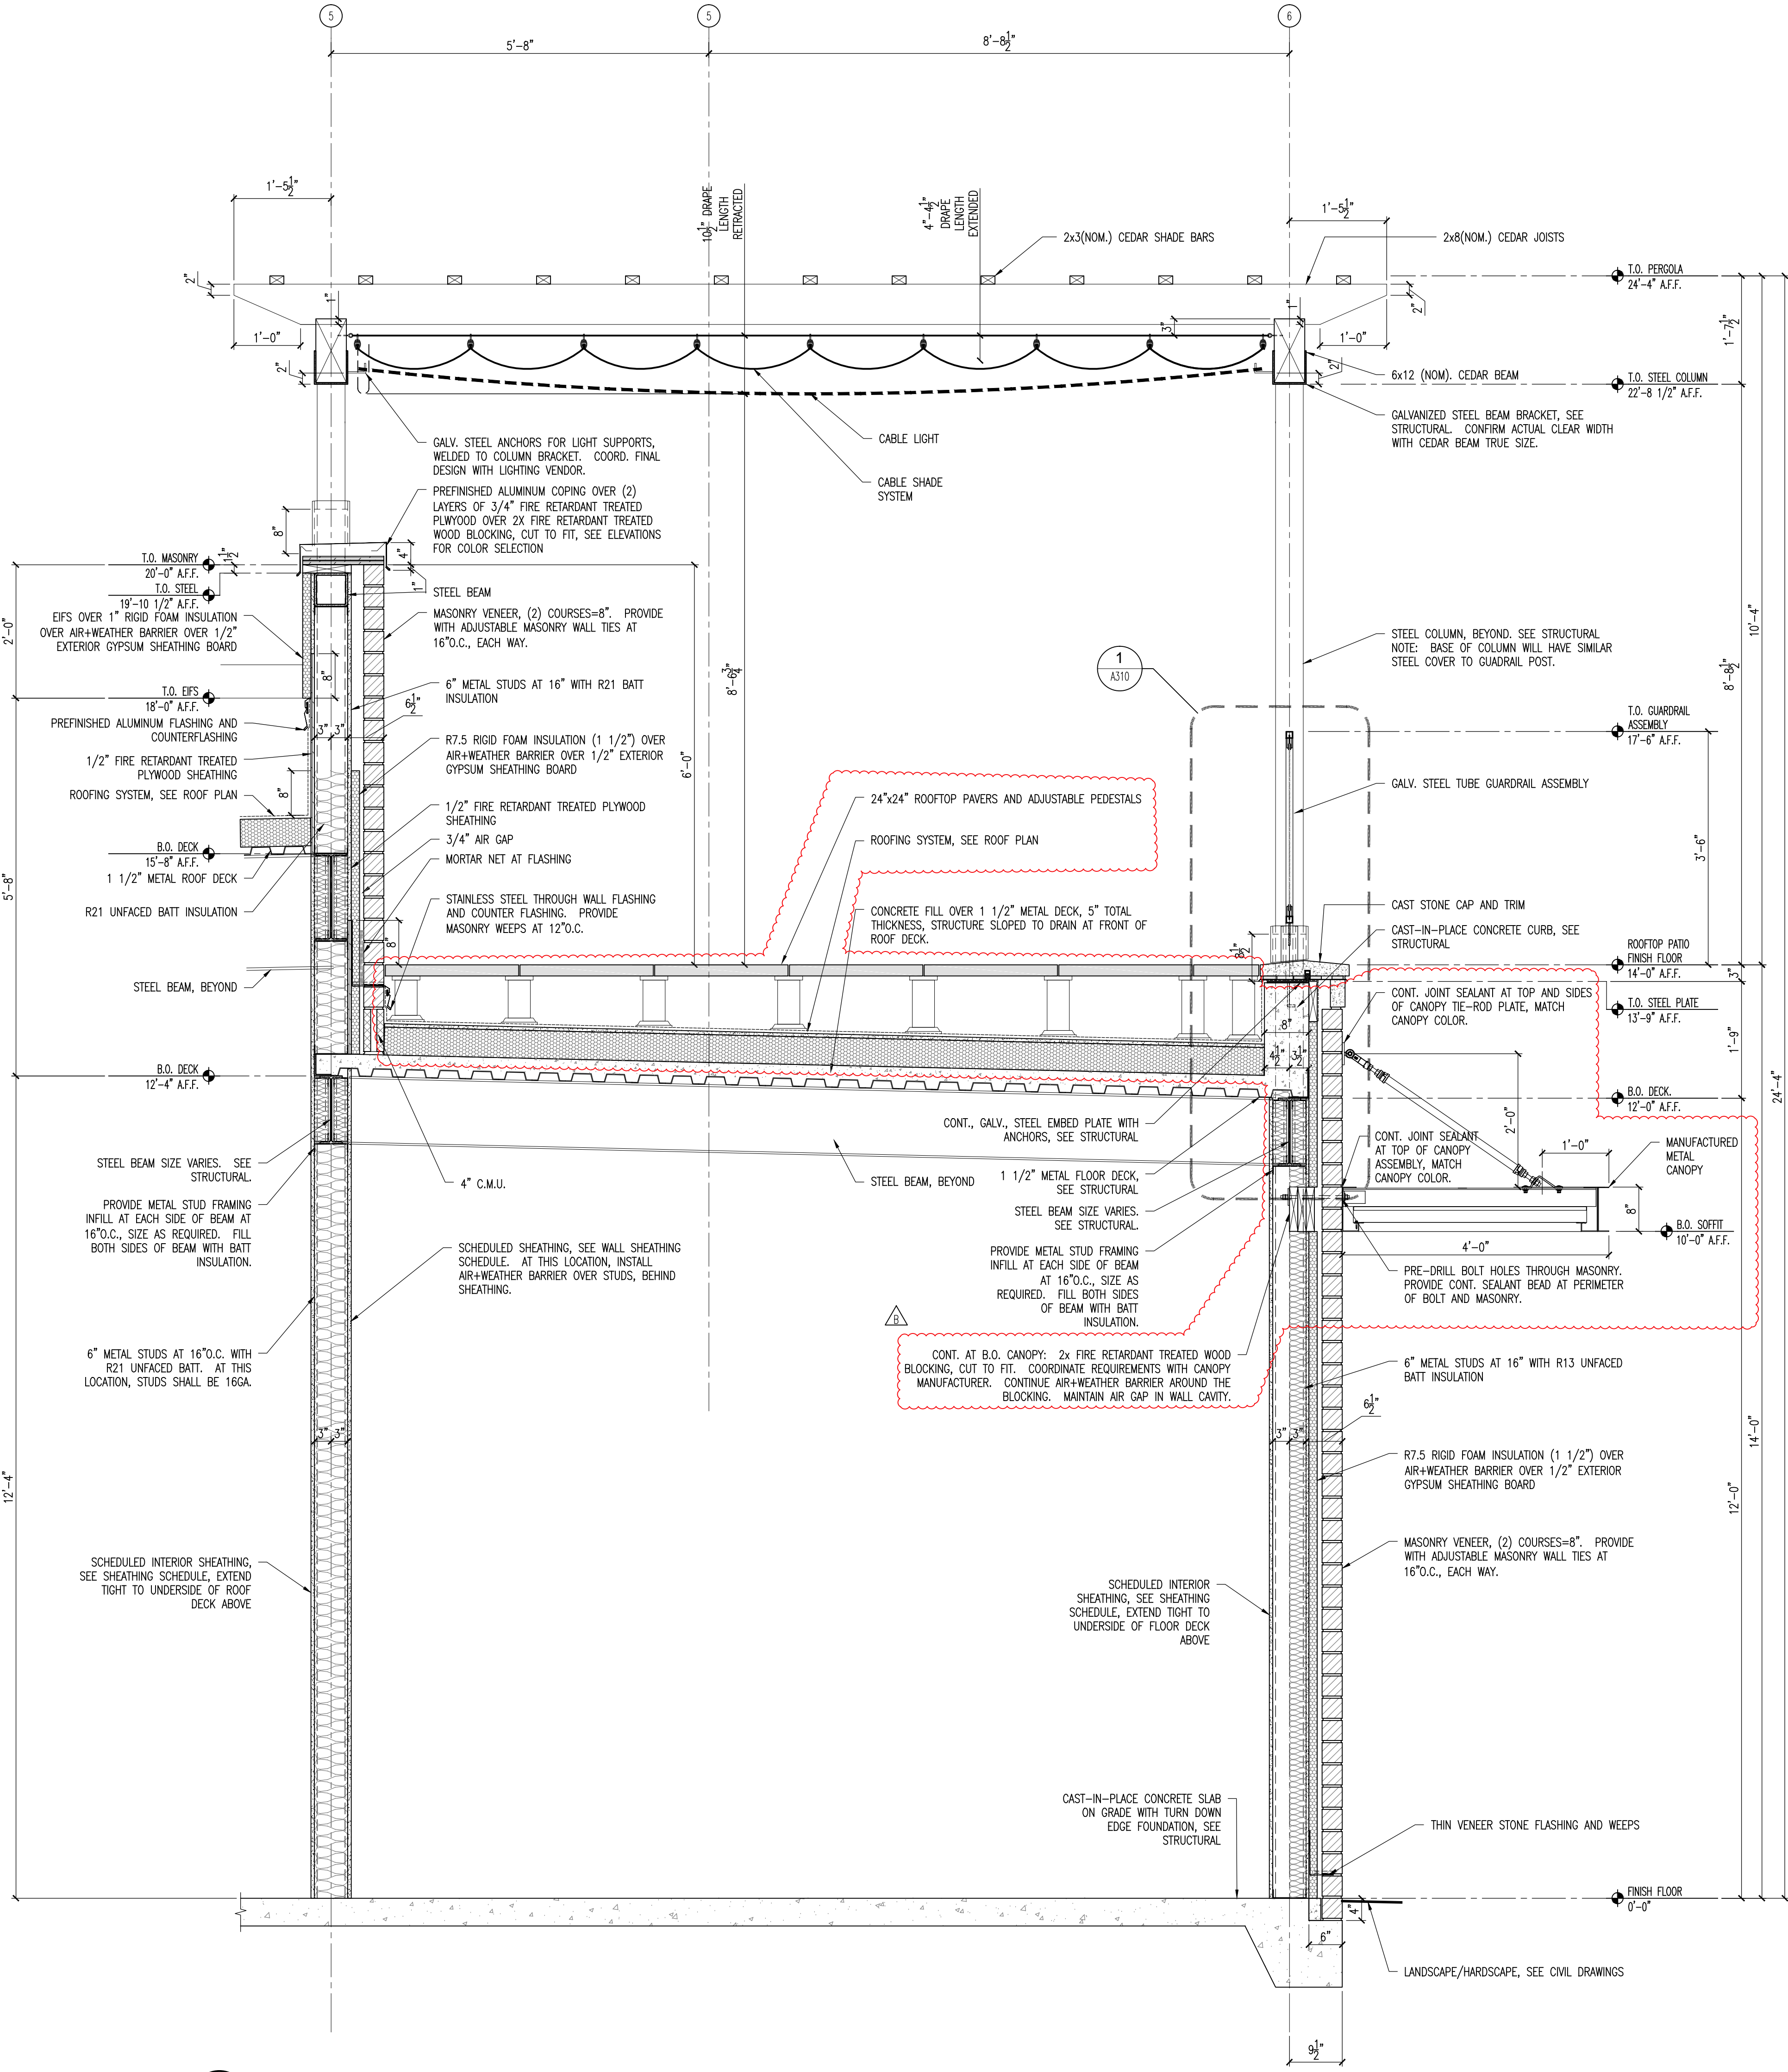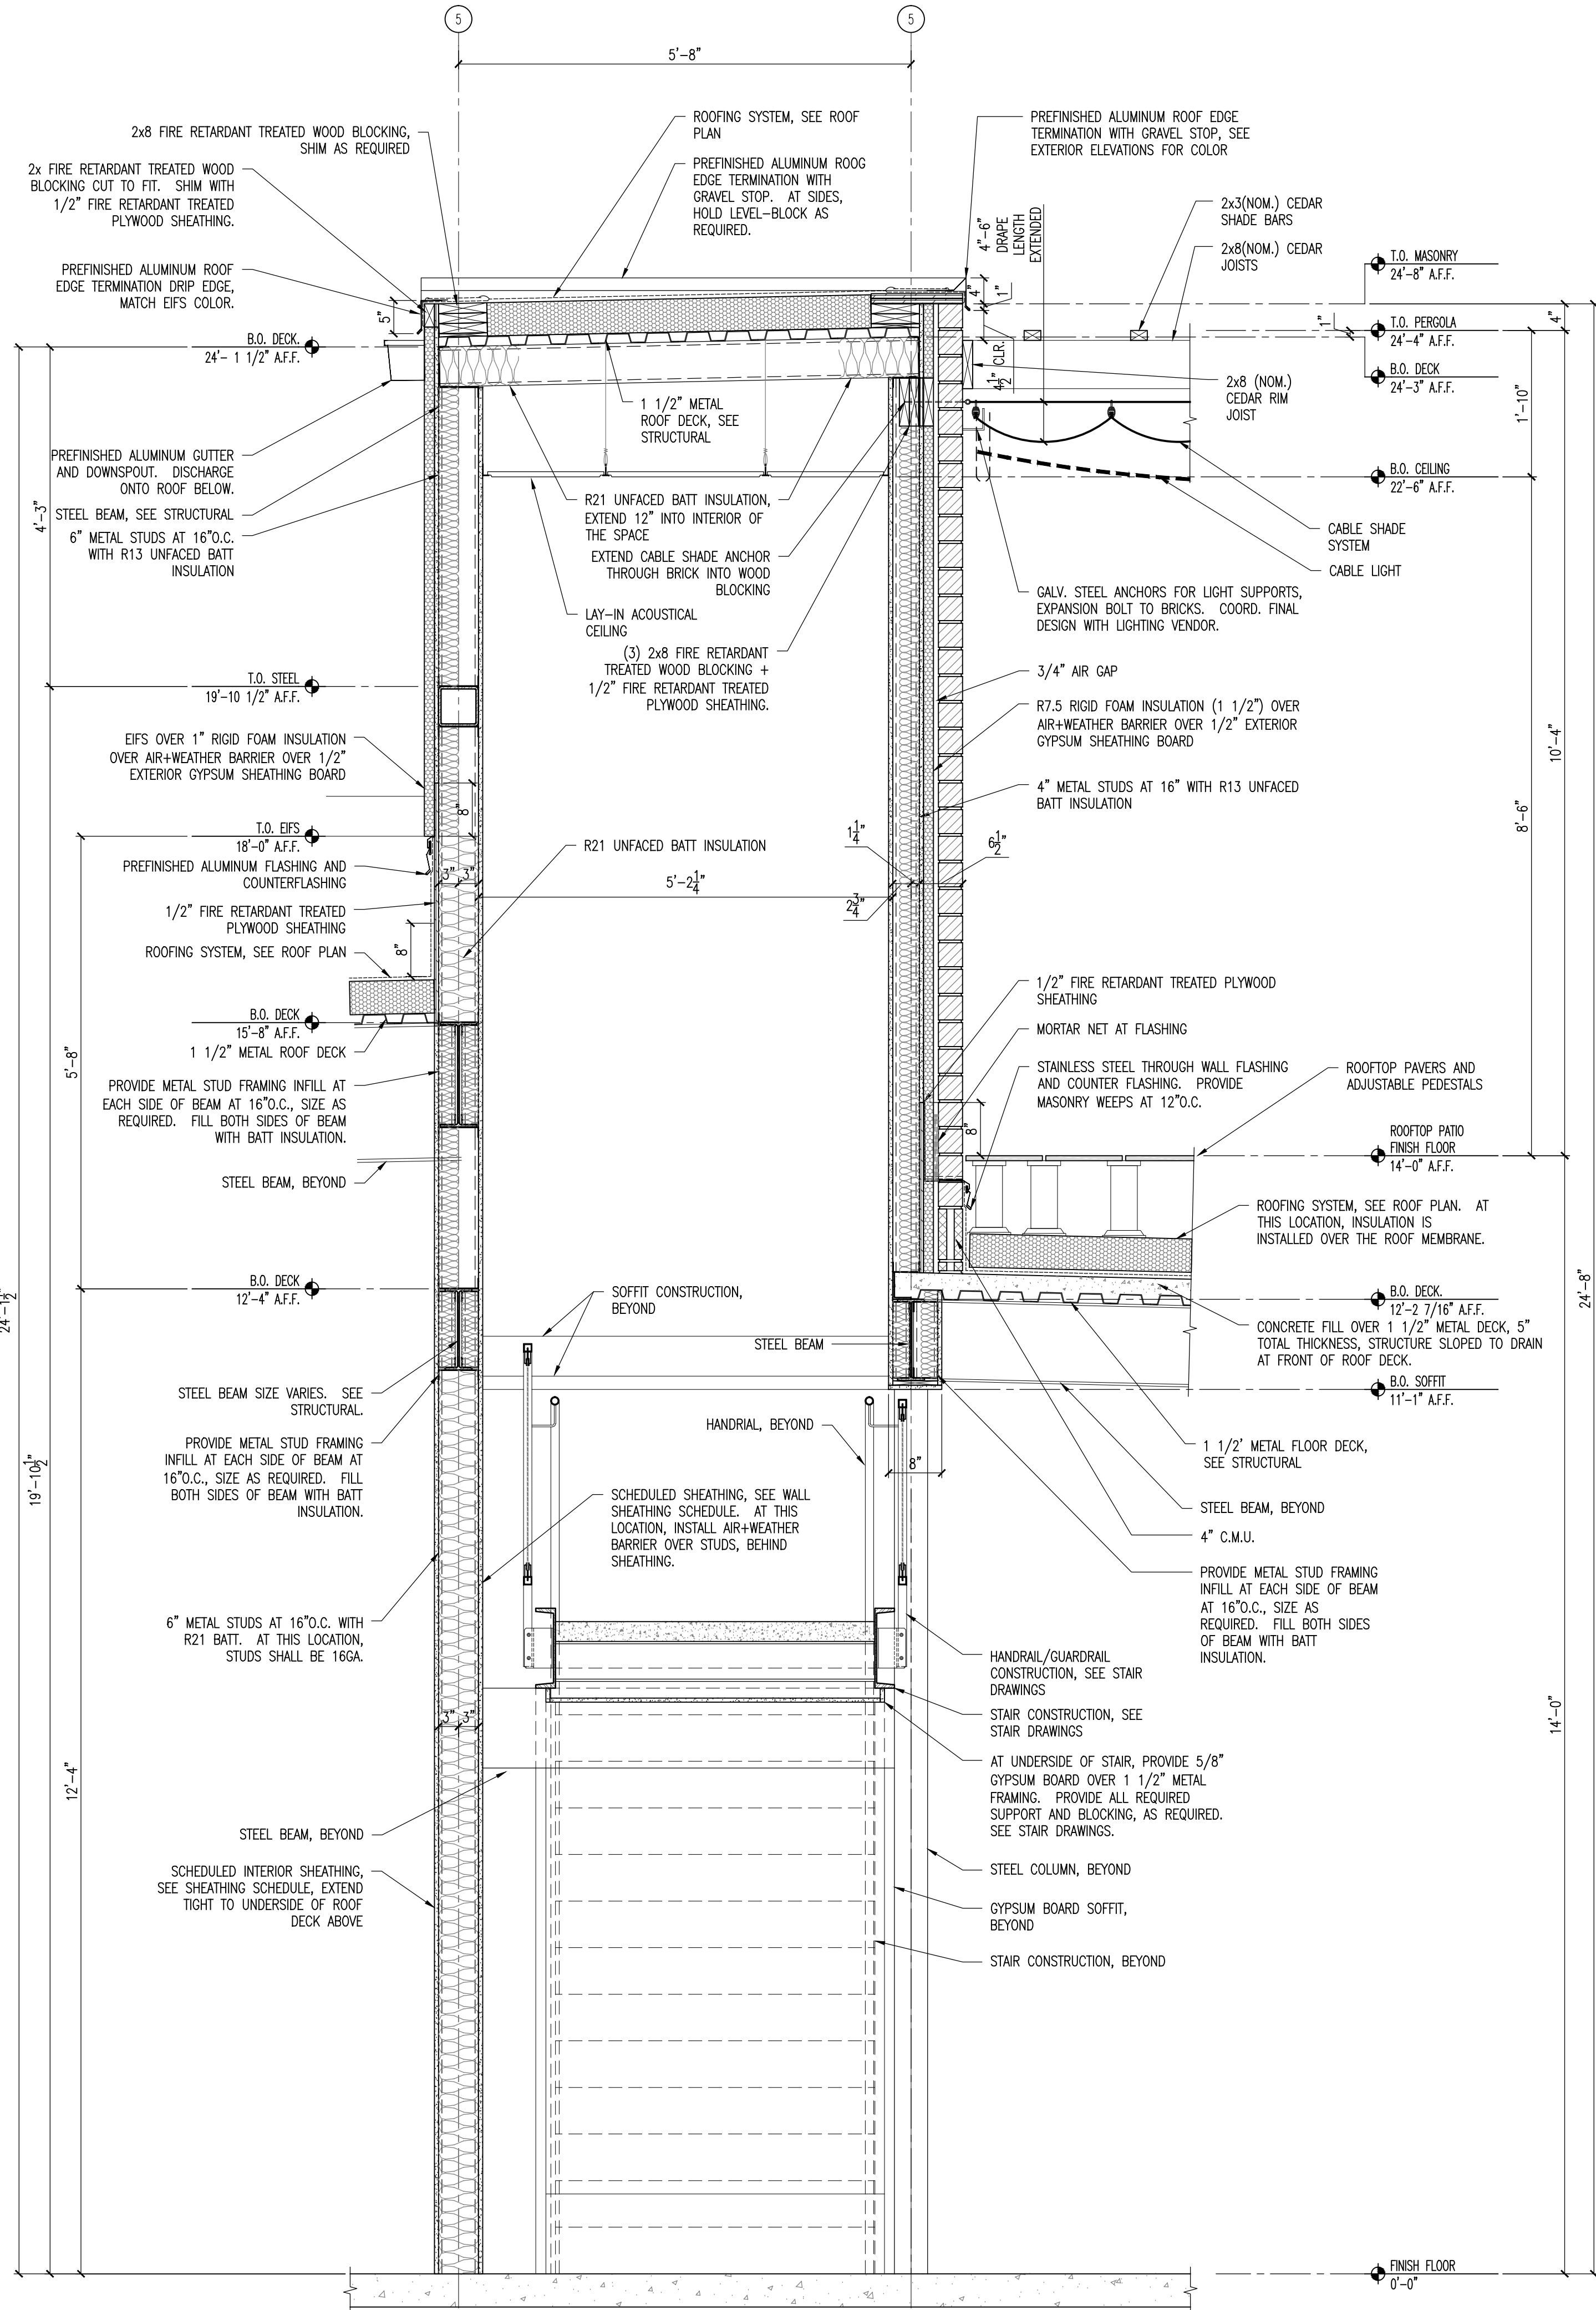


2 WALL SECTION AT ROOFTOP PATIO STAIR ENCLOSURE

1 WALL SECTION AT ROOFTOP PATIO


NO.	DESCRIPTION	DATE
1	ISSUED FOR PERMITS	03-14-2022
2	FOR CONSTRUCTION	03-14-2022

Sheet Name:	WALL SECTIONS
Proj #:	211201
Issue Date:	03-14-2022
Sheet No.:	A304
Drawn By:	KC
Checked By:	KC/SA

1. SEE SHEET A301 FOR GENERAL SHEET NOTES AND GENERAL MATERIAL NOTES.
2. NOTE: SIMPLIFIED GUARDRAIL PANELS THAT ELIMINATE THE FABRICATED OFFSET BRACKETS AND WELD THE INFILL PANEL DIRECTLY TO THE STEEL TUBE SHALL BE ACCEPTABLE. EXPAND INFILL PANEL SIZE, DO NOT CHANGE GUARDRAIL TUBE LOCATIONS.

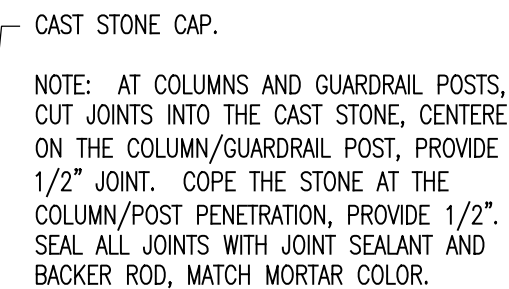


NOTE: CONDITION SHOWS GUARDRA
BASE. CONDITION AT PERGOLA
COLUMNS IS SIMILAR.

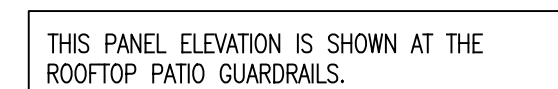


2 TYPE
A310 1 1/2"=1'-0"

NOTE: SEE 4/A301 FOR PARAPET CAP DETAIL
AT STAIR ACCESS GATE.

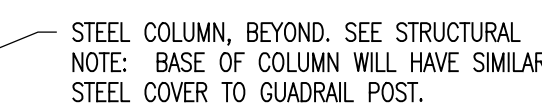

1 ROO
A310 1 1/2"=1"

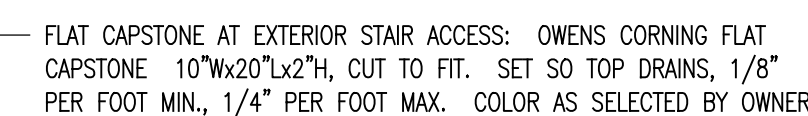

NOTE: AT COLUMNS AND GUARDRAIL POSTS, CUT JOINTS INTO THE CAST STONE, CENTERED ON THE COLUMN/GUARDRAIL POST, PROVIDE 1/2" JOINT. COPE THE STONE AT THE COLUMN/POST PENETRATION, PROVIDE 1/2". SEAL ALL JOINTS WITH JOINT SEALANT AND BACKER ROD, MATCH MORTAR COLOR.

ROOF FOR 1st FLOOR
FINISH FLOOR
14'-0" A.F.F.

T.O. STEEL PLATE
13'-9" A.F.F.

ON. AT UPPER LANDING, ALIGN TOP OF
RIGER AND LANDING CONCRETE INFILL WITH
PATIO

CORNING TUSCAN LINE 6" HY22" X2 5/8" D

ED WOOD BLOCKING, CHAMFER BOTTOM EDGE

RSSES=8". PROVIDE WITH ADJUSTABLE MASONRY
1 WAY.

N (1 1/2") OVER

CURB, SEE CURB

4 ROC
A310 3"=1'-0"

No.	Description	Date:
22	BID SET	03-14-2022
A	G.C. SHOP DWG. COORD. 1	02-04-2022
B	G.C. SHOP DWG. COORD. 2	03-14-2022

Proj #:	Issue Date:
041004	02.11.2003

Proj #:	Issue Date:
041004	02.11.2003

211201	03-14-2022
Sheet No.:	

A310

A510

Drawn By: KC	Checked By: KC/SA
-----------------	----------------------


NO.	DESCRIPTION	DATE
1	ISSUED FOR PERMIT	03-14-2022
2	ISSUED FOR CONSTRUCTION	04-12-2022
3	ISSUED FOR CONSTRUCTION	04-12-2022
4	ISSUED FOR CONSTRUCTION	04-12-2022
5	ISSUED FOR CONSTRUCTION	04-12-2022
6	ISSUED FOR CONSTRUCTION	04-12-2022
7	ISSUED FOR CONSTRUCTION	04-12-2022
8	ISSUED FOR CONSTRUCTION	04-12-2022
9	ISSUED FOR CONSTRUCTION	04-12-2022
10	ISSUED FOR CONSTRUCTION	04-12-2022

ENLARGED PLANS AND DETAILS	Sheet Name:
Proj #: 211201	Issue Date: 03-14-2022
Sheet No.: A401	
Drawn By: KC	Checked By: KC/SA


GENERAL SHEET NOTES

- NOT ALL ITEMS MAY BE USED.
- DIMENSIONS ARE TAKEN TO FACE OF STUD, FACE OF MASONRY OR CONCRETE, OR COLUMN CENTERLINE, UNLESS INDICATED OTHERWISE.
- PRIOR TO ROUGH-IN AND WALL ENCLOSURE, COORDINATE ALL WORK WITH TENANT/OWNER VENDOR REQUIREMENTS.
- PRIOR TO ROUGH-IN AND WALL ENCLOSURE, COORDINATE LOCATION OF ALL WALL MOUNTED FIXTURES AND DEVICES WITH FINISH WORK SHOWN IN THE ARCHITECTURAL AND/OR ID DRAWINGS - ALIGN AS INDICATED. THIS SHALL INCLUDE, BUT NOT BE LIMITED TO: ALL CONTRACTOR, TENANT/OWNER, AND TENANT/OWNER VENDOR SUPPLIED ITEMS.
- IF THERE IS A DISCREPANCY BETWEEN THE ARCHITECTURAL AND ID DRAWINGS, NOTIFY THE ARCHITECT FOR RESOLUTION PRIOR TO PROCEEDING WITH THE WORK.
- IF THERE IS A DISCREPANCY WITH THE ACCESSIBILITY STANDARDS, REPORT THE DISCREPANCY TO THE ARCHITECT FOR RESOLUTION PRIOR TO PROCEEDING WITH THE WORK.
- PRIOR TO WALL ENCLOSURE, CONTRACTOR SHALL PROVIDE ALL BLOCKING AS REQUIRED FOR WALL MOUNTED ITEMS. THIS SHALL INCLUDE, BUT NOT BE LIMITED TO: ALL CONTRACTOR, TENANT/OWNER, AND TENANT/OWNER VENDOR SUPPLIED ITEMS.
- COORDINATE FINAL LOCATIONS OF OWNER AND THIRD PARTY VENDOR FURNISHED ITEMS IN THE FIELD WITH TENANT/OWNER REP AND THE VENDOR.
- UNLESS INDICATED OTHERWISE, ALL BLOCKING SHALL BE ENCLOSED INSIDE FINISH CONSTRUCTION.
- BLOCKING AT DRY LOCATIONS: FIRE RETARDANT TREATED WOOD BLOCKING.
- BLOCKING AT WET LOCATIONS: GALVANIZED METAL STRAP BLOCKING, AS PROVIDED BY METAL STUD SUPPLIER/FABRICATOR.
- CONTRACTOR SHALL PROVIDE ALL NECESSARY FRAMING TO ACCOMMODATE THE FINAL LAYOUTS SHOWN FOR ALL FINISHES SHOWN IN THE ARCHITECTURAL AND ID DRAWINGS.
- ALL FIRE RATED PARTITIONS SHALL BE EFFECTIVELY AND PERMANENTLY IDENTIFIED WITH SIGNS OR STENCILING. SUCH IDENTIFICATION SHALL BE ABOVE ANY DECORATIVE CEILING AND IN CONCEALED SPACES. IDENTIFY WITH THE FOLLOWING TEXT: "XX" HOUR RATED FIRE/SMOKE BARRIER. PROTECT ALL OPENINGS AND PENETRATIONS. CONFIRM HOURLY RATING WITH FIRE RESISTANCE RATING OF WALL. AT LOCATIONS WHERE THERE ARE NO CEILINGS OR CONCEALED SPACES, COORDINATE SIGNAGE REQUIREMENT WITH THE AUTHORITY HAVING JURISDICTION (AHJ). AT THESE LOCATIONS, IF SIGNAGE IS REQUIRED BY THE AHJ, CONFIRM WITH TENANT/OWNER IF THEY PREFER SIGNS OR STENCILING.
- SEE ACCESSIBILITY STANDARDS FOR MOUNTING HEIGHT REQUIREMENTS FOR ALL TOILET AND BATHROOM ACCESSORIES.


- STEEL TUBE CORNER FABRICATION NOTES:**
- MITER ALL OUTSIDE COLUMN AND BEAM CORNERS.
 - AT INTERMEDIATE COLUMNS, SECTION COLUMN INTO BEAM FULL DEPTH OF TUBE STEEL RADIUS + 1/2".
 - PROVIDE CONT. WELD, ALL SIDES.
 - AT WELDS EXPOSED TO VIEW, GRIND SMOOTH AND FLUSH.

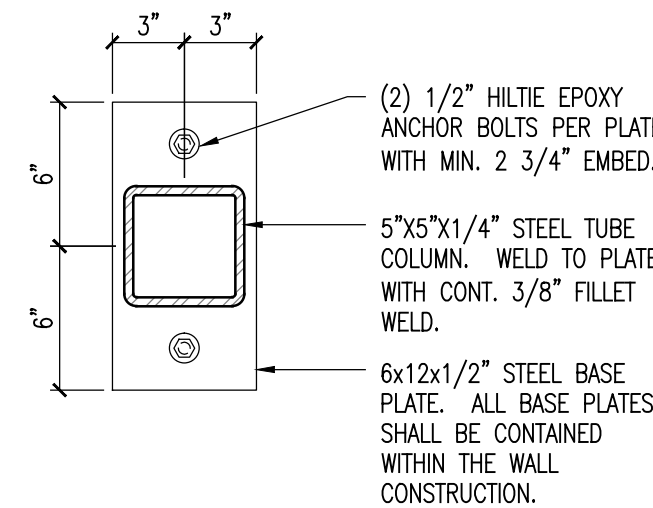


BASE PLATE PLAN

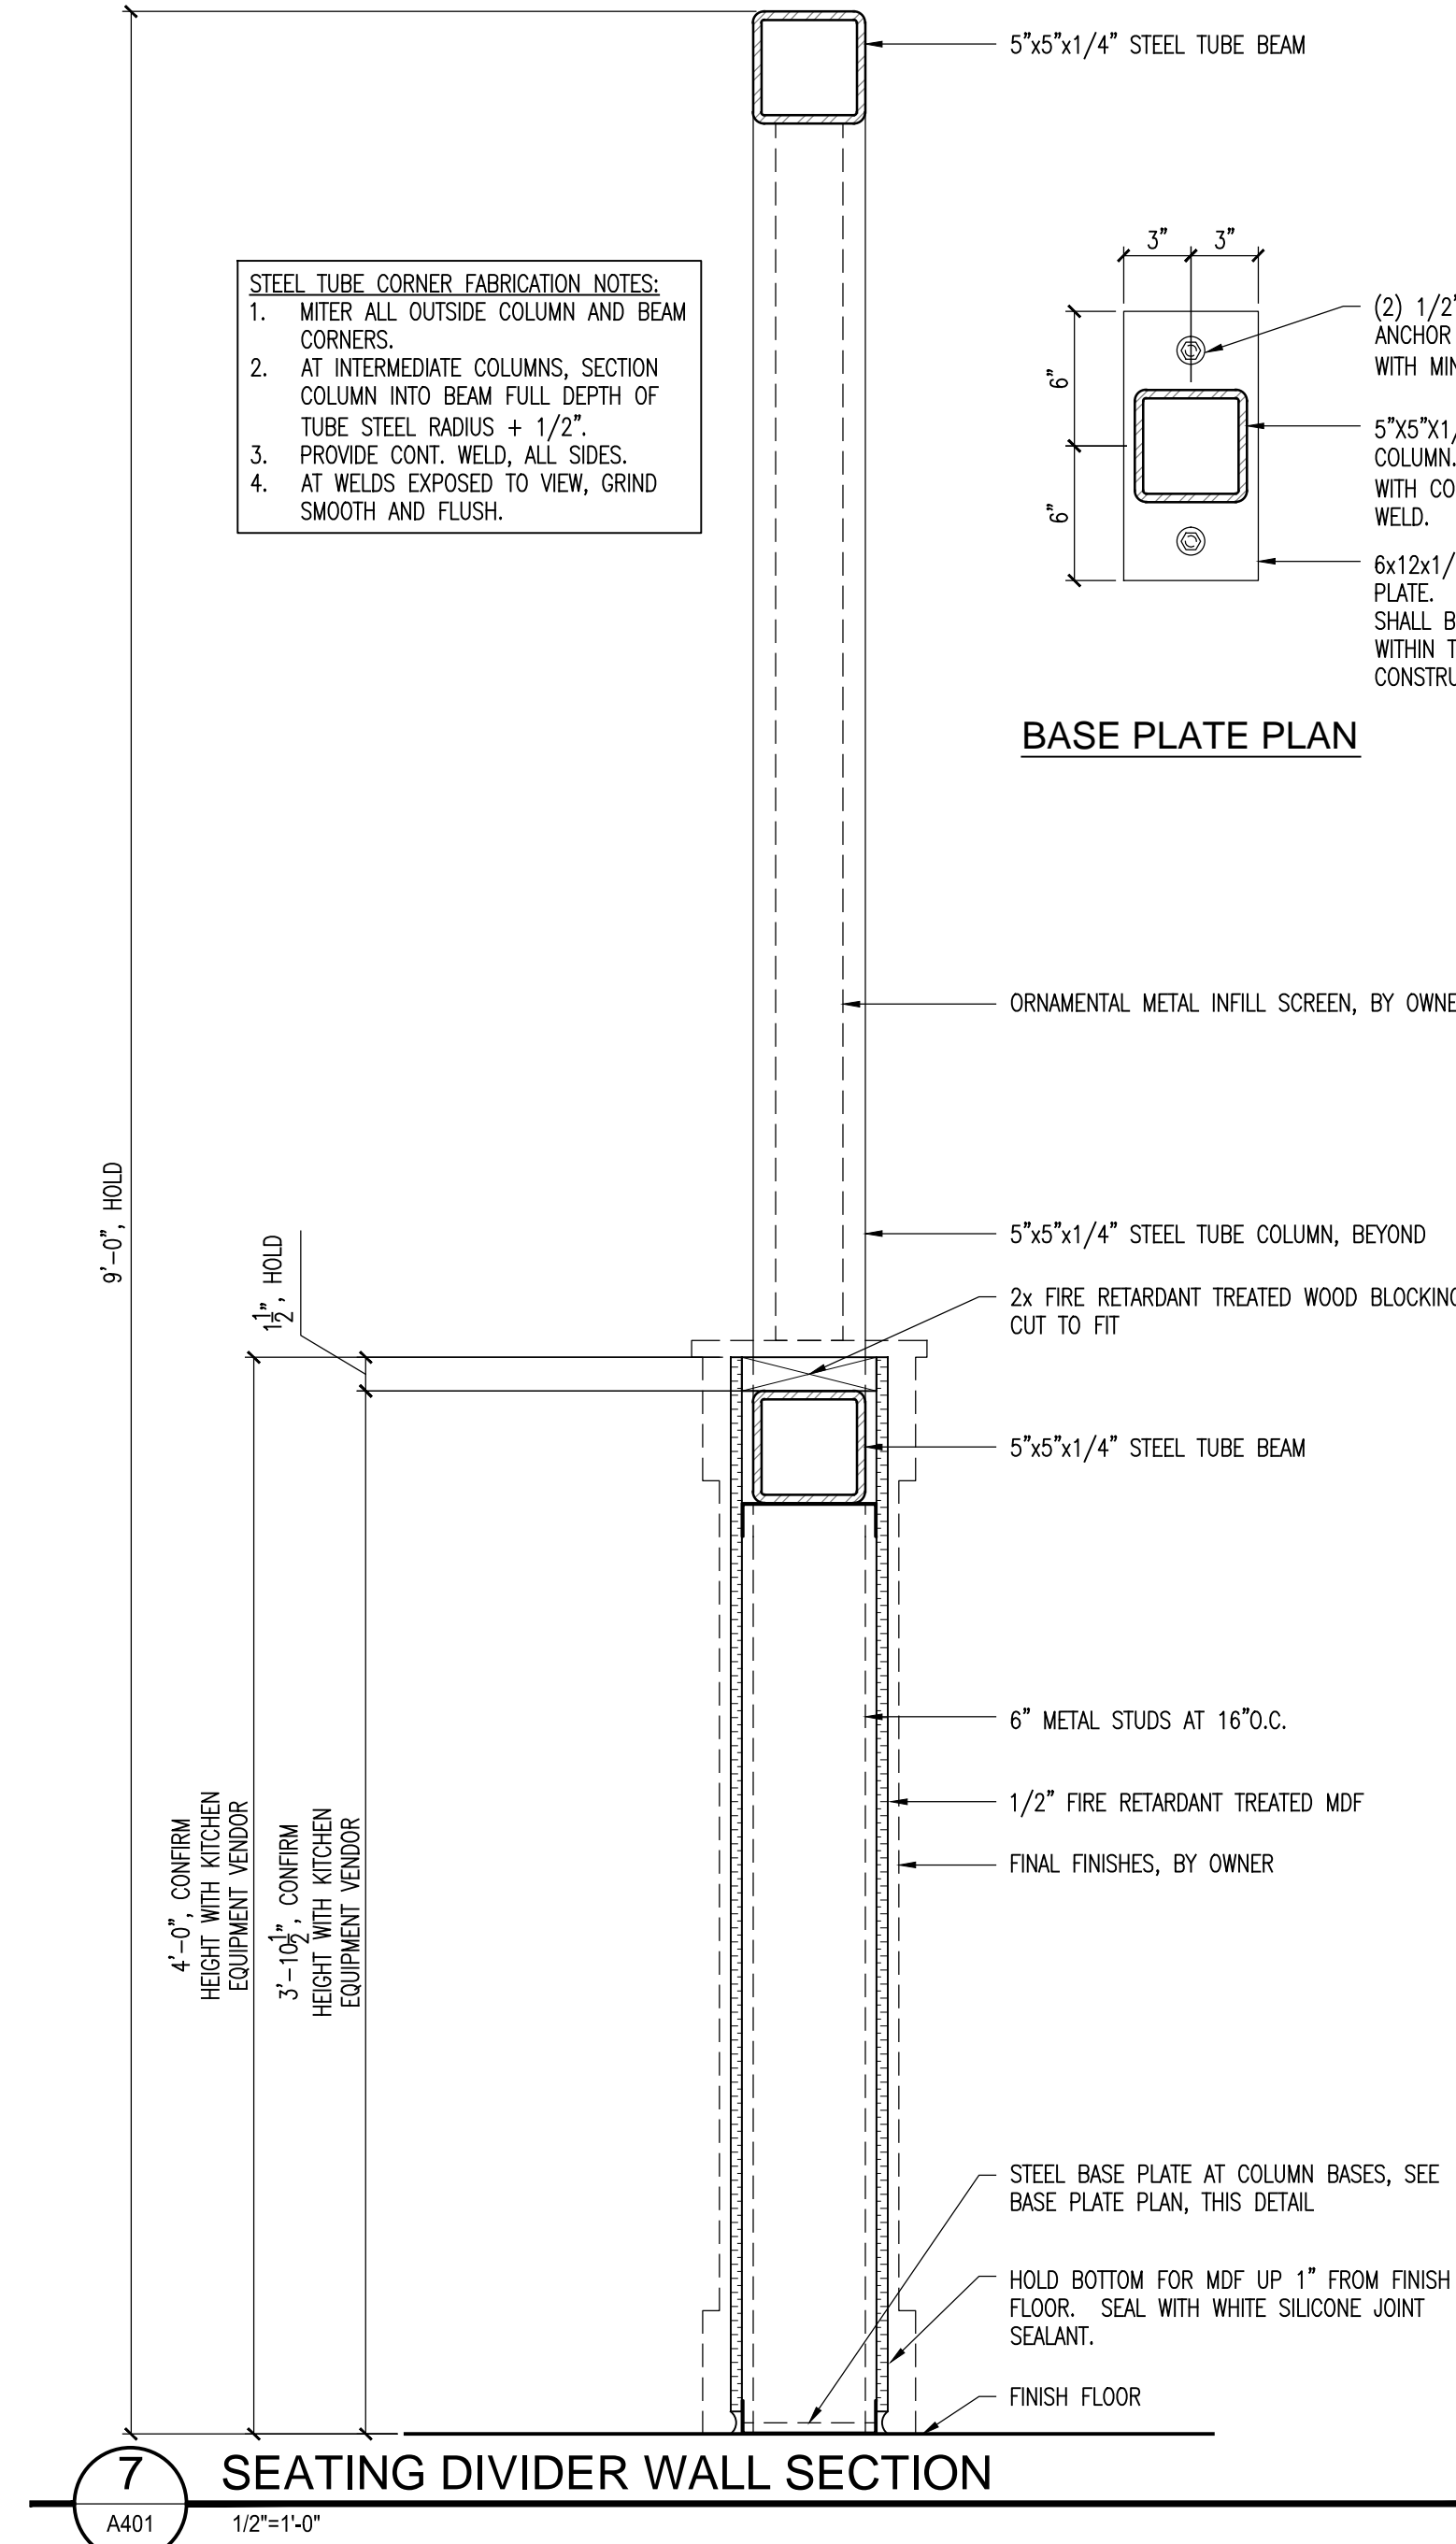


7 SEATING DIVIDER WALL SECTION
A401 1/2"=1'-0"

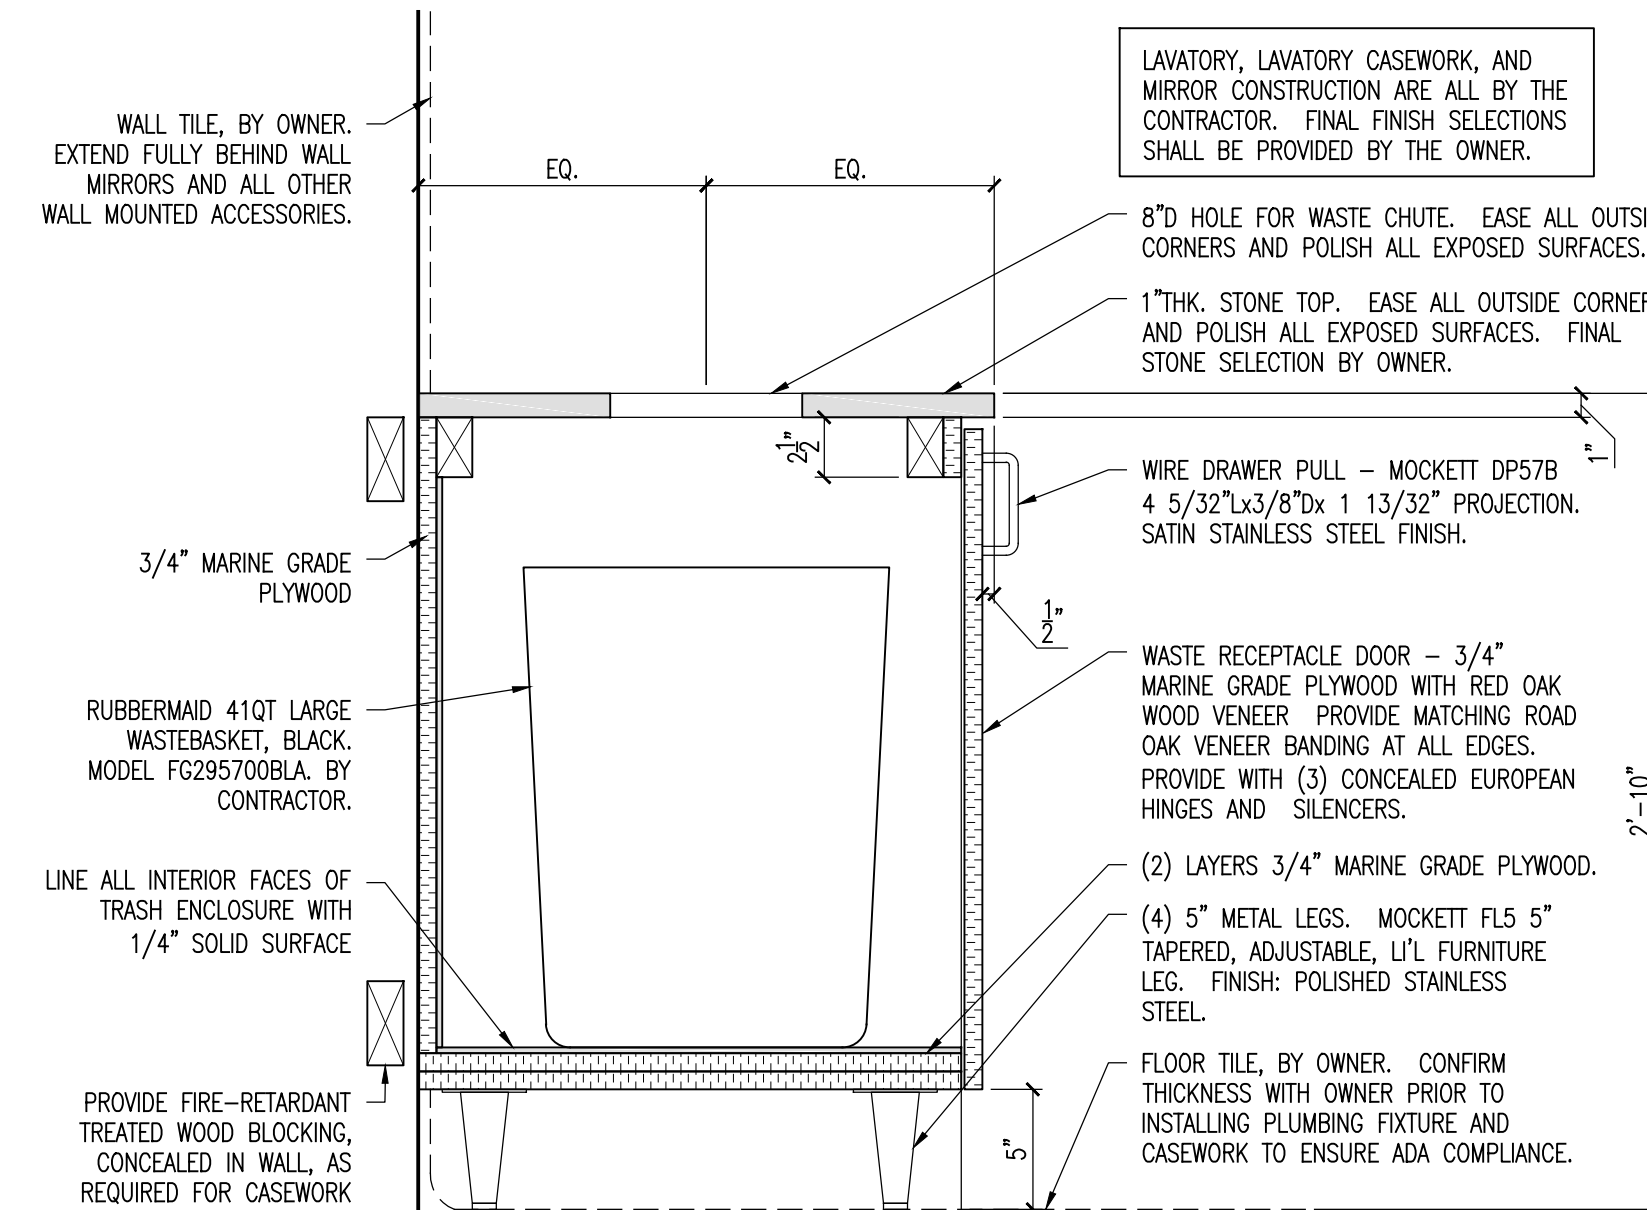


4 RESTROOM COUNTER SECTION AT TRASH RECEPTACLE
A401 1 1/2"=1'-0"

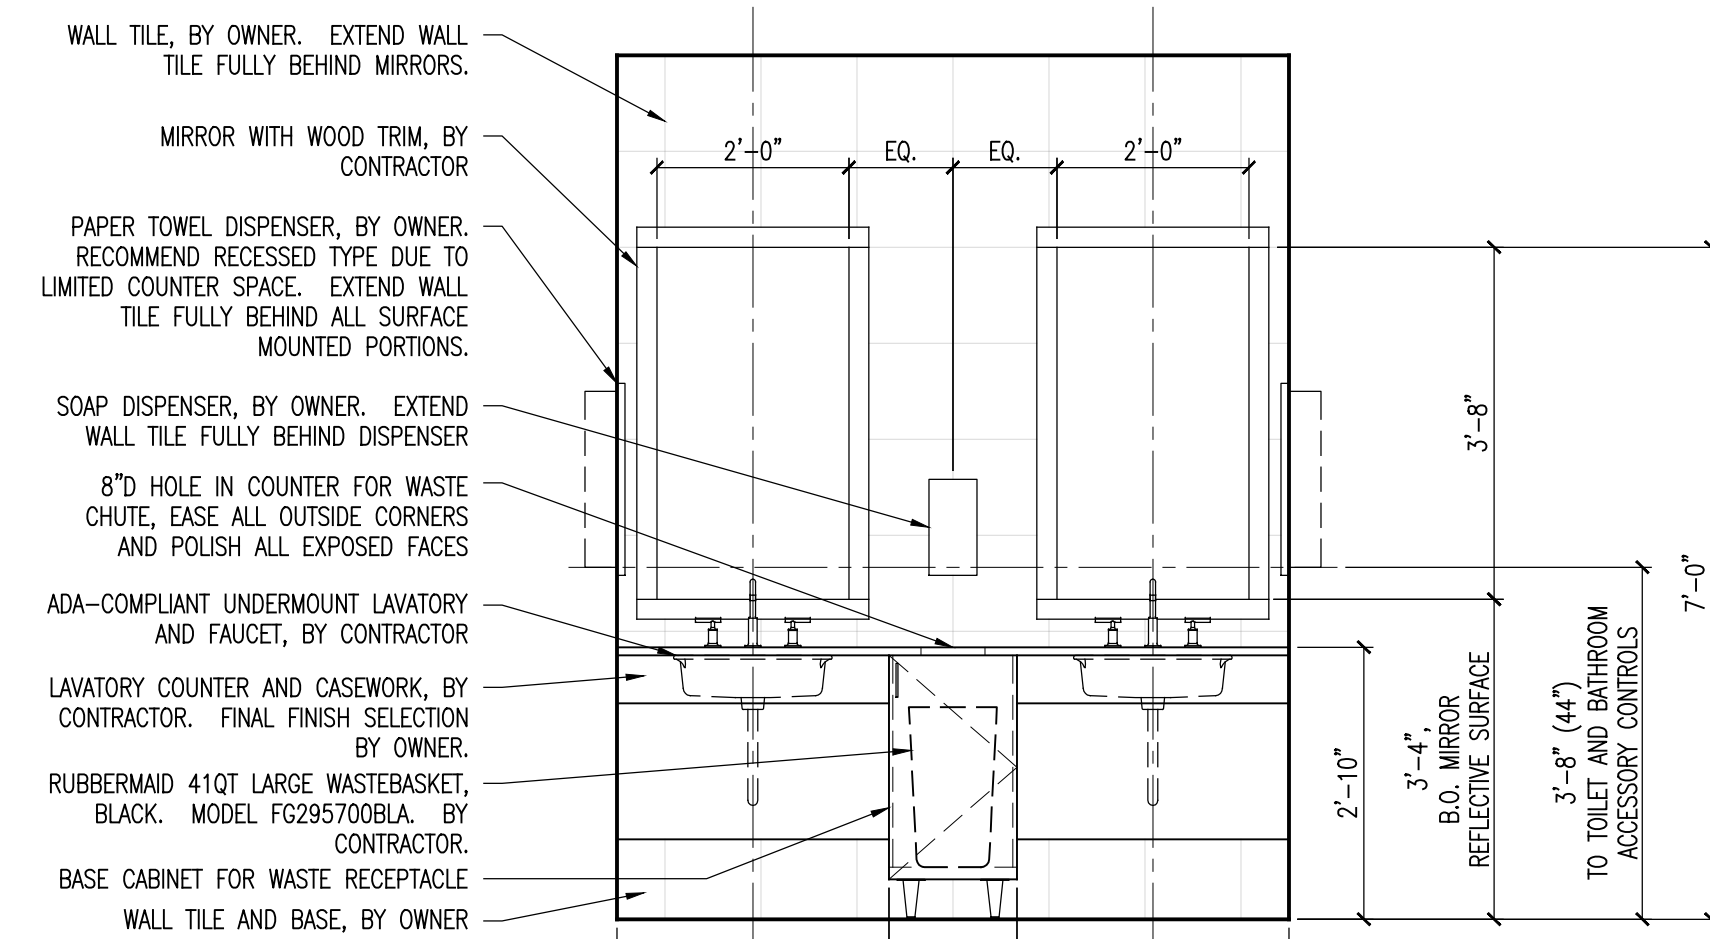


2 ENLARGED RESTROOM COUNTER ELEVATION
A401 1/2"=1'-0"

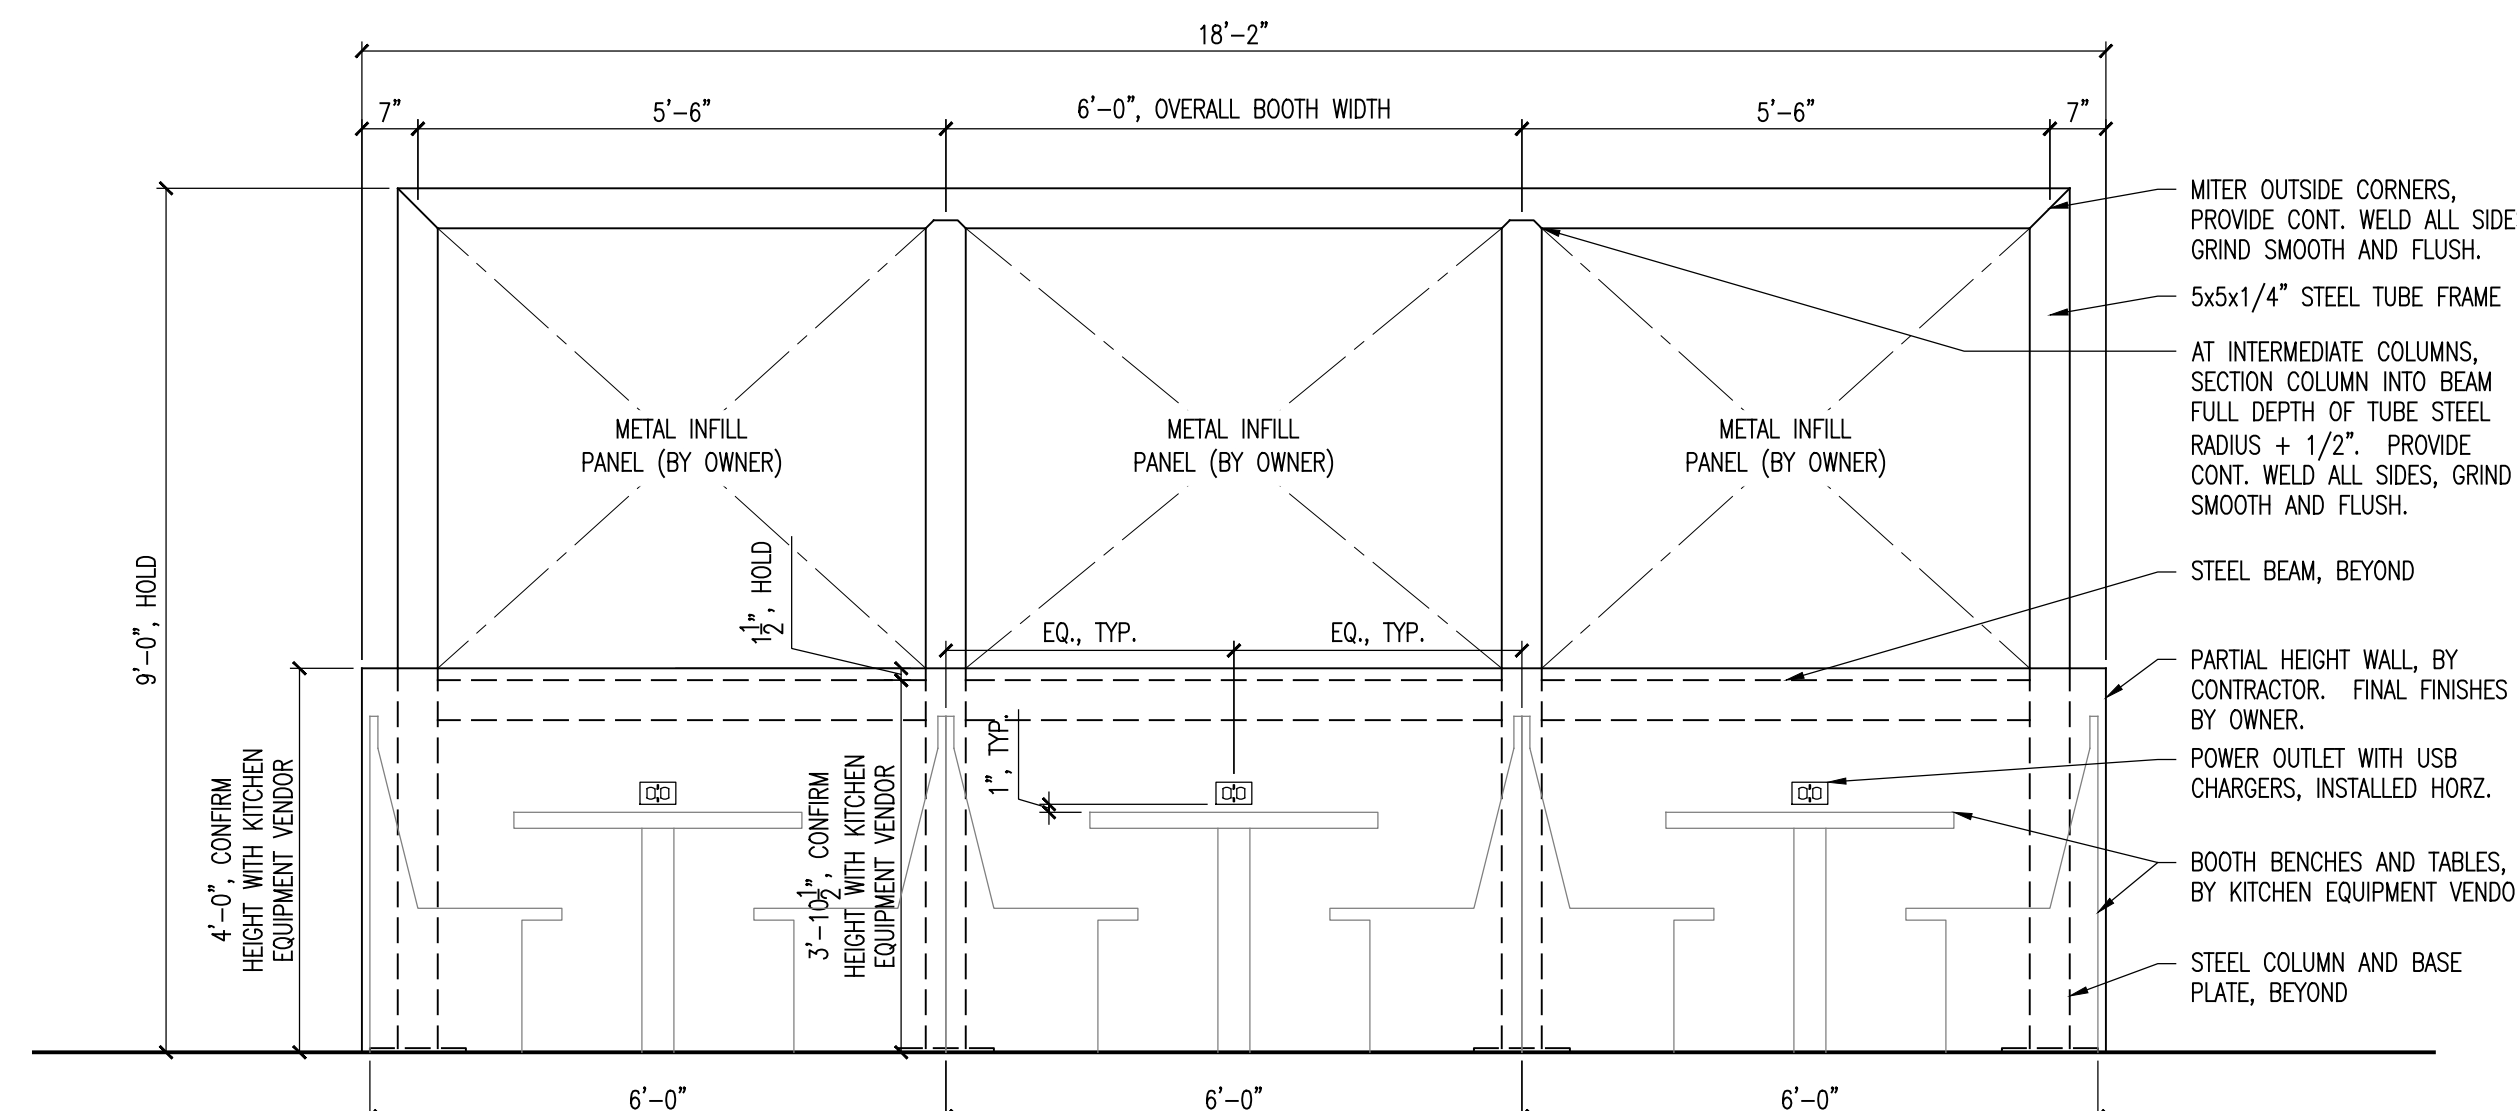


6 SEATING DIVIDER WALL ELEVATION
A401 1/2"=1'-0"

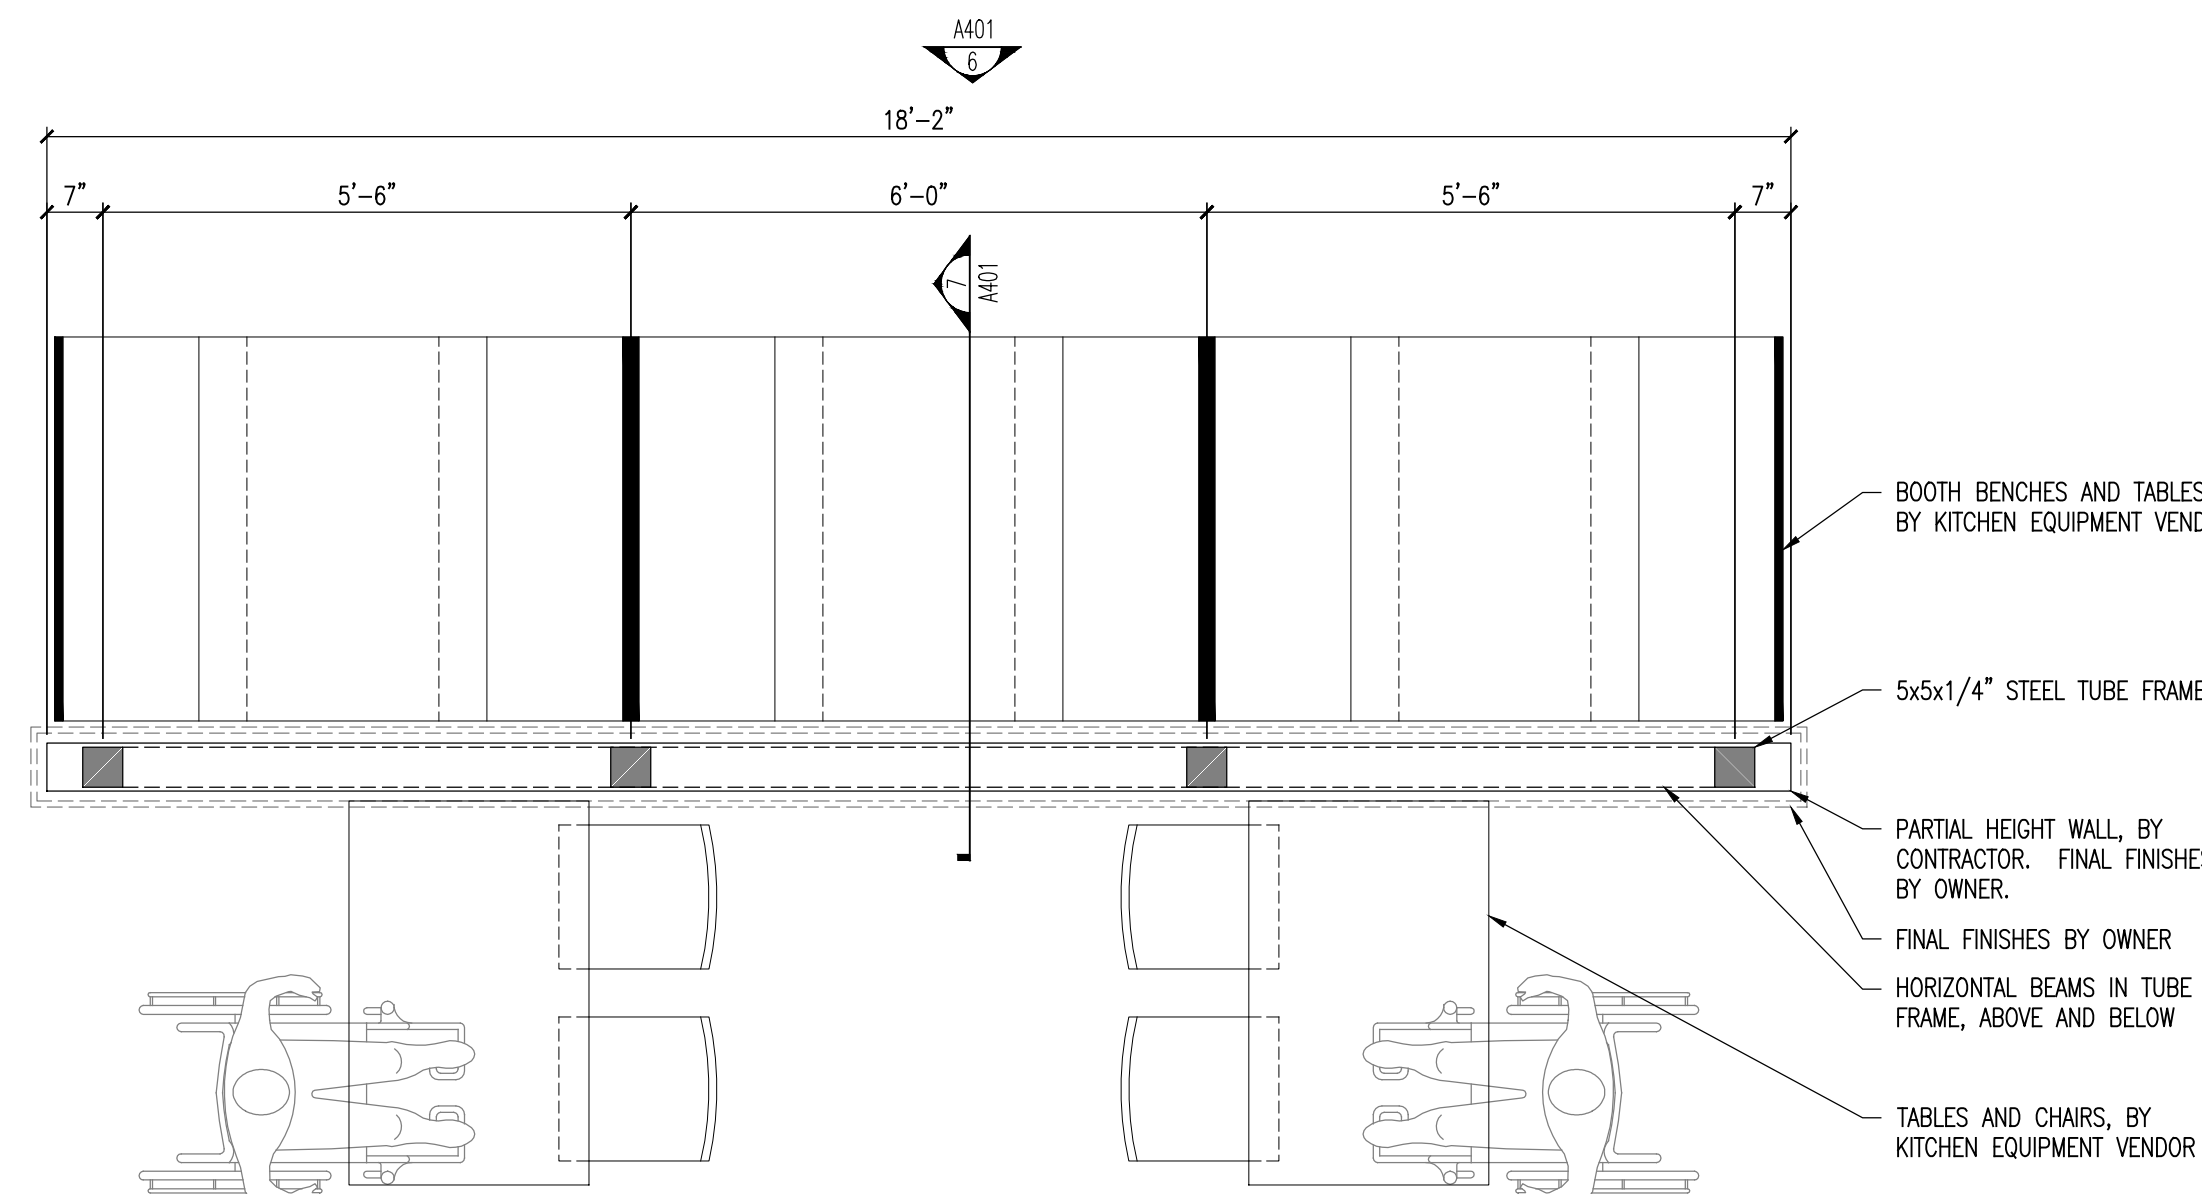

5 SEATING DIVIDER WALL PLAN
A401 1/2"=1'-0"

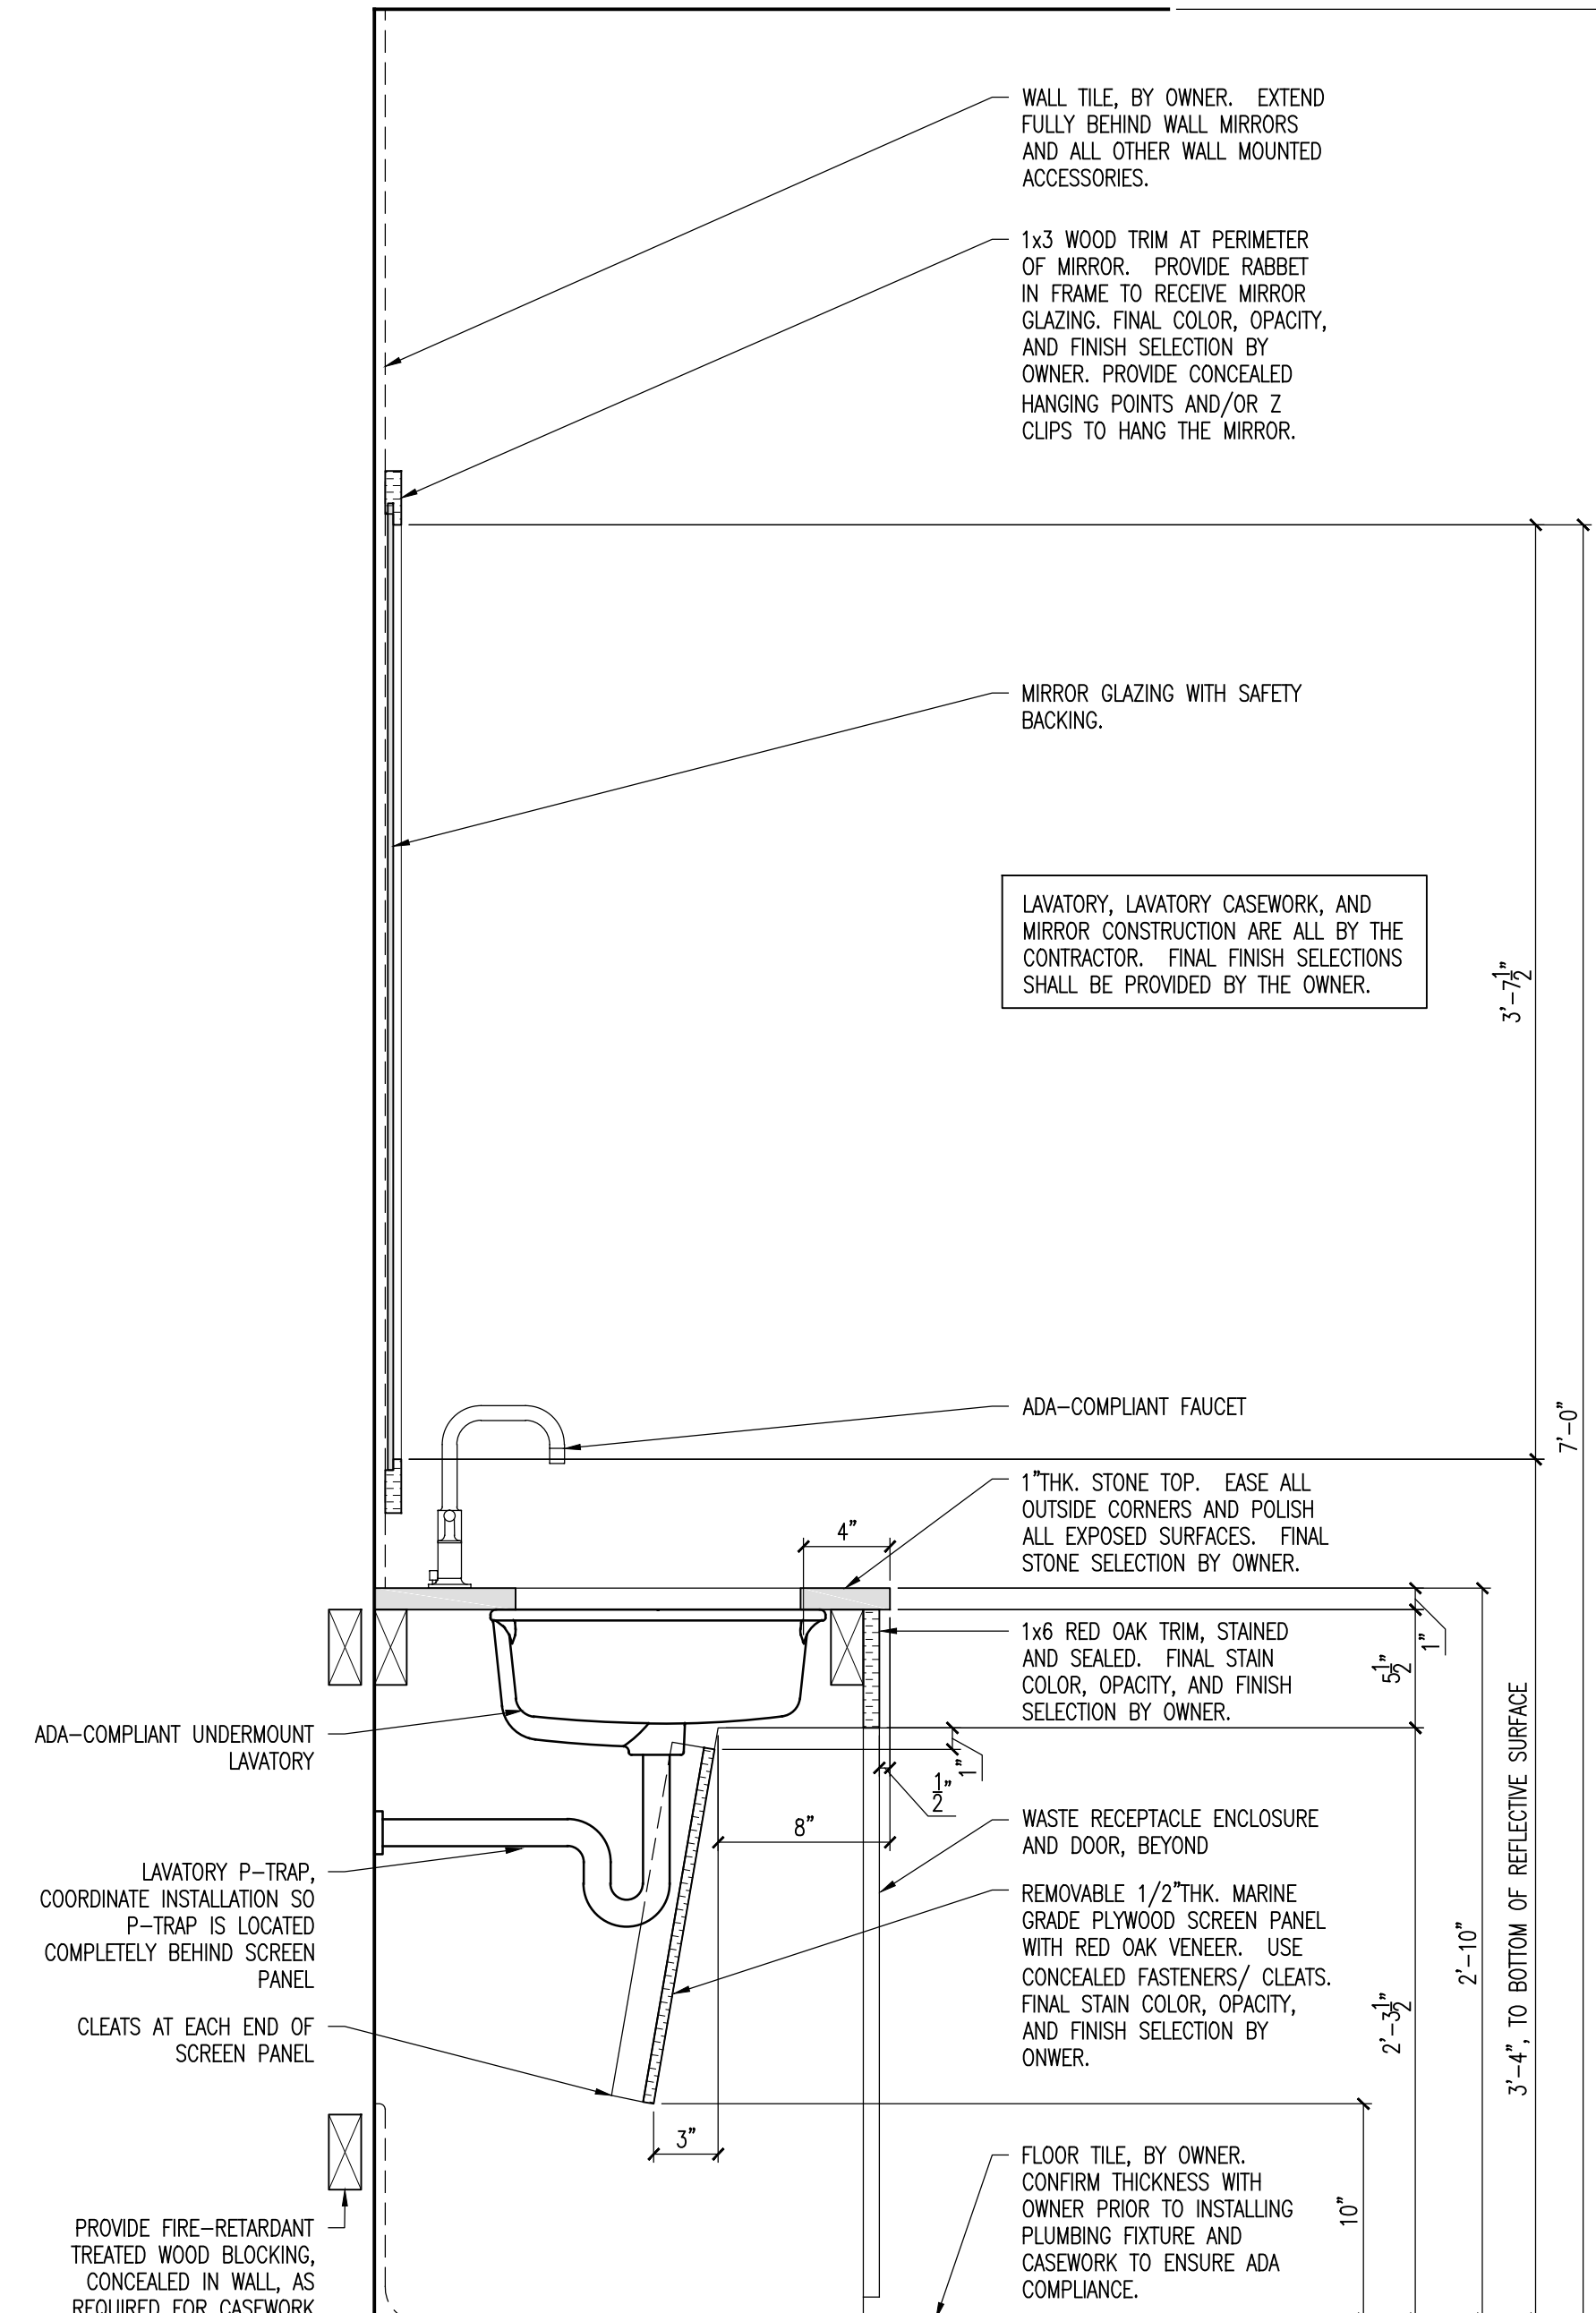


3 RESTROOM COUNTER SECTION AT LAVATORY
A401 1 1/2"=1'-0"

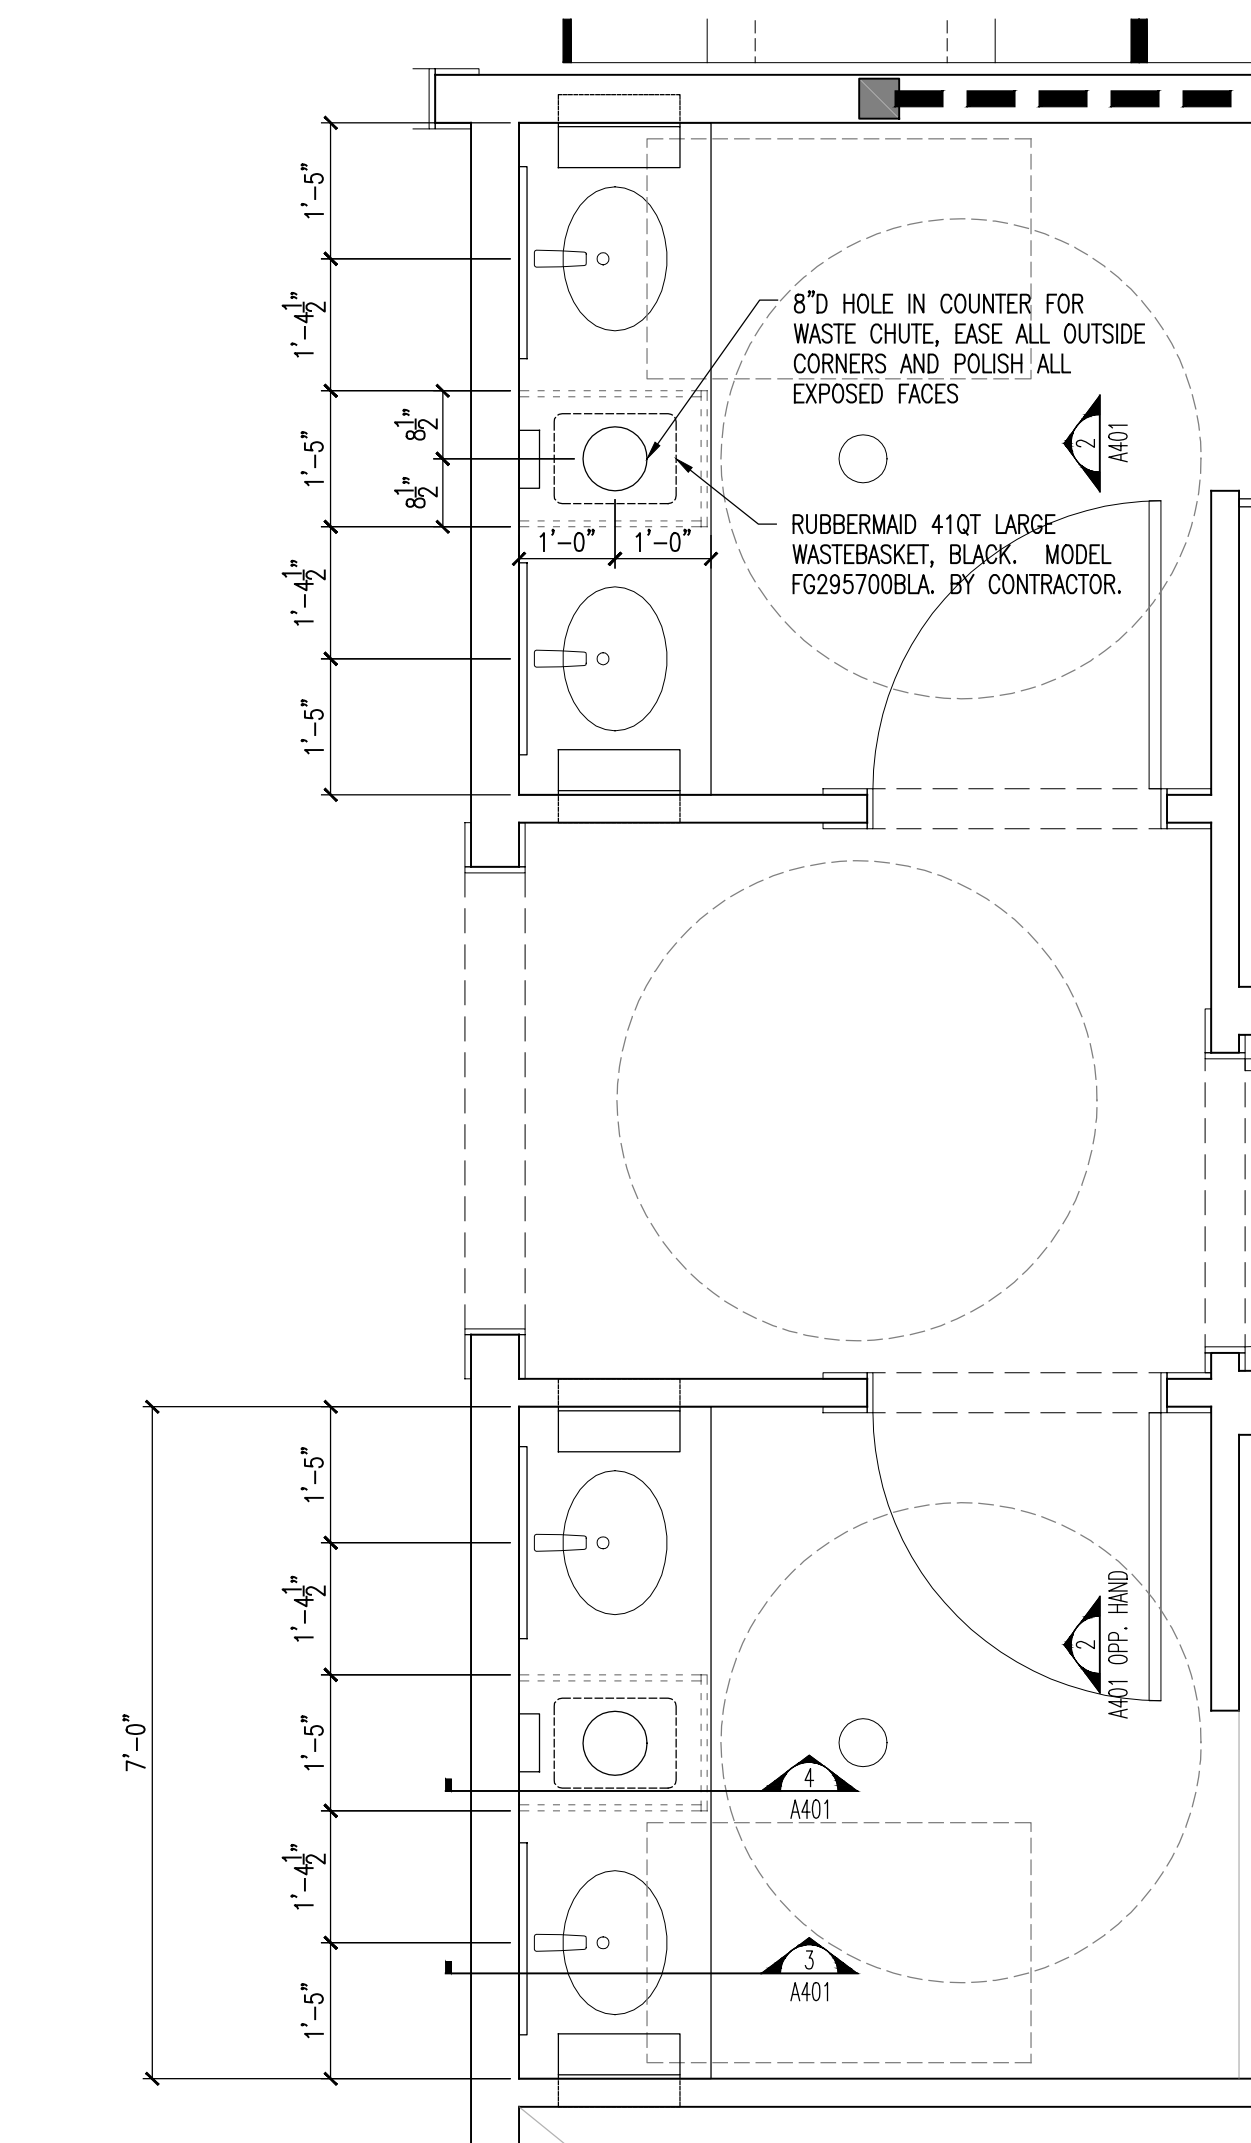


1 ENLARGED RESTROOM COUNTER PLAN
A401 1/2"=1'-0"

1. NOT ALL ITEMS MAY BE USED.
2. DIMENSIONS ARE TAKEN TO FACE OF STUD, FACE OF MASONRY OR CONCRETE , OR COLUMN CENTERLINE, UNLESS INDICATED OTHERWISE.
3. PRIOR TO ROUGH-IN AND WALL ENCLOSURE, COORDINATE ALL WORK WITH TENANT/OWNER FURNITURE AND DEVICES WITH FINISH WORK SHOWN IN THE ARCHITECTURAL AND/OR ID DRAWINGS – ALIGN AS INDICATED. THIS SHALL INCLUDE, BUT NOT BE LIMITED TO: ALL CONTRACTOR, TENANT, OWNER, AND TENANT/OWNER SUPPLIED ITEMS.
- 4.1. IF THERE IS A DISCREPANCY BETWEEN THE ARCHITECTURAL AND ID DRAWINGS, NOTIFY THE ARCHITECT FOR RESOLUTION PRIOR TO PROCEEDING WITH THE WORK.
- 4.2. IF THERE IS A DISCREPANCY WITH THE ACCESSIBILITY STANDARDS, REPORT THE DISCREPANCY TO THE ARCHITECT FOR RESOLUTION PRIOR TO PROCEEDING WITH THE WORK.

5. PRIOR TO WALL ENCLOSURE, CONTRACTOR SHALL PROVIDE ALL BLOCKING AS REQUIRED FOR WALL MOUNTED ITEMS. THIS SHALL INCLUDE, BUT NOT BE LIMITED TO: ALL CONTRACTOR, TENANT/OWNER, AND TENANT/OWNER VENDOR SUPPLIED ITEMS.
6. COORDINATE FINAL LOCATIONS OF OWNER AND THIRD PARTY VENDOR FURNISHED ITEMS IN THE FIELD WITH TENANT/OWNER REP. AND THE VENDOR. UNLESS INDICATED OTHERWISE, ALL BLOCKING SHALL BE PROVIDED BY THE CONTRACTOR.
5. BLOCKING AT DRY LOCATIONS: FIRE RETARATED TREATED WOOD BLOCKING.
6. BLOCKING AT WET LOCATIONS: GALVANIZED METAL STRIP BLOCKING, AS PROVIDED BY METAL STUD SUPPLIER/FABRICATOR.
7. CONTRACTOR SHALL PROVIDE ALL BLOCKING AND BRACING FOR ALL ITEMS SHOWN FOR ALL LOCATIONS, AS SHOWN IN THE ARCHITECTURAL AND ID DRAWINGS.
7. ALL FIRE RATED PARTITIONS SHALL BE EFFECTIVELY AND PERMANENTLY IDENTIFIED WITH SIGNS OR STENCILING. SUCH IDENTIFICATION SHALL BE ABOVE THE PARTITION, ON THE CEILING AND IN CONCEALED SPACES. IDENTIFY WITH THE FOLLOWING TEXT: "XX" HOUR RATED FIRE/SMOKE BARRIER. PROTECT ALL OPENINGS AND PENETRATIONS. CONFIRM HOURLY RATING WITH WALL WITH FIRE RESISTANCE RATING (RATED) WALL. AT LOCATIONS WHERE THERE ARE NO CEILINGS OR CONCEALED SPACES, COORDINATE SIGNAGE REQUIREMENTS WITH THE AUTHORITY HAVING JURISDICTION (AHJ). AT THESE LOCATIONS, IF SIGNAGE IS REQUIRED BY THE AHJ, CONTRACTOR SHALL PROVIDE IT. CONTRACTOR SHALL PROVIDE ALL BLOCKING AND BRACING FOR ALL ITEMS SHOWN FOR ALL LOCATIONS, AS SHOWN IN THE ARCHITECTURAL AND ID DRAWINGS.
8. SEE ACCESSIBILITY STANDARDS FOR MOUNTING HEIGHT REQUIREMENTS FOR ALL TOILET AND BATHROOM AMENITIES.

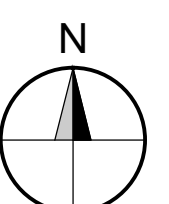
[illegible]

Sheet Name: ENLARGED PLANS AND DETAILS		
Proj #: 211201	Issue Date: 03-14-2022	
Sheet No.: A402		
Drawn By: KC	Checked By: KC/SA	

5586 OLD HIGHWAY 5 (OLD GEORGIA HIGHWAY 5 AND PAYNE ROAD)
WOODSTOCK, GEORGIA 30188


CONSTRUCTION COORDINATION DRAWINGS
PREPARED FOR INNOVATIVE CONTRACTING SOLUTIONS
5605 GLENDRIIDGE DR. NE

SUITE 345 ATLANTA, GEORGIA 30342

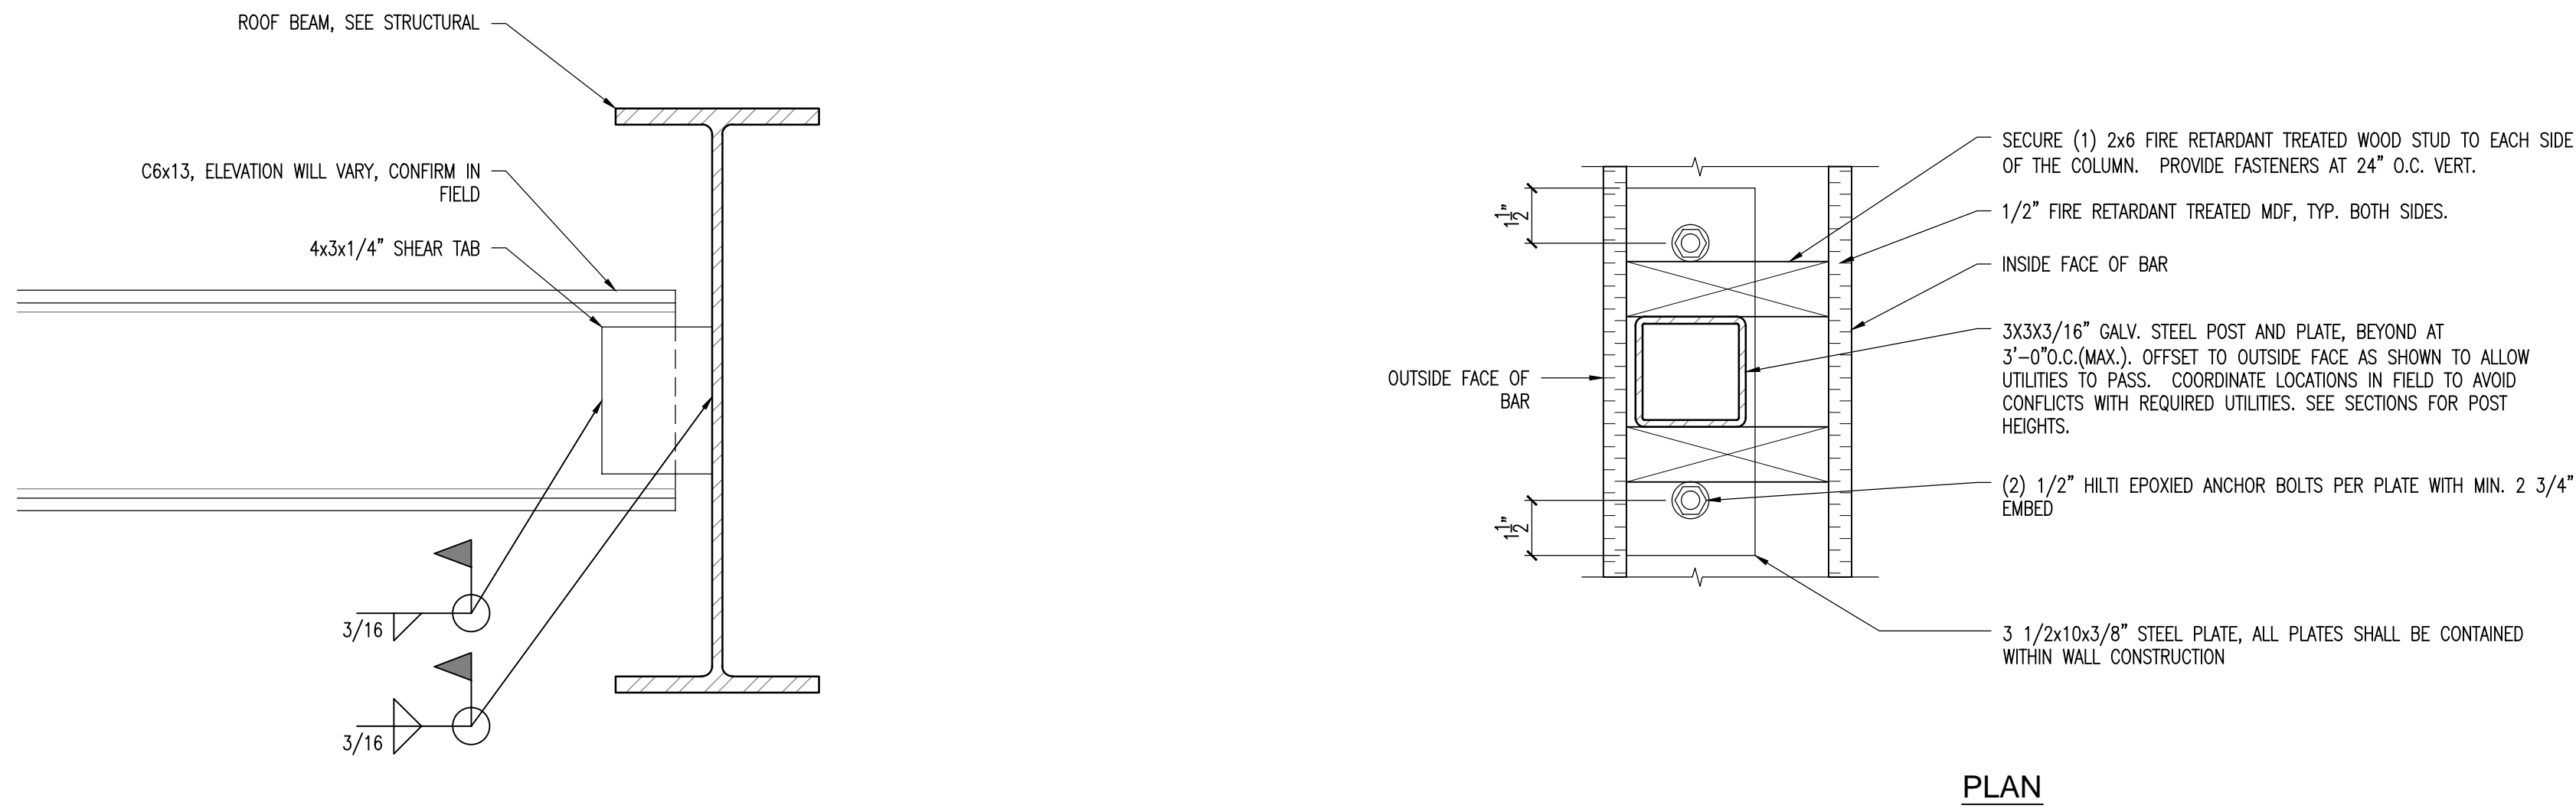


6 CHANNEL ATTACHMENT TO BEAM SECTION


5 STEEL POST DETAIL

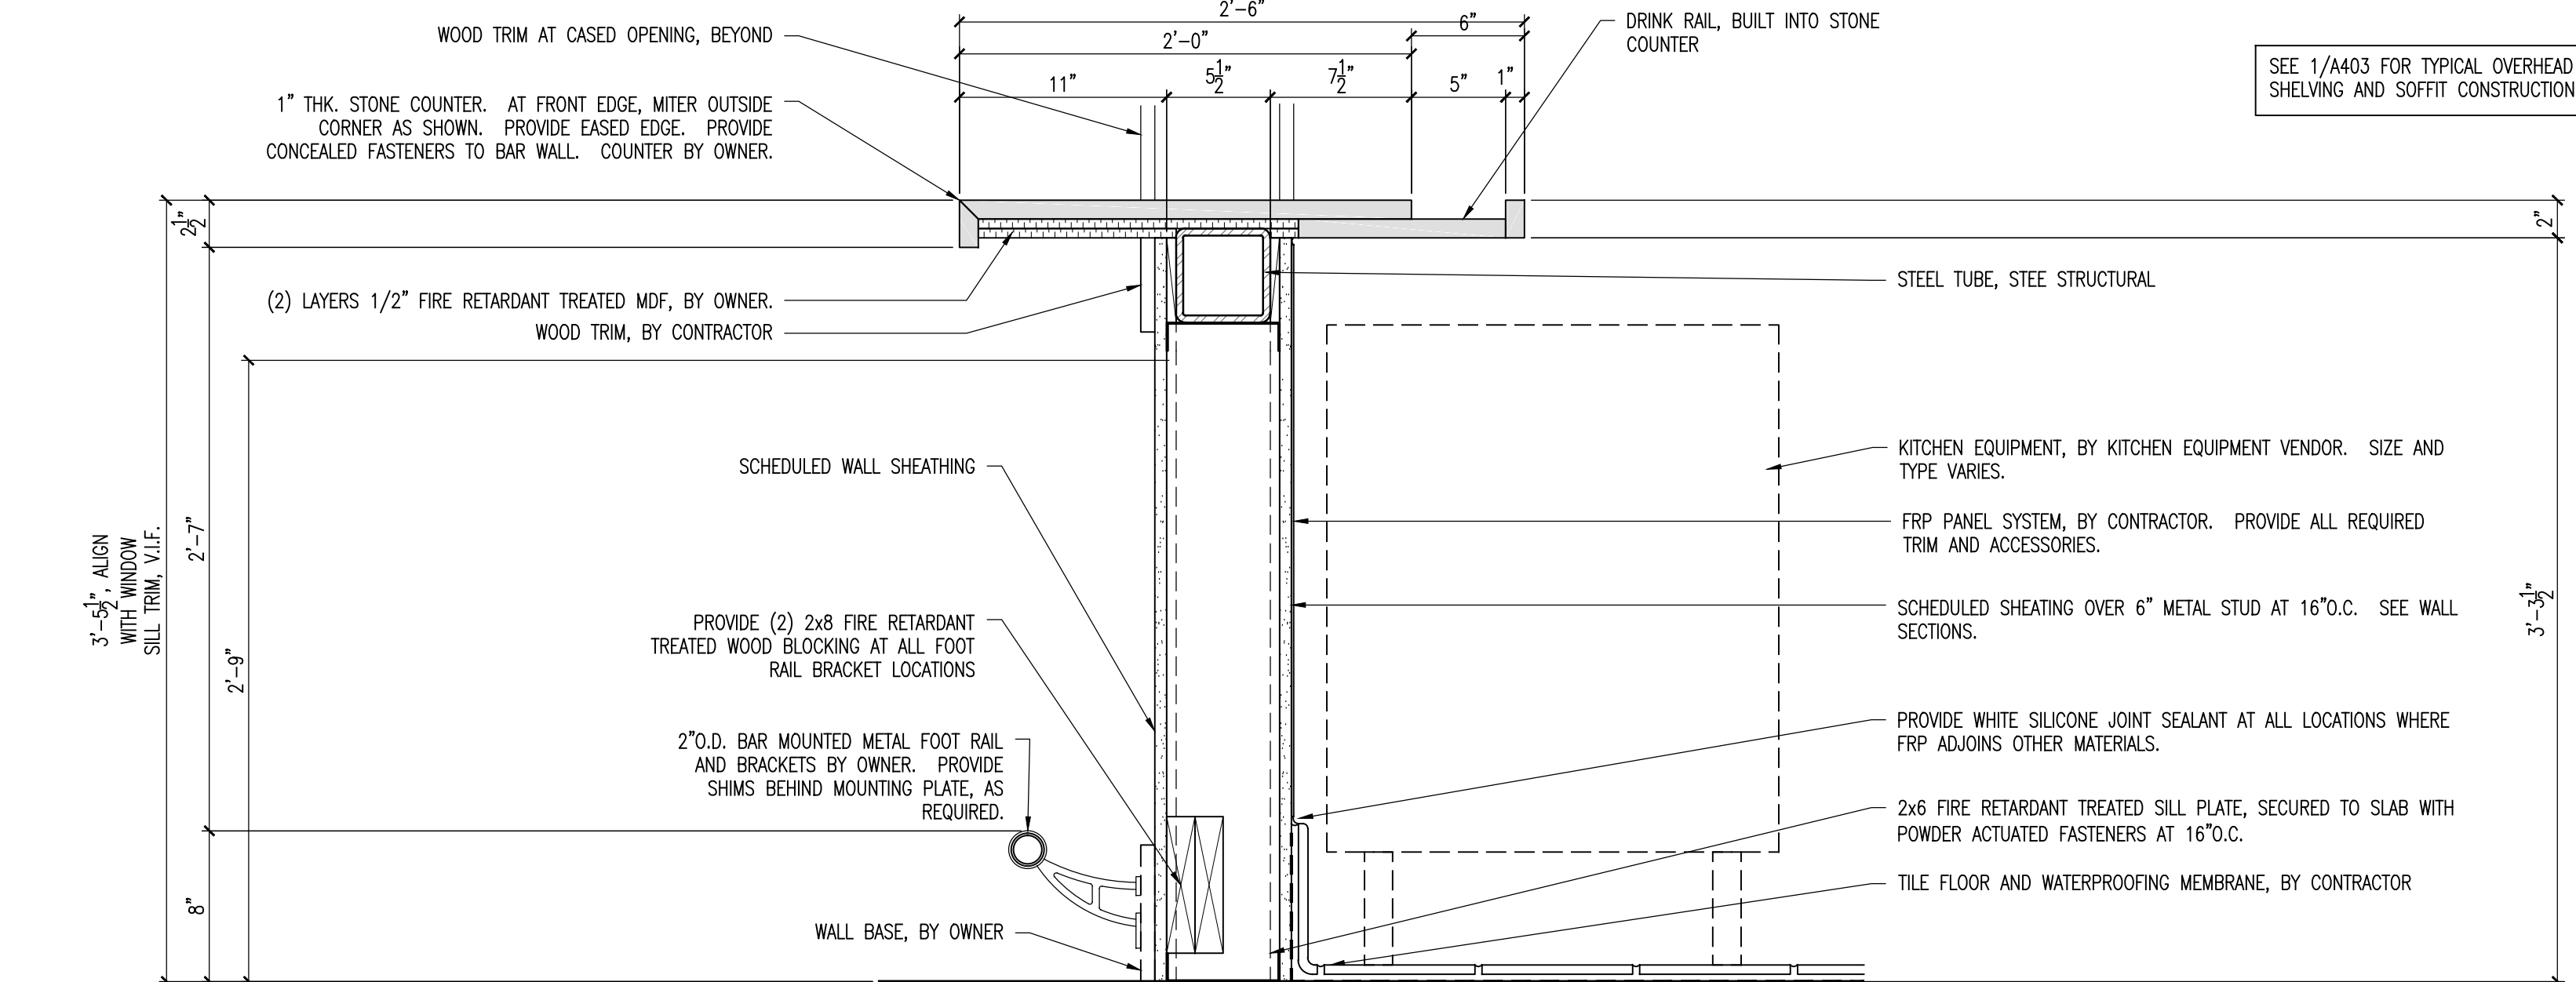

4 BAR SECTION AT FIRST FLOOR PATIO

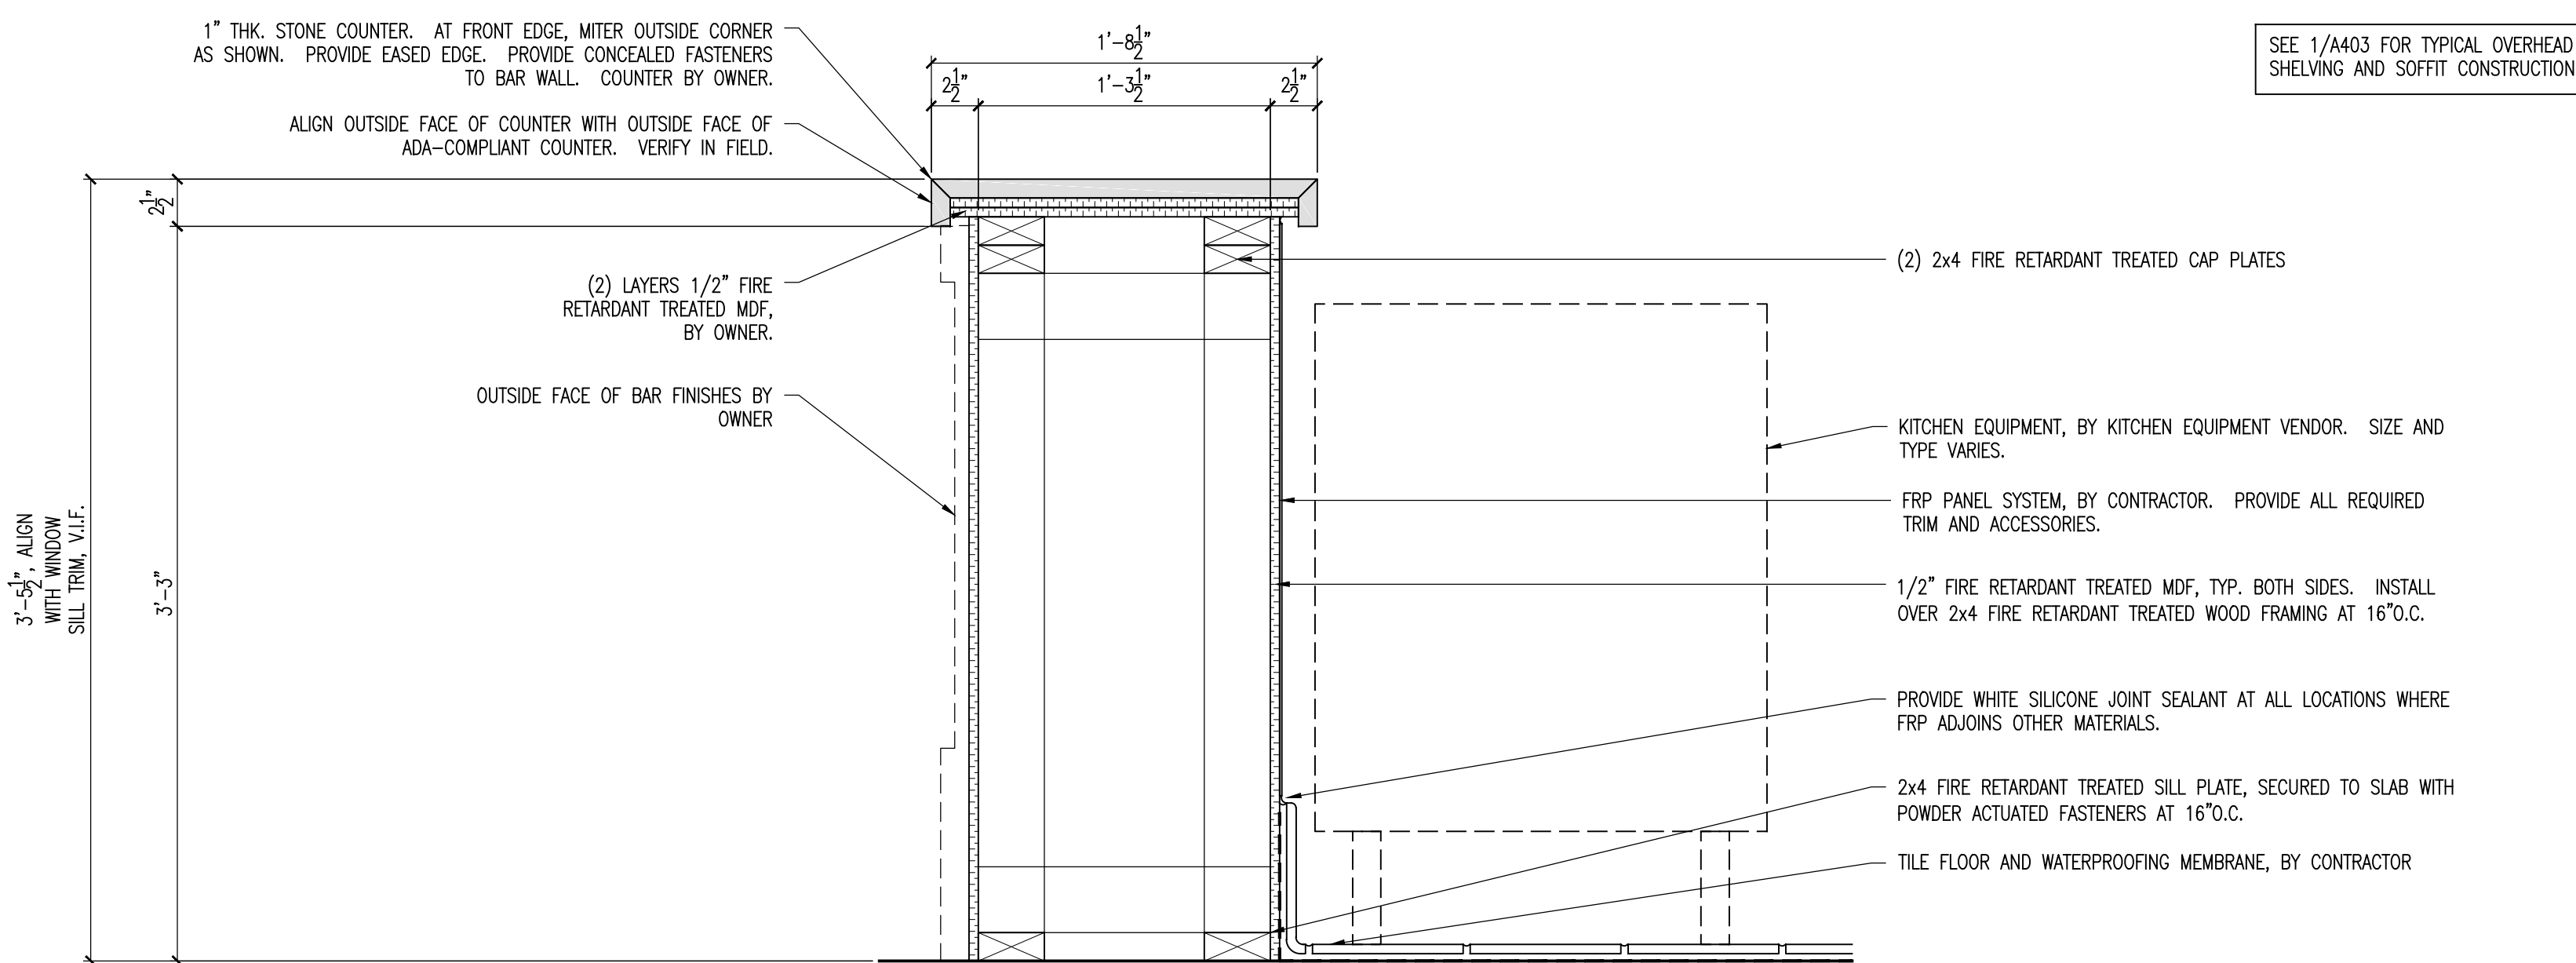


3 BAR SECTION AT STAFF COUNTER

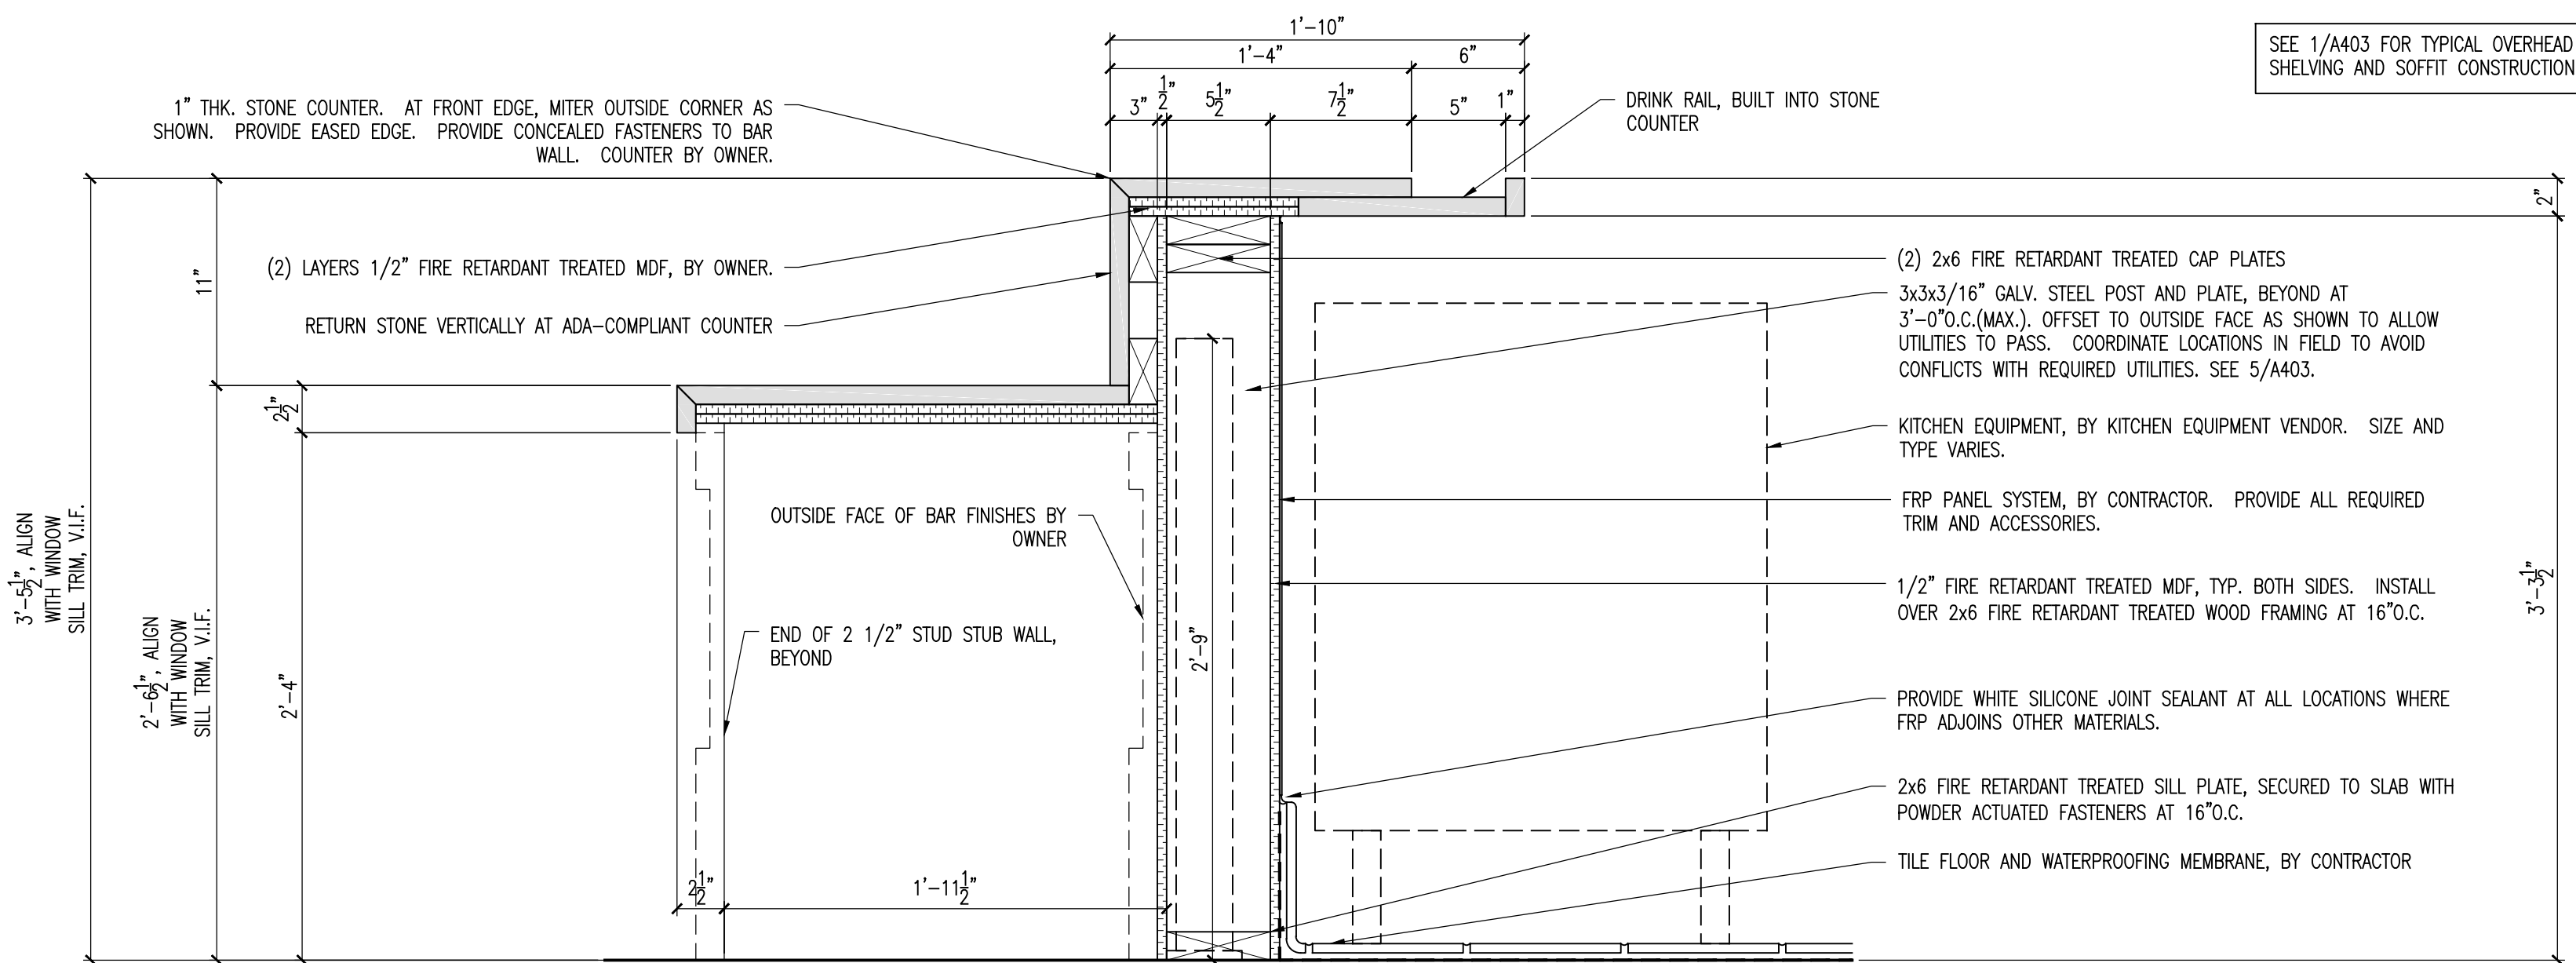

2 BAR SECTION AT ACCESSIBLE COUNTER

GENERAL SHEET NOTES

- NOT ALL ITEMS MAY BE USED.
- DIMENSIONS ARE TAKEN TO FACE OF STUD, FACE OF MASONRY OR CONCRETE, OR COLUMN CENTERLINE, UNLESS INDICATED OTHERWISE.
- PRIOR TO ROUGH-IN AND WALL ENCLOSURE, COORDINATE ALL WORK WITH TENANT/OWNER VENDOR REQUIREMENTS.
- PRIOR TO ROUGH-IN AND WALL ENCLOSURE, COORDINATE LOCATION OF ALL WALL MOUNTED FIXTURES AND DEVICES WITH FINISH WORK SHOWN IN THE ARCHITECTURAL AND/OR ID DRAWINGS - ALIGN AS INDICATED, BUT NOT BE LIMITED TO: ALL CONTRACTOR, TENANT/OWNER, AND TENANT/OWNER VENDOR SUPPLIED ITEMS.
- IF THERE IS A DISCREPANCY BETWEEN THE ARCHITECTURAL AND ID DRAWINGS, NOTIFY THE ARCHITECT FOR RESOLUTION PRIOR TO PROCEEDING WITH THE WORK.
- IF THERE IS A DISCREPANCY WITH THE ACCESSIBILITY STANDARDS, REPORT THE DISCREPANCY TO THE ARCHITECT FOR RESOLUTION PRIOR TO PROCEEDING WITH THE WORK.
- PRIOR TO WALL ENCLOSURE, CONTRACTOR SHALL PROVIDE ALL BLOCKING AS REQUIRED FOR WALL MOUNTED ITEMS. THIS SHALL INCLUDE, BUT NOT BE LIMITED TO: ALL CONTRACTOR, TENANT/OWNER, AND TENANT/OWNER VENDOR SUPPLIED ITEMS.
- COORDINATE FINAL LOCATIONS OF OWNER AND THIRD PARTY VENDOR FURNISHED ITEMS IN THE FIELD WITH TENANT/OWNER REP AND THE VENDOR. UNLESS INDICATED OTHERWISE, ALL BLOCKING SHALL BE ENCLOSED INSIDE FINISH CONSTRUCTION.
- BLOCKING AT DRY LOCATIONS: FIRE RETARDANT TREATED WOOD BLOCKING.
- BLOCKING AT WET LOCATIONS: GALVANIZED METAL STRAP BLOCKING, AS PROVIDED BY METAL STUD SUPPLIER/FABRICATOR.
- CONTRACTOR SHALL PROVIDE ALL NECESSARY FRAMING TO ACCOMMODATE THE FINAL LAYOUTS SHOWN FOR ALL FINISHES SHOWN IN THE ARCHITECTURAL AND ID DRAWINGS.
- ALL FIRE RATED PARTITIONS SHALL BE EFFECTIVELY AND PERMANENTLY IDENTIFIED WITH SIGNS OR STENCILING. SUCH IDENTIFICATION SHALL BE ABOVE ANY DECORATIVE CEILING AND IN CONCEALED SPACES. IDENTIFY WITH THE FOLLOWING TEXT: "X" HOUR RATED FIRE/SMOKE BARRIER. PROTECT ALL OPENINGS AND PENETRATIONS. CONFIRM HOURLY RATING WITH FIRE RESISTANCE RATING OF WALL, AT LOCATIONS WHERE THERE ARE NO CEILINGS OR CONCEALED SPACES. COORDINATE SIGNAGE REQUIREMENT WITH THE AUTHORITY HAVING JURISDICTION (AHJ). AT THESE LOCATIONS, IF SIGNAGE IS REQUIRED BY THE AHJ, CONFIRM WITH TENANT/OWNER IF THEY PREFER SIGNS OR STENCILING.
- SEE ACCESSIBILITY STANDARDS FOR MOUNTING HEIGHT REQUIREMENTS FOR ALL TOILET AND BATHROOM ACCESSORIES.

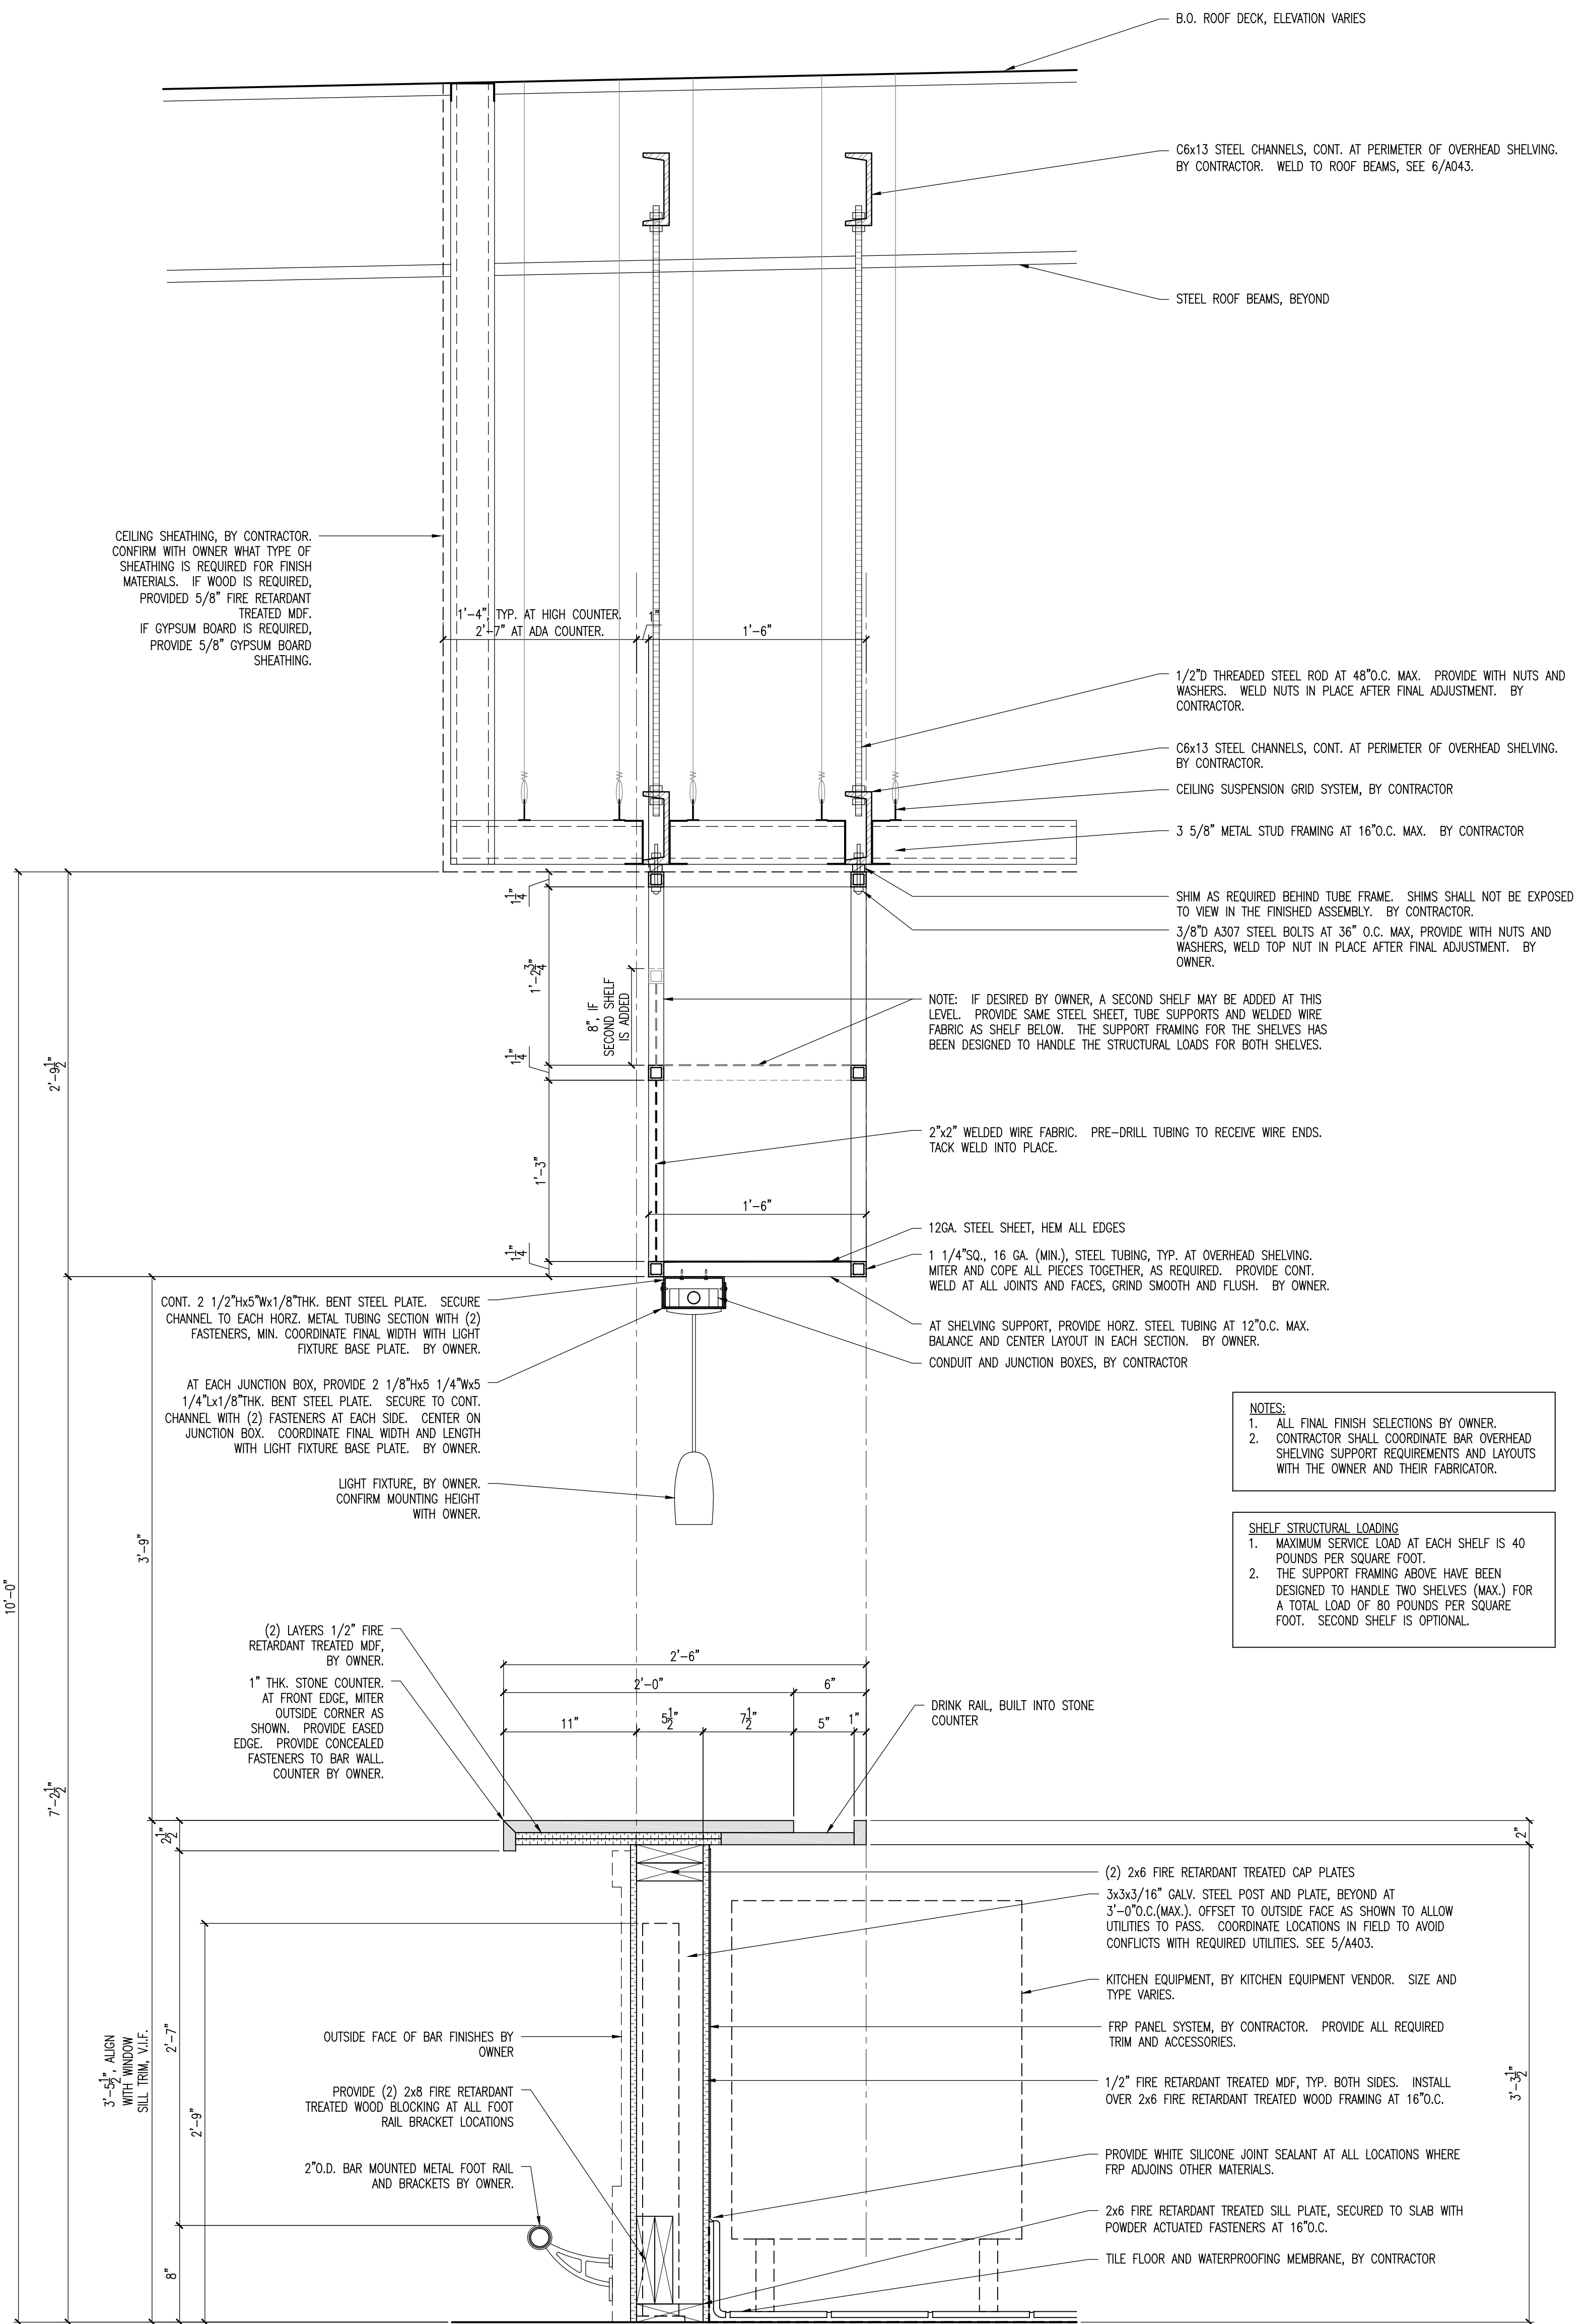

1 TYPICAL BAR SECTION

No.	Description	Date
1	ISSUED FOR PERMIT	03-14-2022
2	ISSUED FOR CONSTRUCTION	04-12-2022
3	ISSUED FOR CONSTRUCTION	04-12-2022
4	ISSUED FOR CONSTRUCTION	04-12-2022
5	ISSUED FOR CONSTRUCTION	04-12-2022
6	ISSUED FOR CONSTRUCTION	04-12-2022
7	ISSUED FOR CONSTRUCTION	04-12-2022
8	ISSUED FOR CONSTRUCTION	04-12-2022
9	ISSUED FOR CONSTRUCTION	04-12-2022
10	ISSUED FOR CONSTRUCTION	04-12-2022

ENLARGED PLANS AND DETAILS

Proj #: 211201 Issue Date: 03-14-2022

Sheet No.: A403

Drawn By: KC Checked By: KC/SA

- 1.1. CONCRETE FILLED STEEL PAN.
- 1.2. FORMER CHANNEL FRAME. C12x20.7 (3"Wx12"D, NOMINAL) SHOWN (MIN.). FABRICATOR SHALL DESIGN FINAL STRUCTURAL SIZES AND REQUIREMENTS.
- 1.3. STAIR SHALL BE SHOP FRAMED AND PAINTED.
- 1.4. 4X12 STEEL TUBE AT LANDING SUPPORT (MIN.). PROVIDE CONTINUOUS FILLET WELD TO THE LANDING COLUMNS AT EITHER SIDE OF STAIR.
- 1.5. REMOVABLE GUARDRAIL ASSEMBLY, SEE 1.2,4.6,5/AS10.
- 1.6. NOT USED.
- 1.7. BARRIER RAILING UNDER STAIR, REQUIRED BY ADA. SEE 7/AS10.
- 1.8. GUARDRAIL MOUNTED HANDRAIL ASSEMBLY. SEE 1.2,5.6,8/AS10.
- 1.9. WALL MOUNTED HANDRAIL. SEE 6/AS10.
- 1.10. AT UPPER LANDINGS, HOLD TOP OF CHANNEL FRAME FLUSH WITH THE TOP OF CONCRETE. THIS IS TO MEET ADA REQUIREMENTS.
- 1.11. 3/8" STEEL PLATE WELDED TO POST TO CLOSE THE GAP BETWEEN THE WALL AND GUARDRAIL. SEE 6/AS10.
- 1.12. FIXED GUARDRAIL ASSEMBLY. SEE 1.3,6,5/AS10.
- 1.13. 4"x4" STEEL POST (MIN.) AT LANDING SUPPORT. TYPE. OF 4) COLUMNS AT EACH LANDING.
- 1.1.1. INSERT COLUMNS TO INSIDE FACE OF CHANNEL STRINGER/FRAMING AS SHOWN.
- 1.1.2. PROVIDE WITH 8"x8" BASE PLATE, THICKNESS AS REQUIRED.
- 1.1.3. PROVIDE EACH BASE PLATE WITH 4) FASTENERS, SIZE AND TYPE AS REQUIRED.
- 1.1.4. 1/2" STEEL TUBE 1/4" BENDING (MIN.). TYPE. ALL SIZES OF LANDING.
- 1.1.5. COPE THE INTERSECTION OF THE Y-BRACING AND PROVIDE CONT. FILLET WELD AT ALL EDGES.
- 1.1.6. PROVIDE CONT. FILLET WELD AT ALL JUNCTIONS WITH STEEL POSTS.
- 1.1.7. PROVIDE 1/2" STEEL TUBE AT LANDING SUPPORT. THIS IS TO ALIGN WITH THE FINISH FLOOR OF ROOF/STAIR PLATE.
- 1.1.8. AT GATE, PROVIDE 1/4" x 50, TUBE SPACE AT HINGE SIDE OF DOOR, CAP BOTH ENDS. LENGTH=HINGE LENGTH+1/2". PROVIDE (1) AT EACH HINGE. WELD TO STEEL COLUMN.
- 1.1.9. PROVIDE STAIR POST FROM TOP OF STRINGER TO BOTTOM OF GUARDRAIL/ASSEMBLY BOTTOM RAIL.
- 1.1.10. PROVIDE SLIP CONNECTION BETWEEN STAIR GUARDRAIL ASSEMBLY AND ADJACENT STEEL COLUMN/GUARDRAIL POST.

[illegible]

NOT ALL ITEMS MAY BE USED.

DIMENSIONS ARE TAKEN TO FACE OF STUD, FACE OF MASONRY OR CONCRETE, OR COLUMN CENTERLINE, UNLESS INDICATED OTHERWISE.

PRIOR TO ROUGH-IN AND/OR DRAWINGS, COORDINATE ALL WORK WITH TENANT/OWNER VENDOR REQUIREMENTS.

PRIOR TO ROUGH-IN AND/OR DRAWINGS, COORDINATE LOCATION OF ALL WALL MOUNTED FIXTURES AND DEVICES WITH FINISH WORK SHOWN IN THE ARCHITECTURAL AND/OR ID DRAWINGS - ALIGN AS INDICATED. THIS SHALL INCLUDE, BUT NOT BE LIMITED TO: ALL CONTRACTOR, TENANT/OWNER, AND TENANT/OWNER VENDOR SUPPLIED ITEMS.

4.1. IF THERE IS A DISCREPANCY BETWEEN THE ARCHITECTURAL AND ID DRAWINGS, NOTIFY THE ARCHITECT FOR RESOLUTION PRIOR TO PROCEEDING WITH THE WORK.

4.2. IF THERE IS A DISCREPANCY WITH THE ACCESSIBILITY STANDARDS, REPORT THE DISCREPANCY TO THE ARCHITECT FOR RESOLUTION PRIOR TO PROCEEDING WITH THE WORK.

PRIOR TO WALL ENCLOSURE, CONTRACTOR SHALL PROVIDE ALL BLOCKING AS REQUIRED FOR WALL MOUNTED ITEMS. THIS SHALL INCLUDE, BUT NOT BE LIMITED TO: ALL CONTRACTOR, TENANT/OWNER, AND TENANT/OWNER VENDOR SUPPLIED ITEMS.

5.1. COORDINATE FINAL LOCATIONS OF OWNER AND THIRD PARTY VENDOR FURNISHED ITEMS IN THE FIELD WITH TENANT/OWNER REP AND THE VENDOR.

5.2. UNLESS INDICATED OTHERWISE, ALL BLOCKING SHALL BE ENCLOSED INSIDE FINISH CONSTRUCTION.

6.1. BLOCKING AT DOOR LOCATIONS: FIRE RESISTANT TREATED WOOD BLOCKING

6.2. BLOCKING AT WET LOCATIONS: GALVANIZED METAL STRAP BLOCKING, AS PROVIDED BY METAL STUO SUPPLIER/FABRICATOR.

7. CONTRACTOR SHALL PROVIDE ALL NECESSARY FRAMING TO ACCOMMODATE THE FINAL LAYOUTS SHOWN FOR ALL FINISHES SHOWN IN THE ARCHITECTURAL AND ID DRAWINGS.

8. IDENTIFIED PARTITIONS SHALL BE EFFECTIVELY AND PERMANENTLY IDENTIFIED WITH SIGNS OR STENCILING. SUCH IDENTIFICATION SHALL BE ABOVE ANY DECORATIVE CEILING AND IN CONCEALED SPACES. IDENTIFY WITH THE FOLLOWING TEXT: "XX HOUR RATED FIRE/SMOKE BARRIER. PROTECT ALL OPENINGS AND PENETRATIONS." CONFIRM HOURLY RATING WITH WIRE FIRE RESISTANCE RATING LABEL. AT LOCATIONS WHERE THERE ARE NO CLASHES OR INTERFERENCE WITH EXISTING OR NEW MECHANICAL EQUIPMENT OR ELECTRICAL DISTRIBUTION (WALL), AT THESE LOCATIONS, IF SIGNAGE IS REQUIRED BY THE AHJ, CONFORM WITH TENANT/OWNER IF THEY PREFER SIGNS OR STENCILING.

SEE ACCESSIBILITY STANDARDS FOR MOUNTING HEIGHT REQUIREMENTS FOR ALL TOILET AND BATHROOM ACCESSORIES.

INTERIOR STAIRS AND RAILINGS.

1. INTERIOR STAIRS SHALL HAVE THE FOLLOWING SURFACE PREP: SSPC-SP3 POWER TOOL CLEANING.

1.1 ALL SURFACE IMPERFECTIONS SHALL BE REMOVED AND/OR FILLED. THIS SHALL INCLUDE, BUT NOT BE LIMITED TO: GAUGES, BURN MARKS, EXCESS MATERIALS, AND OTHER VISIBLE SURFACE IMPERFECTIONS.

2. INTERIOR STAIRS SHALL BE SHOP PRIMED AND FIELD PAINTED.

2.1 INTERIOR RAILINGS SHALL BE SHOP PRIMED AND FIELD PAINTED, UNLESS INDICATED OTHERWISE.

3. ENSURE ALL ERECTION MARKS, AND OTHER MARKS, ARE COMPLETELY SEALED BY THE PRIMER AND NOT VISIBLE THROUGH THE PRIMER. AT NON-PANED FINISHES, MARKS SHALL BE REMOVED BY METHOD RECOMMENDED BY THE MANUFACTURER. RESTORE SURFACE FINISHES AS REQUIRED.

EXTERIOR STAIRS AND RAILINGS.

1. EXTERIOR STAIRS SHALL HAVE THE FOLLOWING SURFACE PREP: SSPC-SP3 POWER TOOL CLEANING.

1.1 ALL SURFACE IMPERFECTIONS SHALL BE REMOVED AND/OR FILLED. THIS SHALL INCLUDE, BUT NOT BE LIMITED TO: GAUGES, BURN MARKS, EXCESS MATERIALS, AND OTHER VISIBLE SURFACE IMPERFECTIONS.

2. EXTERIOR STAIRS SHALL BE SHOP HOT-SPRINT GALVANIZED.

2.1 IN THE FIELD, PROVIDE PRE-TREATMENT AND CLEANER RECOMMENDED FOR GALVANIZED STEEL.


2.2 IN THE FIELD, AFTER CLEANING, PROVIDE PRIMER AND FINISH PAINT COATS.

3. EXTERIOR STAIRS SHALL BE SHOP HOT-SPRINT GALVANIZED.

3.1 IN THE FIELD, PROVIDE PRE-TREATMENT AND CLEANER RECOMMENDED FOR GALVANIZED STEEL.

3.2 IN THE FIELD, AFTER CLEANING, PROVIDE PRIMER AND FINISH PAINT COATS.

4. ENSURE ALL ERECTION MARKS, AND OTHER MARKS, ARE COMPLETELY SEALED BY THE PRIMER AND NOT VISIBLE THROUGH THE PRIMER. AT NON-PANED FINISHES, MARKS SHALL BE REMOVED BY METHOD RECOMMENDED BY THE MANUFACTURER. RESTORE SURFACE FINISHES AS REQUIRED.

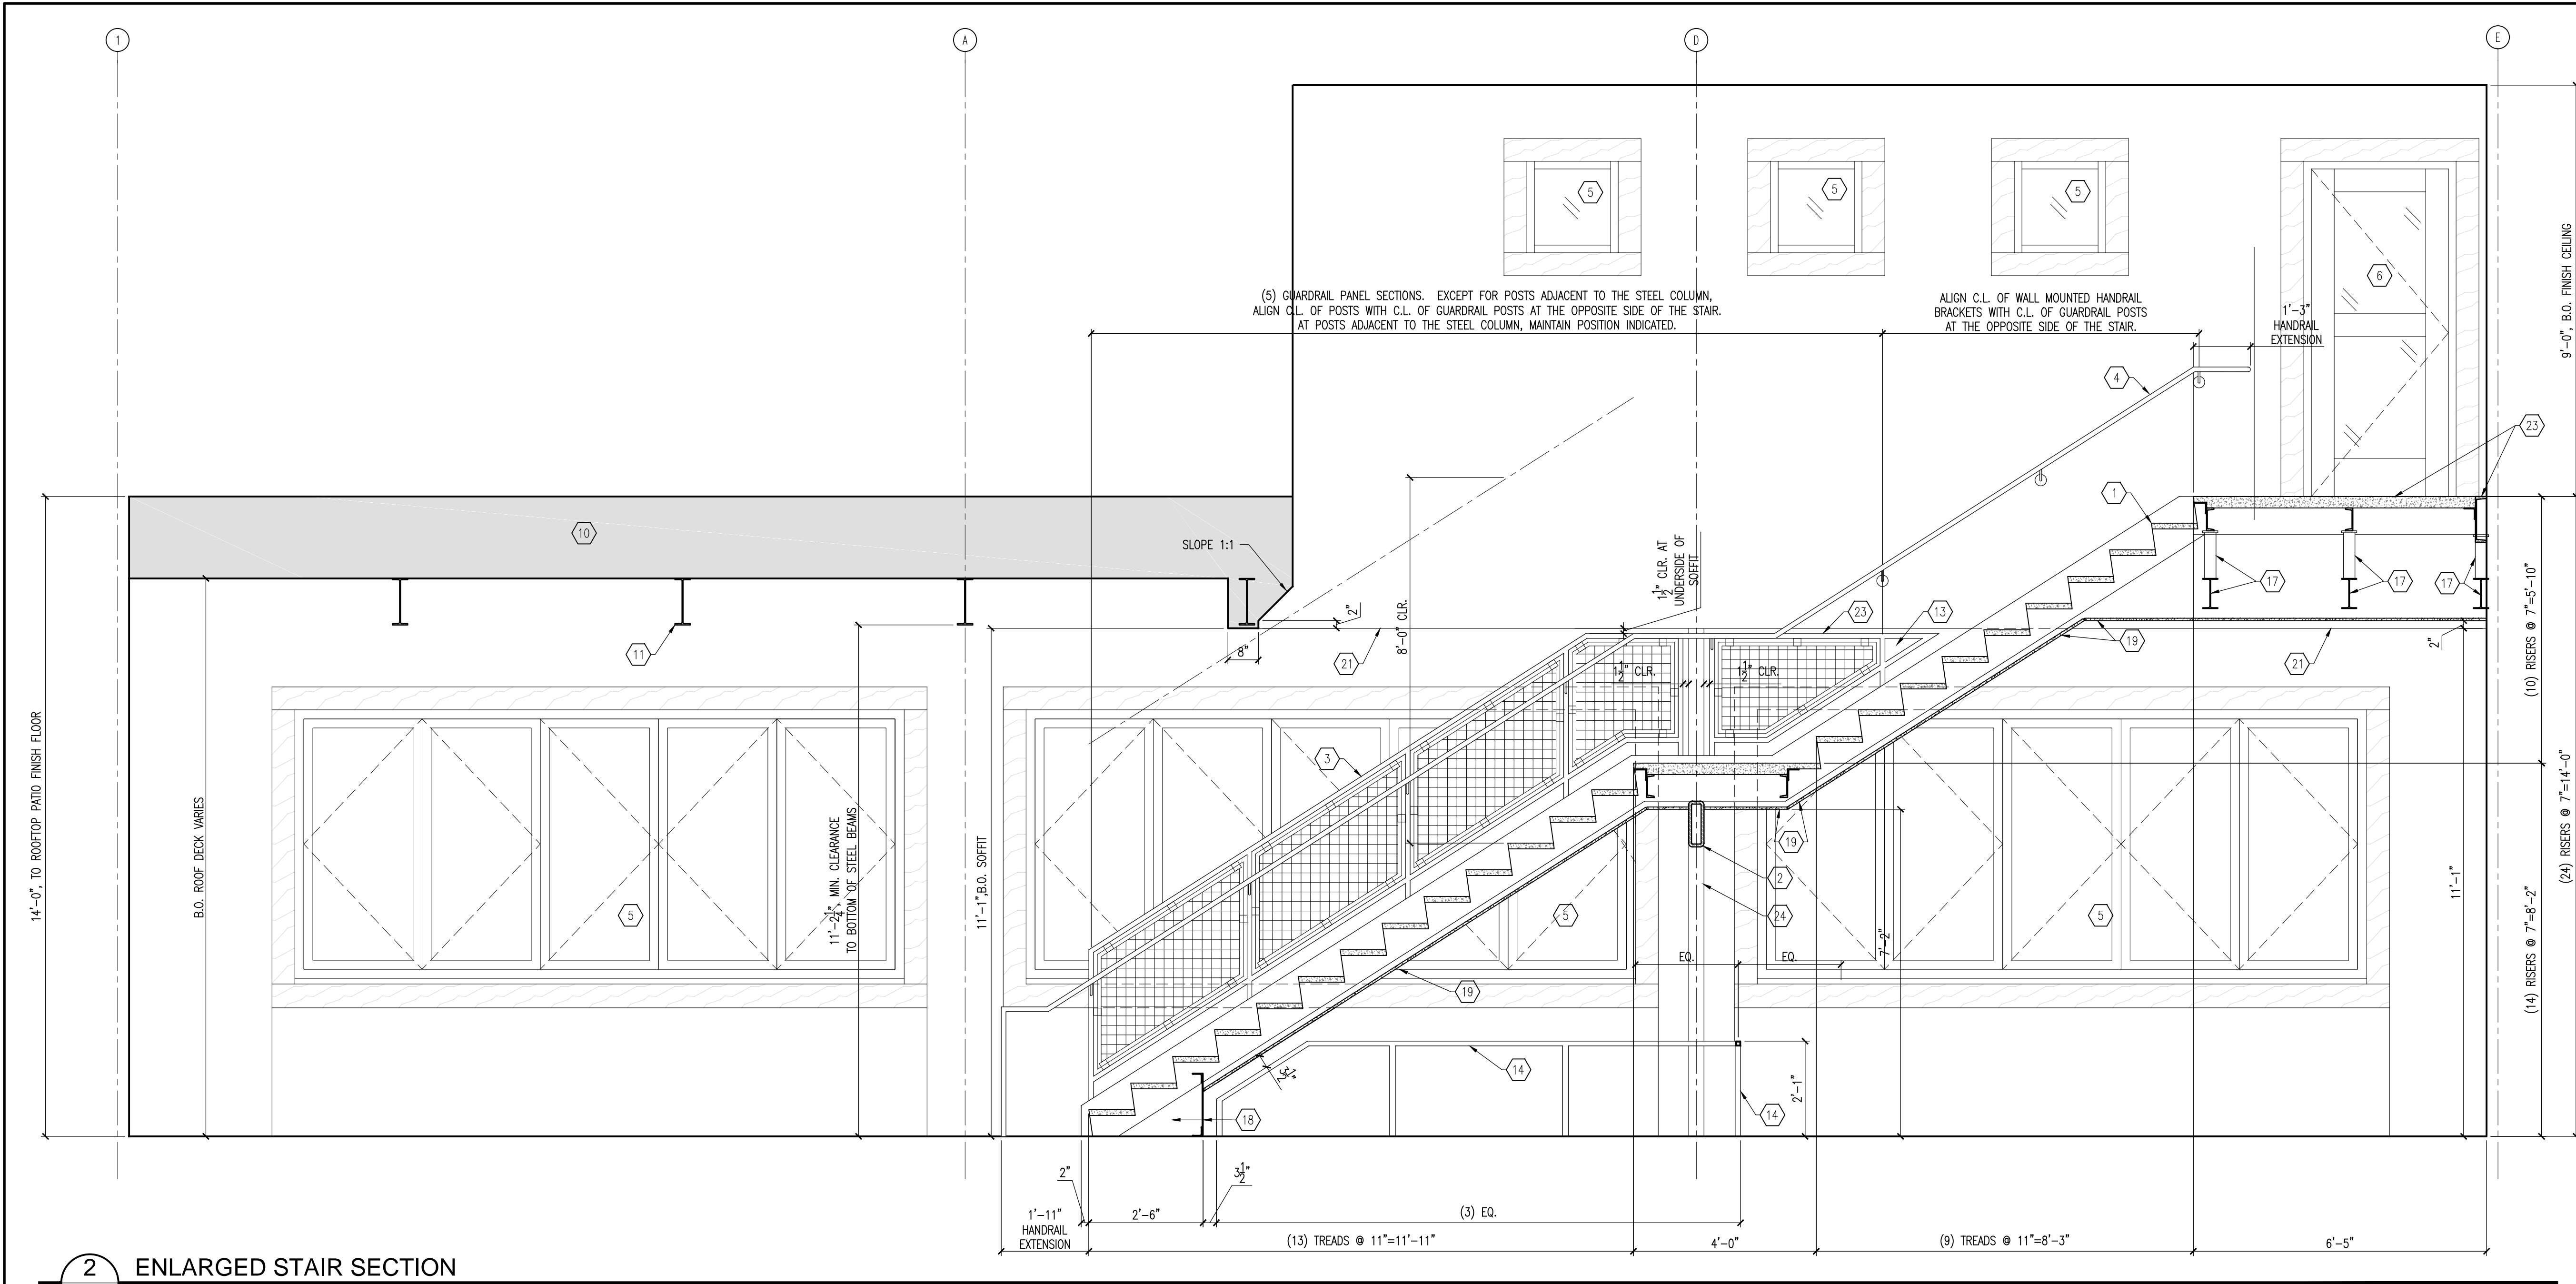

2 ENLARGED STAIR SECTION

A502 1/2"=1'-0"

GENERAL SHEET NOTES


1. SEE A501 FOR GENERAL SHEET NOTES.

STAIR DESIGN REQUIREMENTS

1. SEE A501 FOR STAIR DESIGN REQUIREMENTS.

KEYNOTES

1. STAIR CONSTRUCTION.
 - 1.1. CONCRETE FILLED STEEL PAN.
 - 1.2. PERIMETER CHANNEL FRAME. C12x20.7 (3"Wx12"D, NOMINAL) SHOWN (MIN.). FABRICATOR SHALL DESIGN FINAL STRUCTURAL SIZES AND REQUIREMENTS.
 - 1.3. STAIR SHALL BE SHOP PRIMED AND FIELD PAINTED.
2. 4X12 STEEL TUBE AT LANDING SUPPORT (MIN.). PROVIDE CONTINUOUS FILLET WELD TO THE BUILDING COLUMNS AT EITHER SIDE OF STAIR.
3. REMOVABLE GUARDRAIL ASSEMBLY. SEE 1,2,4,8,9/A510.
4. WALL-MOUNTED HANDRAIL ASSEMBLY. SEE 6/A510.
5. WINDOW, BEYOND.
6. DOOR, BEYOND.
7. WALL OPENING TO BAR, BEYOND.
8. BAR COUNTER, BEYOND.
9. RETRACTABLE, ROLL UP, VINYL WINDOW SYSTEM, BEYOND.
10. PEDISTAL PAVER SYSTEM.
11. ROOF SYSTEM AND STRUCTURAL DECK.
12. STEEL BEAM LOCATION.
13. INFILL OPENING WITH 1/4" STEEL PLATE, CENTERED ON THE TUBE FRAMING. PROVIDE CONT. FILLET WELD, BOTH SIDES OF PLATE. GRIND WELDS SMOOTH AND FLUSH.
14. BARRIER RAILING AT VERTICAL CLEARANCE TO STAIR, REQUIRED BY ADA. SEE 7/A510.
15. BOTTOM OF STRUCTURE, BEYOND.
16. STAIR STEEL CHANNEL RETURN, BEYOND.
17. STAIR FABRICATOR SHALL PROVIDE STEEL POSTS AND INTERMEDIATE LOWER FRAMING, AS REQUIRED TO FRAME INTO LOWER STEEL BEAMS AT BUILDING FRAME. COORDINATE ALL WORK WITH THE STEEL FABRICATOR. TOP OF INTERMEDIATE LOWER FRAMING SHALL ALIGN WITH THE TOP OF THE BUILDING FRAME BEAMS, V.I.F.
18. STEEL ANGLES AND 1/4" STEEL CLOSURE PLATES AT BOTTOM OF STAIR, TYPICAL ALL (3) SIDES. BY STAIR FABRICATOR.
 - 18.1. AT STAIR STRINGERS, FACE OF PLATE SHALL ALIGN WITH INSIDE EDGE OF STAIR STRINGER.
 - 18.2. WELD ANGLES TO STAIR FRAMING.
 - 18.3. SECURE PLATES TO THE ANGLES WITH COUNTERSUNK, FLAT HEAD SCREWS.
19. AT UNDERSIDE OF STAIR, PROVIDE 5/8" GYPSUM BOARD OVER 1 1/2" METAL FRAMING. SEE 284/A510.
- 19.1. PROVIDE ALL REQUIRED SUPPORT AND BLOCKING, AS REQUIRED.
- 19.2. AT UPPER STAIR LANDING, HOLD CEILING FRAMING 1 1/2" BELOW THE LOWER STEEL BEAM SUPPORT.
20. 3/8" STEEL PLATE WELDED TO POST TO CLOSE THE GAP BETWEEN THE WALL AND GUARDRAIL. SEE 8/A510.
21. SOFFIT AT STAIR OPENING, BEYOND.
22. AT THE UPPER LANDING, HOLD THE TOP OF THE CHANNEL FRAME FLUSH WITH THE TOP OF THE CONCRETE SLAB. THIS IS REQUIRED TO MEET ADA REQUIREMENTS. TYPICAL ALL SIDES OF THE UPPER LANDING.
23. AT THIS LOCATION, THE GUARDRAIL STOPS UNDER THE SOFFIT CONSTRUCTION AT THE PERIMETER OF THE STAIR.
24. STEEL COLUMN BEYOND.
25. WALL LOUVER, SEE MECA.

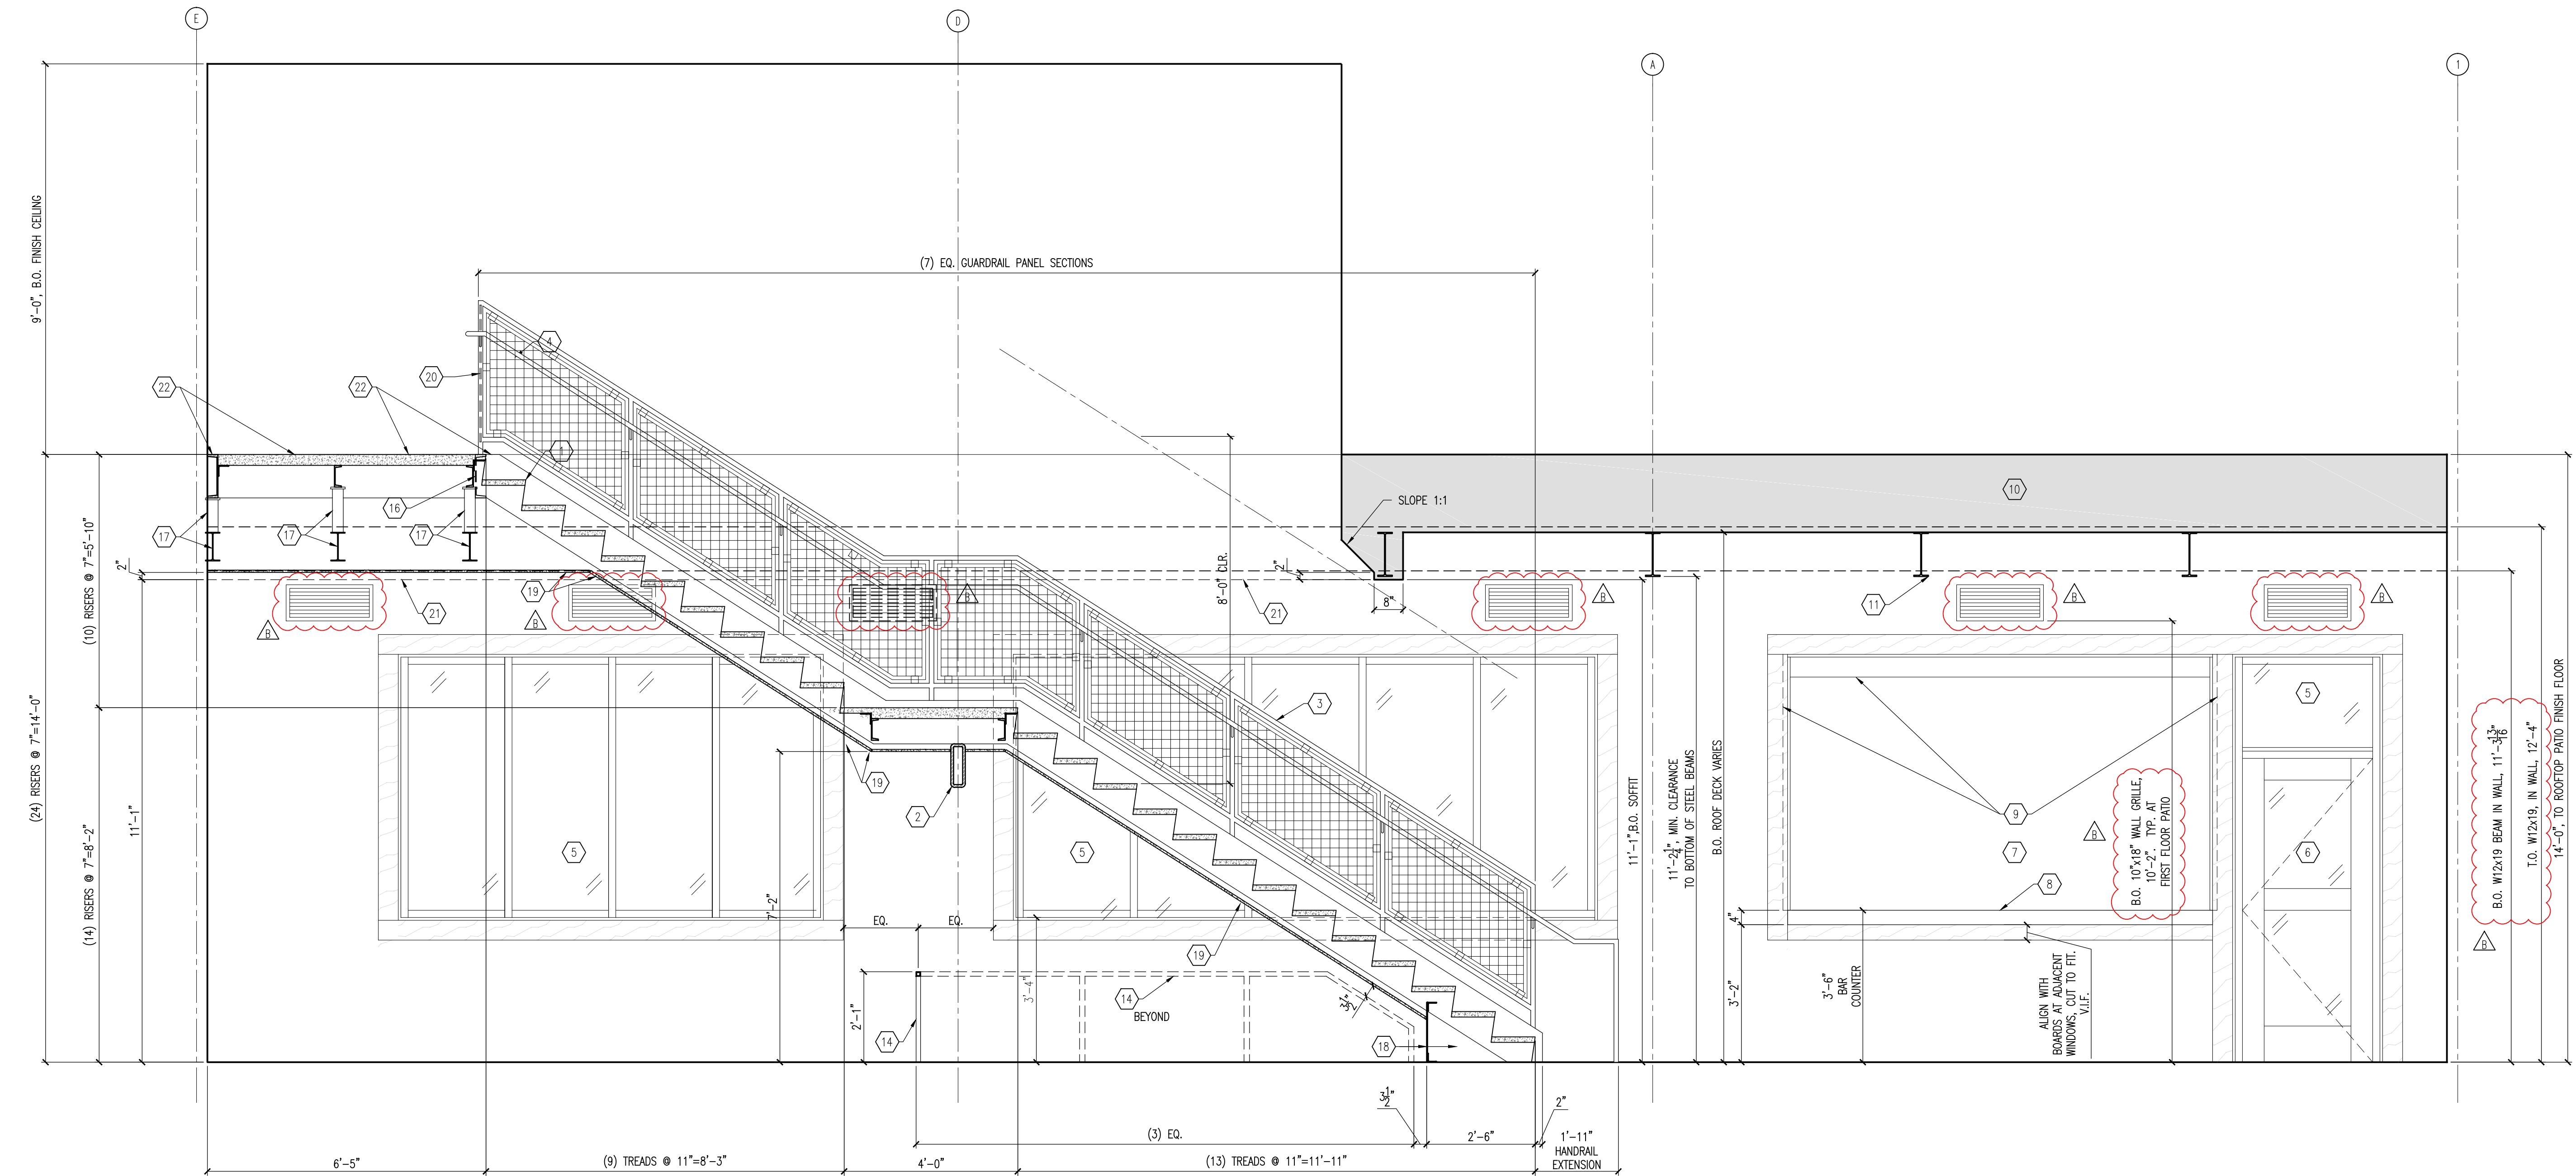


1 ENLARGED STAIR SECTION

A502 1/2"=1'-0"

REV	DESCRIPTION	DATE
1	B.D. SET	03-14-2022
2	CL. SHOP ENG. COORD. 1	03-14-2022
3	CL. SHOP ENG. COORD. 2	03-14-2022

Sheet Name: ENLARGED STAIRS	
Proj #: 211201	Issue Date: 03-14-2022
Sheet No.: A502	
Drawn By: KC	Checked By: KC/SA

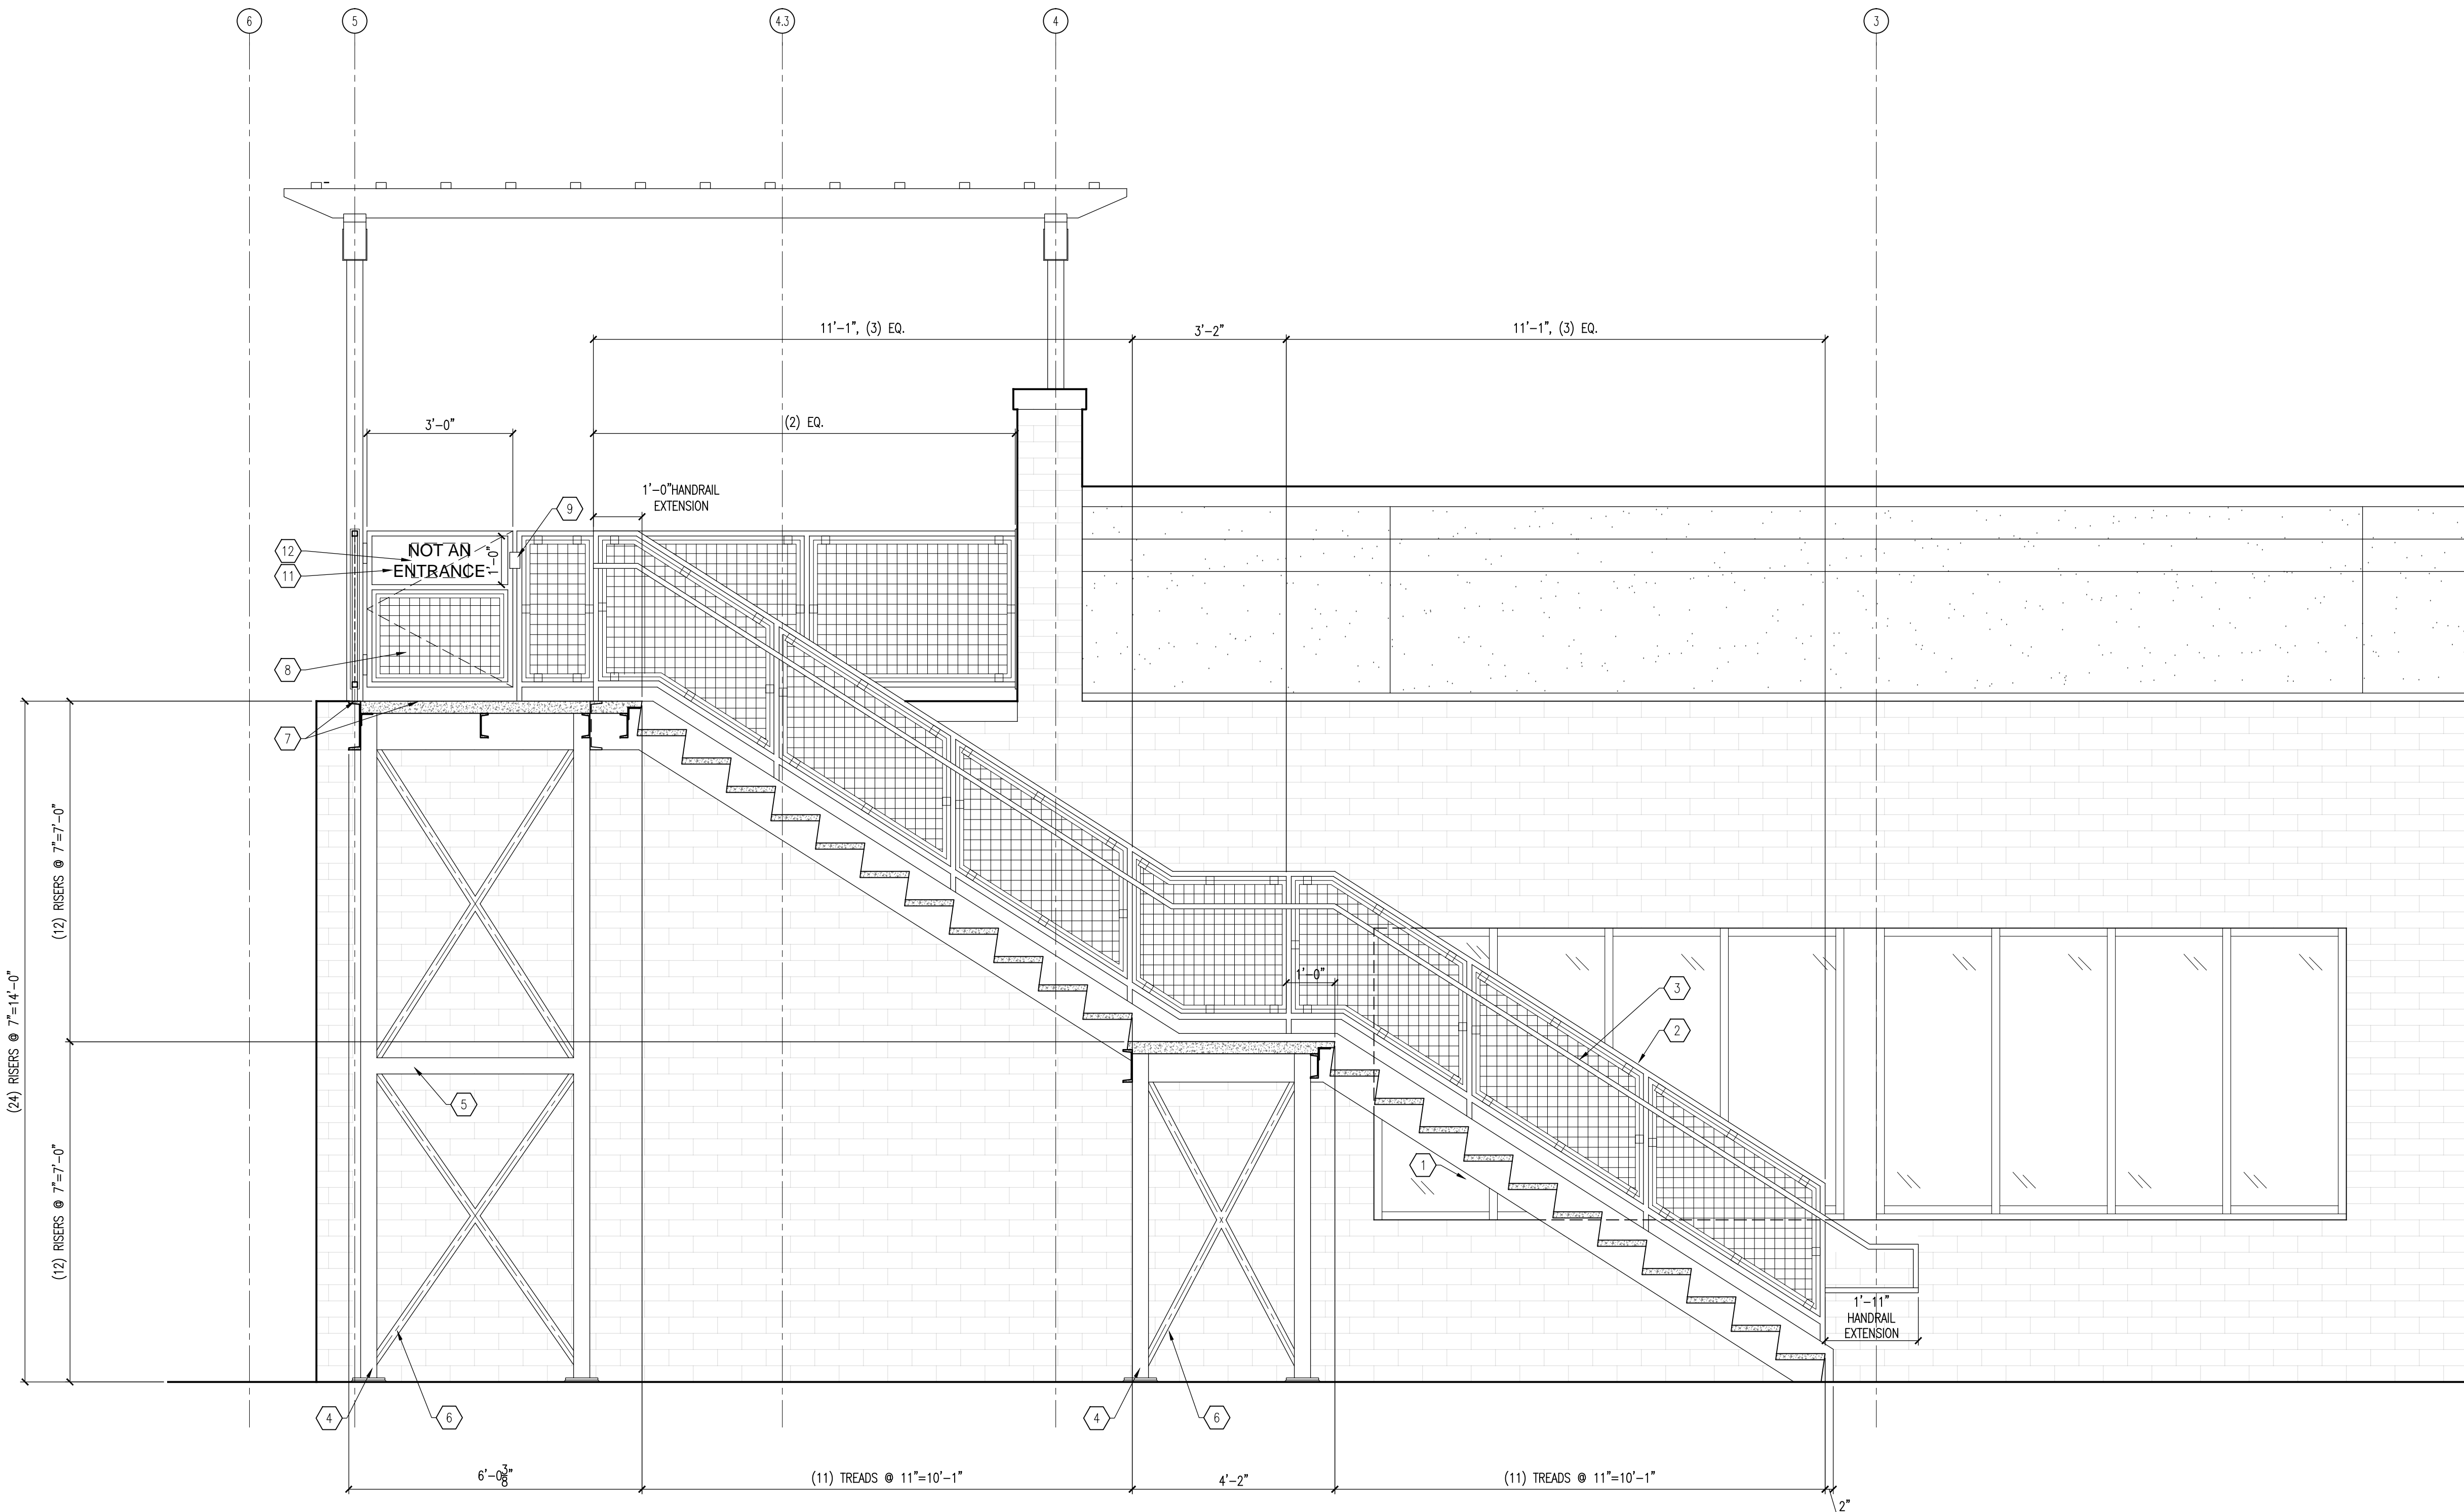

1 ENLARGED STAIR SECTION
A503 1/2"=1'-0"

GENERAL SHEET NOTES

1. SEE A501 FOR GENERAL SHEET NOTES.

STAIR DESIGN REQUIREMENTS

1. SEE A501 FOR STAIR DESIGN REQUIREMENTS.

KEYNOTES

1. STAIR CONSTRUCTION.
 - 1.1. CONCRETE FILLED STEEL PAN.
 - 1.2. PERIMETER CHANNEL FRAME. C12X20.7 (3"Wx12"D, NOMINAL) SHOWN (MIN.). FABRICATOR SHALL DESIGN FINAL STRUCTURAL SIZES AND REQUIREMENTS.
 - 1.3. STAIR SHALL BE SHOP PRIMED AND FIELD PAINTED.
2. FIXED GUARDRAIL ASSEMBLY. SEE 1.2&5/A510.
3. GUARDRAIL MOUNTED HANDRAIL ASSEMBLY. SEE 1.2,5,&6/A510.
4. 4"x4" STEEL POST AT LANDING SUPPORT (MIN.). TYP. OF (4) COLUMNS AT EACH LANDING.
 - 4.1. INSET COLUMNS TO INSIDE FACE OF CHANNEL STRINGER/FRAMING AS SHOWN.
 - 4.2. PROVIDE WITH 8"x8" BASE PLATE, THICKNESS AS REQUIRED.
 - 4.3. PROVIDE EACH BASE PLATE WITH (4) FASTENERS, SIZE AND TYPE AS REQUIRED.
5. 4x4 STEEL BEAMS, ALL SIDES OF LANDING SUPPORT (MIN.). COPE TO COLUMNS AND PROVIDE CONT. PERIMETER FILLET WELD, ALL FACES.
6. 2"x2" STEEL TUBE X-BRACING (MIN.). TYP. ALL SIDES OF LANDING SUPPORT.
 - 6.1. COPE THE INTERSECTION OF THE X-BRACING AND PROVIDE CONT. FILLET WELD AT ALL EDGES.
 - 6.2. PROVIDE CONT. FILLET WELD AT ALL JUNCTIONS WITH STEEL POSTS.
7. AT UPPER LANDING, HOLD TOP OF CHANNEL FRAME FLUSH WITH THE TOP OF THE CONCRETE. THIS IS TO ALIGN WITH THE FINISH FLOOR OF THE ROOFTOP PATIO.
8. SELF-CLOSING PATIO GATE.
9. MAGNETIC CATCH PLATE, NO LATCHING.
10. 1/8" STEEL PANEL INFILL, CENTERED ON THE PERIMETER TUBES, FOR EXIT SIGN AND BUILDING SIGNAGE MOUNTING.
11. 3/4" PAINTED LETTERS, CENTERED ON PANEL.
12. SELF-ILLUMINATING EXIT SIGN, OPPOSITE SIDE OF PANEL. CENTER ON PANEL.

BY	DATE
BD SET	03-14-2022
A	03-14-2022

NO.	DESCRIPTION	DATE
1	ENLARGED STAIRS	03-14-2022

Proj #:	211201	Issue Date:	03-14-2022
Sheet No.:	A503	Drawn By:	KC
		Checked By:	KC/SA

No.	Description	Date
1	ISSUED FOR PERMIT	03-14-2022
2	ISSUED FOR PERMIT	03-14-2022
3	ISSUED FOR PERMIT	03-14-2022
4	ISSUED FOR PERMIT	03-14-2022
5	ISSUED FOR PERMIT	03-14-2022
6	ISSUED FOR PERMIT	03-14-2022
7	ISSUED FOR PERMIT	03-14-2022
8	ISSUED FOR PERMIT	03-14-2022
9	ISSUED FOR PERMIT	03-14-2022
10	ISSUED FOR PERMIT	03-14-2022


Sheet Name: ENLARGED STAIRS	
Proj #: 211201	Issue Date: 03-14-2022
Sheet No.: A510	
Drawn By: KC	Checked By: KC/SA

GENERAL SHEET NOTES


- SEE A501 FOR GENERAL SHEET NOTES.
- NOTE: SIMPLIFIED GUARDRAIL PANELS THAT ELIMINATE THE FABRICATED OFFSET BRACKETS AND WELL THE INFL PANEL DIRECTLY TO THE STEEL TUBES SHALL BE ACCEPTABLE. EXPAND INFL PANEL SIZE, DO NOT CHANGE GUARDRAIL TUBE LOCATIONS.

STAIR DESIGN REQUIREMENTS

- SEE A501 FOR STAIR DESIGN REQUIREMENTS.

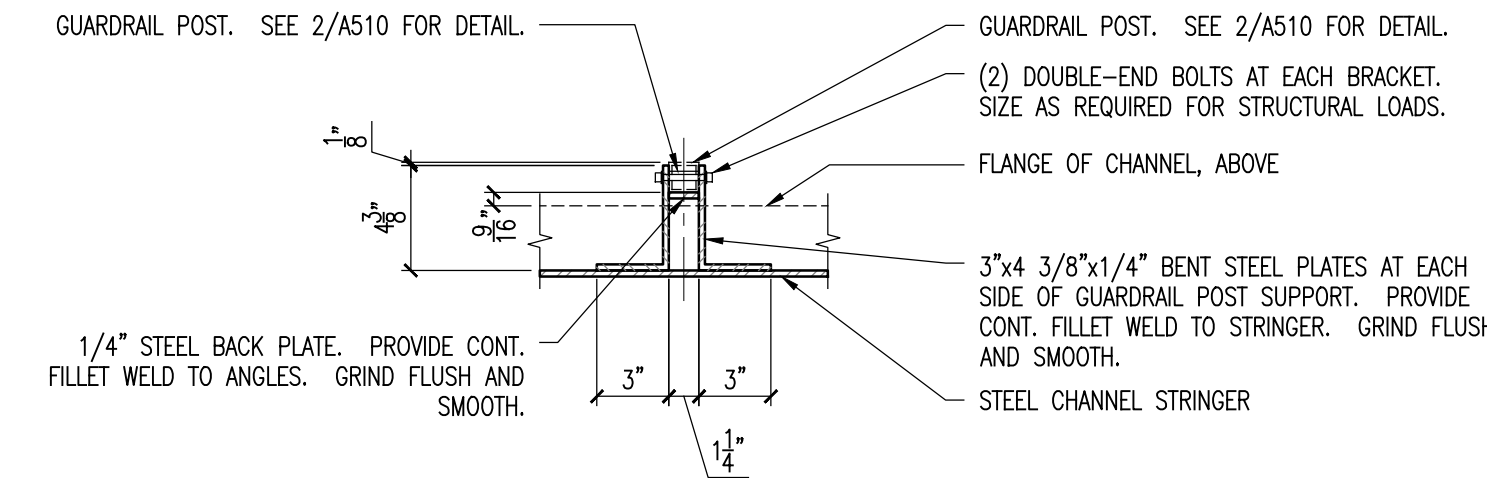


BRACKET PLAN

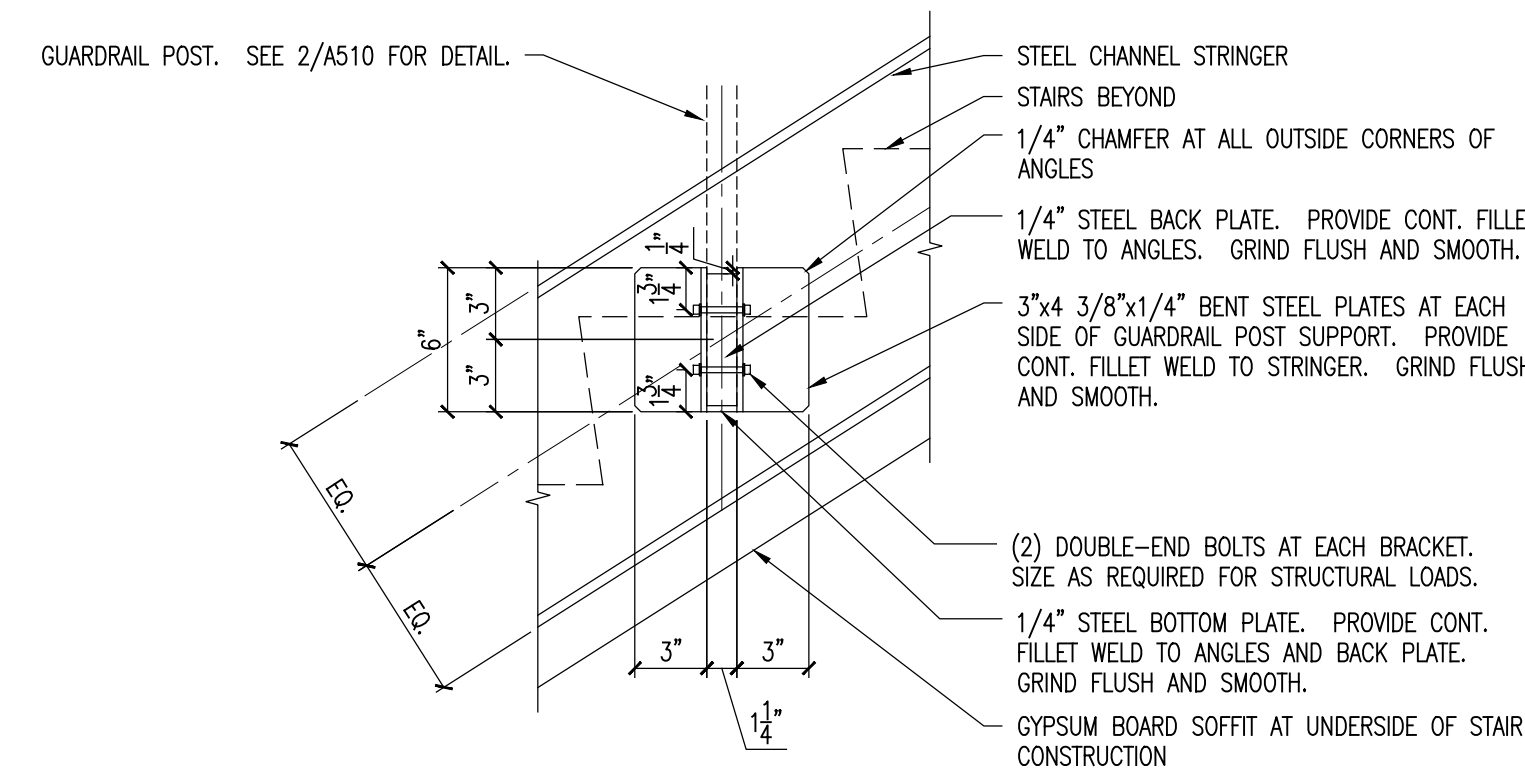

BRACKET ELEVATION


TYPICAL INTERIOR STAIR GUARDRAIL POST MOUNTING BRACKET DETAIL

A510 1 1/2"=1'-0"

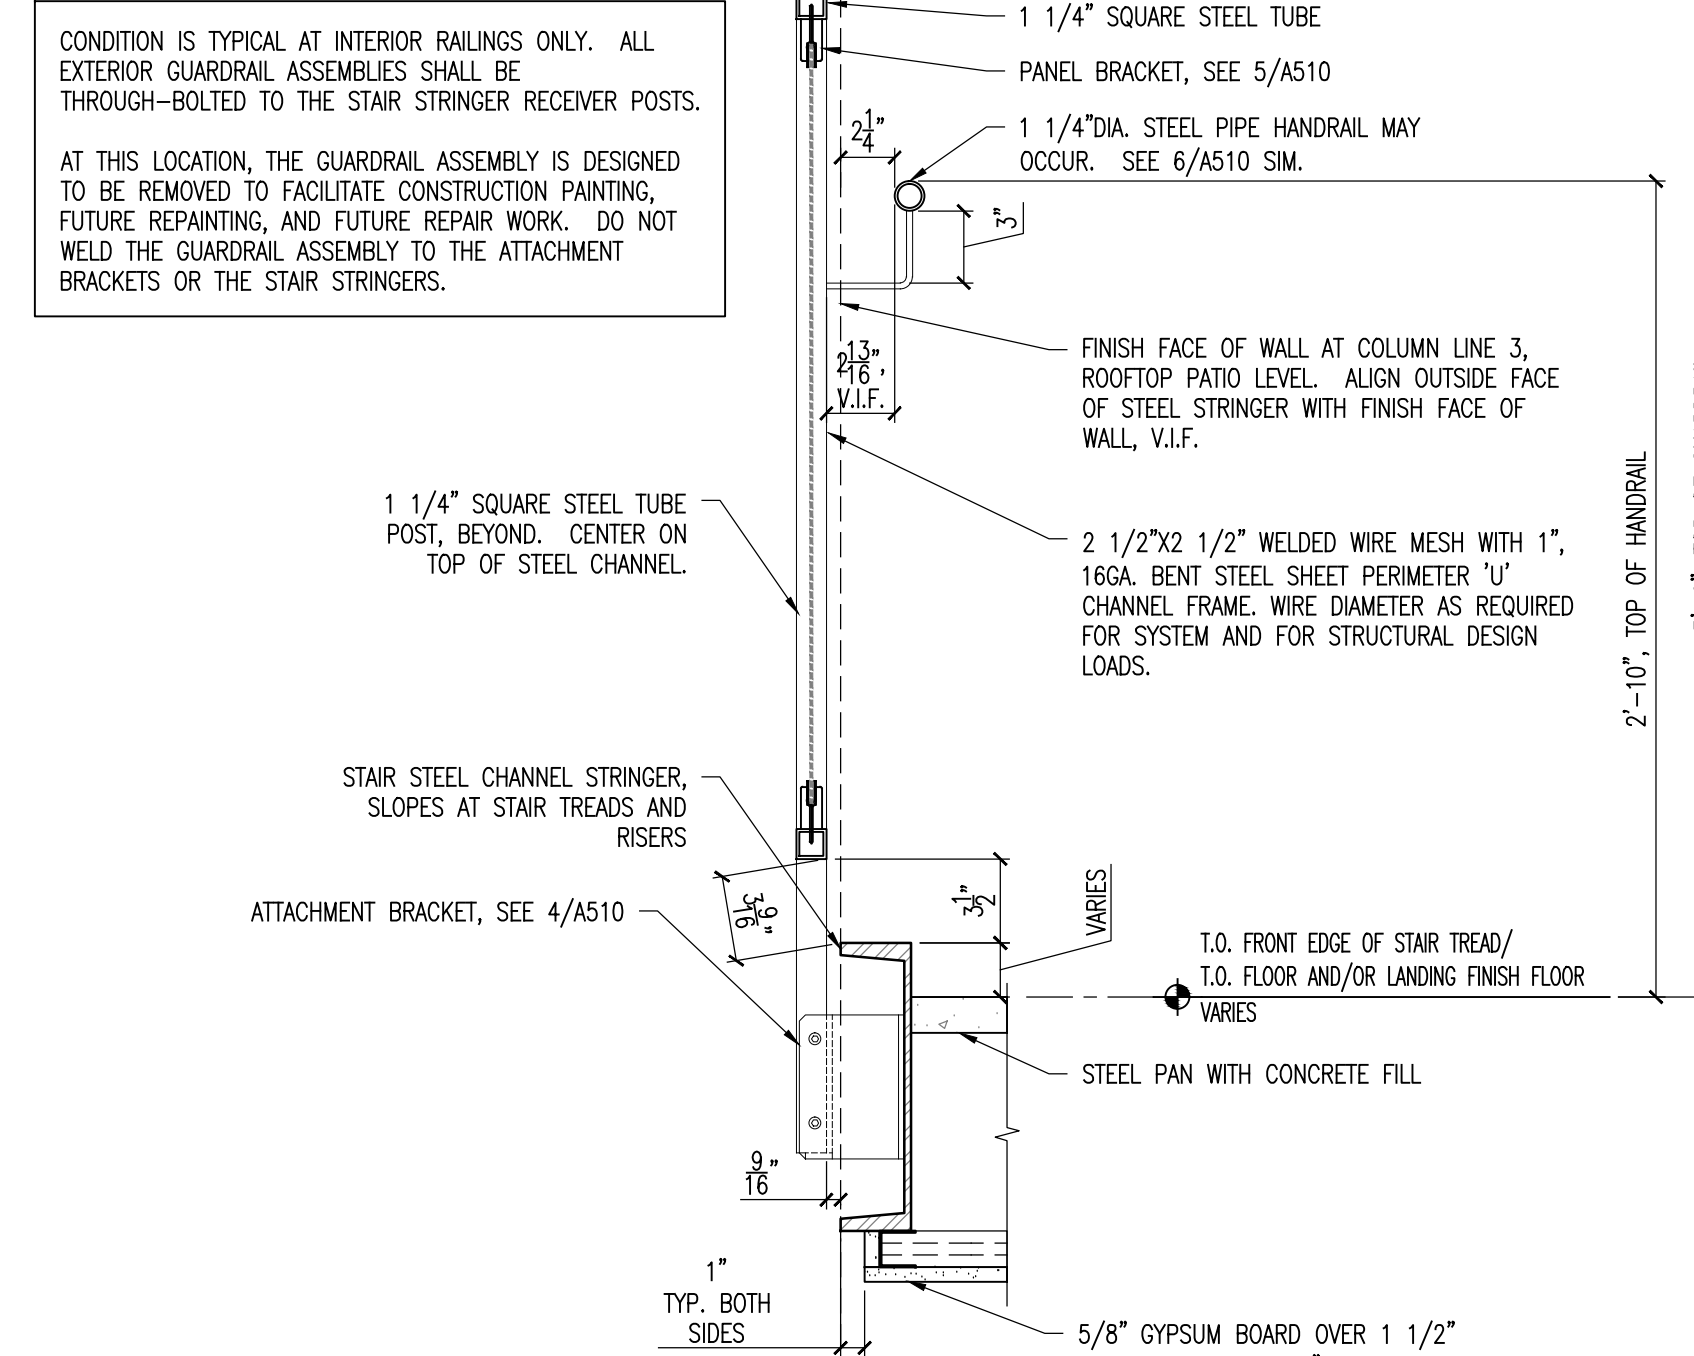


TYPICAL INTERIOR GUARDRAIL SECTION

A510 1 1/2"=1'-0"

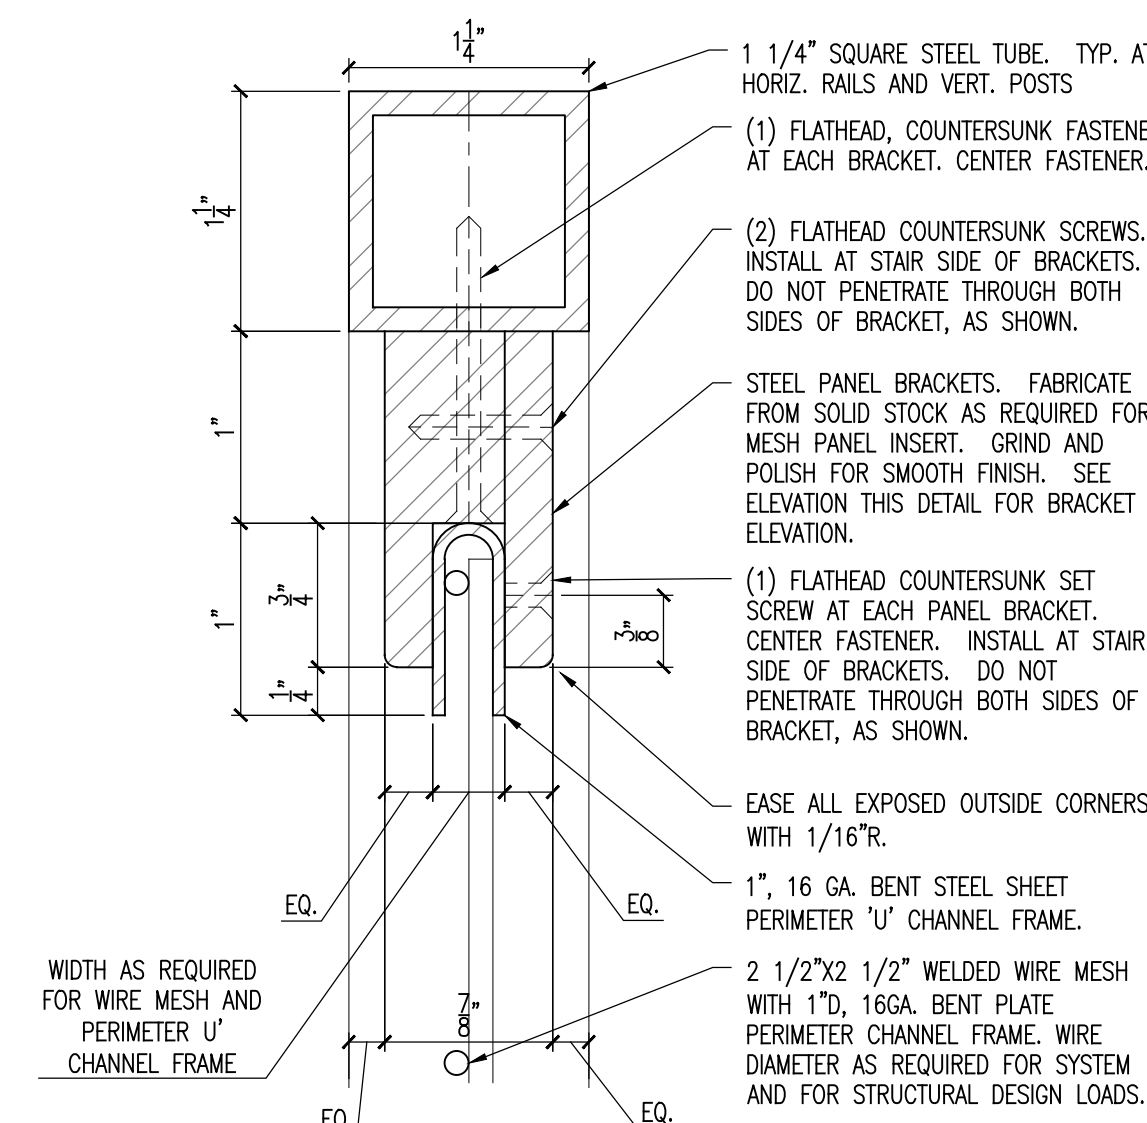


PANEL BRACKET SECTION

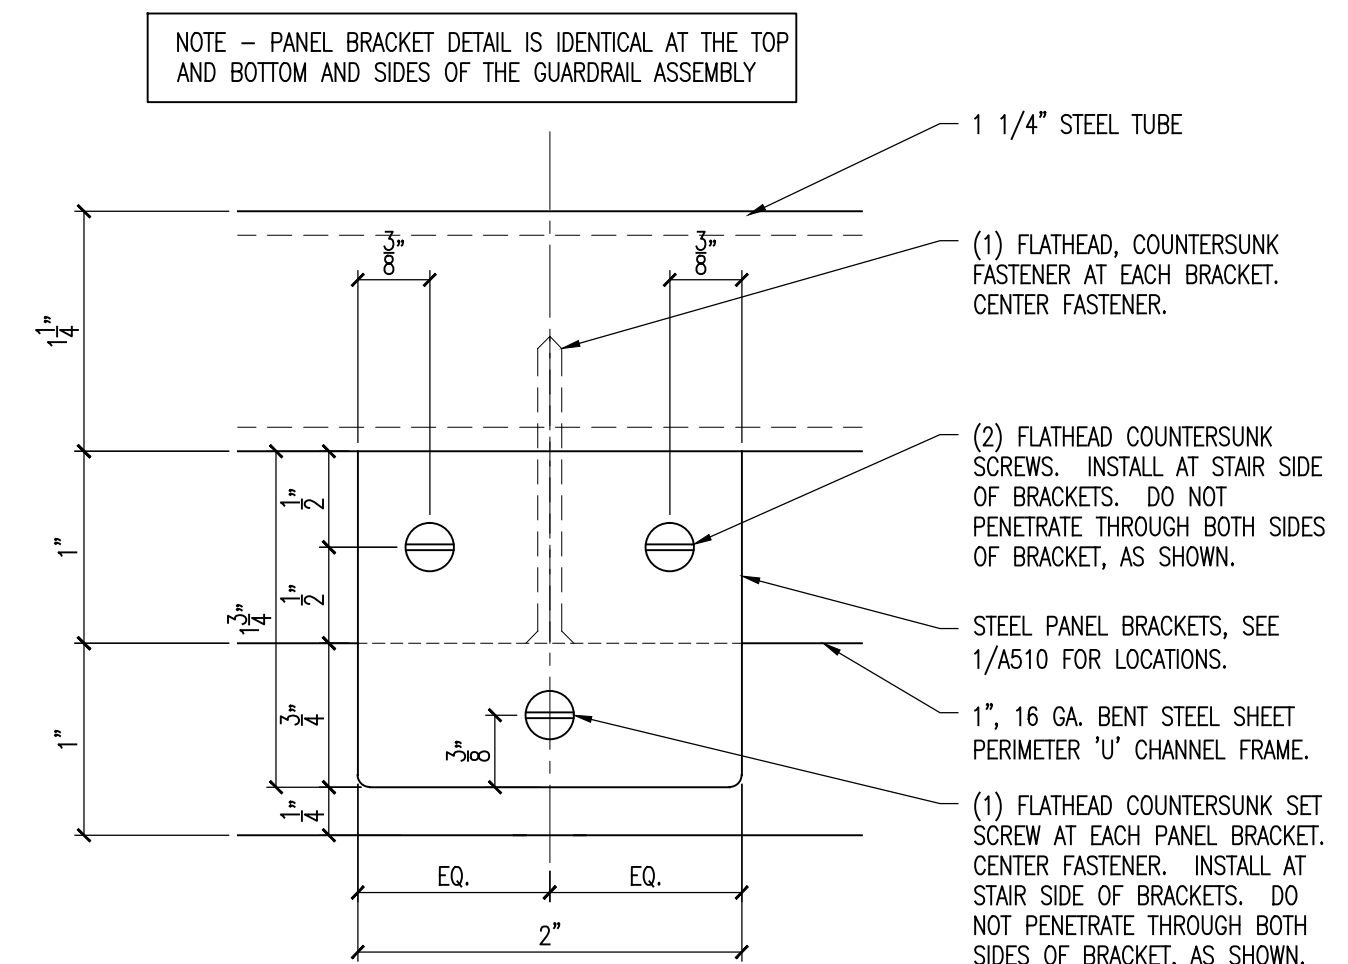

PANEL BRACKET ELEVATION


TYPICAL GUARDRAIL PANEL BRACKET DETAIL

A510 1'-0"=1'-0"

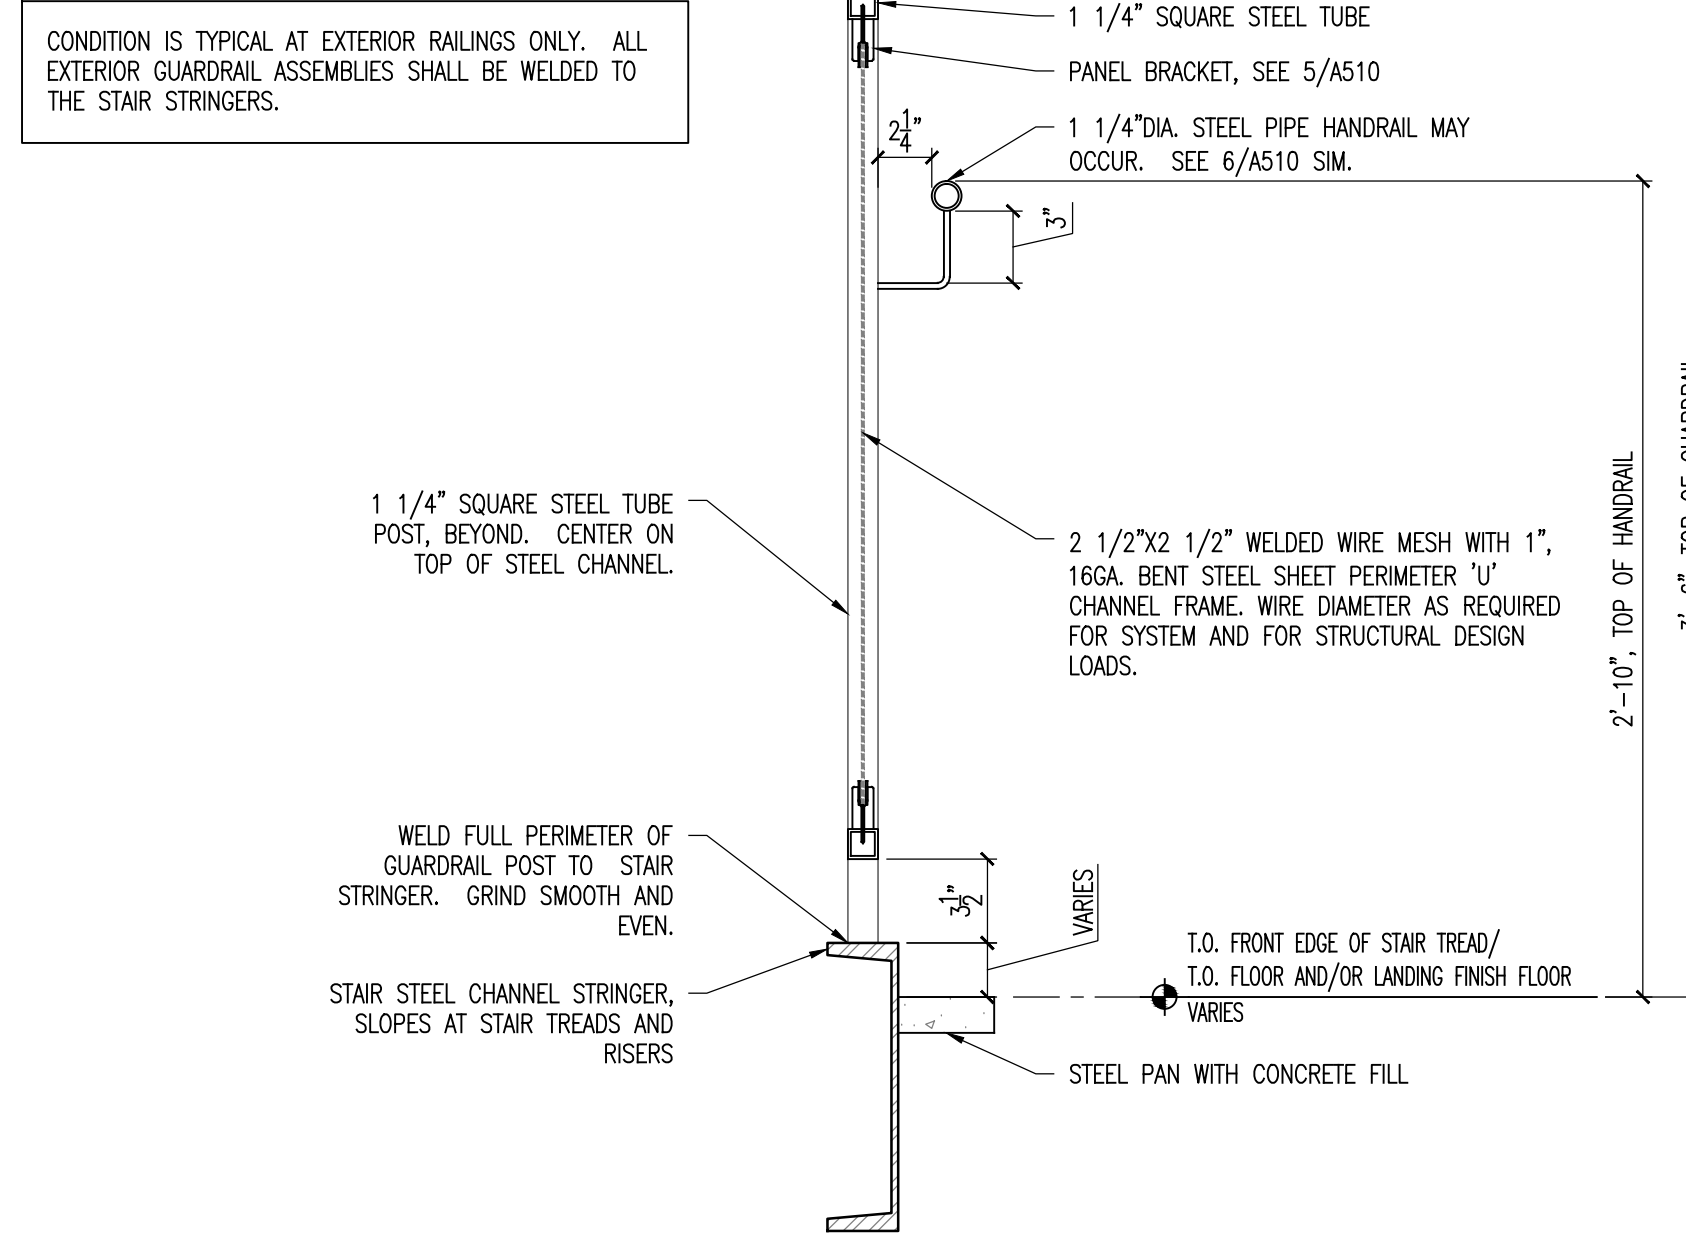


TYPICAL EXTERIOR GUARDRAIL SECTION

A510 1 1/2"=1'-0"

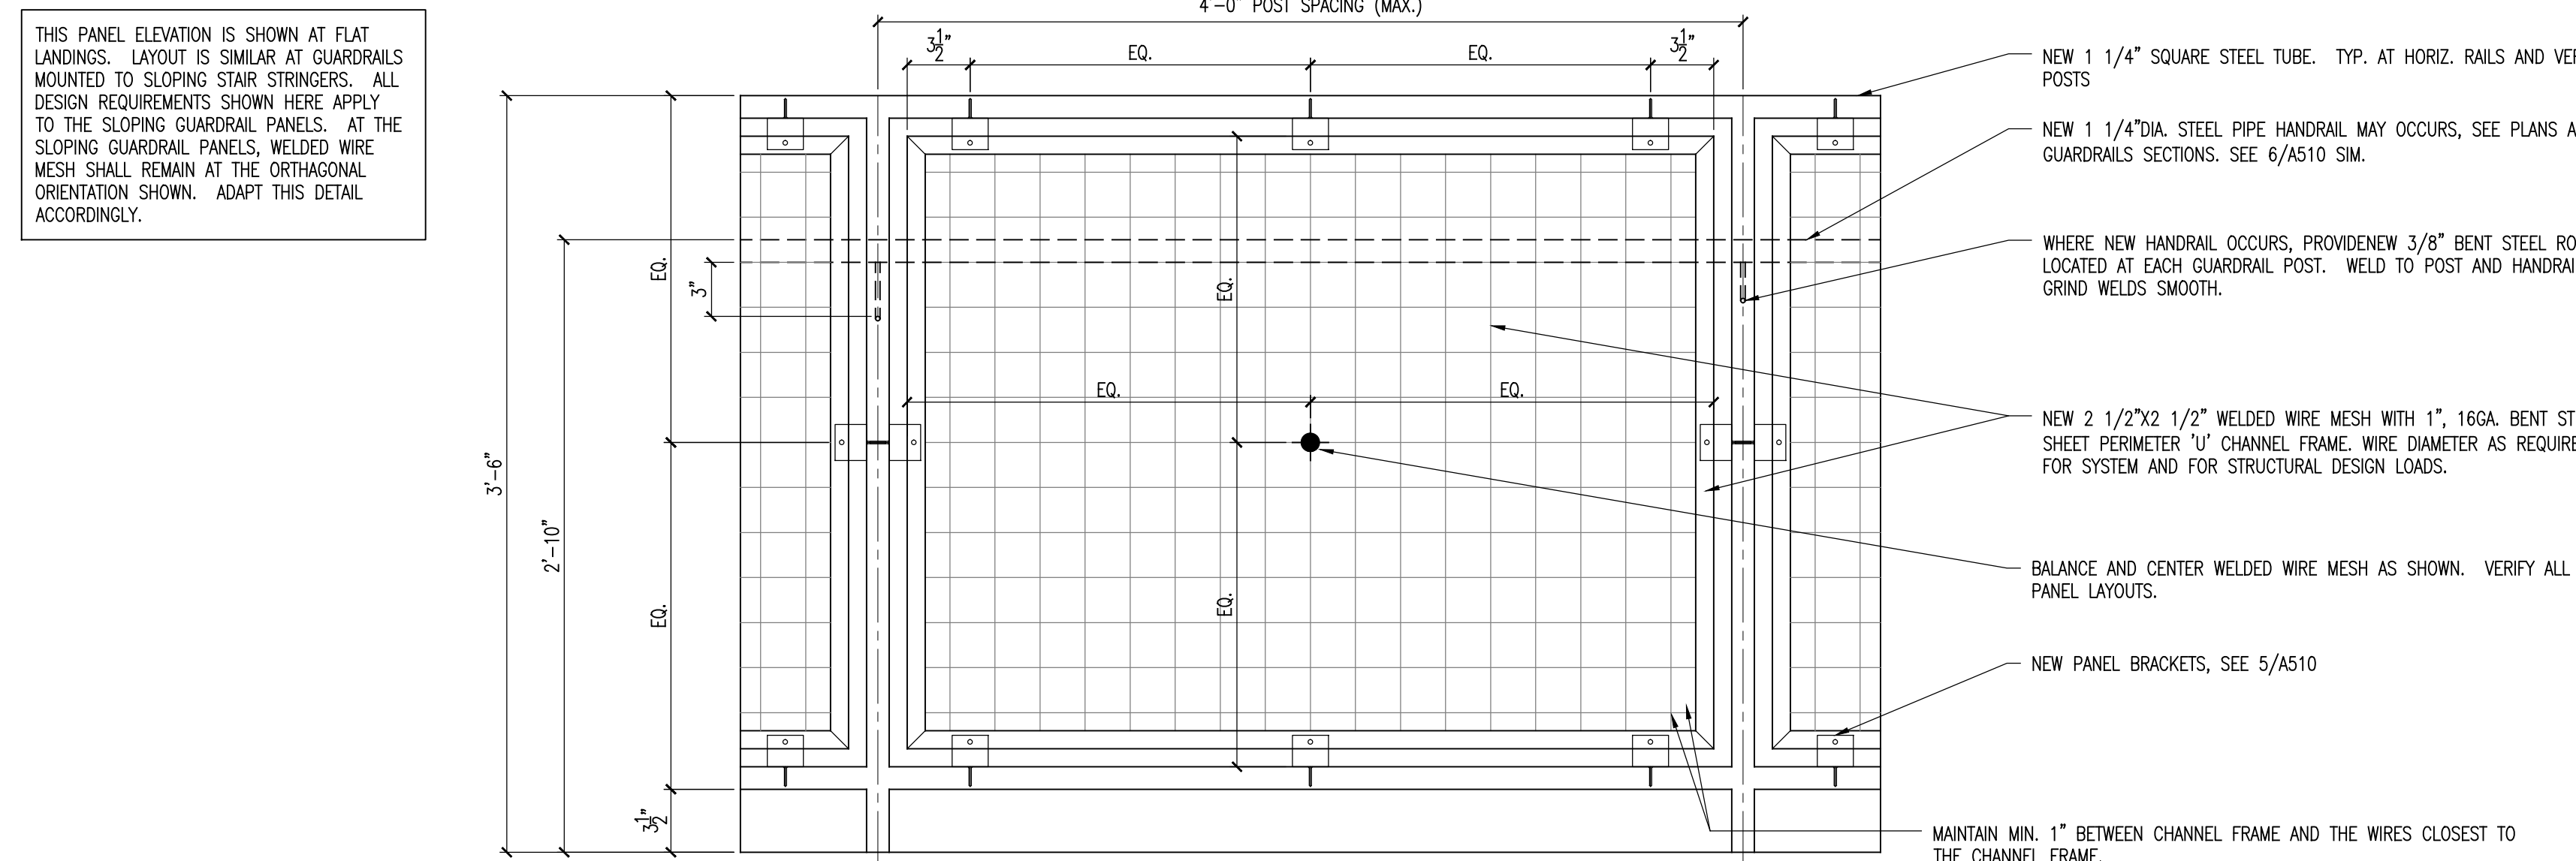

TYPICAL GUARDRAIL PANEL ELEVATION


A510 1 1/2"=1'-0"

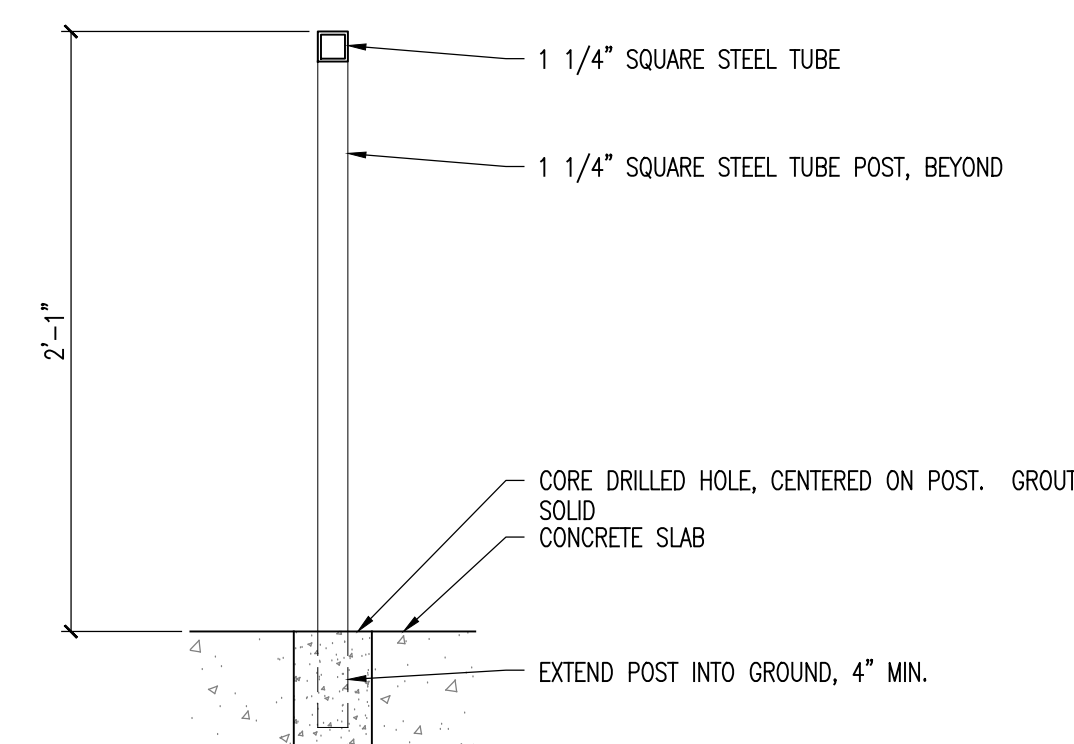


BARRIER RAILING DETAIL

A510 1 1/2"=1'-0"


- NOTES:
- HANDRAILS MOUNTED TO GUARDRAIL ARE SIM. TO THIS DETAIL. OMIT WALL PLATE, WALL FASTENERS, AND SNAP-ON FINISH COVER. WELD ROD DIRECTLY TO GUARDRAIL POSTS GRIND WELDS SMOOTH.
 - HANDRAIL BRACKETS SHALL HAVE A MAXIMUM SPACING OF 4'-0". ALIGN WALL MOUNTED HANDRAIL BRACKETS WITH HANDRAIL BRACKETS ATTACHED TO THE GUARDRAIL AT THE OPPOSITE SIDE OF THE STAIR RUN.
 - CONTRACTOR SHALL PROVIDE ALL REQUIRED SUPPORT, BLOCKING, EXPANSION ANCHORS, ETC. AS REQUIRED TO PROPERLY SUPPORT HANDRAIL ANCHOR PLATE AT WALL CONSTRUCTION. ALL MEANS OF SUPPORT SHALL BE CONCEALED WITHIN THE WALL CONSTRUCTION. COORDINATE WITH THE RAILING FABRICATOR.

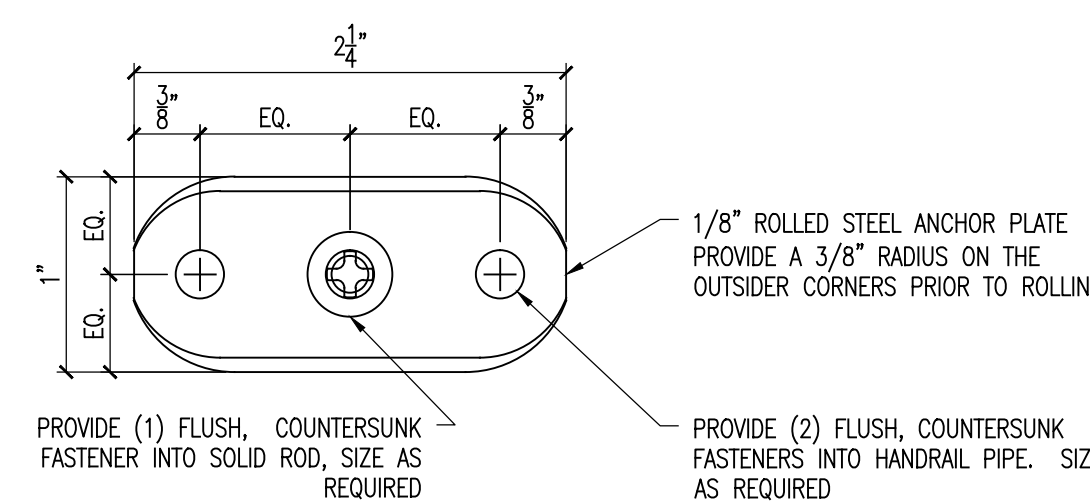

WALL MOUNTED ANCHOR PLATE PLAN

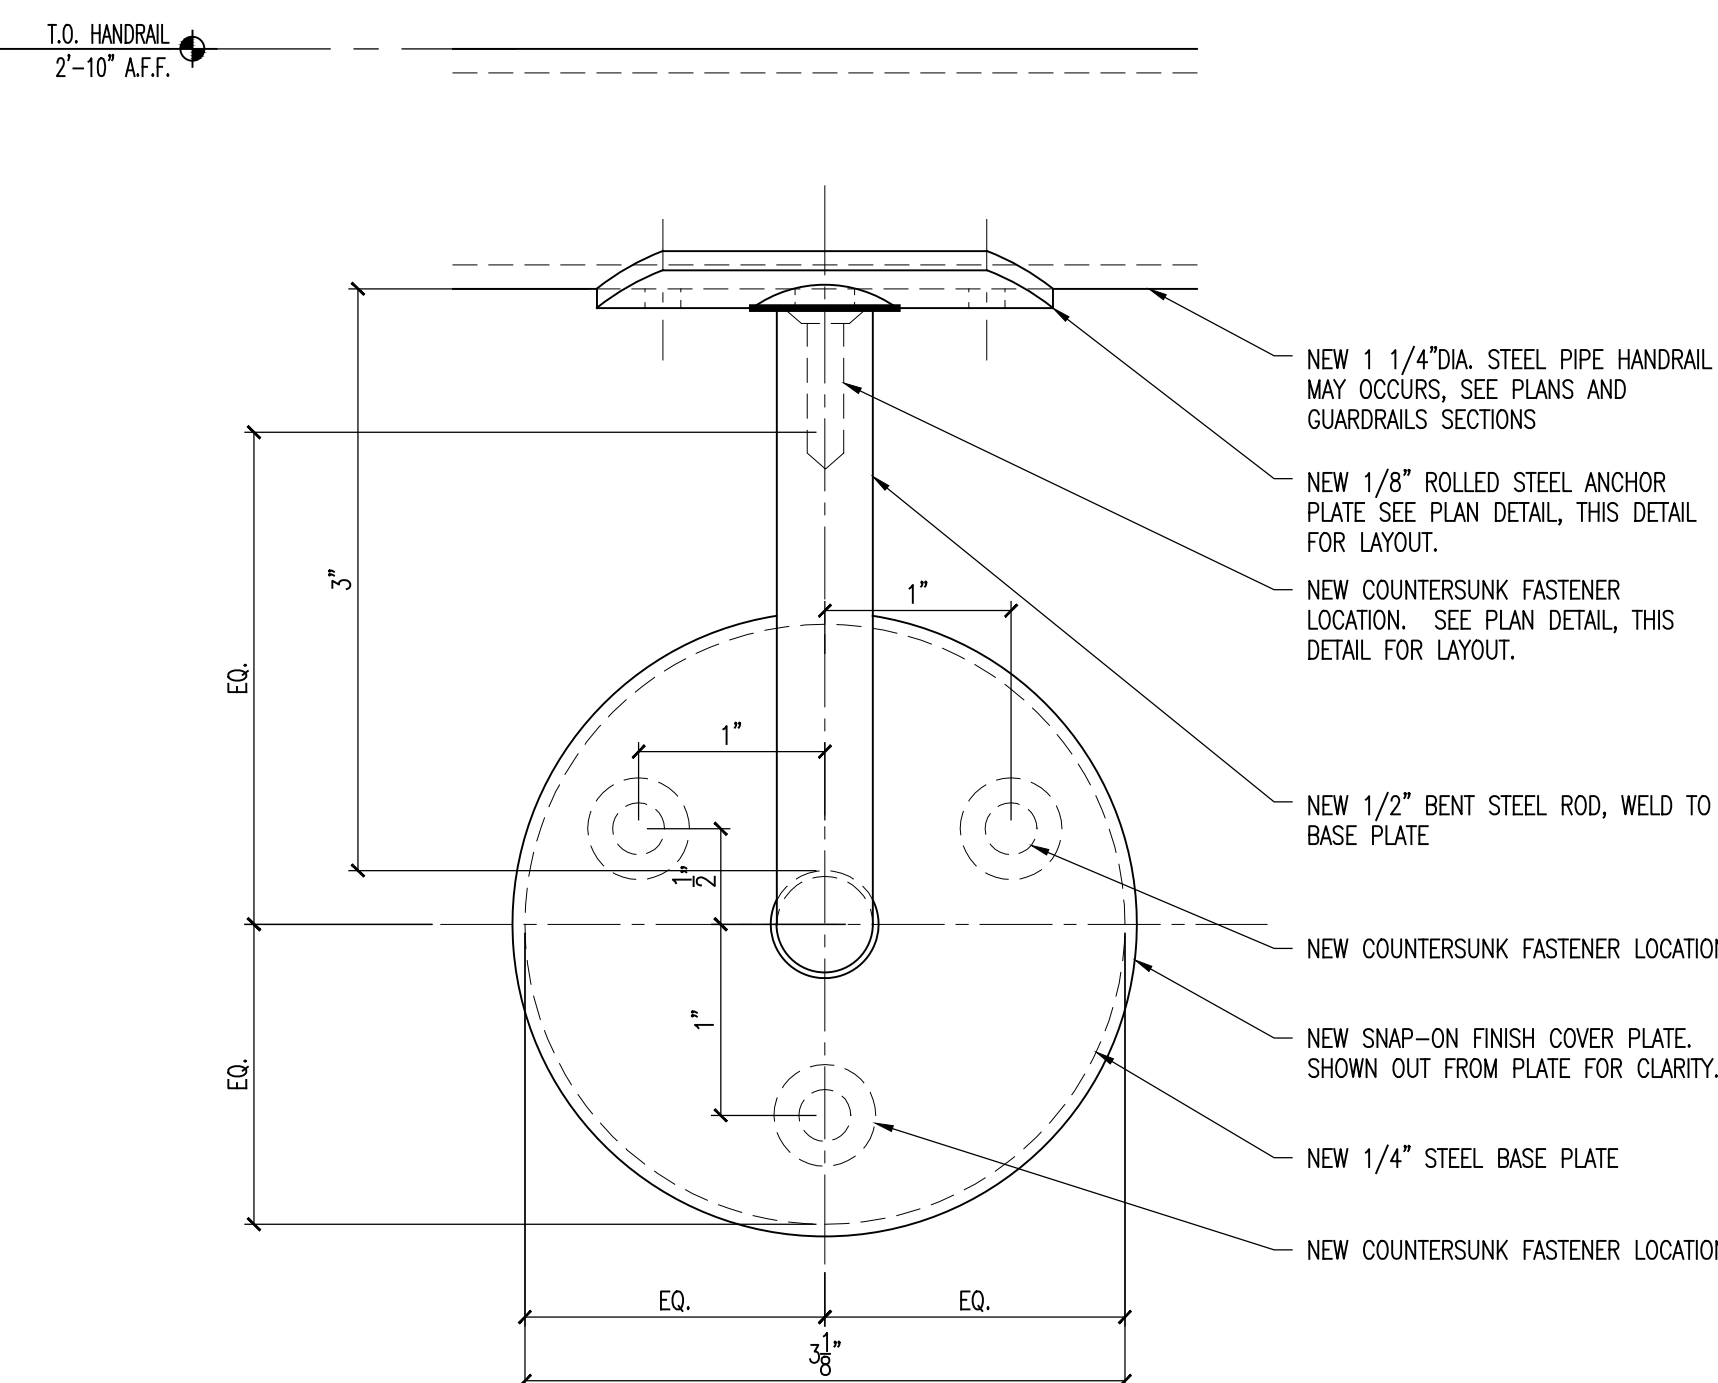


WALL MOUNTED HANDRAIL ELEVATION

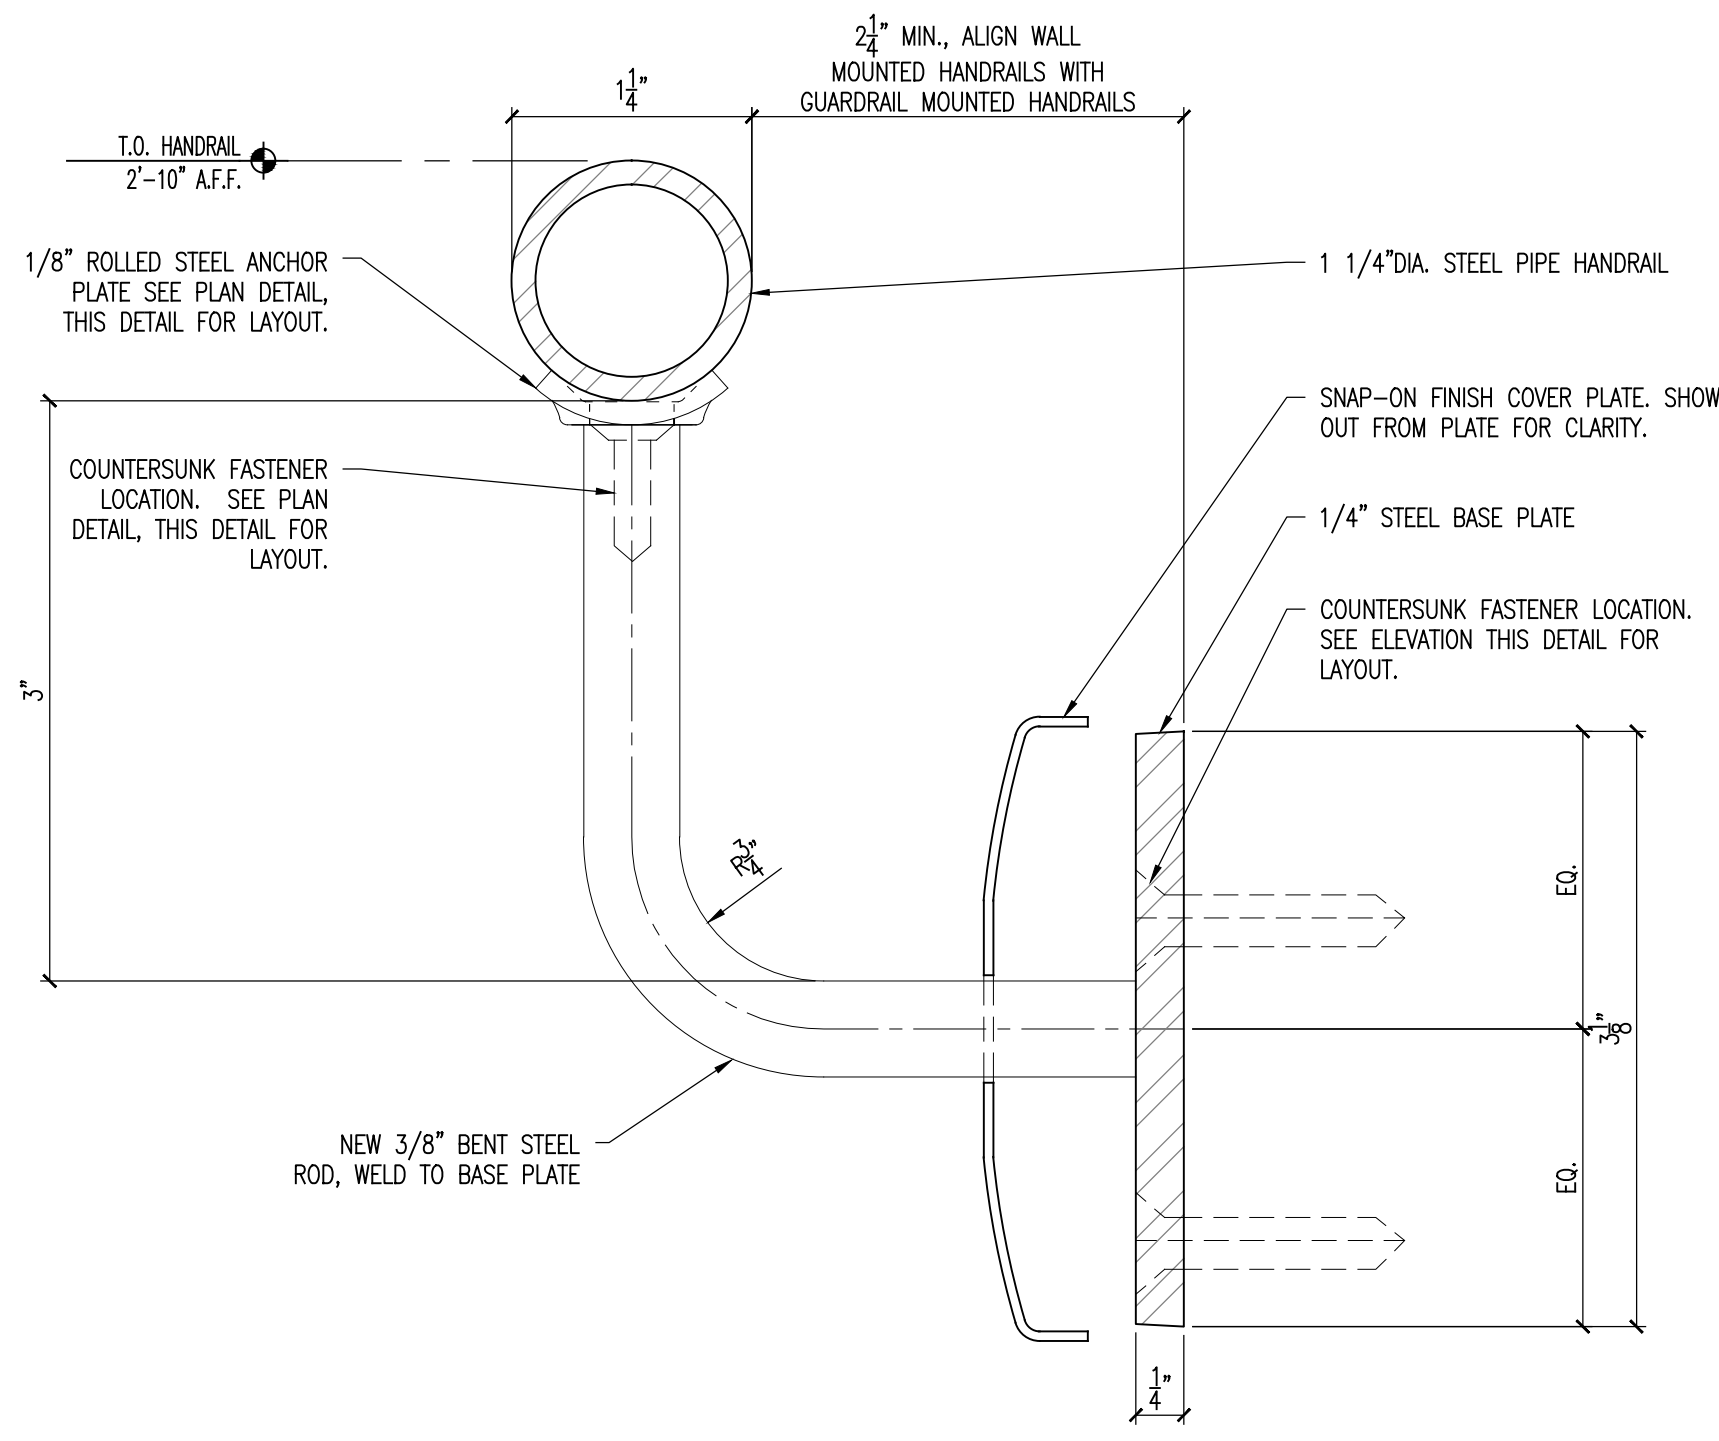

WALL MOUNTED HANDRAIL SECTION

TYPICAL WALL MOUNTED HANDRAIL DETAILS

A510 1'-0"=1'-0"

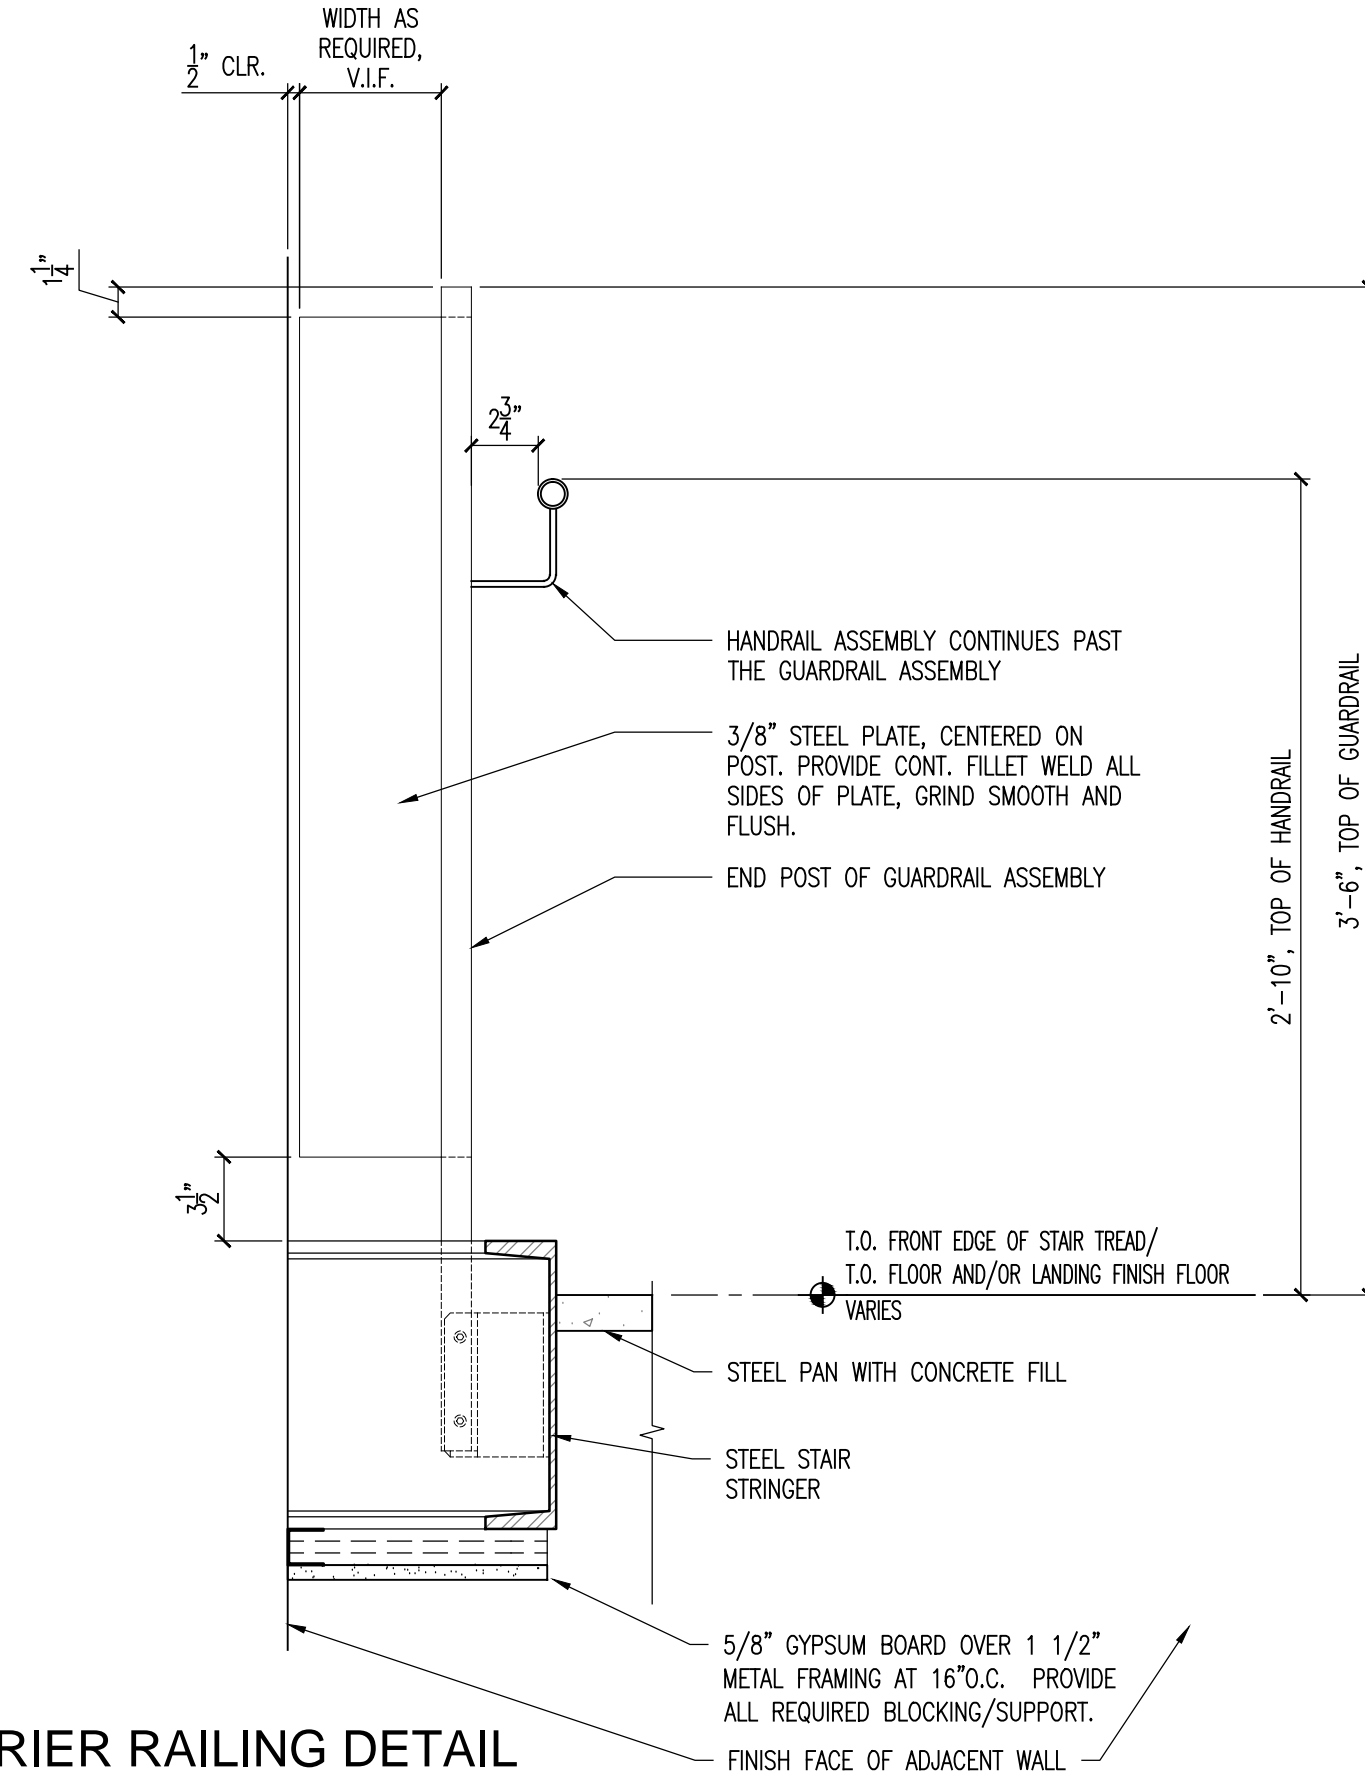

BARRIER RAILING DETAIL

A510 1 1/2"=1'-0"

1. NOT ALL ITEMS MAY BE USED.
2. DIMENSIONS ARE TAKEN TO FACE OF STUD, FACE OF MASONRY OR CONCRETE, OR COLUMN CENTERLINE, UNLESS INDICATED OTHERWISE.
3. CONTRACTOR SHALL COORDINATE STUD FRAMING LAYOUT TO ENSURE PROPER SUPPORT FOR ALL WALL MOUNTED ITEMS AND FINISHES. PROVIDE FIRE RETARDANT TREATED WOOD BLOCKING AS REQUIRED, CONCEALED IN WALL CONSTRUCTION.



3'-1'-0




3'-1'-0














3'-1'-C



3'-1'-0'

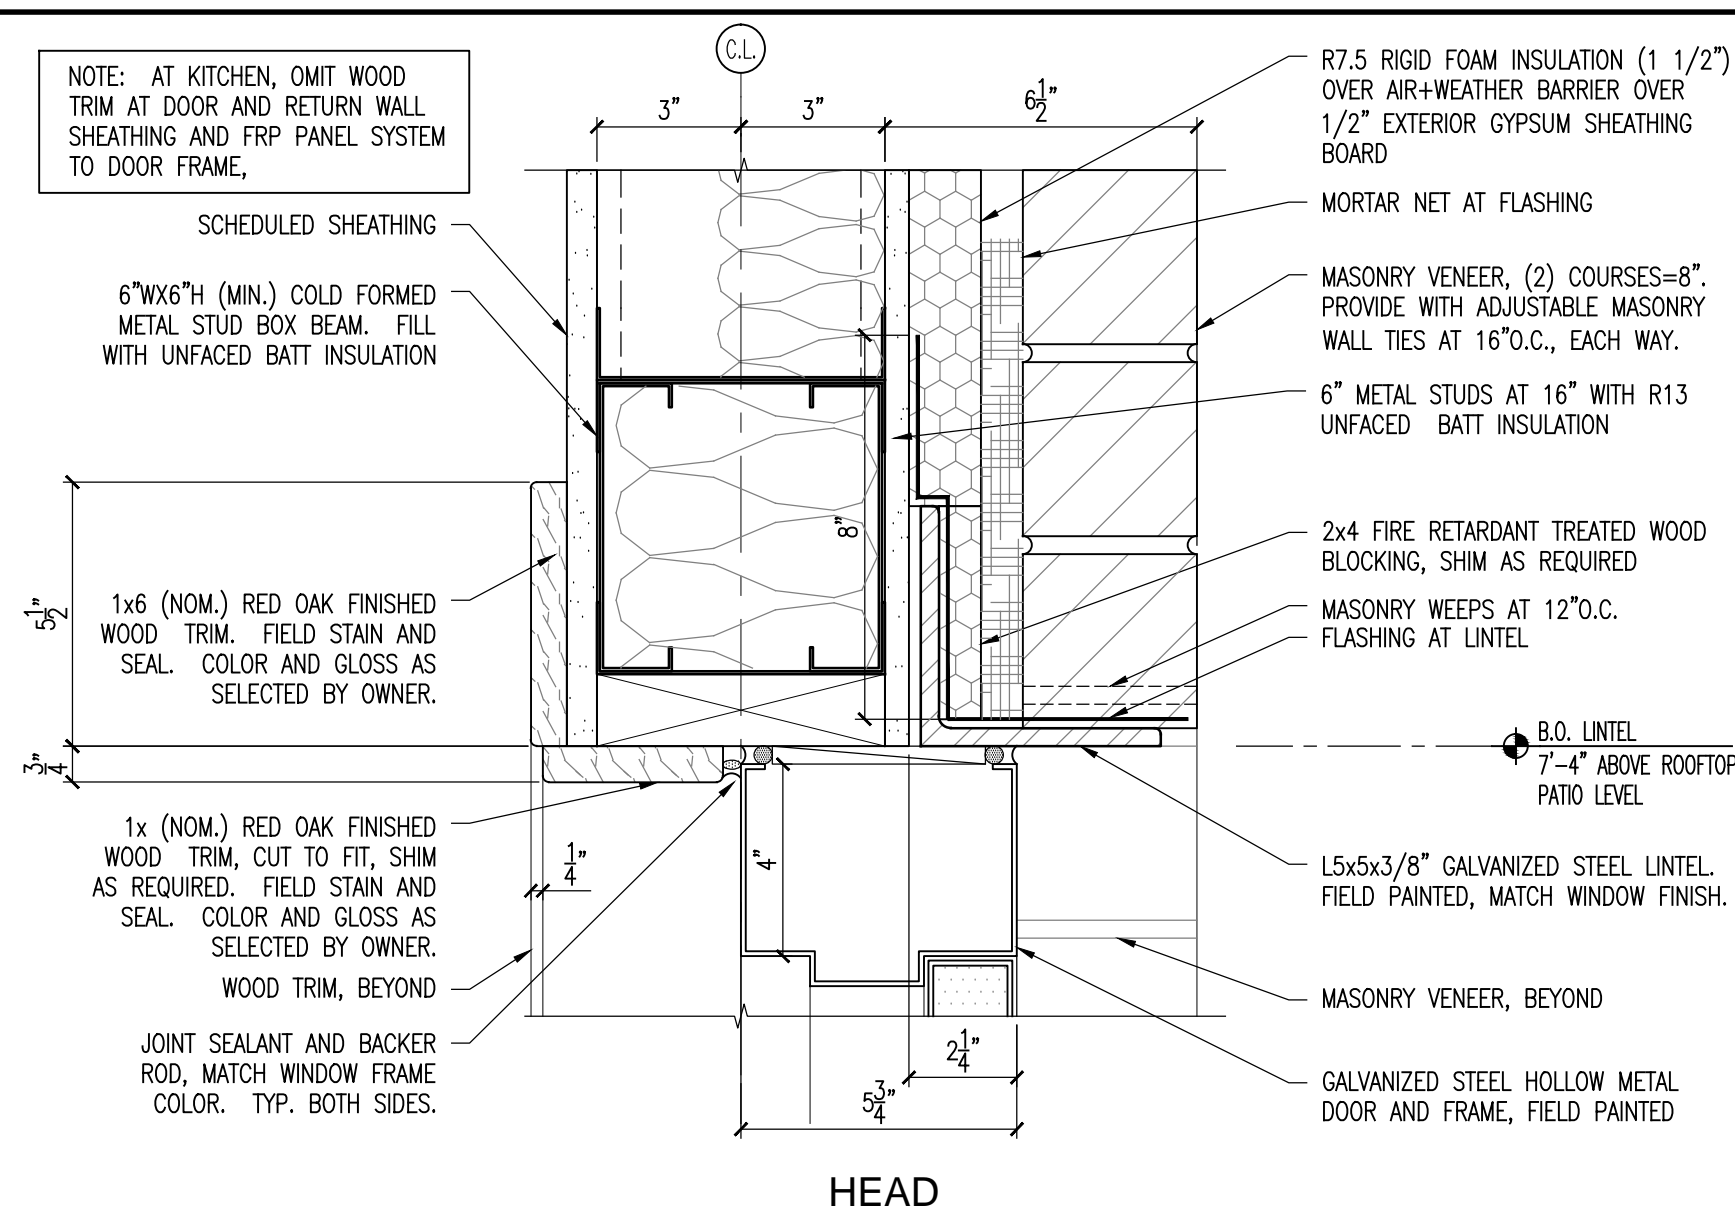

4 EXTERIOR HOLLOW METAL DOOR DETAILS AT MASONRY

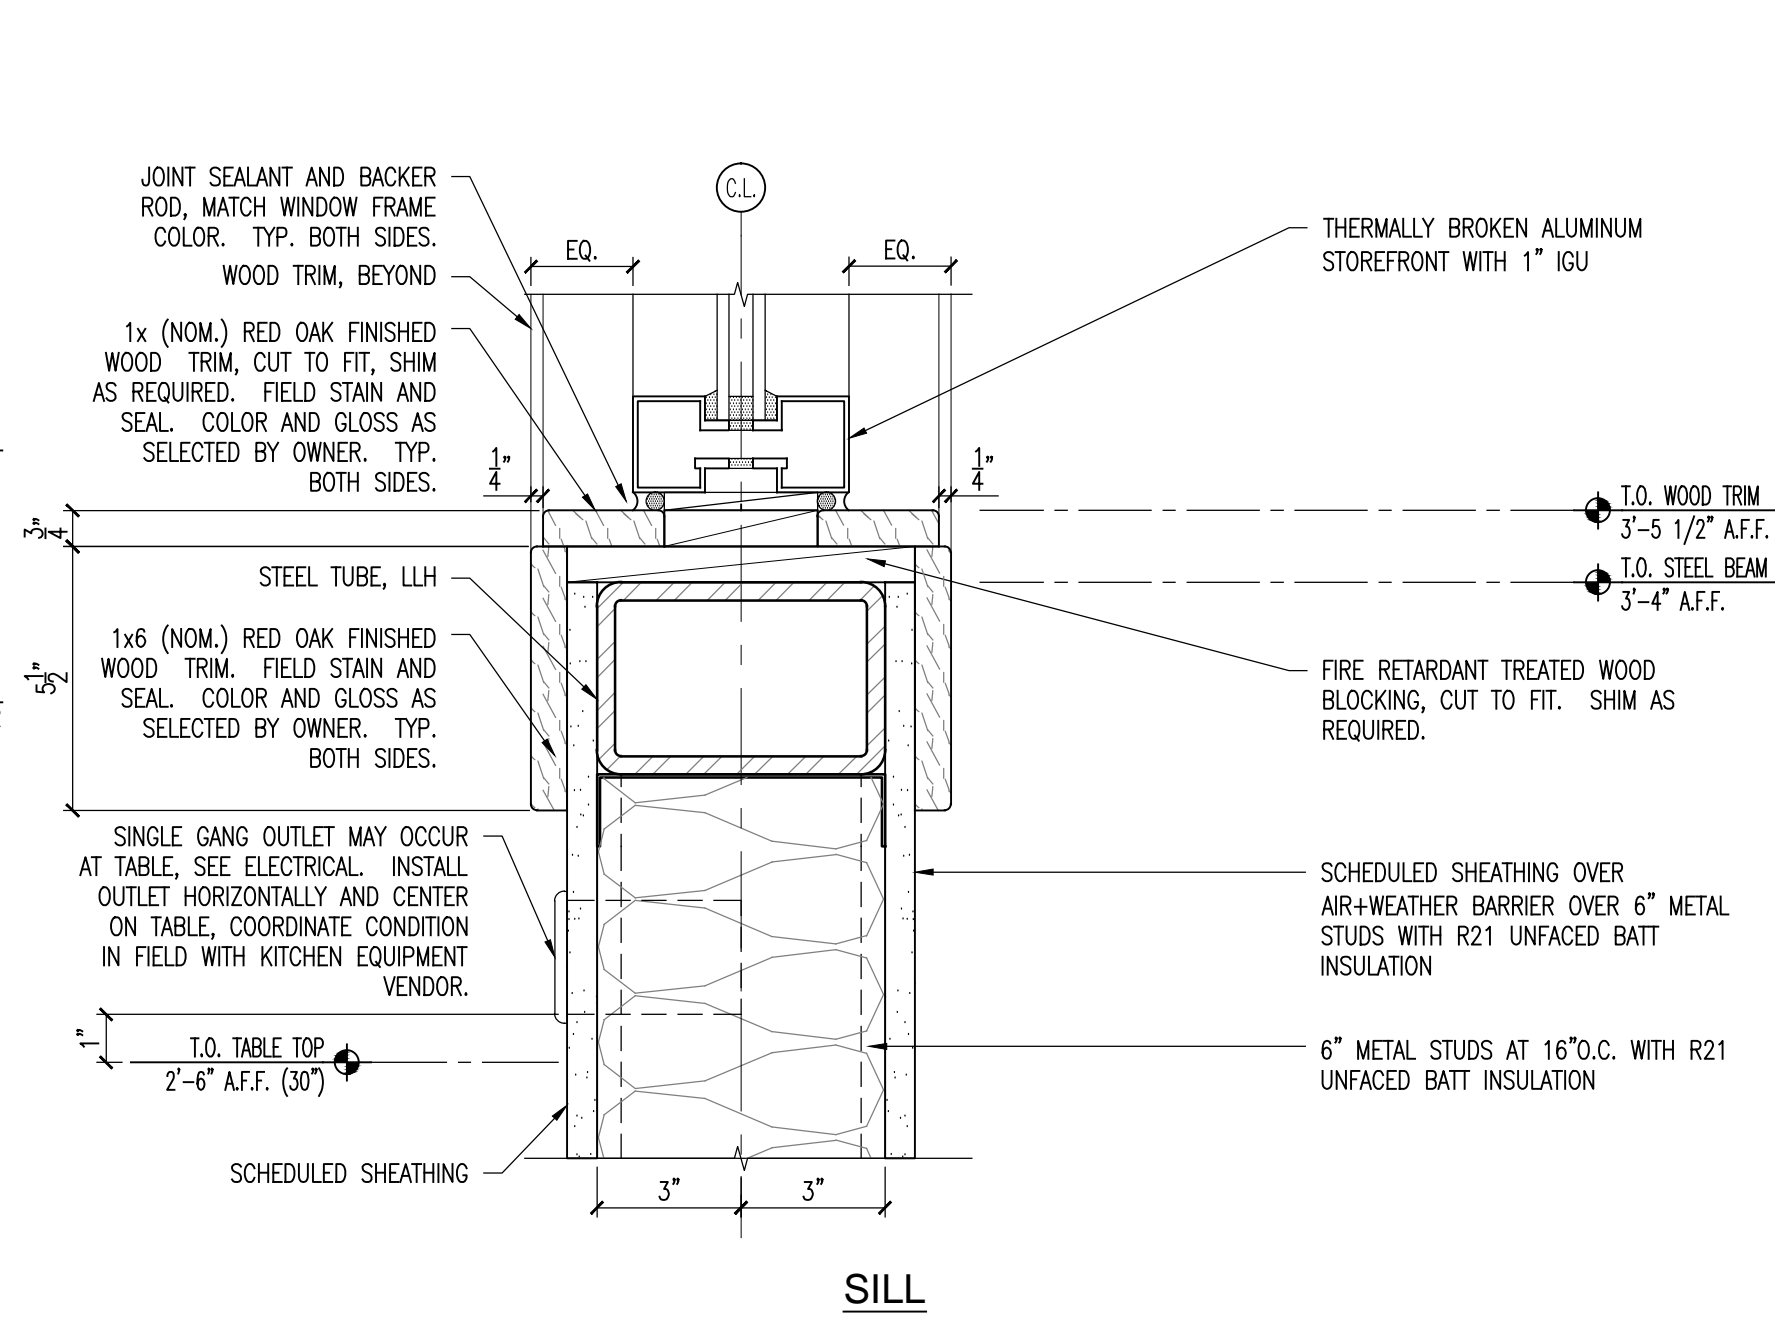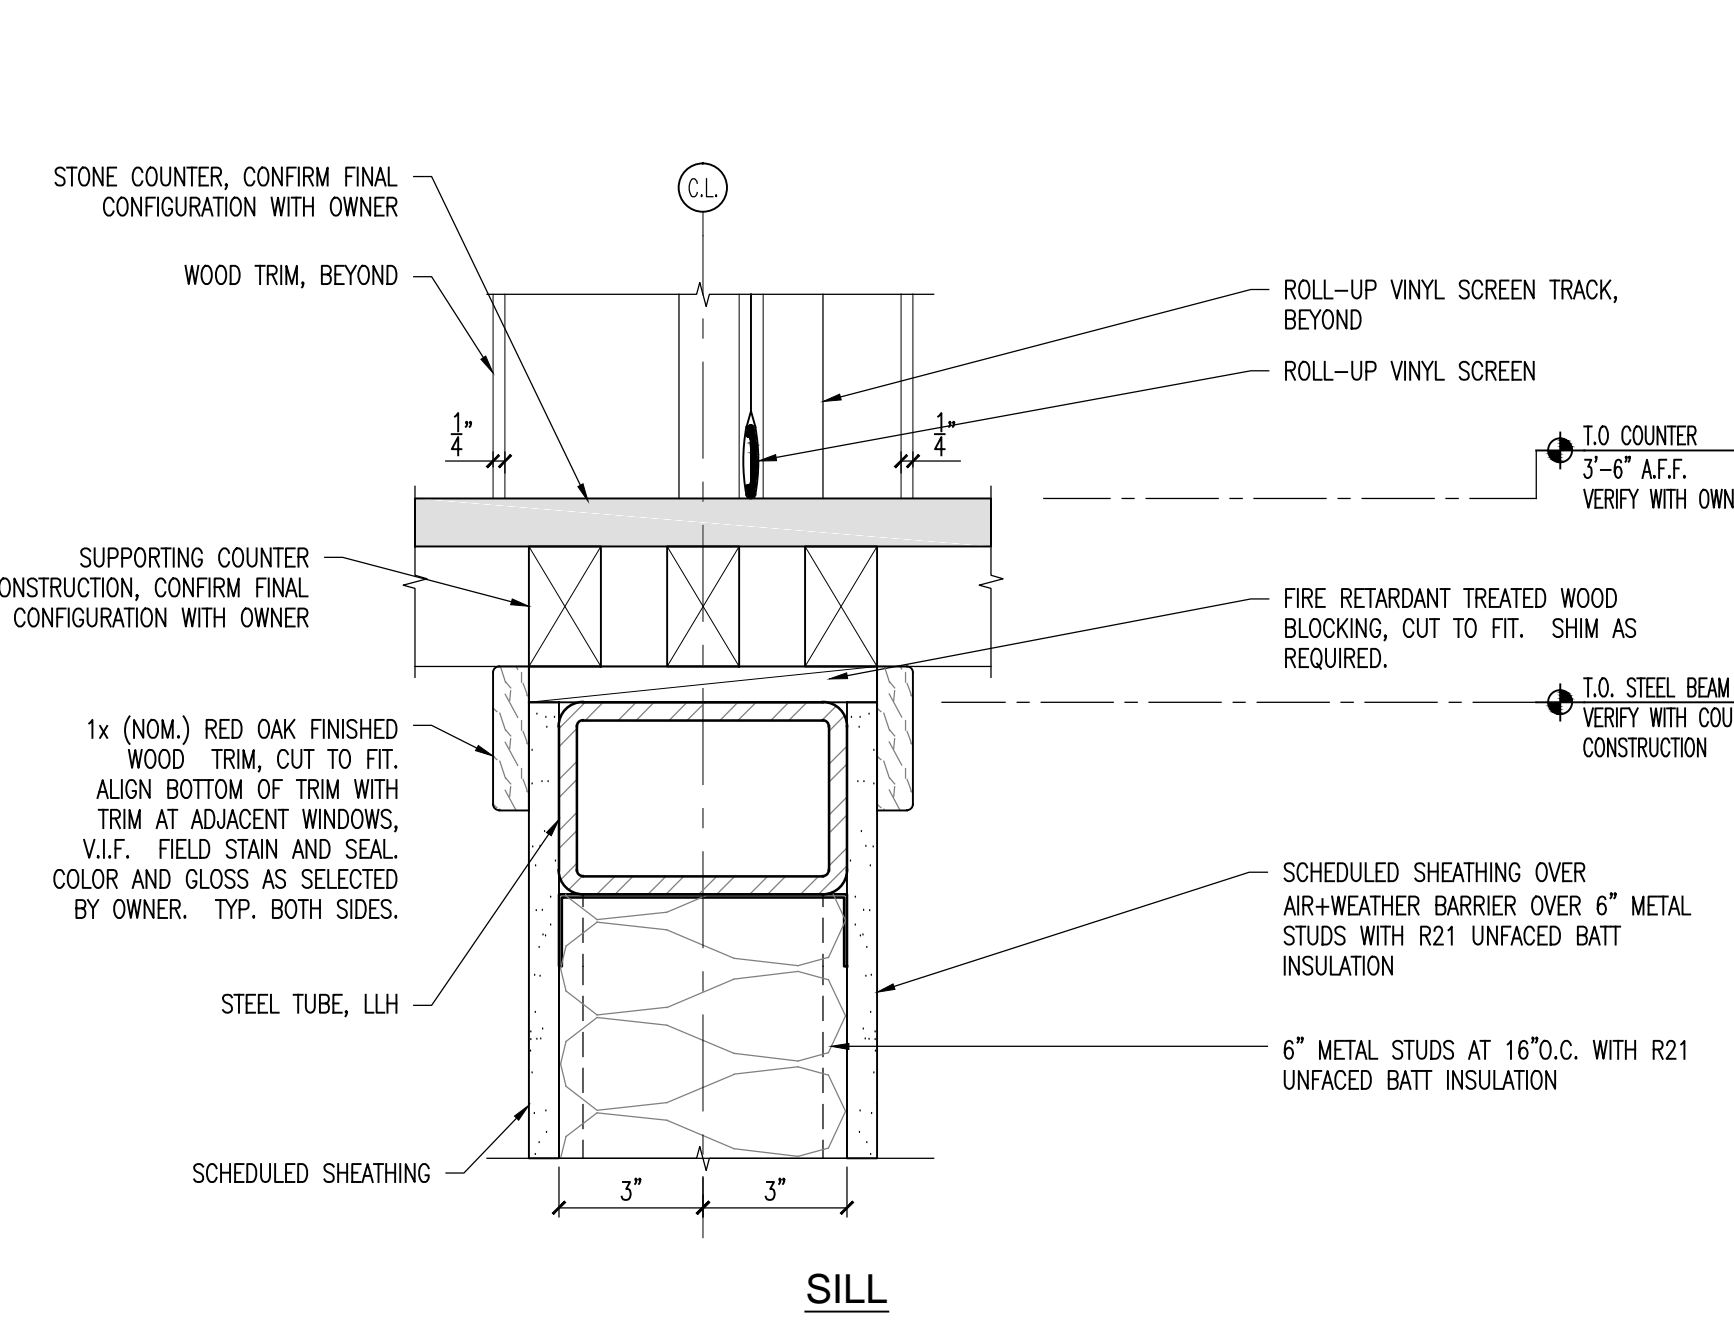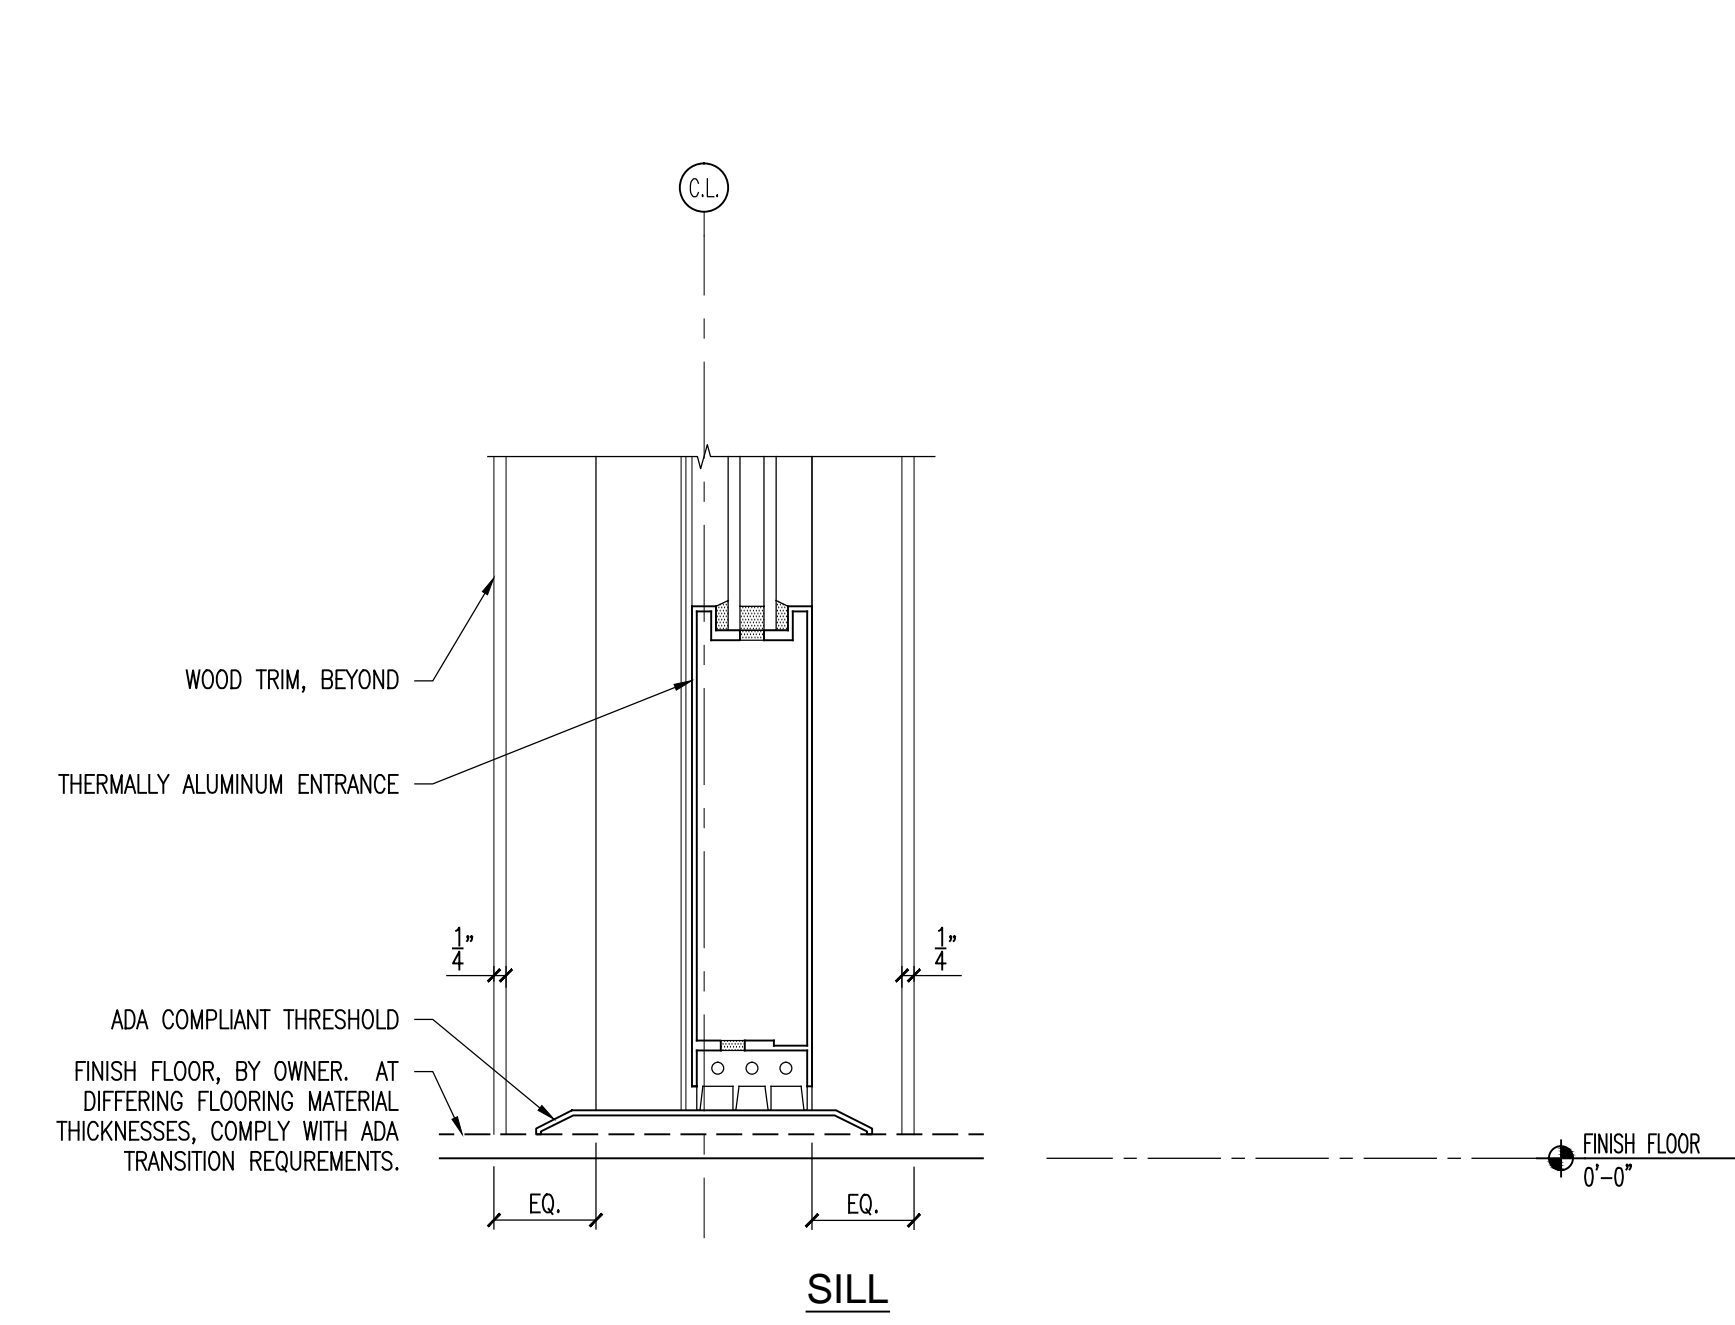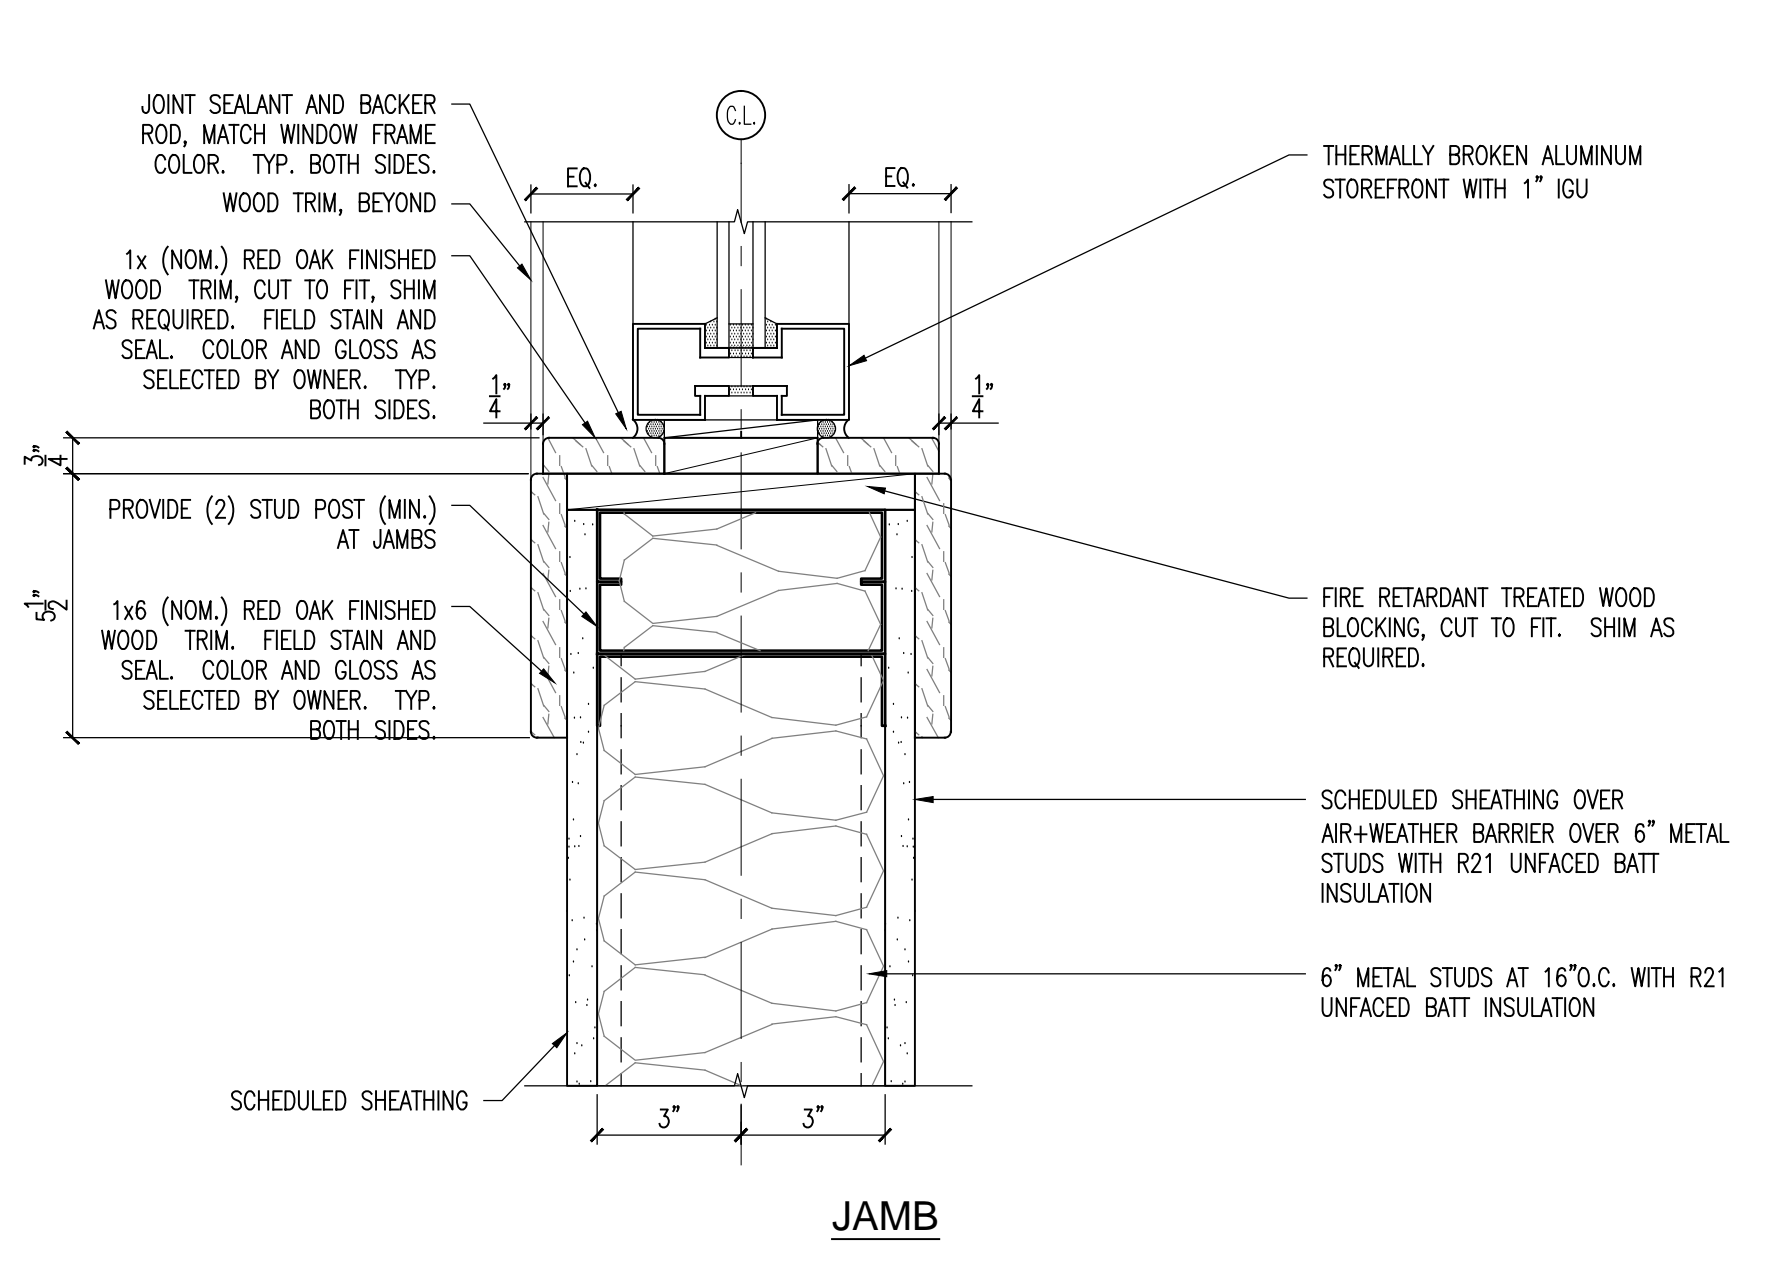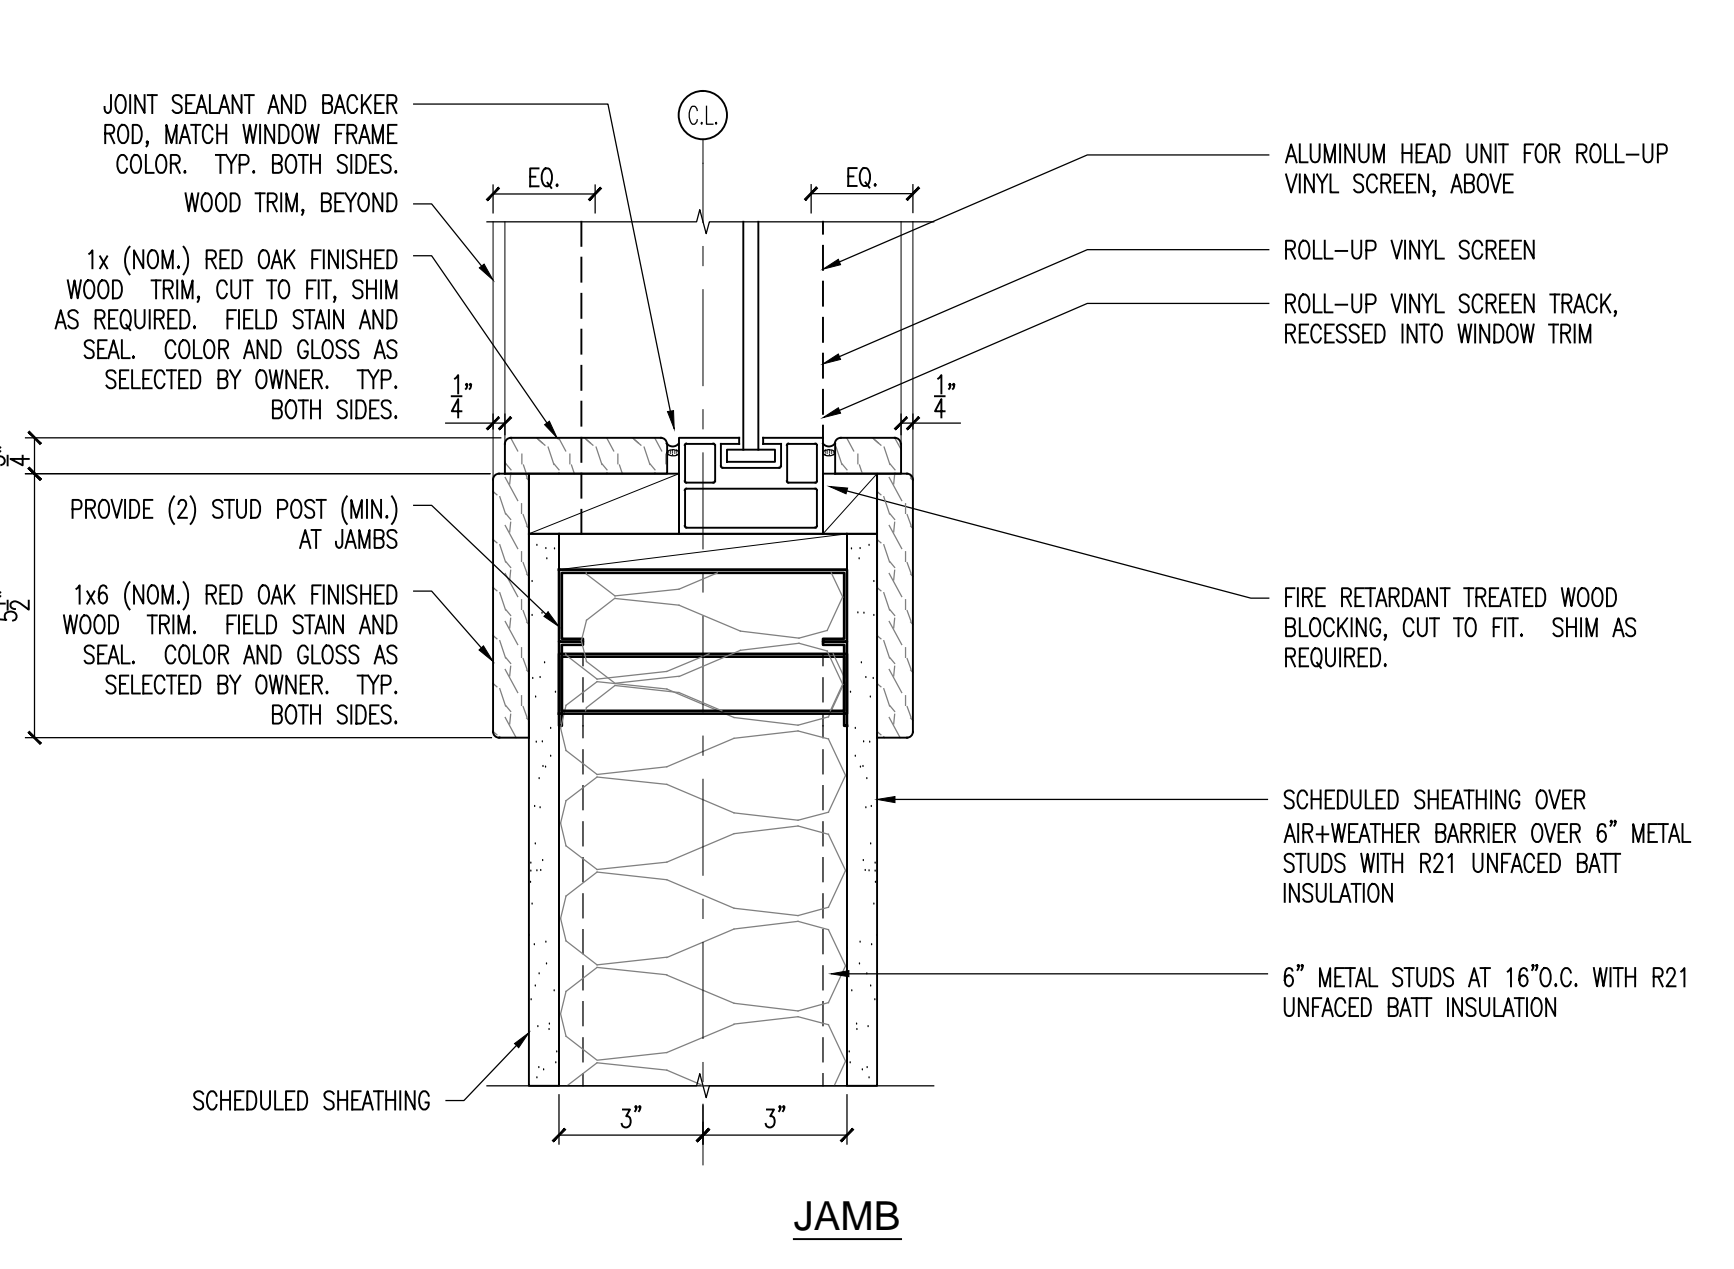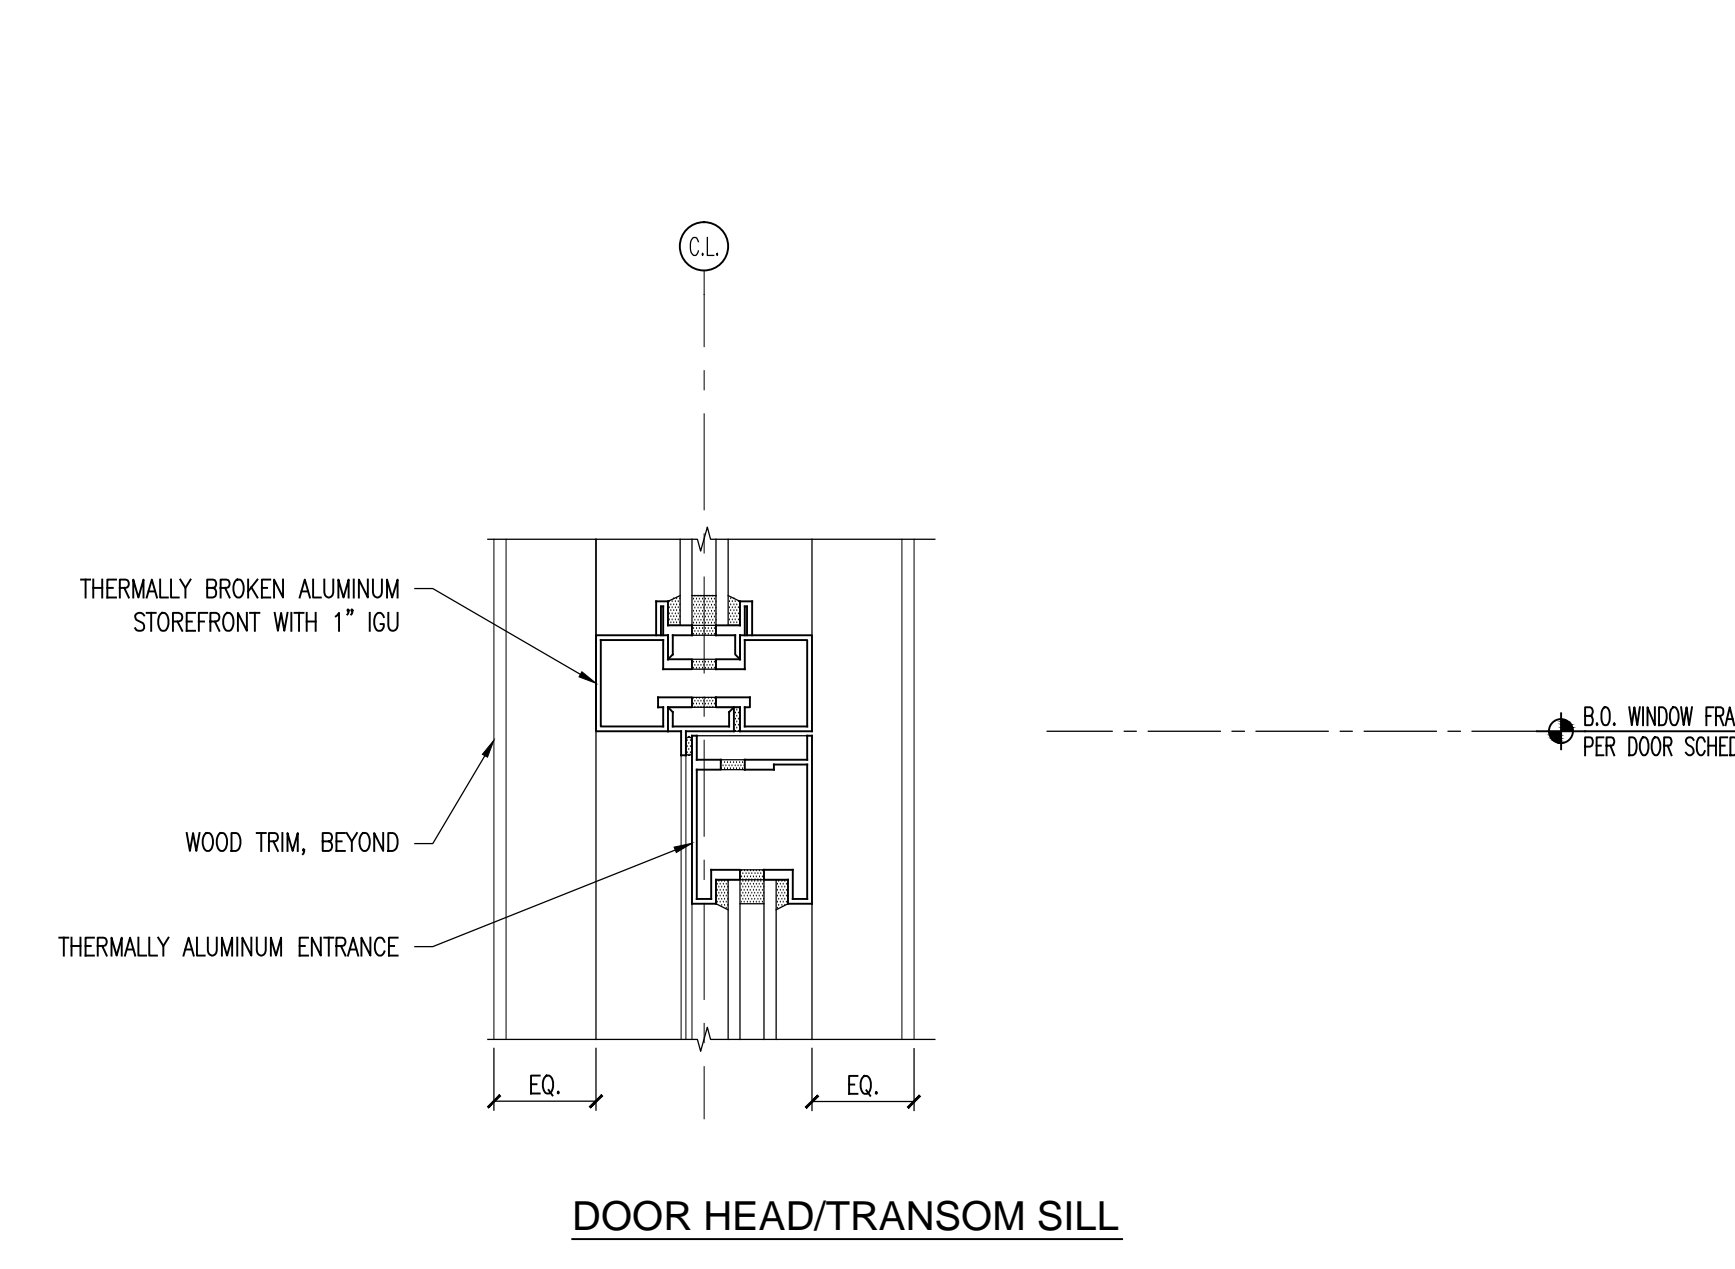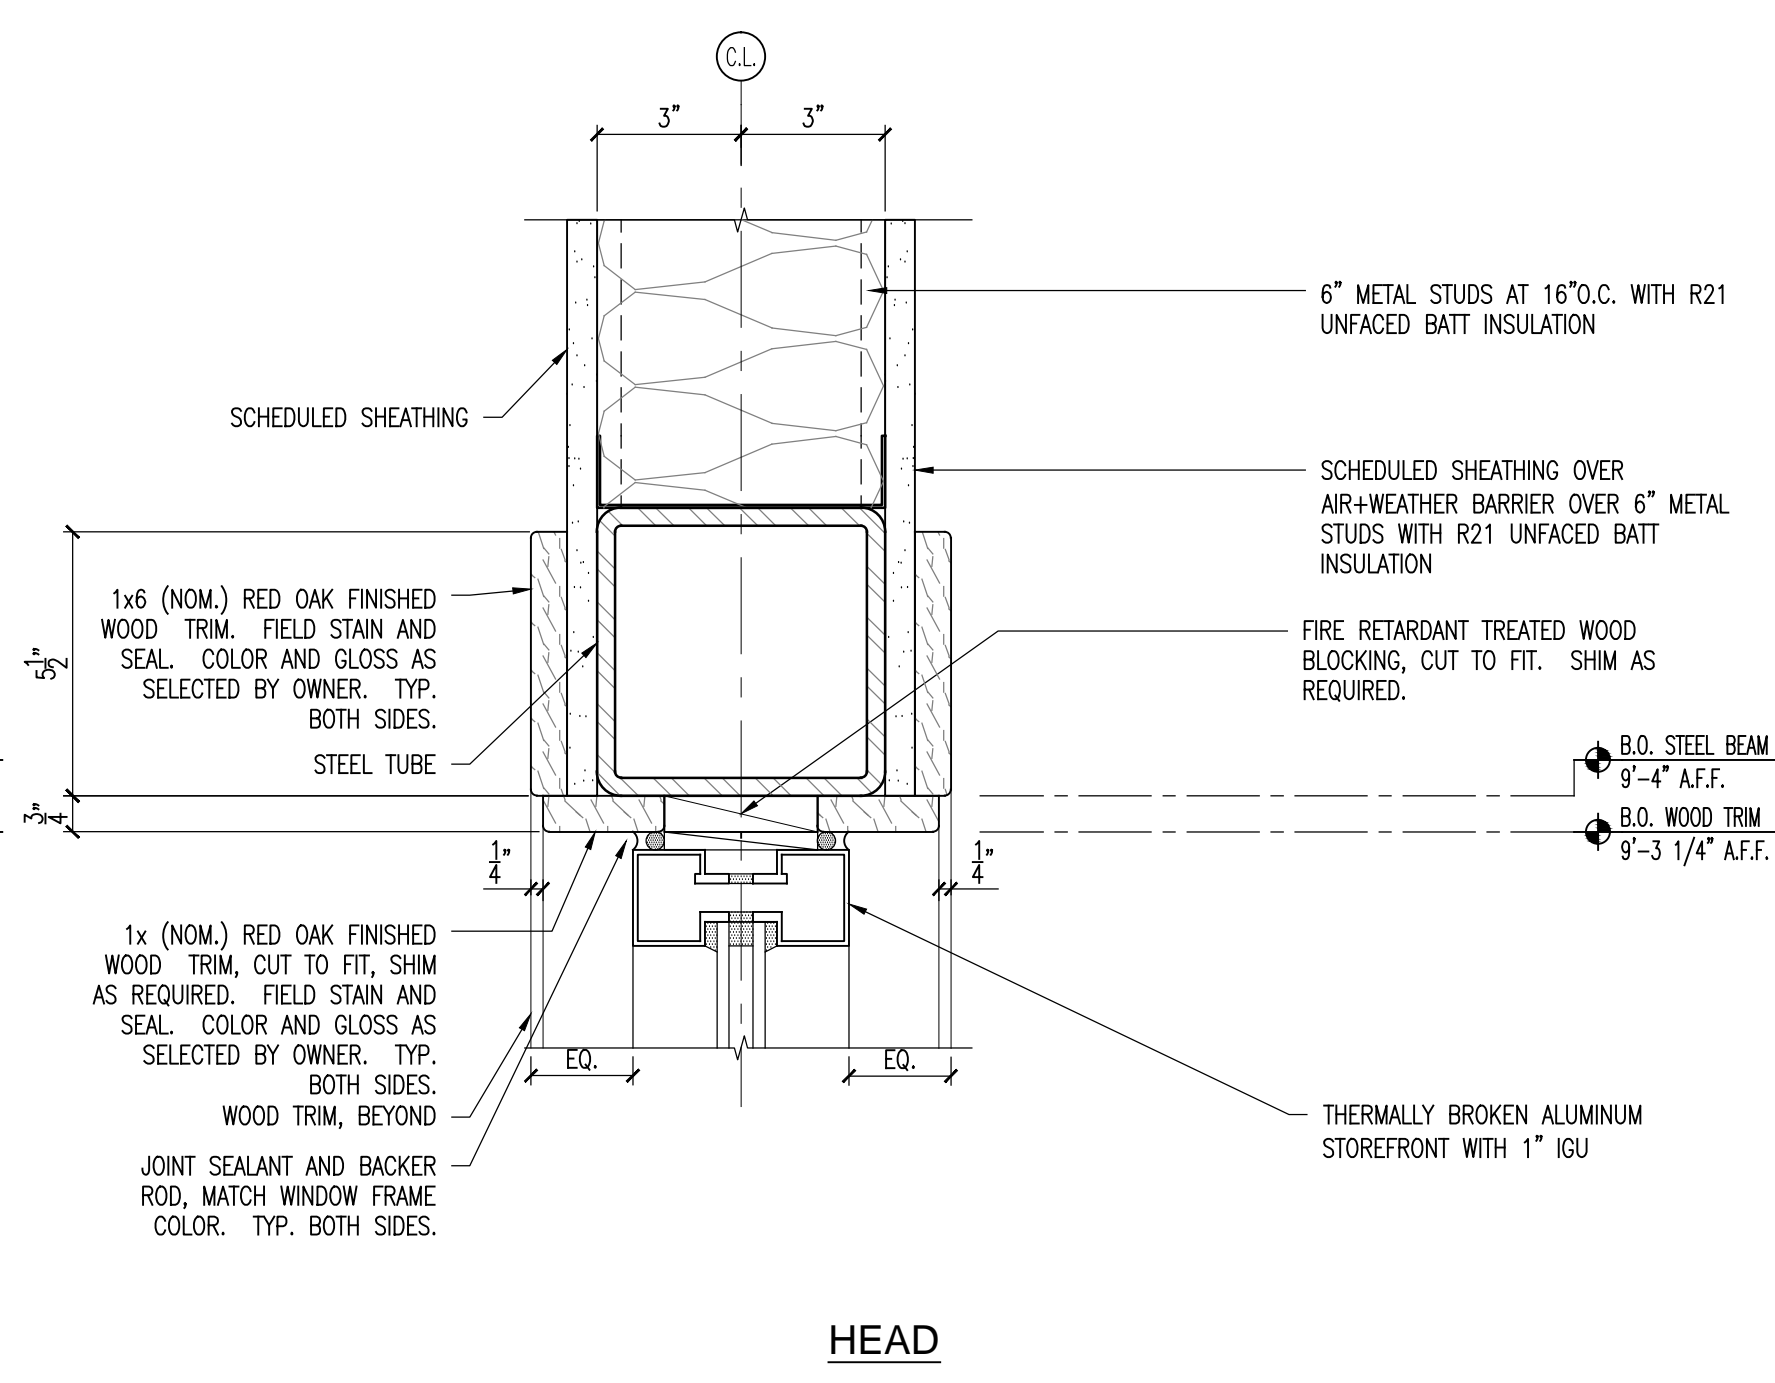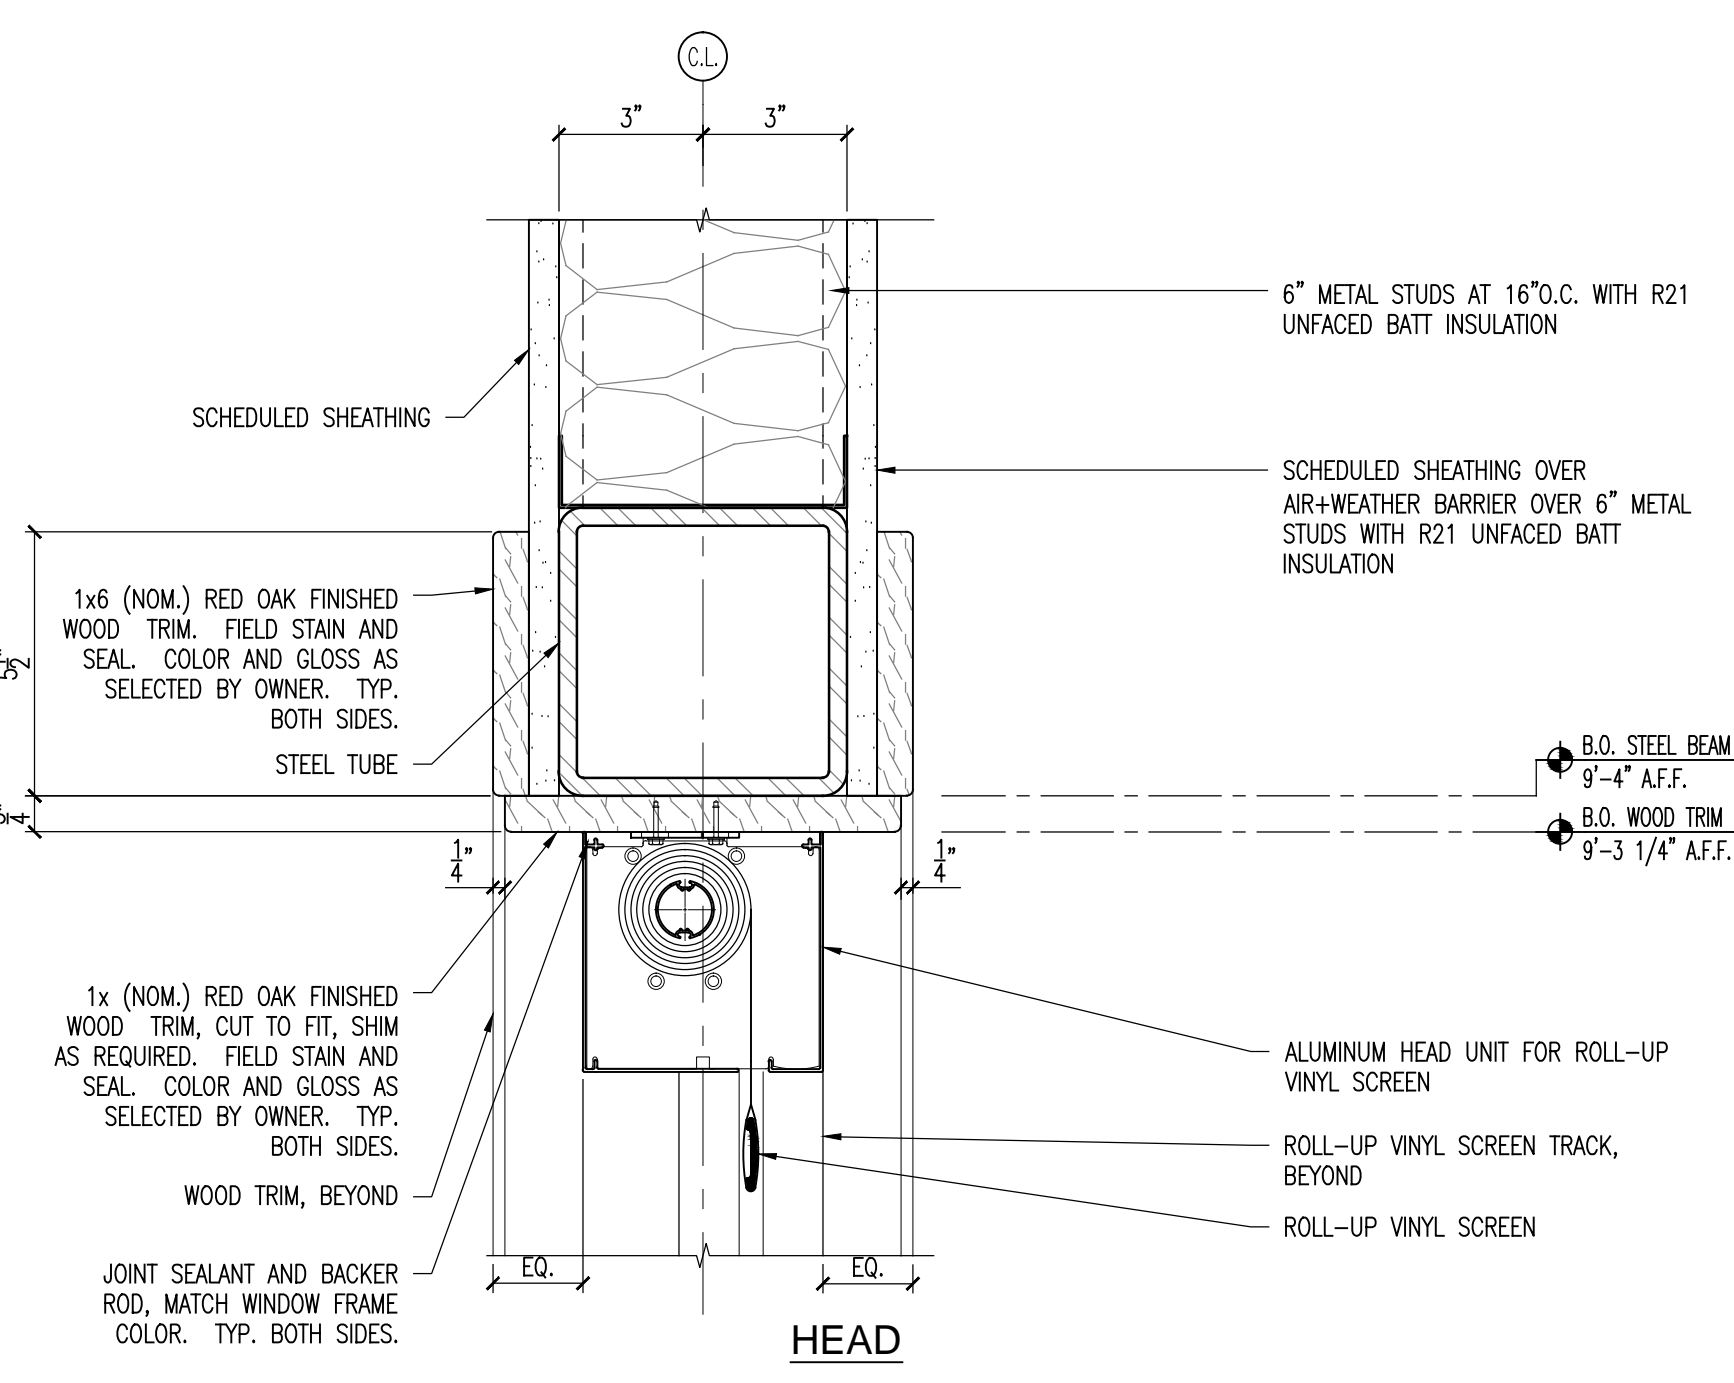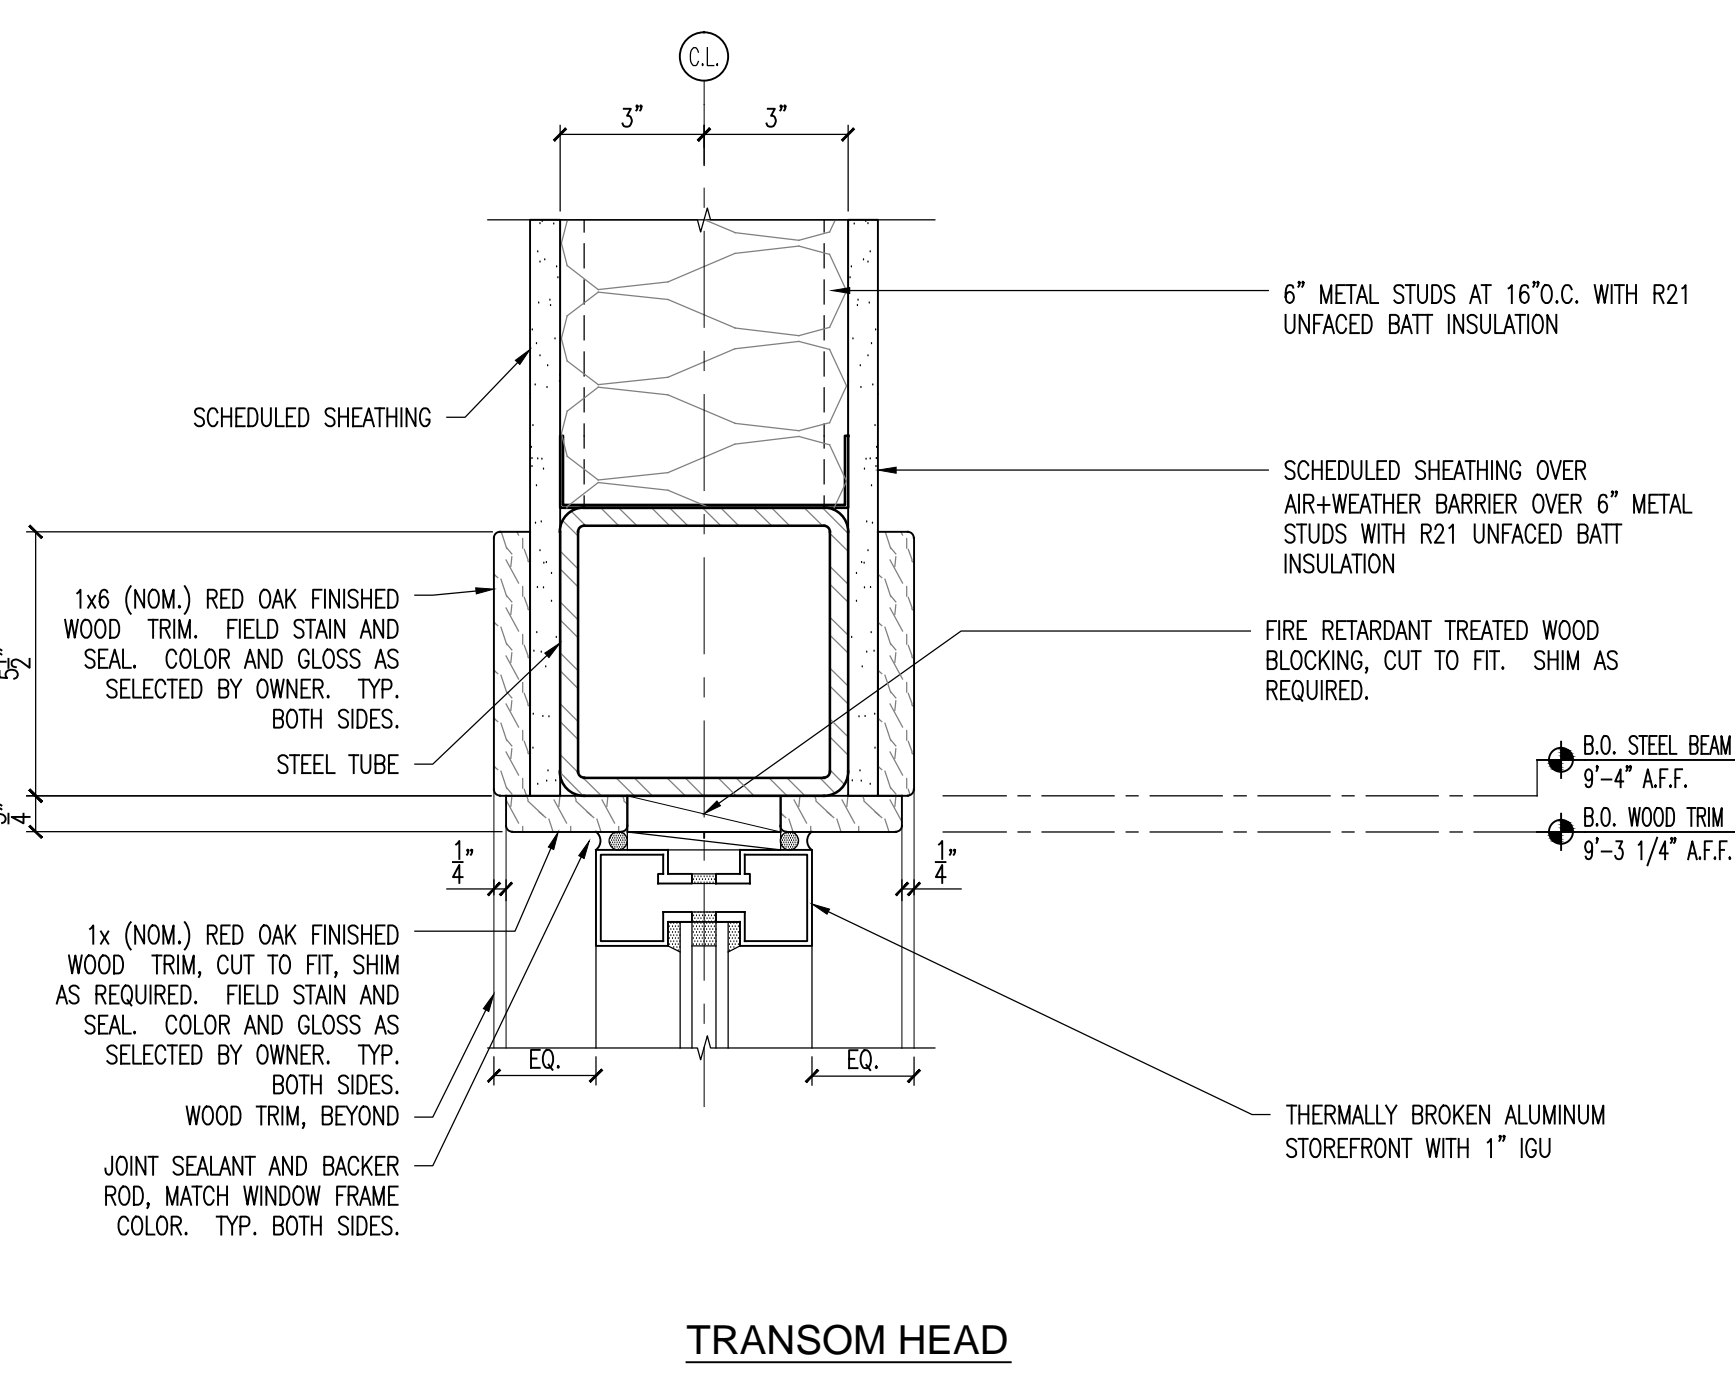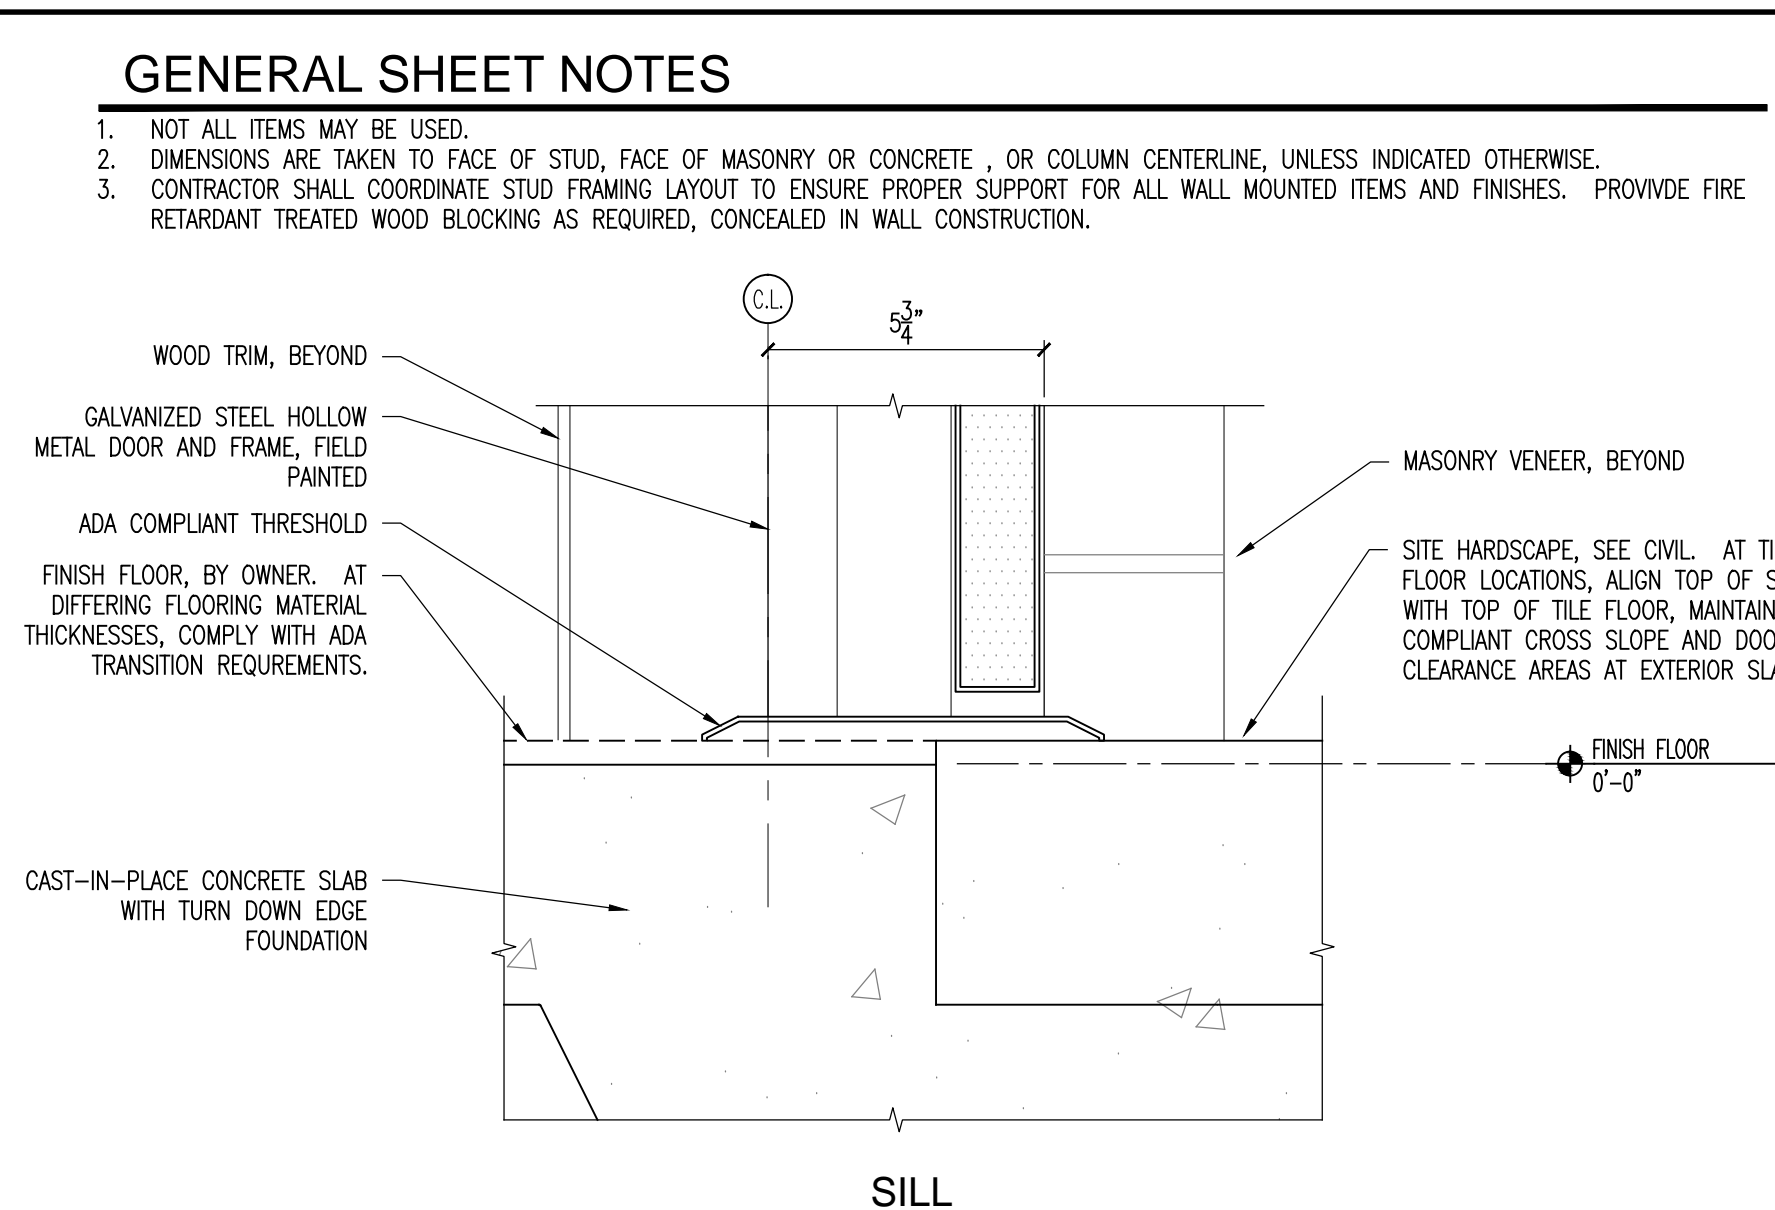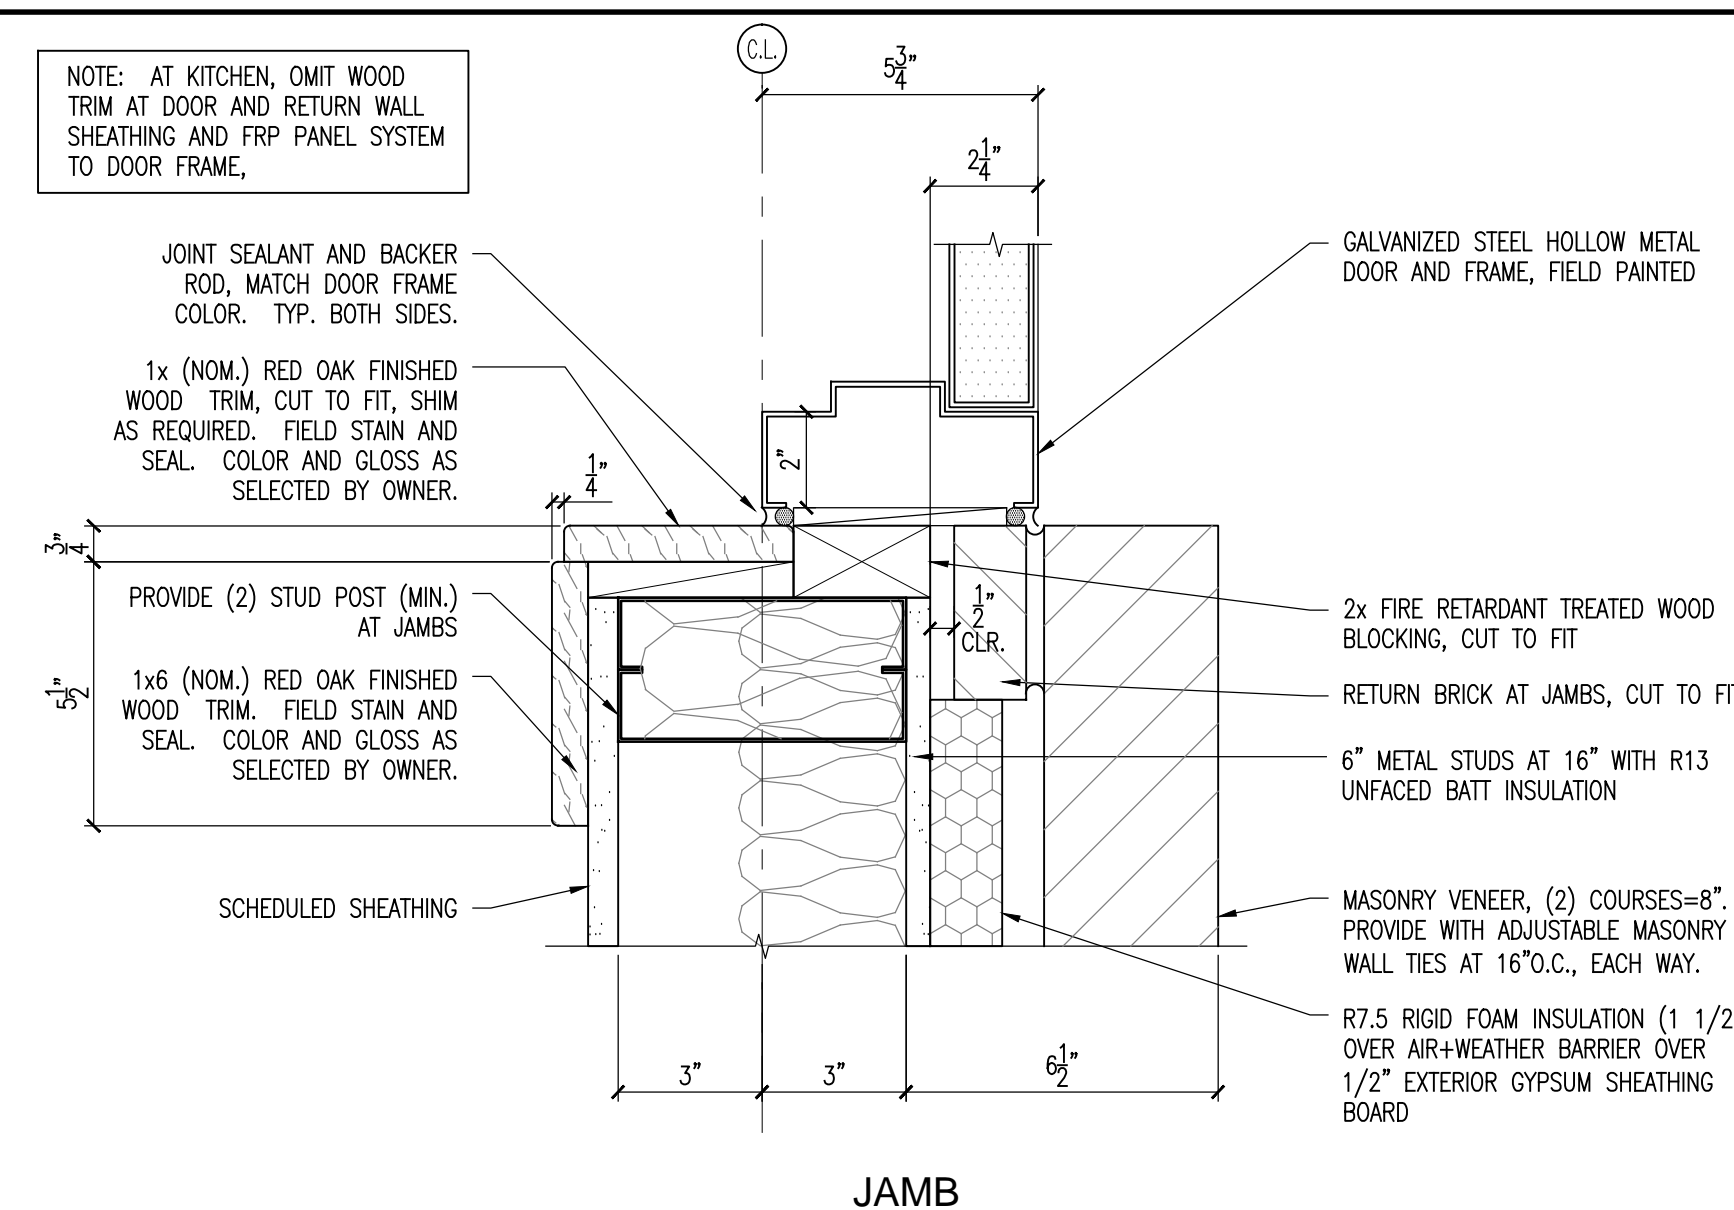

3 DINING ROOM TO PATIO ENTRANCE DOOR AND TRANSOM

2 DINING ROOM TO PATIO ROLL-UP WINDOW DETAILS

1 DINING ROOM TO PATIO EXTERIOR STOREFRONT WINDOW DETAILS

1. NOT ALL ITEMS MAY BE USED.
2. DIMENSIONS ARE TAKEN TO FACE OF STUD, FACE OF MASONRY OR CONCRETE , OR COLUMN CENTERLINE, UNLESS INDICATED OTHERWISE.
3. CONTRACTOR SHALL COORDINATE STUD FRAMING LAYOUT TO ENSURE PROPER SUPPORT FOR ALL WALL MOUNTED ITEMS AND FINISHES. PROVIDE FIRE RETARDANT TREATED WOOD BLOCKING AS REQUIRED, CONCEALED IN WALL CONSTRUCTION.




FINISH FLOOR, BY OWNER. AT
DIFFERING FLOORING MATERIAL
THICKNESSES, COMPLY WITH ADA
TRANSITION REQUIREMENTS.

SIL

GENERAL SHEET NOTES


1. NOT ALL ITEMS MAY BE USED.
2. DIMENSIONS ARE TAKEN TO FACE OF STUD, FACE OF MASONRY OR CONCRETE, OR COLUMN CENTERLINE, UNLESS INDICATED OTHERWISE.
3. CONTRACTOR SHALL COORDINATE ALL MINIMUM CLEARANCE REQUIREMENTS WITH THE DUMPSTER PAD ENCLOSURE WITH THE WASTE MANAGEMENT COMPANY. VERTICAL CLEARANCE IS CRITICAL.
4. CITY REGULATIONS REQUIRE THE DUMPSTER BE COMPLETELY CONCEALED BEHIND THE MASONRY WALL. CONFIRM FINAL HEIGHT OF MASONRY WALL WITH WASTE MANAGEMENT COMPANY.
5. ALL FASTENERS AND ACCESSORIES SHALL BE HOT DIPPED GALVANIZED.

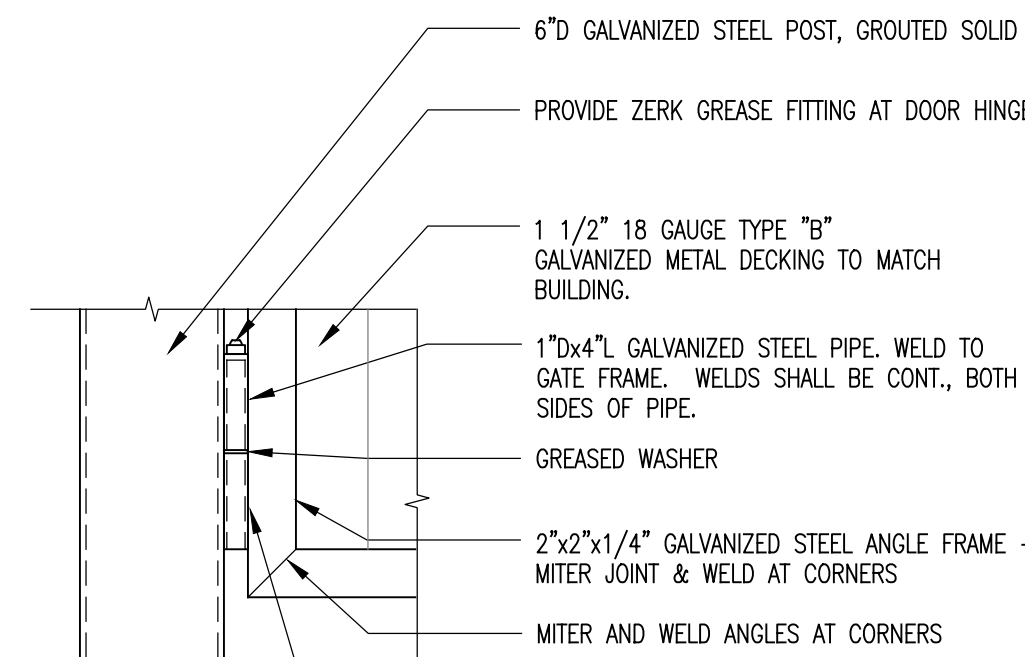


NOTE: GREASE COMPONENTS BEFORE ASSEMBLING HINGE IN FIELD.

NOTE: PROVIDE (4) HINGES AT EACH GATE POST.


ELEVATION

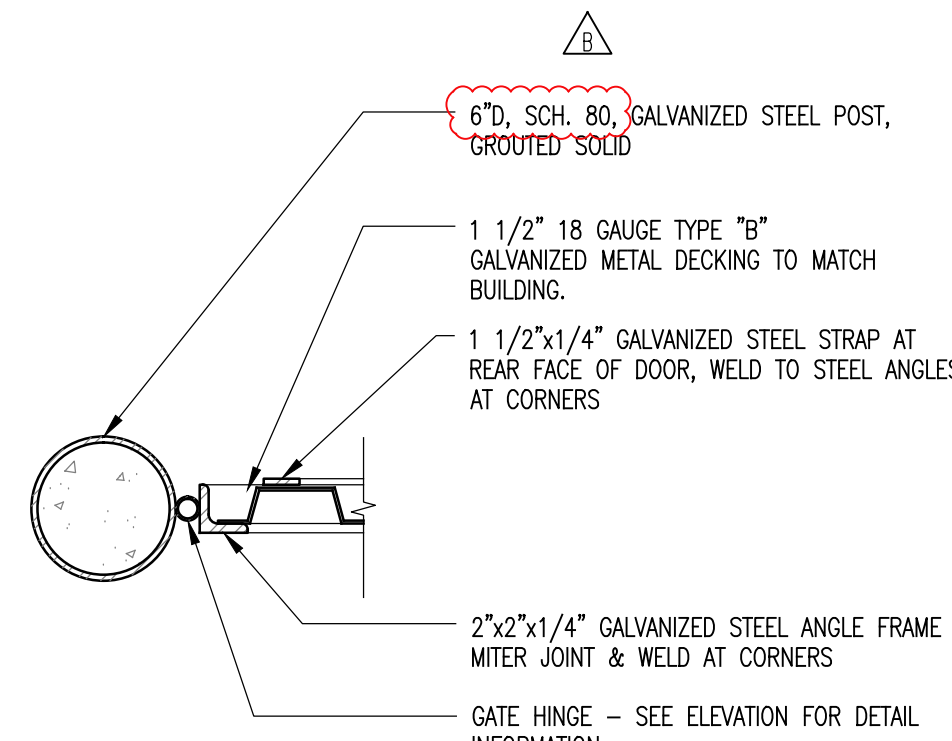


PLAN

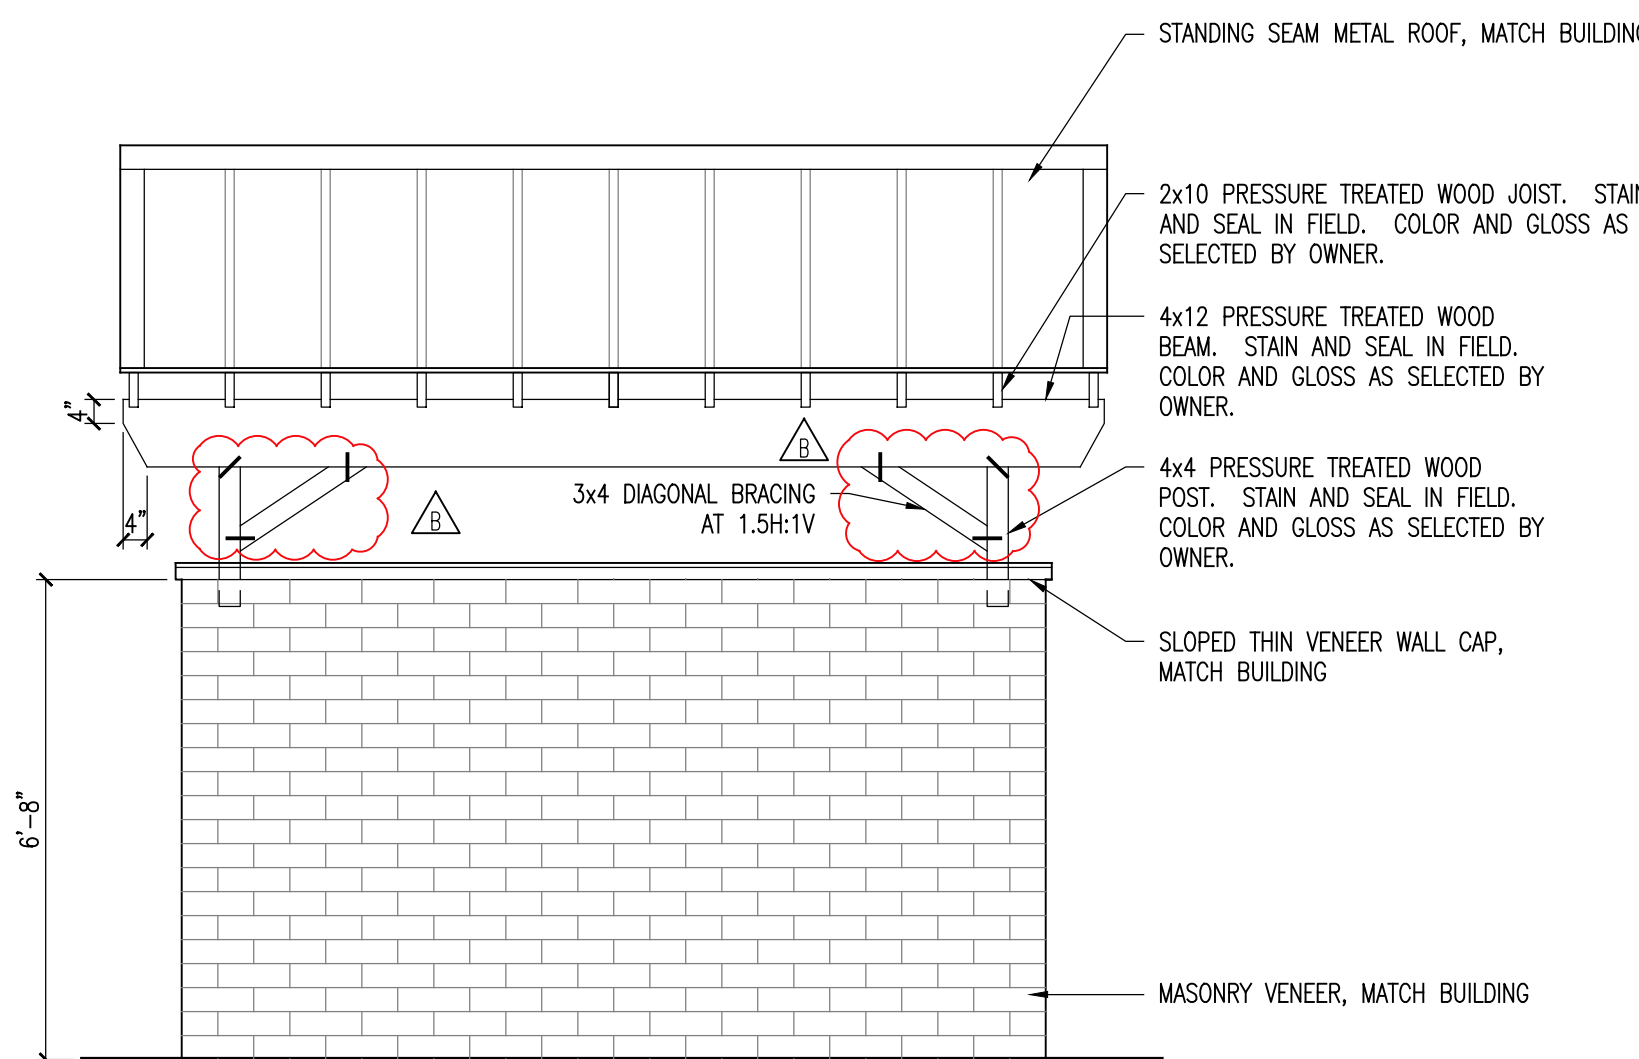


REAR ELEVATION

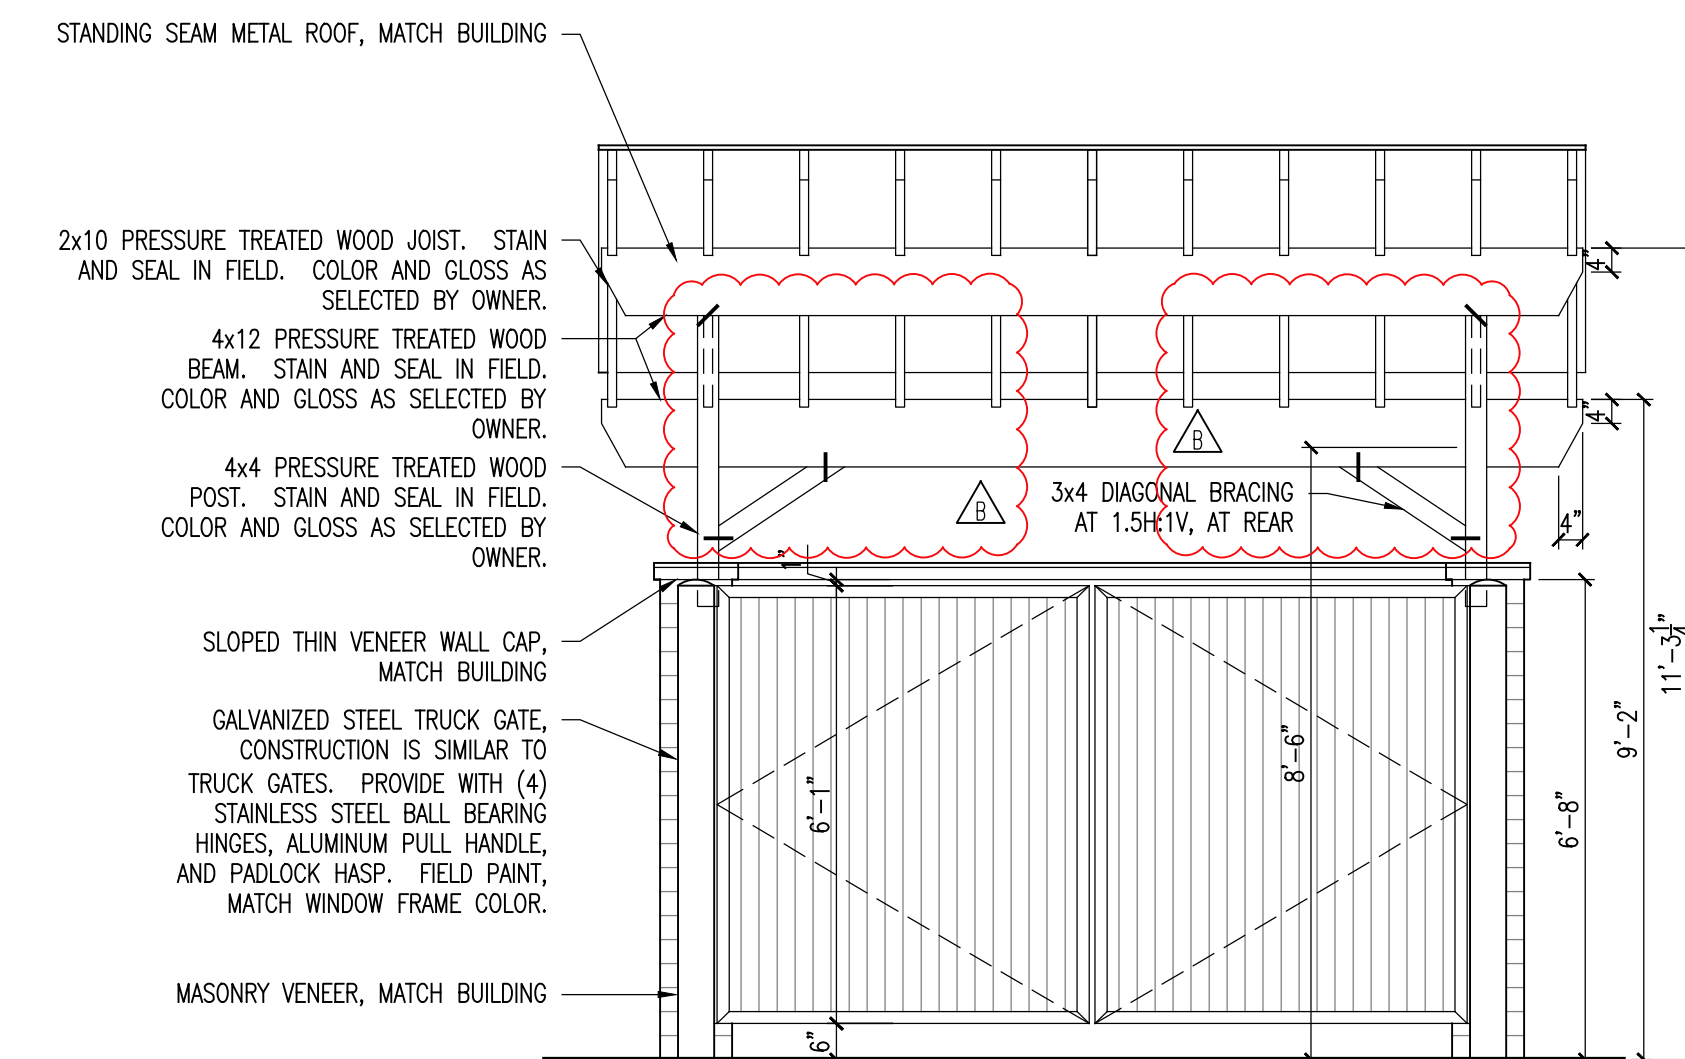

FRONT ELEVATION

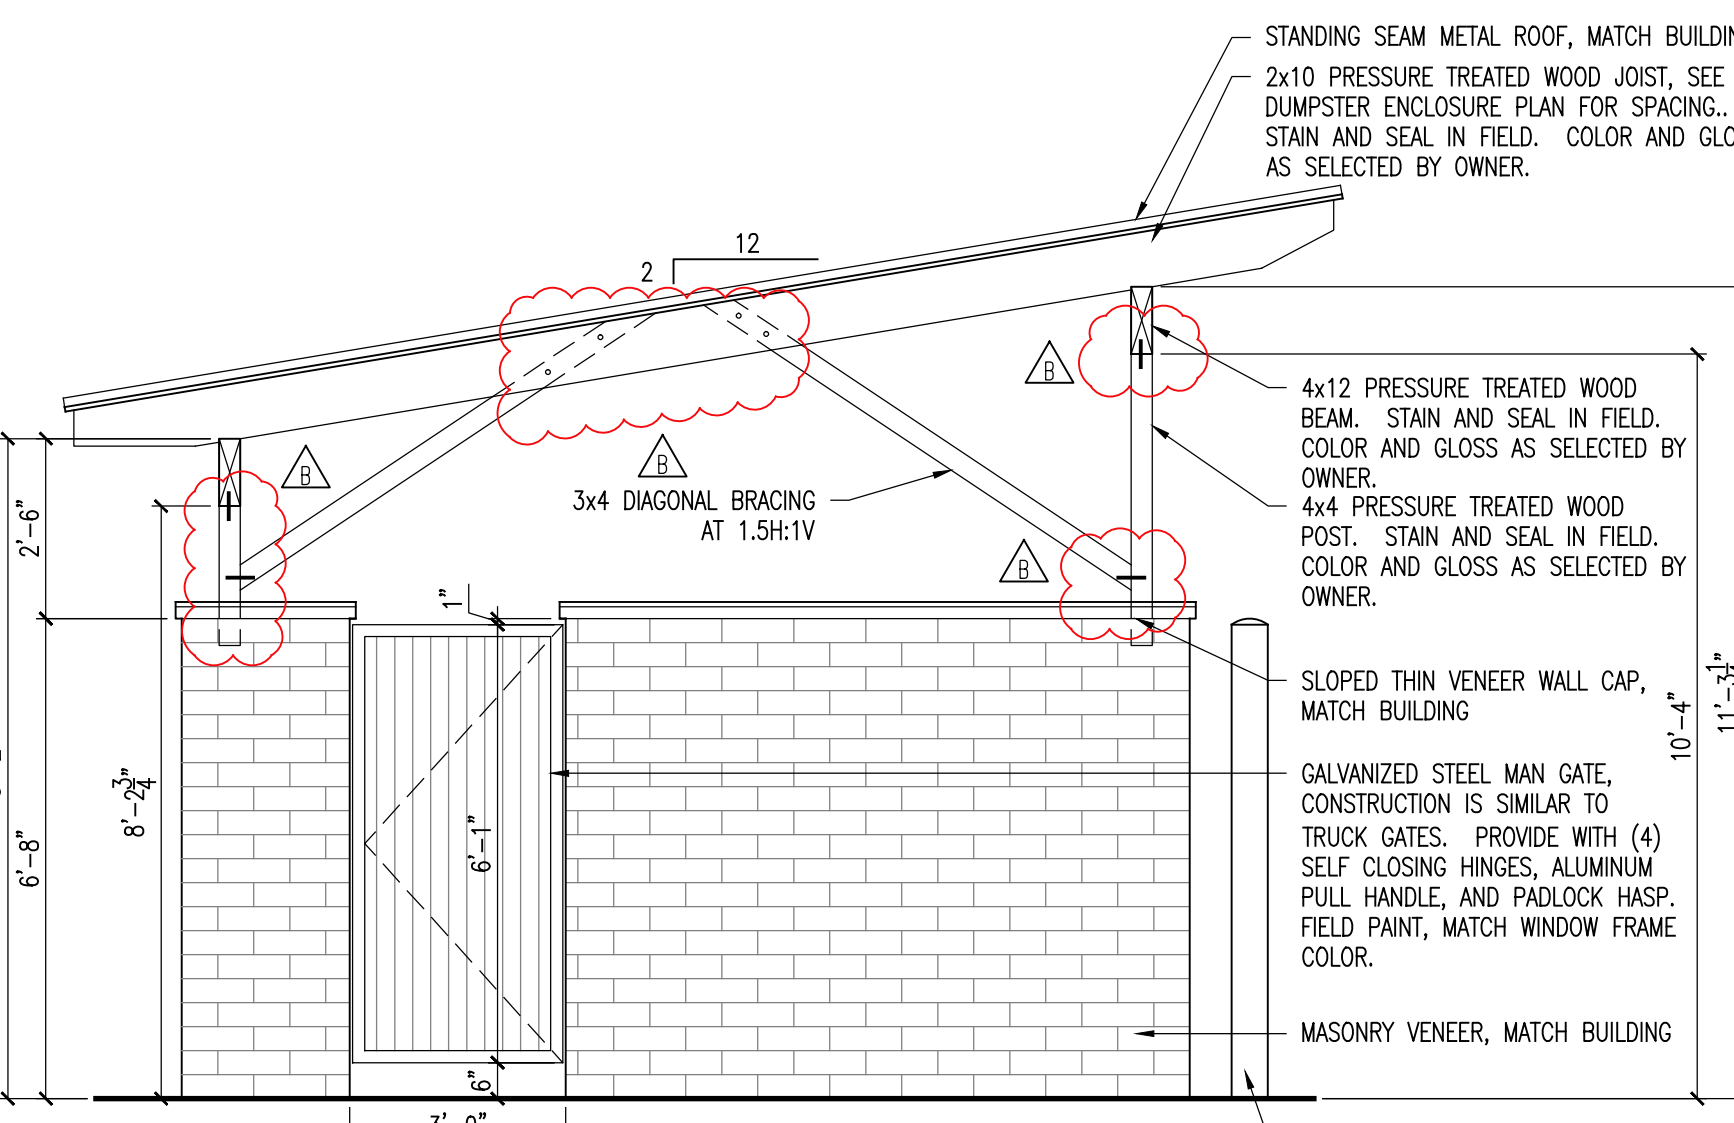


SIDE ELEVATION WITH GATE

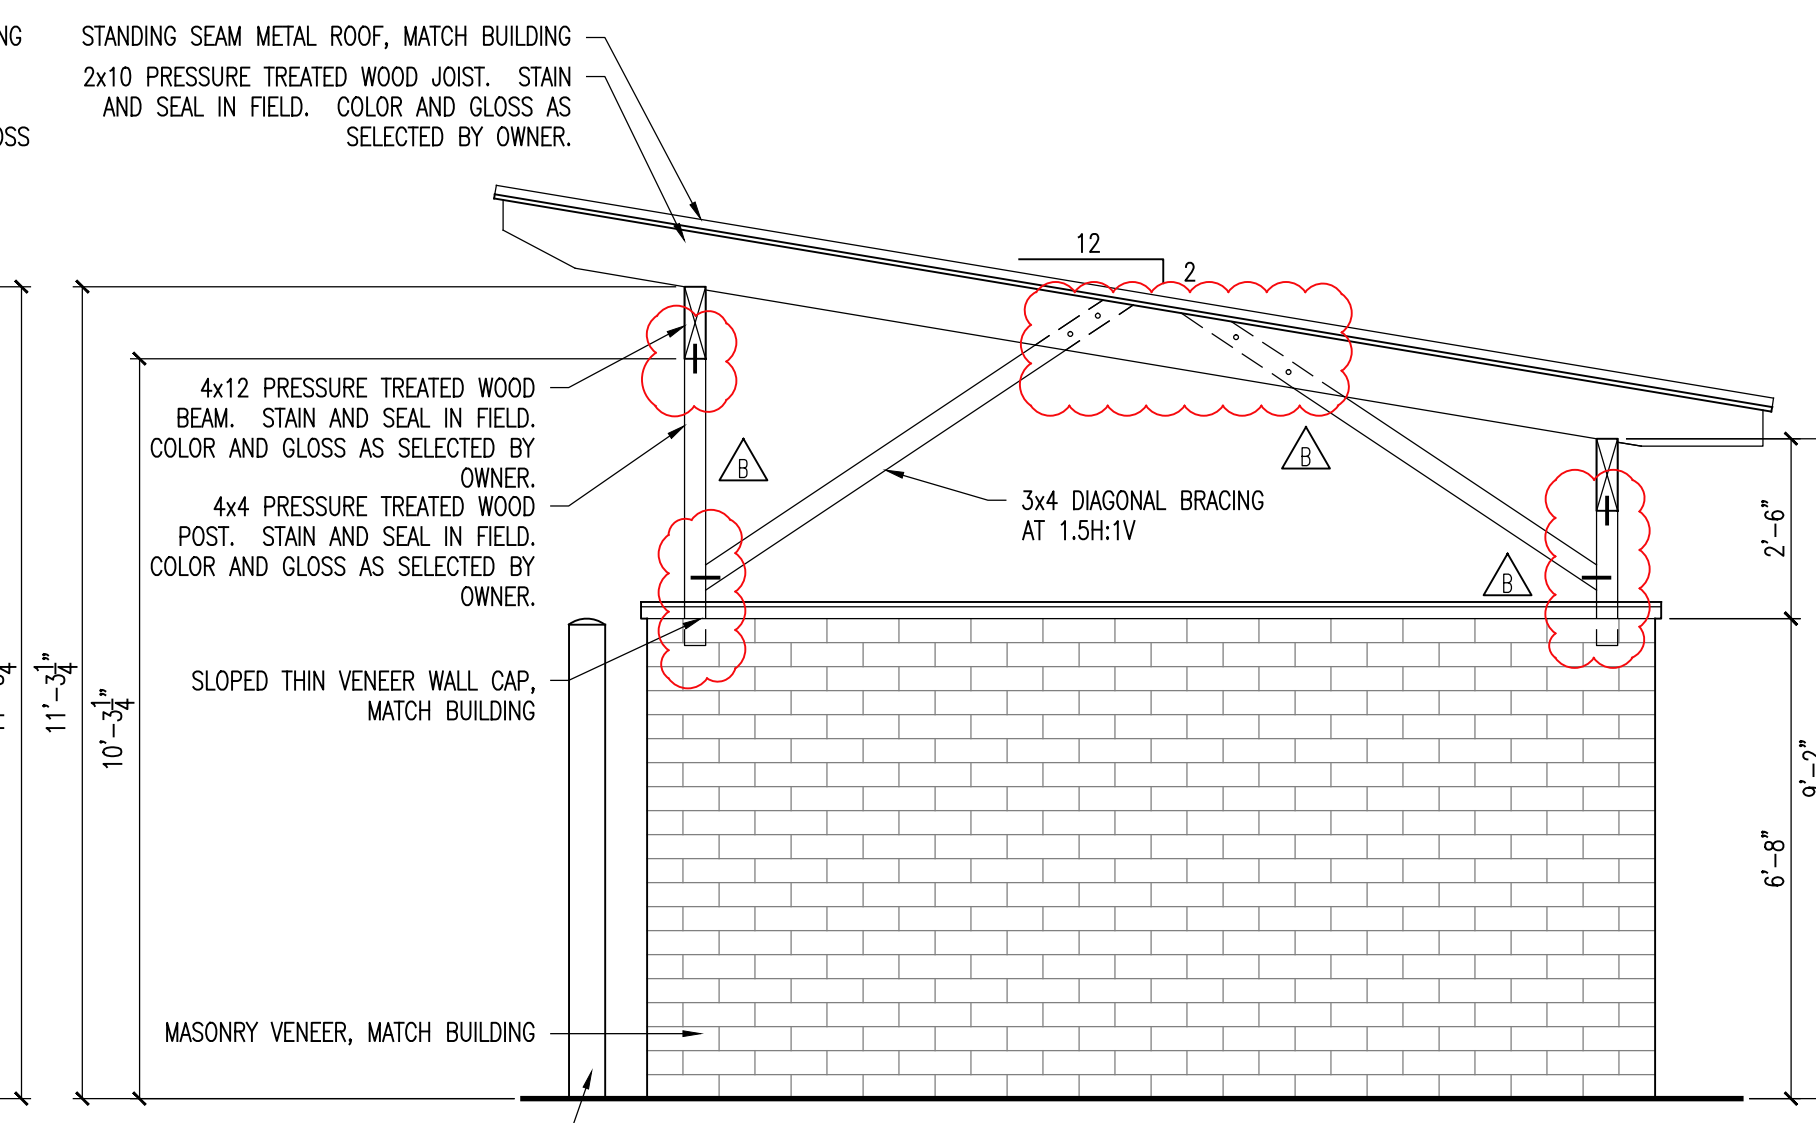

SIDE ELEVATION

2 DUMPSTER ENCLOSURE ELEVATIONS

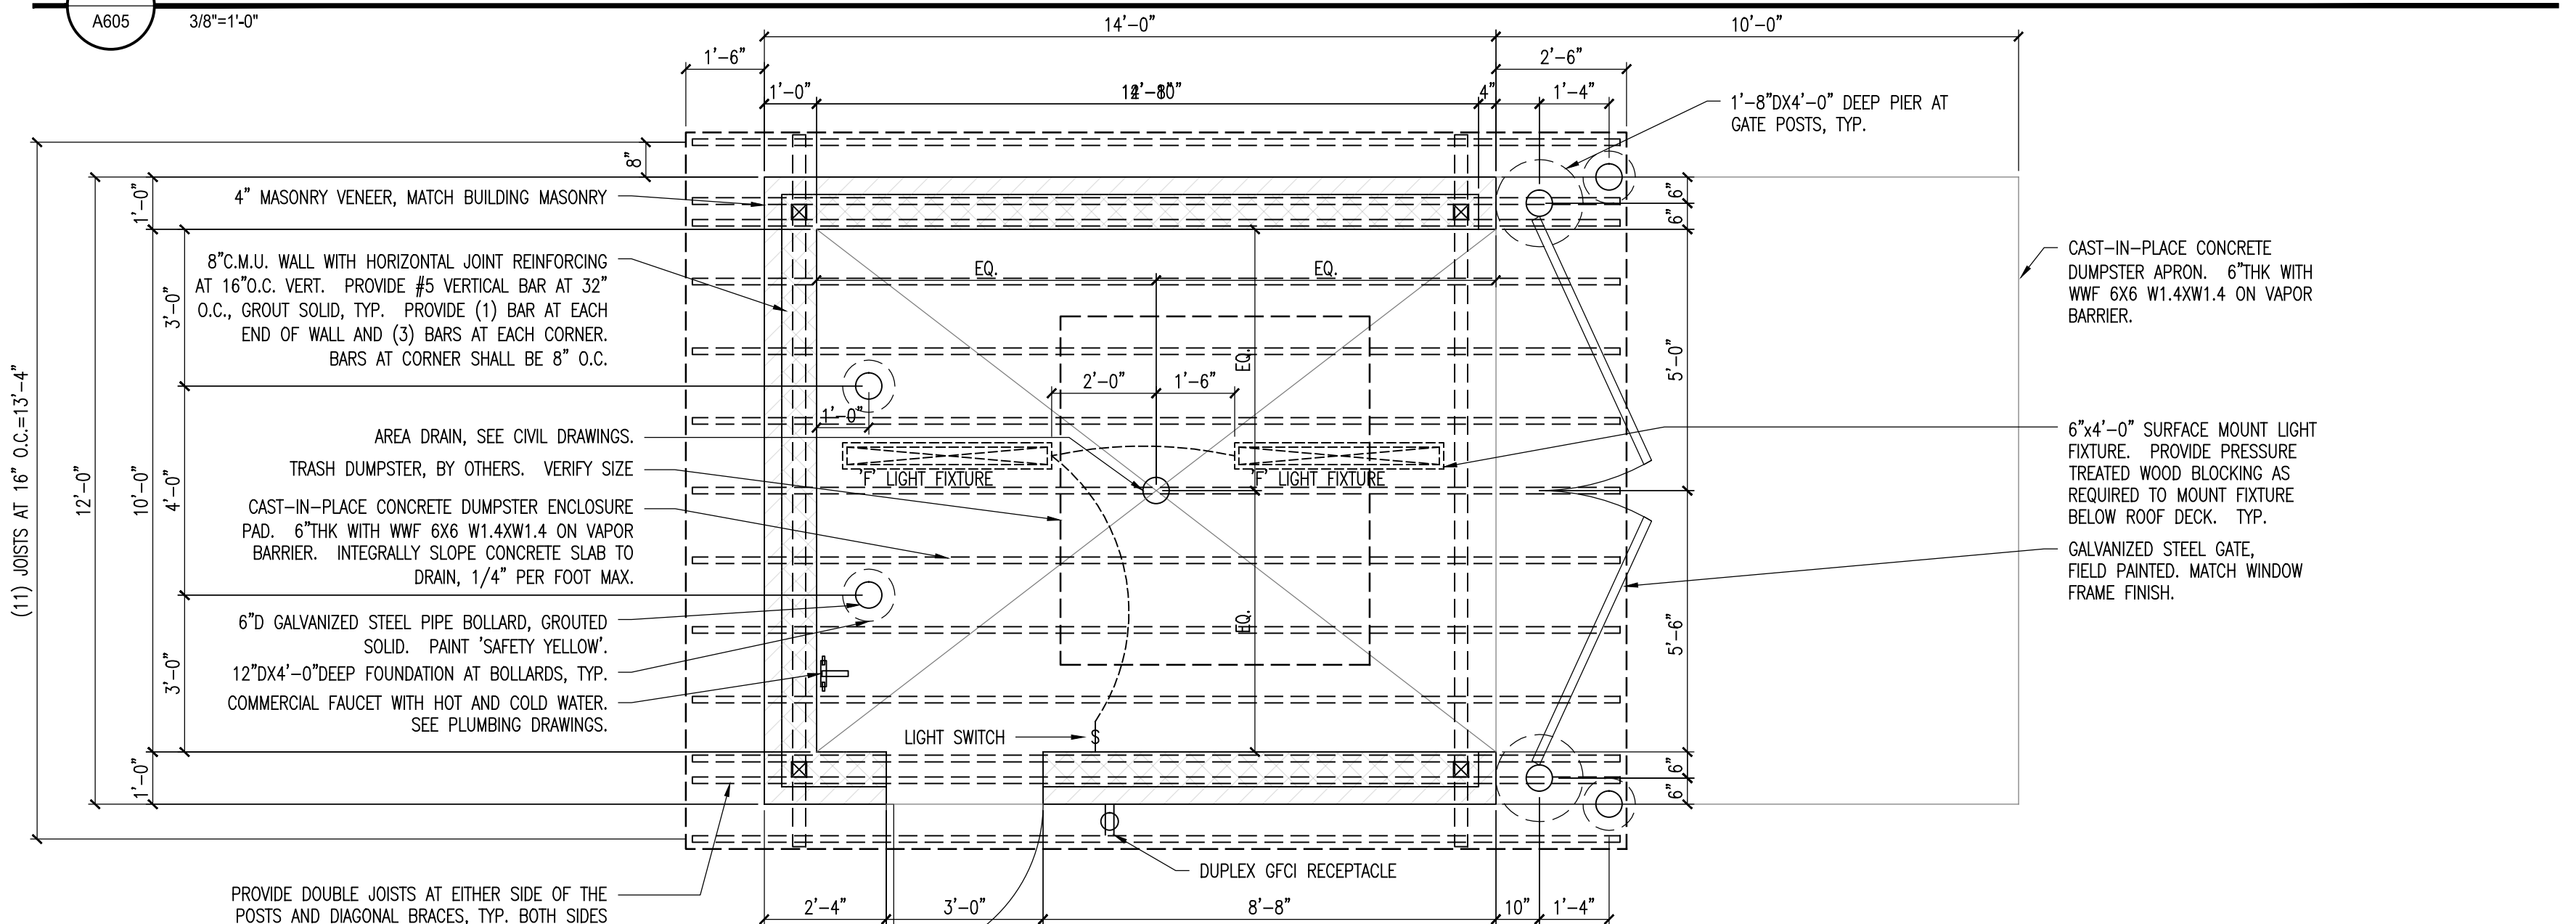


1 DUMPSTER ENCLOSURE PLAN

3/8"=1'-0"

4 GATE HINGE DETAIL

1/2"=1'-0"

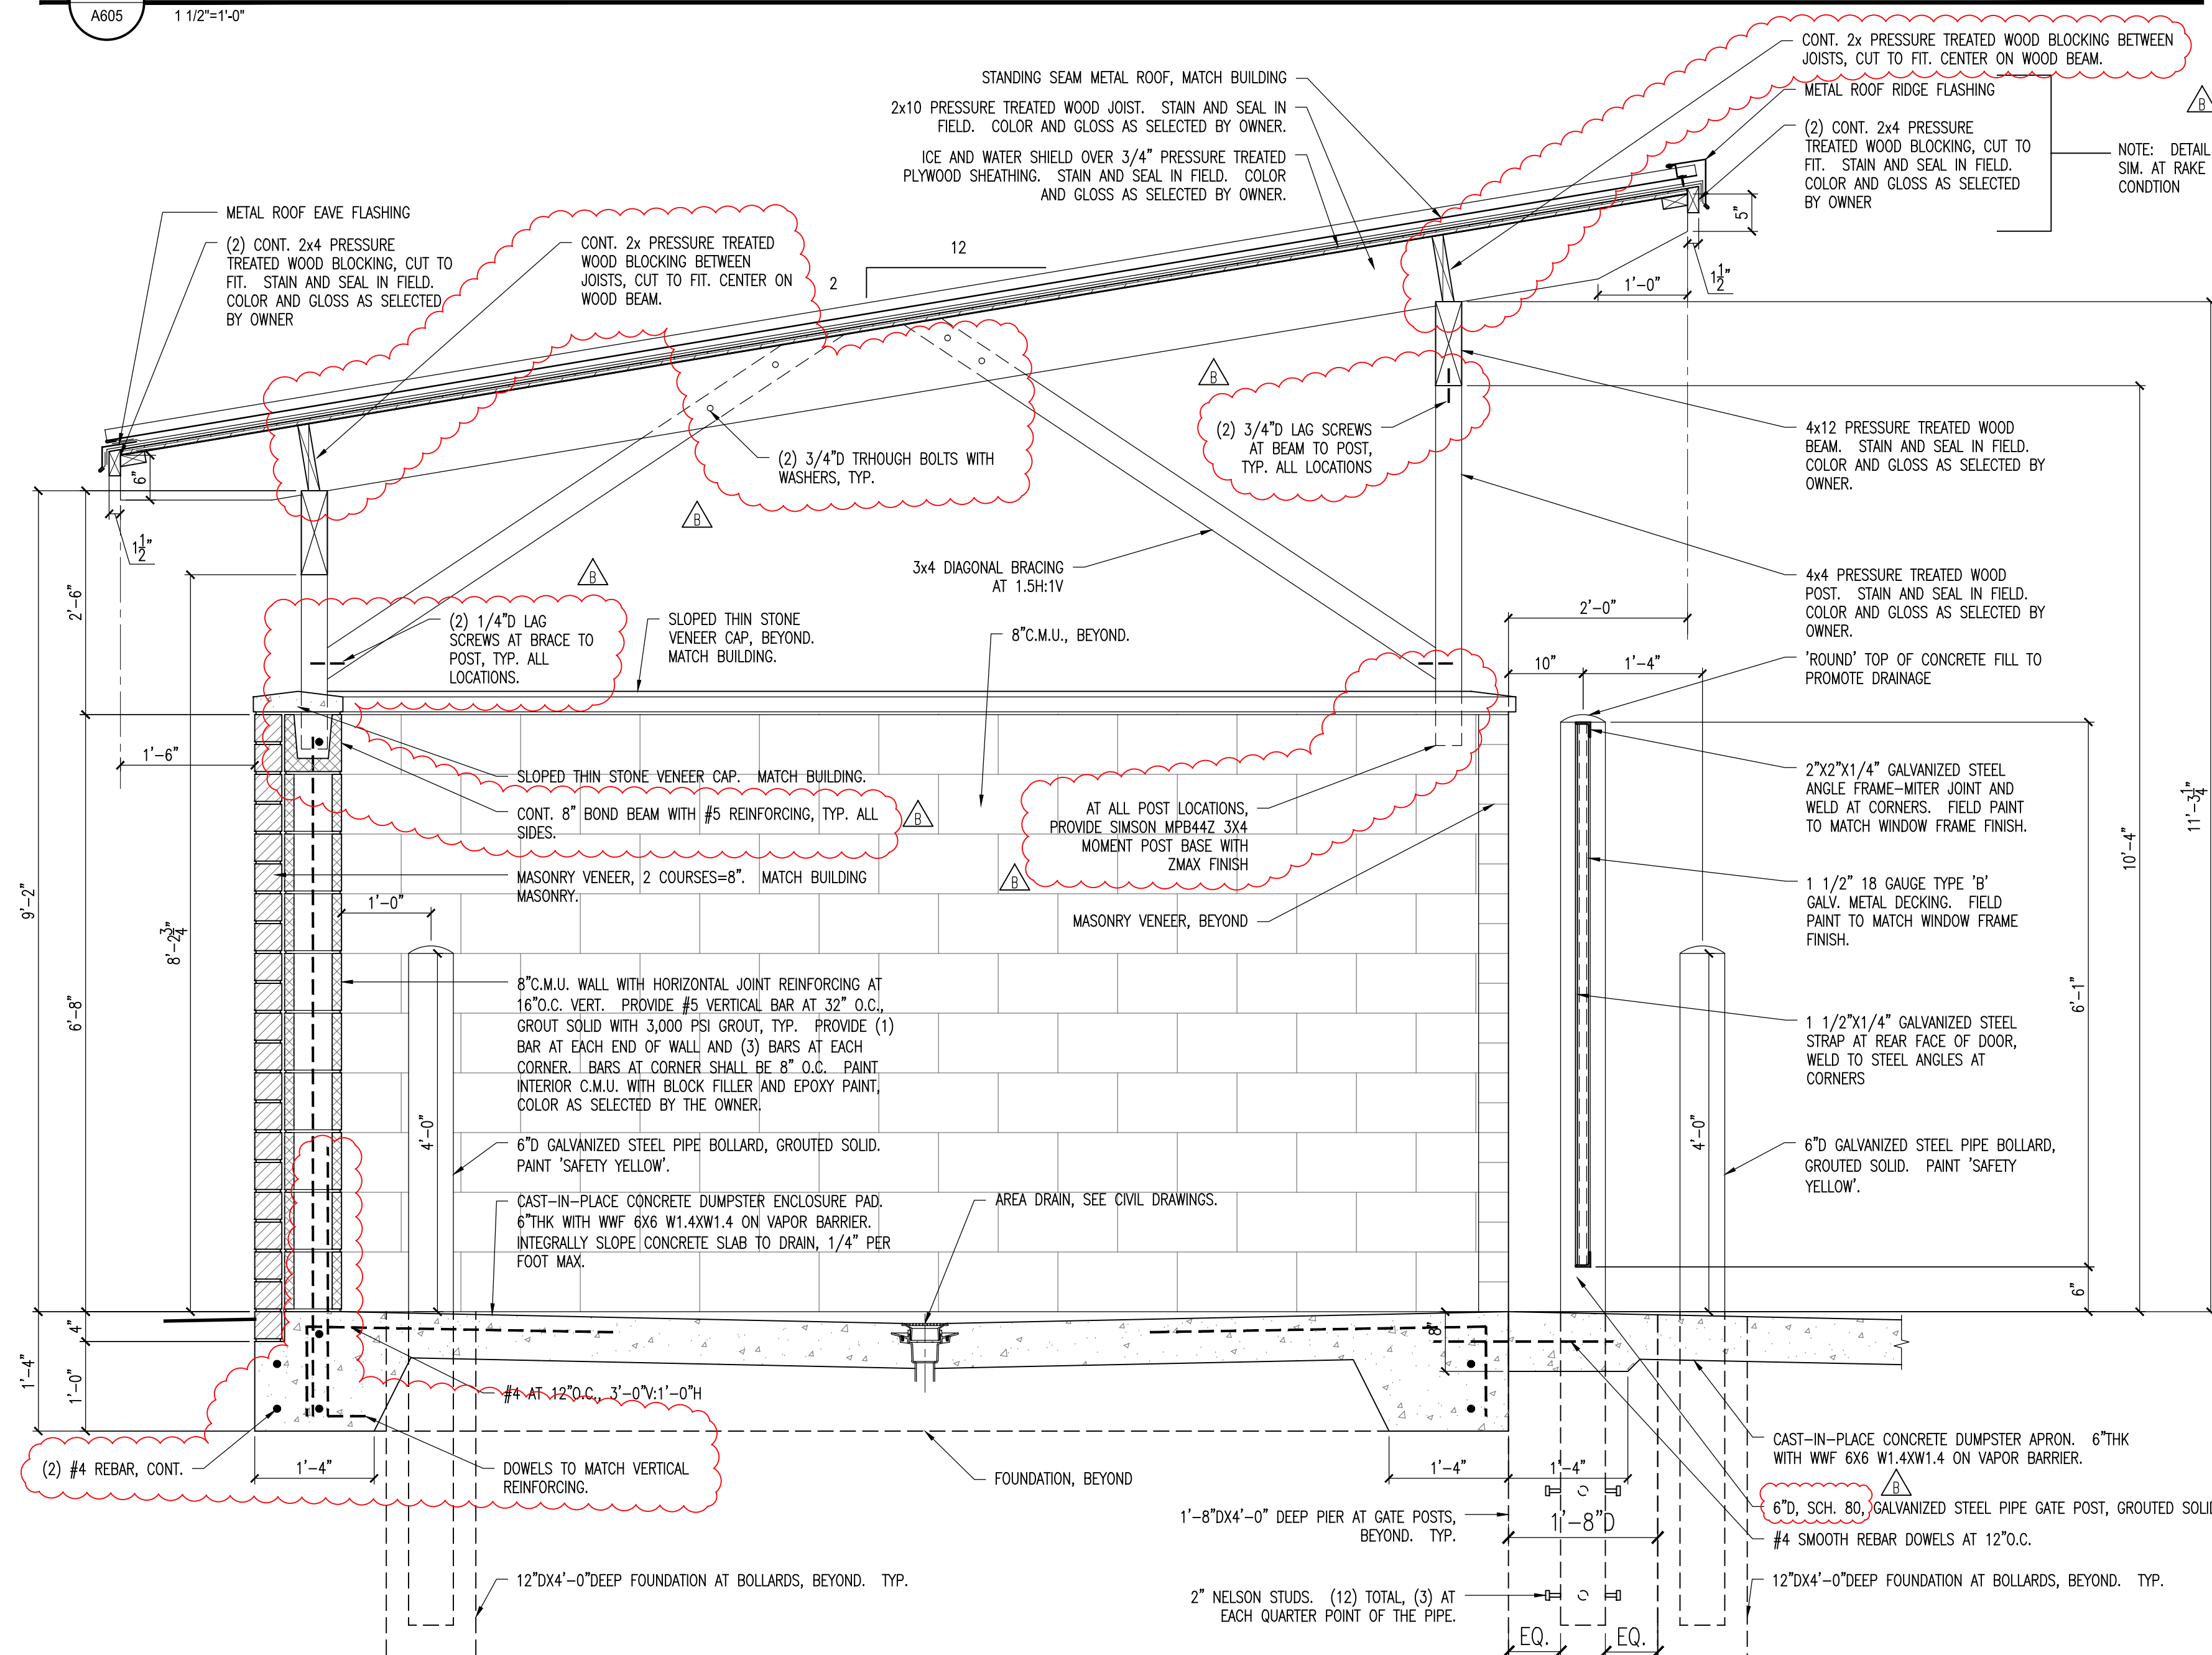

3 DUMPSTER ENCLOSURE SECTION

3/4"=1'-0"

No.	Description	Date
1	1. 1/2" 18 GAUGE TYPE 'B' GALVANIZED METAL DECKING TO MATCH BUILDING.	03-14-2022
2	2. 1/2" 18 GAUGE TYPE 'B' GALVANIZED METAL DECKING TO MATCH BUILDING.	03-14-2022
3	3. 1/2" 18 GAUGE TYPE 'B' GALVANIZED METAL DECKING TO MATCH BUILDING.	03-14-2022
4	4. 1/2" 18 GAUGE TYPE 'B' GALVANIZED METAL DECKING TO MATCH BUILDING.	03-14-2022
5	5. 1/2" 18 GAUGE TYPE 'B' GALVANIZED METAL DECKING TO MATCH BUILDING.	03-14-2022

DUMPSTER ENCLOSURE DETAILS

Proj #: 211201 Issue Date: 03-14-2022

Sheet No.: A605

Drawn By: KC Checked By: KC/SA

FIRST FLOOR DOOR SCHEDULE

MARK		SIZE				DOOR				FRAME					DETAILS					HARDWARE		NOTES	DOOR NUMBER	
DOOR NUMBER	ROOM NUMBER	WIDTH	HEIGHT	THK.	TYPE	MATERIAL	FINISH	GLOSS	GLAZING	TYPE	MATERIAL	FINISH	GLOSS	GLAZING	THRESHOLD	RATING LABEL	HEAD	JAMB	SILL	INT.	SET			FUNCTION
101A	101	PR. 3'-6"	8'-0"	2 1/4"	D3	WOOD	FS-TBD	FG-TBD	GLAZING 1TD	F4	WOOD	FS-TBD	FG-TBD	GLAZING 1T	ALUM.	---	2/A603	2/A603	2/A603	2/A603	1	PANIC HARDWARE	CASED OPENING ONLY - NO DOORS.	101A
101B	101	6'-0" CLR	8'-0" CLR	N.A.	N.A.	---	---	---	---	F4	WOOD	FS-TBD	FG-TBD	GLAZING 1T	---	---	3/820	3/820	3/820	3/820	---	N.A.	CASED OPENING ONLY - NO DOORS.	101B
104A	104	3'-10" CLR	7'-0" CLR	N.A.	N.A.	---	---	---	---	F5	WOOD	FS-TBD	FG-TBD	GLAZING 1T	---	---	1/A820 SIM.	1/A820 SIM.	1/A820 SIM.	---	---	N.A.	CASED OPENING ONLY - NO DOORS. CUT WOOD JAMBS TO FIT AT CIRC. 104 SIDE OF OPENING, KEEP CASED OPENING CENTERED ON CIRC. 104. MINIMUM REQUIRED CODE CLEARANCE IS 3'-8".	104A
104B	104	4'-8" CLR	7'-0" CLR	N.A.	N.A.	---	---	---	---	F5	WOOD	FS-TBD	FG-TBD	---	---	---	1/A820 SIM.	1/A820 SIM.	1/A820 SIM.	---	---	N.A.	CASED OPENING ONLY - NO DOORS. ADJUST OPENING WIDTH AS REQUIRED SO THAT FULL WOOD JAMB BOARDS ARE USED AT THE ALCOVE IN FRONT OF THE RESTROOM ENTRANCES. MINIMUM REQUIRED CODE CLEARANCE IS 3'-8".	104B
104C	104	3'-0"	7'-0"	1 3/4"	D1	GHM	FP-TBD	SEMIGLOSS	---	F1	GHM	FP-TBD	SEMIGLOSS	---	ALUM.	---	4/A602	4/A602	4/A602	---	2	PANIC HARDWARE		104C
105A	105	3'-0"	7'-0"	1 3/4"	D4	WOOD	FS-TBD	FG-TBD	---	F5	WOOD	FS-TBD	FG-TBD	---	---	---	1/A820	1/A820	1/A820	---	3	PUSH/PULL		105A
106A	106	3'-0"	7'-0"	1 3/4"	D4	WOOD	FS-TBD	FG-TBD	---	F5	WOOD	FS-TBD	FG-TBD	---	---	---	1/A820	1/A820	1/A820	---	4	CLASSROOM		106A
107A	107	3'-0"	7'-0"	1 3/4"	D4	WOOD	FS-TBD	FG-TBD	---	F5	WOOD	FS-TBD	FG-TBD	---	---	---	1/A820	1/A820	1/A820	---	3	PUSH/PULL		107A
108A	108	3'-0"	7'-0"	1 3/4"	D4	WOOD	FS-TBD	FG-TBD	---	F5	WOOD	FS-TBD	FG-TBD	---	---	---	1/A820	1/A820	1/A820	---	5	CLASSROOM		108A
109A	109	3'-0"	7'-0"	1 3/4"	D4	WOOD	FS-TBD	FG-TBD	---	F5	WOOD	FS-TBD	FG-TBD	---	---	---	1/A820	1/A820	1/A820	---	6	OFFICE		109A
110A	110	3'-8"	9'-3 1/4"	N.A.	N.A.	---	---	---	---	F5	WOOD	FS-TBD	FG-TBD	---	---	---	1/A820 SIM.	1/A820 SIM.	1/A820 SIM.	---	---	N.A.	CASED OPENING ONLY-NO DOORS. HOLD 3'-8" CLEAR.	110A
110B	110	3'-8"	9'-3 1/4"	N.A.	N.A.	---	---	---	---	F5	WOOD	FS-TBD	FG-TBD	---	---	---	1/A820 SIM.	1/A820 SIM.	1/A820 SIM.	---	---	N.A.	CASED OPENING ONLY-NO DOORS. HOLD 3'-8" CLEAR.	110B
111A	111	3'-0"	7'-0"	MANUF.	D5	STAINLESS STEEL	BRUSHED S.S.	---	ACRYLIC	F6	WOOD, STAINLESS STEEL	BRUSHED S.S./FS-TBD	---	---	---	---	2/A820	2/A820	2/A820	---	7	PUSH BI-SWING	ALL HARDWARE BY DOOR MANUFACTURER	111A
111B	111	3'-0"	7'-0"	MANUF.	D5	STAINLESS STEEL	BRUSHED S.S.	---	ACRYLIC	F6	WOOD, STAINLESS STEEL	BRUSHED S.S./FS-TBD	---	---	---	---	2/A820	2/A820	2/A820	---	7	PUSH BI-SWING	ALL HARDWARE BY DOOR MANUFACTURER	111B
111C	111	3'-0"	7'-0"	MANUF.	D5	STAINLESS STEEL	BRUSHED S.S.	---	ACRYLIC	F6	WOOD, STAINLESS STEEL	BRUSHED S.S./FS-TBD	---	---	---	---	2/A820	2/A820	2/A820	---	7	PUSH BI-SWING	ALL HARDWARE BY DOOR MANUFACTURER	111C
111D	111	3'-0"	7'-0"	1 3/4"	D1	GHM	FP-TBD	SEMIGLOSS	---	F1	GHM	FP-TBD	SEMIGLOSS	---	ALUM.	---	4/A602	4/A602	4/A602	---	2	PANIC HARDWARE		111D
113A	113	PR. 2'-0"	7'-0"	1 3/4"	D4	WOOD	FS-TBD	FG-TBD	---	F5	WOOD	FS-TBD	FG-TBD	---	---	---	1/A820 SIM.	1/A820 SIM.	1/A820 SIM.	---	8	BI-FOLD CLOSET		113A
114A	114	3'-0"	7'-0"	2 1/4"	D2	ALU. S.F.E.-T.B.	MATTE BLACK	MANUF.	GLAZING 1TD	F2	ALUM. S.F.-T.B.	MATTE BLACK	MANUF.	GLAZING 1TD	ALUM.	---	3/A602	3/A602	3/A602	3/A602	9	PUSH/PULL		114A
114B	114	3'-0"	7'-0"	2 1/4"	D2	ALU. S.F.E.-T.B.	MATTE BLACK	MANUF.	GLAZING 1TD	F2	ALUM. S.F.-T.B.	MATTE BLACK	MANUF.	GLAZING 1TD	ALUM.	---	3/A602	3/A602	3/A602	3/A602	9	PUSH/PULL		114A

ROOFTOP PATIO DOOR SCHEDULE

MARK		SIZE			DOOR					FRAME							DETAILS				HARDWARE			
DOOR NUMBER	ROOM NUMBER	WIDTH	HEIGHT	THK.	TYPE	MATERIAL	FINISH		GLAZING	TYPE	MATERIAL	FINISH	GLOSS	GLAZING	THRESHOLD	RATING LABEL	HEAD	JAMB	SILL	INT.	SET	FUNCTION	NOTES	DOOR NUMBER
R01A	R01	3'-0"	7'-2"	2 1/4"	D2	ALUM S.F.E.-T.B.	MATTE BLACK	MANUF.	1TD	F3	ALUM S.F.-T.B.	MATTE BLACK	MANUF.	1TD	ALUM.	---	1/A603	1/A603	1/A603	---	10	PUSH/PULL WHEN OCCUPIED. DEADBOLTED WHEN UNOCCUPIED.	CONFIRM HARDWARE OPERATION IS ACCEPTABLE TO THE AUTHORITY HAVING JURISDICTION PRIOR TO ORDERING.	R01A
R01B	R01	3'-0"	VERIFY	1 1/4"	N.A.	---	---	---	---	N.A.	---	---	--	---	---	---	BY RAILING FABRICATOR	BY RAILING FABRICATOR	BY RAILING FABRICATOR	---	11	PUSH/PULL WITH MAGNETIC CATCH PAD	METAL GATE IN GUARDRAIL. SEE GUARDRAIL DETAILS. MAGNETIC CATCHPAD REQUIRES NO SPECIAL OPERATION TO RELEASE. IT IS SIMPLY TO HOLD THE GATE SHUT IN NORMAL OPERATION, SIMILAR TO A KITCHEN CABINET LATCH. FREE EGRESS ALWAYS PERMITTED. COORDINATE WITH RAILING FABRICATOR.	R01B

ABBREVIATIONS

ALUM. ALUMINUM
ALUM. S.F.-T.B. ALUMINUM STOREFRONT-THERMALLY BROKEN
ALUM. S.F.E.-T.B.D ALUMINUM STOREFRONT ENTRANCE-THERMALLY BROKEN
FG-TBD FIELD GLOSS - TO BE DETERMINED. AS SELECTED BY OWNER.
FP-TBD FIELD PAINTED - TO BE DETERMINED. AS SELECTED BY OWNER.
FS-TBD FILED STAINED - TO BE DETERMINED. AS SELECTED BY OWNER.
GHM GALVANIZED HOLLOW METAL
MANUF. MANUFACTURER STANDARD
S.S. STAINLESS STEEL

DOOR HARDWARE SETS

THE FOLLOWING INFORMATION IS A HARDWARE OUTLINE INDICATING THE MINIMUM REQUIREMENTS FOR THE PROJECT. THE CONTRACTOR SHALL PROVIDE A COMPLETE HARDWARE SPECIFICATION FOR REVIEW BY THE ARCHITECT AND THE OWNER. CONTRACTOR SHALL NOT ORDER MATERIALS OR PROCEED WITH THE DOOR WORK UNTIL BOTH PARTIES HAVE APPROVED THE HARDWARE.

MANUFACTURERS AND PRODUCTS SHALL BE CONSIDERED TO THE NAMED PRODUCTS BELOW, PROVIDED THEY MEET THE REQUIREMENTS OF THE PROJECT.

- HINGES: MES ARCHITECTURAL HINGES.
- SPRING HINGES: MES 3SP1, 3 KNUCKLE SPRING FULL MORTISE HINGE.
- CYLINDER LOCKSETS: FALCON T SERIES WITH ADA-COMPLIANT LEVER HANDLES. BOARDWALK LEVER STYLE.
- MORTISE LOCKSETS: FALCON MA SERIES WITH ADA-COMPLIANT LEVER HANDLES. BOARDWALK LEVER STYLE.
- EXIT DEVICES: FALCON 24/25 SERIES. BOARDWALK LEVER STYLE, WHERE LEVER HANDLE IS INDICATED.
- CLOSERS: FALCON SC70A SERIES.
- DOOR PULLS- LONG BAR TYPE (ENTRANCE DOORS AND PATIO DOORS): MES 9266, 3/8", 1 1/4"D.
- DOOR PULLS-BAR AND PLATE TYPE (RESTROOMS): MES 8303-10, 1/2" PLATE SIZE AS INDICATED.
- DOOR PUSH PLATES: MES.
- PROTECTION PLATES: MES.
- CONCEALED FLUSH BOLTS: MES.
- WALL STOPS: MES.
- FLOOR STOPS-NO THRESHOLD: MES, FS436.
- FLOOR STOPS-THRESHOLD OR UNDERCUT DOORS: MES, FS438.
- SWEEPS: ZERO INTERNATIONAL.
- GASKETING: ZERO INTERNATIONAL.
- DOOR VIEWER: MES ONE-WAY WIDE ANGLE VIEWER, U688.
- LOCK GUARDS: MES.
- RECESSED DOOR PULL: MES 960.

GENERAL REQUIREMENTS

- CONFIRM ALL HARDWARE, OPERATIONS/FUNCTIONS, AND FINISHES WITH OWNER PRIOR TO ORDERING.
- CONFIRM KEYING SYSTEM REQUIREMENTS AND LEVELS WITH OWNER PRIOR TO ORDERING.
- ALL DOOR HARDWARE SHALL BE GRADE B/MA 1.
- PROVIDE (1) NEW KEYBOX WITH (5) COPIES MIN. OF ALL NEW KEYS AND ALL EXISTING KEYS IN THE ARE OF WORK.
- COORDINATE ALL FLOOR STOPS WITH DOOR UNDERCUTS AND THE REQUIREMENTS OF THE DOOR MANUFACTURER.

HARDWARE SET 1 (PAIR MAIN ENTRANCE DOORS)

- (8) STAINLESS STEEL, BALL BEARING, 5 KNUCKLE HINGES WITH NON-REMOVABLE PIN.
- (2) NEW SURFACE MOUNTED EXIT DEVICES (PANIC HARDWARE) WITH CYLINDER DOGGING. ENTRANCE LOCK FUNCTION AT EXTERIOR SIDE OF DOOR. NO EXTERIOR TRIM, JUST ESCUTCHEON AND CYLINDER/LOCK.
- (2) SURFACE MOUNTED VERTICAL RODS, TOP AND BOTTOM. RODS SHALL HOLD RETRACTED WHEN EXIT DEVICES ARE DOGGED.
- (2) VERTICAL LONG BAR TYPE PULL HANDLES, PULL SIDE OF DOOR. LOCATE PULLS SUCH THAT THE PULLS CLEAR THE CYLINDER FOR OPERATION BUT REMAIN IN ADA REACH RANGES.
- (2) PUSH PLATES, PUSH SIDE OF DOOR. PLATES SHALL BE 16"H x WIDTH OF DOOR RAIL, LESS 1/2".
- (2) SURFACE MOUNTED CLOSERS WITH INTEGRAL STOPS, INTERIOR SIDE OF DOOR.
- (1) PERIMETER GASKET.
- (1) EDGE MOUNT BRUSH TYPE ASTRAGAL.
- (1) FLAT SADDLE THRESHOLD.
- (2) CYLINDERS.
- (4) KICK PLATES, (2) EACH SIDE OF DOOR. KICK PLATES SHALL BE HEIGHT OF BOTTOM RAIL, LESS 1/2" x WIDTH OF DOOR, LESS 1/2".

HARDWARE SET 2 (REAR EXIT DOORS)

- (3) STAINLESS STEEL, BALL BEARING, 5 KNUCKLE HINGES WITH NON-REMOVABLE PIN.
- (1) SURFACE MOUNTED EXIT DEVICE. PROVIDE WITH ENTRANCE FUNCTION AND EXTERIOR LEVER HANDLE.
- (1) SURFACE MOUNTED CLOSER, INTERIOR SIDE OF DOOR.
- (1) PERIMETER GASKET.
- (1) DOOR SWEEP.
- (1) FLAT SADDLE THRESHOLD.
- (1) DOOR VIEWER. MOUNT AT 60" A.F.F. TO CENTERLINE OF VIEWER.
- (1) KICK PLATE. PLATE SHALL BE 10"H x WIDTH OF DOOR, LESS 1/2".
- (1) DOOR LOCK GUARD.
- (1) CYLINDER.

HARDWARE SET 3 (RESTROOMS)

- (3) 5 KNUCKLE HINGES.
- (1) PUSH PLATE, PUSH SIDE OF DOOR. PUSH PLATE SHALL BE 16"H x WIDTH OF STILE, LESS 1/2".
- (1) DOOR PULL WITH PLATE, PULL SIDE OF DOOR. PLATE SHALL BE 16"H x WIDTH OF STILE, LESS 1/2".
- (1) CLOSER.
- (1) WALL STOP.
- (1) SET DOOR SILENCERS.
- (2) KICK PLATES, (1) EACH SIDE OF DOOR. KICK PLATES SHALL BE HEIGHT OF BOTTOM RAIL, LESS 1/2" x WIDTH OF DOOR, LESS 1/2".

HARDWARE SET 4 (JANITORS)

- (3) 5 KNUCKLE HINGES.
- (1) CLASSROOM LOCKSET.
- (1) WALL STOP.
- (1) SET DOOR SILENCERS.
- (1) KICK PLATE, CIRCULATION SIDE OF DOOR. KICK PLATES SHALL BE HEIGHT OF BOTTOM RAIL, LESS 1/2" x WIDTH OF DOOR, LESS 1/2".
- (1) PROTECTION PLATE, JANITOR'S CLOSET SIDE OF DOOR. PROTECTION PLATE SHALL BE HEIGHT OF DOOR TO TOP OF INTERMEDIATE RAIL, LESS 1/2" x WIDTH OF DOOR, LESS 1/2". CONTRACTOR SHALL PROVIDE FIRE RETARDANT TREATED MARINE GRADE PLYWOOD INFILL PANEL AT BOTTOM PANEL OF DOOR, JANITORS CLOSET SIDE OF DOOR. PROVIDE IN THICKNESS TO FLUSH OUT WITH THE STILE AND RAILS. GLUE INTO EXISTING DOORS, DO NOT USE FASTENERS.
- (1) CYLINDER.

HARDWARE SET 5 (STORE ROOM)

- (3) 5 KNUCKLE HINGES.
- (1) CLASSROOM LOCKSET.
- (1) CLOSER.
- (1) FLOOR STOP.
- (1) SET DOOR SILENCERS.
- (2) KICK PLATES, (1) EACH SIDE OF DOOR. KICK PLATES SHALL BE HEIGHT OF BOTTOM RAIL, LESS 1/2" x WIDTH OF DOOR, LESS 1/2".
- (1) CYLINDER.

HARDWARE SET 6 (OFFICE)

- (3) 5 KNUCKLE HINGES.
- (1) CLASSROOM LOCKSET.
- (1) CLOSER.
- (1) WALL STOP.
- (1) SET DOOR SILENCERS.
- (2) KICK PLATES. KICK PLATES SHALL BE HEIGHT OF BOTTOM RAIL, LESS 1/2" x WIDTH OF DOOR, LESS 1/2".
- (1) CYLINDER.

HARDWARE SET 7 (BI-SWING KITCHEN DOORS)

NOTE: CONFIRM OFFSET PIVOT HINGE DOES NOT IMPEDE REQUIRED 32" CLEAR DIMENSION WITH THE DOOR IN THE 90 DEGREE OPEN POSITION. VERIFY PRIOR TO ORDERING. ADJUST SIZE AS REQUIRED, COORDINATE WITH KITCHEN EQUIPMENT LAYOUT.

- (1) LOWER HINGE ASSEMBLY AND JAMB GUARD, BY DOOR MANUFACTURER.
- (1) INTEGRATED CLOSER.
- (1) UPPER HINGE ASSEMBLY AND COVER, BY DOOR MANUFACTURER.
- (2) FLOOR STOPS, BY CONTRACTOR. COORDINATE FLOOR STOP LOCATIONS WITH ADJACENT AND EQUIPMENT AND DOORS. VERIFY IN FIELD.
- ** AT DOOR 111B, SERVICE LINE 110 SIDE OF DOOR. A WALL STOP MOUNTED TO THE INTERMEDIATE RAIL OF DOOR 113A MAY BE PREFERRED, VERIFY IN FIELD.
- ** AT DOOR 111C, CIRC. 104 SIDE OF DOOR, DOOR STOP LOCATION AND ANGLE SHALL BE SET WITH THE DOOR OPEN TO WITHIN 2" OF THE ADJACENT OUTSIDE WALL CORNER.

HARDWARE SET 8 (BI-FOLD STORAGE DOORS)

- (1) DOOR HEAD TRACK AND CARRIERS ASSEMBLY, LENGTH AS REQUIRED.
- (1) TOP PIVOT.
- (1) BOTTOM PIVOT.
- (1) ROLLER ASSEMBLY.
- (3) BI-FOLD DOOR HINGES.
- (1) RECESSED DOOR PULL.

HARDWARE SET 9 (FIRST FLOOR PATIO DOORS)

- (3) STAINLESS STEEL, BALL BEARING, 5 KNUCKLE HINGES WITH NON-REMOVABLE PIN.
- (1) VERTICAL LONG BAR TYPE PULL HANDLE, PULL SIDE OF DOOR. LOCATE PULLS SUCH THAT THE PULLS REMAIN IN ADA REACH RANGES.
- (1) PUSH PLATE, PUSH SIDE OF DOOR. PLATES SHALL BE 16"H x WIDTH OF DOOR RAIL, LESS 1/2".
- (1) SURFACE MOUNTED CLOSER WITH INTEGRAL STOP, INTERIOR SIDE OF DOOR.
- (1) PERIMETER GASKET.
- (1) EDGE MOUNT BRUSH TYPE ASTRAGAL.
- (1) DOOR SWEEP.
- (1) FLAT SADDLE THRESHOLD.

HARDWARE SET 10 (ROOFTOP PATIO STAIR DOOR)

NOTE: CONFIRM HARDWARE OPERATION IS ACCEPTABLE TO THE AUTHORITY HAVING JURISDICTION PRIOR TO ORDERING.* REVIEW AS SOON AS POSSIBLE AS THIS IS CRITICAL TO BUILDING OPERATION

THE ORIGINAL DRAWINGS HAD AN EMERGENCY EGRESS EXIT DEVICE (PANIC HARDWARE) MOUNTED ON THE EXTERIOR SIDE OF THE DOOR WHICH WOULD HAVE ALLOWED FREE ACCESS TO THE INTERIOR OF THE BUILDING AT ALL TIMES, INCLUDING WHEN THE BUILDING IS UNOCCUPIED. THIS IS NOT ACCEPTABLE FROM A SECURITY AND NIGHT-TIME SAFETY STANDPOINT.

THE INTENT IS THAT THE DOOR IS AN ELECTRONIC LOCKSET. WHEN THE BUILDING IS OCCUPIED, THE DOOR WILL FUNCTION AS A PASSAGE SET, ALLOWING FREE ACCESS FROM BOTH SIDES OF THE DOOR. WHEN THE BUILDING IS UNOCCUPIED, THE ELECTRIC LOCKSET WILL LOCK AT EXTERIOR, SECURING THE BUILDING. FREE EGRESS IS STILL PROVIDED FROM THE ROOFTOP PATIO VIA THE RAILING GATE AND EXTERIOR STAIR.

ALL HARDWARE BY DOOR FABRICATOR

- (1) SOHLGAE ELECTRIC LOCKSET L5092P, 12V/24V POWER.
- (3) STAINLESS STEEL, BALL BEARING, 5-KNUCKLE HINGES WITH NON-REMOVABLE PIN.
- (1) STAINLESS STEEL POWER TRANSFER HINGE. VON DUHRN EP710 SP28
- (1) CLOSER WITH BUILT IN STOP, INTERIOR SIDE OF DOOR.
- (1) PERIMETER GASKETING.
- (1) SWEEP.
- (1) FLAT SADDLE THRESHOLD.
- (1) CYLINDER. CYLINDER IS INCLUDED WITH LOCK, IF PANIC HARDWARE IS USED THEN A RIM CYLINDER IS REQUIRED.
- (1) POWER SUPPLY. SCHLAGE PS802. POWER SUPPLY SHALL STEP DOWN POWER FROM 120V CIRCUIT.
- (1) SECURITY PANEL FOR PROGRAMMING THE DOOR. LOCATE IN THE MANAGERS OFFICE.

NOTES

- PROVIDE THE FOLLOWING SIGNAGE ON THE DOOR, IN 10"H DIE-CUT VINYL LETTERS, MOUNTED TO THE GLASS - "THIS DOOR SHALL REMAIN UNLOCKED DURING THE HOURS OF OPERATION".
- DURING THE HOURS OF OPERATION, THE DOOR SHALL FAIL SAFE AND FUNCTION AS A PASSAGE SET WITH POSITIVE LATCHING. NO SPECIAL OPERATION SHALL BE REQUIRED TO RELEASE THE DOOR.
- DURING HOURS OTHER THAN THE HOURS OF OPERATION, THE DOOR SHALL FAIL SECURE. DOOR SHALL REMAIN LATCHED IN EVENT OF A LOSS OF POWER OR ACTIVATION OF THE FIRE ALARM SYSTEM.

HARDWARE SET 11 (ROOFTOP PATIO GATE)

- (3) SPRING HINGES.
- (1) STOP PLATE (BY GATE FABRICATOR).
- (1) SET ADHESIVE DOOR SILENCERS.
- (1) SET OF MAGNETIC CATCHES (BY GATE FABRICATOR).

NOTE: GATE HAS NO LOCKING MECHANISM, IT IS SIMPLE PUSH/PULL OPERATION. FREE EGRESS IS ALWAYS PERMITTED.

GENERAL DOOR NOTES


- FIELD VERIFY ALL DIMENSIONS, COMPLY WITH DESIGN INTENT SHOWN IN THE DRAWINGS. NOTIFY THE ARCHITECT OF ANY SIGNIFICANT DISCREPANCIES PRIOR TO PROCEEDING WITH THE WORK. COORDINATE ALL WORK WITH RELATED (SUB)CONTRACTORS.
- DOOR NUMBERS ARE DIRECTLY ASSOCIATED WITH THE ROOM NUMBERS. THERE ARE JUMPS IN THE DOOR NUMBERING DUE TO ROOMS WITH NO DOORS IN THEM OR UNUSED ROOM NUMBERS.
- ALL EXTERIOR HOLLOW METAL DOORS AND FRAMES SHALL BE HOT DIPPED GALVANIZED AND SHOP PRIMED. INSULATE ALL EXTERIOR HOLLOW METAL DOORS. GROUT EXTERIOR HOLLOW METAL FRAMES SOLID.
- ALL INTERIOR HOLLOW METAL DOORS AND FRAMES SHALL BE SHOP PRIMED.
- ALARM LOCKS, DELAYED EGRESS LOCKS, AND PANIC HARDWARE LOCATIONS SHALL BE APPROVED BY THE LOCAL AUTHORITY HAVING JURISDICTION.
- ALL DOORS, DOOR FRAMES, AND DOOR HARDWARE SHALL BE ADA COMPLIANT, ALL LOCKSET DOOR HANDLES SHALL BE LEVER TYPE. SEE ACCESSIBILITY STANDARDS FOR ADA DOOR/DOOR OPERATION REQUIREMENTS.
- PROVIDE SILENCERS AT ALL HOLLOW METAL DOOR FRAMES.
- PROVIDE SWEEPS AND GASKETS AT ALL RATED DOORS, AS REQUIRED BY CODE.
- WHERE REQUIRED BY PANED DOOR OPERATION, PROVIDE A DOOR COORDINATOR.
- ALL DOORS SHALL BE OPENABLE FROM THE INTERIOR OF A ROOM OR SPACE WITHOUT THE USE OF A KEY, SPECIAL KNOWLEDGE, OR SPECIAL EFFORT.
- EGRESS DOORS SHALL SWING IN THE DIRECTION OF EGRESS TRAVEL WHEN SERVING WHEN SERVING AN OCCUPANT LOAD OF 50 OR GREATER.
- EGRESS DOORS MAY SWING IN EITHER DIRECTION WHERE THE OCCUPANT LOAD IS LESS THAN 50.
- ALL LATCHING EGRESS DOORS SHALL HAVE EXIT DEVICES (PANIC HARDWARE) OR A DEADLATCH WIT A PADDLE OPERATOR AS NOTED IN THE HARDWARE SCHEDULE.
- DOORS INDICATED AS PUSH/PULL ARE FREE SWINGING AND DO NOT HAVE LATCHES.
- CONTRACTOR SHALL PREPARE A HARDWARE SCHEDULE, AND HARDWARE PRODUCT DATA, FOR REVIEW BY THE ARCHITECT PRIOR TO ORDERING DOORS, FRAMES, AND HARDWARE.
- CONTRACTOR SHALL COORDINATE ALL HARDWARE WITH DOOR SIZES LISTED IN THE DOOR SCHEDULE.
- CONTRACTOR SHALL COORDINATE FINAL NEW HARDWARE SELECTION AT EXISTING DOORS TO REMAIN WITH THE EXISTING DOOR PREP - V.I.F.
- ALL ALUMINUM STOREFRONT AND CURTAINWALL FRAMES SHALL BE DESIGNED FOR STRUCTURAL ADEQUACY WITH WIND LOADS AS REQUIRED BY LOCAL APPLICABLE CODE AND PER THE LOAD INFORMATION PROVIDED IN THE STRUCTURAL DRAWINGS. GLAZING SUBCONTRACTOR IS RESPONSIBLE FOR PROVIDING SHOP DRAWINGS AND NECESSARY CALCULATIONS TO CONFIRM DESIGN ADEQUACY. WHERE REQUIRED BY THE LOCAL AUTHORITY HAVING JURISDICTION, CONTRACTOR SHALL SUBMIT SHOP DRAWINGS SEALED BY A LOCALLY LICENSED STRUCTURAL ENGINEER TO THE LOCAL AUTHORITY FOR APPROVAL.
- HAZARDOUS GLAZING LOCATIONS, PROVIDE FULLY TEMPERED GLASS (SAFETY GLASS):
- ALL GLAZING IN DOORS.
- GLAZING IN WINDOWS ADJACENT TO A DOOR: WHERE THE GLAZING IS WITHIN A 24" ARC OF EITHER VERTICAL EDGE OF THE DOOR IN THE CLOSED POSITION AND WHERE THE BOTTOM EXPOSED EDGE OF THE GLAZING IS LESS THAN 60" ABOVE THE WALKING SURFACE.
- GLAZING IN WINDOWS MEETING ALL THE FOLLOWING CRITERIA:
 - 18.3.1. THE EXPOSED AREA OF THE INDIVIDUAL PANEL IS GREATER THAN 9 S.F.
 - 18.3.2. THE BOTTOM EDGE OF THE GLAZING IS LESS THAN 18" A.F.F.
 - 18.3.3. THE TOP EDGE OF THE GLAZING IS GREATER THAN 36" A.F.F.
 - 18.3.4. ONE OR MORE WALKING SURFACES ARE WITHIN 36" MEASURED HORIZONTALLY AND IN A STRAIGHT LINE, OF THE PLANE OF THE GLAZING.
- COORDINATE ALL WINDOW ROUGH OPENING DIMENSIONS AND FRAMING REQUIREMENTS WITH THE DOOR MANUFACTURER'S WRITTEN REQUIREMENTS, THE SUBSTRATE CONSTRUCTION, AND THE ADJACENT FINISH MATERIALS.
- COORDINATE ALL DOOR SILL CONDITIONS, AND FLOOR FINISH TRANSITIONS WITH THE I.D. DRAWINGS.
- CONTRACTOR SHALL PROVIDE DOOR SYSTEMS AND GLAZING PRODUCTS MEETING THE REQUIREMENTS OF THE CONSTRUCTION DOCUMENTS AND LOCAL ENERGY CODE REQUIREMENTS.

MINIMUM ENERGY CODE BUILDING ENVELOPE FENESTRATION MINIMUM REQUIREMENTS


- PROJECT IS IN CLIMATE ZONE 3.
- OPAQUE DOORS: U=0.61.
- FIXED FENESTRATION: U=0.46.
- OPERABLE FENESTRATION: U=0.60.
- ENTRANCE DOORS: U=0.77.
- SOLAR HEAT GAIN COEFFICIENT:
 - 6.1. NORTH ORIENTATION, PF<0.2: 0.33.
 - 6.2. SOUTH, EAST, AND WEST ORIENTATION, PF<0.2: 0.25.

No.	Description	Date
1	DO SET	03-14-2022
2	DOOR SCHEDULE	03-14-2022


Sheet Name: DOOR SCHEDULE	
Proj No: 211201	Issue Date: 03-14-2022
Sheet No.: A801	
Drawn By: KC	Checked By: KC/SA

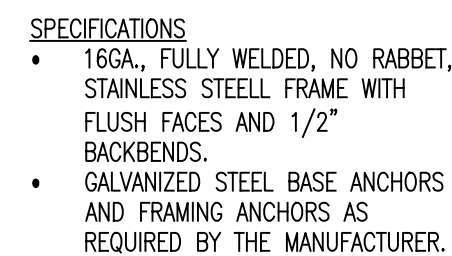


FRAME TYPE 'F7'
INTERIOR WALK-IN CASED OPENING

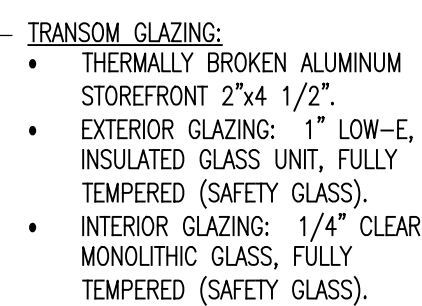


FRAME TYPE 'F4'
EXTERIOR WOOD DOOR FRAME

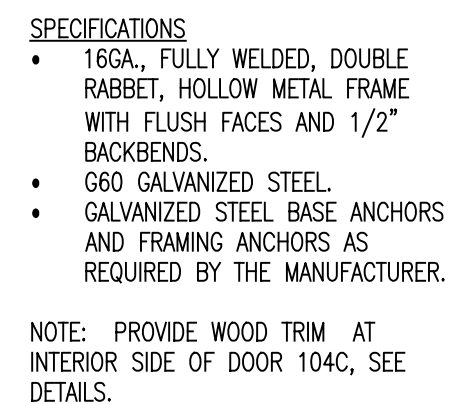


FRAME TYPE 'F1'
EXTERIOR HOLLOW METAL FRAME

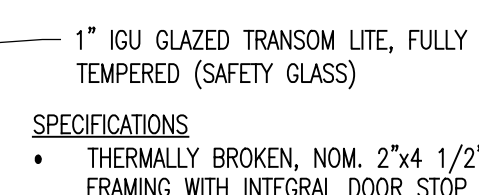


FRAME TYPE 'F2'
EXTERIOR ALUMINUM ENTRANCE DOOR FRAME WITH TRANSOM

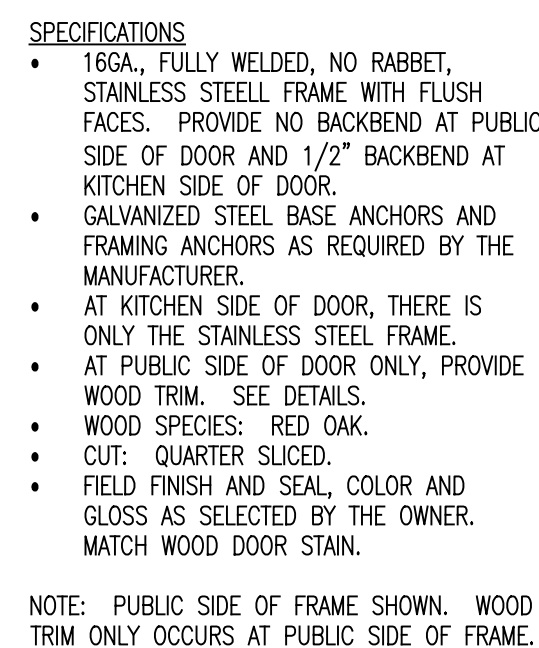


FRAME TYPE 'F6'
INTERIOR KITCHEN DOOR FRAME

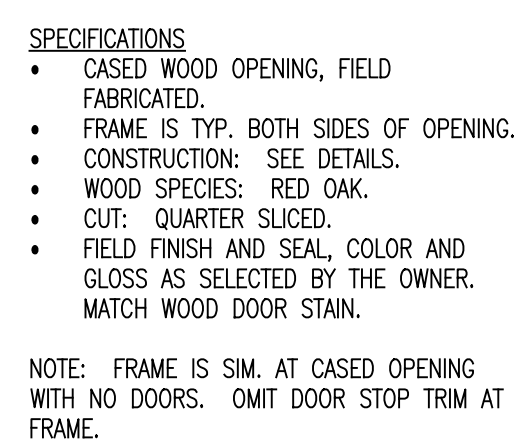


FRAME TYPE 'F5'
INTERIOR WOOD DOOR FRAME

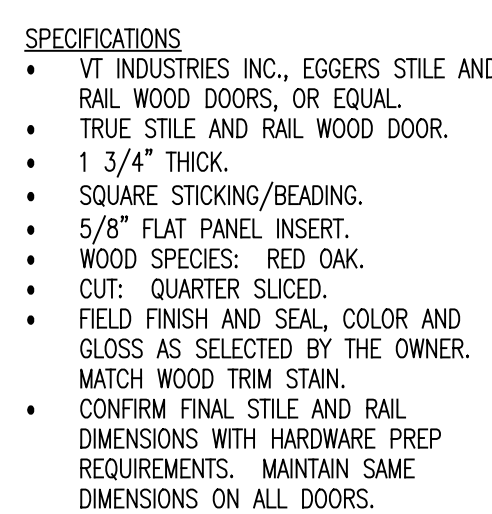


DOOR TYPE 'D4'
INTERIOR STILE AND RAIL WOOD DOOR

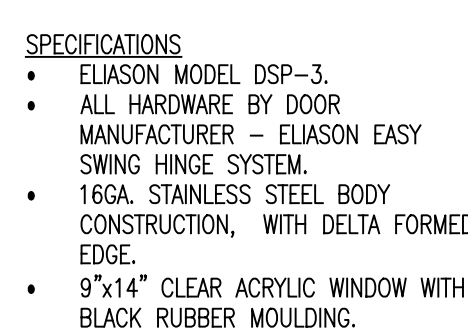

DOOR TYPE 'D5'
STAINLESS STEEL KITCHEN DOOR

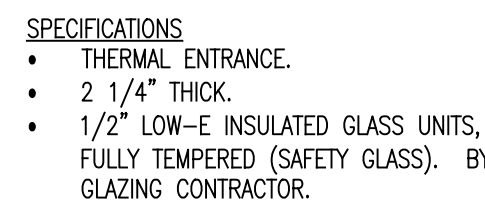

DOOR TYPE 'D2'
EXTERIOR ALUMINUM ENTRANCE DOOR

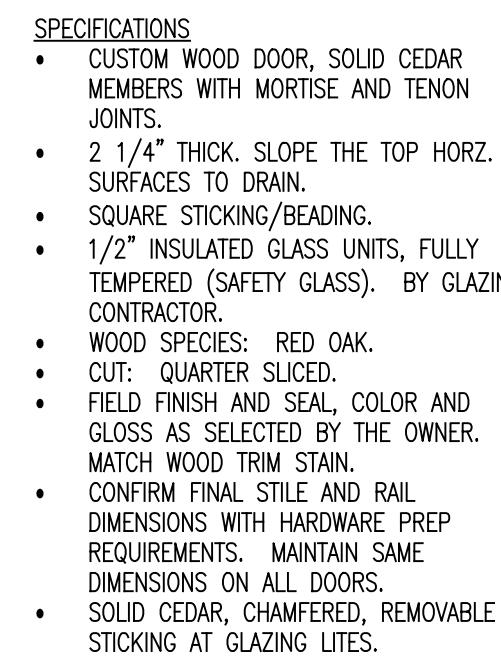


DOOR TYPE 'D3'
EXTERIOR STILE AND RAIL WOOD DOOR

FRAME TYPES

DOOR TYPES


1. NOT ALL ITEMS MAY BE USED.
2. DIMENSIONS ARE TAKEN TO FACE OF STUD, FACE OF MASONRY OR CONCRETE , OR COLUMN CENTERLINE, UNLESS INDICATED OTHERWISE.
3. CONTRACTOR SHALL COORDINATE STUD FRAMING LAYOUT TO ENSURE PROPER SUPPORT FOR ALL WALL MOUNTED ITEMS AND FINISHES. PROVIDE FIRE RETARDANT TREATED WOOD BLOCKING AS REQUIRED, CONCEALED IN WALL CONSTRUCTION.

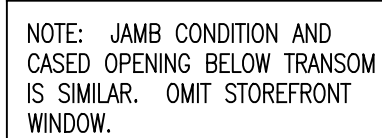

TRANSOM JAME




PUBLIC SIDE

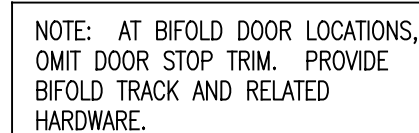


HEAD



PUBLIC SIDE

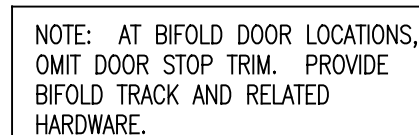

JAME

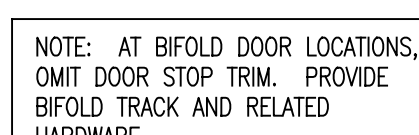PUBLIC SIDE

SILL



HEAD

JAMB

SILL

TRANSOM HEAD

TRANSOM SILL/WALL OPENING HEAD



SILL

4

3

②

1

FOODSERVICE ABBREVIATIONS (SECTION 114000)				GENERAL FOODSERVICE AND HEALTH CODE REQUIREMENTS	REFRIGERATION GENERAL REQUIREMENTS	PLUMBING GENERAL REQUIREMENTS (DIVISION 22)	ELECTRICAL GENERAL REQUIREMENTS (DIVISION 26)
AFF	ABOVE FINISHED FLOOR	INST	INSTALL(ATION)	<div>1. FOODSERVICE EQUIPMENT AND INSTALLATION SHALL COMPLY WITH THE CURRENT EDITION OF CODES, RULES, AND REGULATIONS OF THE GOVERNING HEALTH DEPARTMENT AUTHORITIES AND SHALL BE MANUFACTURED IN STRICT COMPLIANCE WITH AND, IF APPLICABLE, BEAR THE SEAL OF UL, NEMA, ASME, NSF, NSF7, ETL, AGA, OSHA AND NFPA. ACCEPTANCE OF FOODSERVICE AREAS IS SUBJECT TO FINAL INSPECTION BY THE GOVERNING HEALTH DEPARTMENT.</div> <div>2. CEILING AND WALL SURFACES ADJACENT TO OR ABOVE ANY FOODSERVICE AREA, RESTROOM, AND ANTE-ROOM SHALL BE SMOOTH, NON-ABSORBENT, EASILY CLEANABLE, AND LIGHT IN COLOR. ANY MATERIALS NOT CLEARLY CONSISTENT WITH THIS REQUIREMENT SHOULD BE SUBMITTED TO THE GOVERNING HEALTH DEPARTMENT FOR PRIOR APPROVAL OF USE. LAY-IN CEILING TILE MUST BE NON-POROUS AND NON-FISSURED PANELS ONLY. A CORROSION RESISTANT SUSPENSION SYSTEM IS RECOMMENDED.</div> <div>3. FLOORING IN ANY FOODSERVICE AREA, RESTROOM, AND ANTE-ROOM SHALL BE SMOOTH, NON-ABSORBENT, AND EASILY CLEANABLE WITH MINIMUM 3/8" COVE BASE EXTENDING UPWARD MINIMUM 6" AT WALLS OR AS DIRECTED BY THE GOVERNING HEALTH DEPARTMENT.</div> <div>4. BUILDING SURFACES AT AND AROUND FOODSERVICE COUNTERS IN PUBLIC SERVING AREAS SHALL MEET THE FINISH REQUIREMENTS OF THE GOVERNING HEALTH DEPARTMENT.</div> <div>5. CONSTRUCT PARTITION WALLS BETWEEN FOODSERVICE AREAS AND PUBLIC AREAS FOR MAXIMUM SOUND CONTROL WHERE APPLICABLE.</div> <div>6. LIGHTING IN FOODSERVICE AREAS SHALL MEET THE MINIMUM FOOT-CANDLE REQUIREMENTS ESTABLISHED BY THE AUTHORITIES HAVING JURISDICTION.</div> <div>7. LIGHTING AND INFRARED/HEAT LAMPS IN AREAS OVER FOOD CONTACT SHALL HAVE LAMP GUARDS/SLEEVES, SOLID PLASTIC LENSES, OR APPROVED SHATTER RESISTANT COATED BULBS.</div> <div>8. BACKSPASHES, WHEN PROVIDED WITH EQUIPMENT, SHALL BE SEALED TO WALLS WITH SILICONE IN A NEAT WORKMANLIKE MANNER OR AS DIRECTED BY THE GOVERNING HEALTH DEPARTMENT. SEALANT MUST BE APPROVED BY THE NATIONAL SANITATION FOUNDATION (NSF).</div> <div>9. SEAMS AND GAPS BETWEEN NON-PORTABLE FOODSERVICE EQUIPMENT AND ADJACENT STRUCTURES SHALL BE PROPERLY SEALED AGAINST THE ENTRANCE OF FOOD PARTICULATES AND VERMIN WITH NSF APPROVED SILICONE SEALANT AND/OR TRIM OR AS DIRECTED BY THE GOVERNING HEALTH DEPARTMENT.</div> <div>10. EQUIPMENT PLACED ON TABLES AND COUNTERS SHALL BE COMPLETELY SEALED TO WORK SURFACE OR MOUNTED ON LEGS NO LESS THAN 4 INCHES IN HEIGHT IF EQUIPMENT WEIGHS MORE THAN 75 POUNDS.</div> <div>11. ALL FOODSERVICE EQUIPMENT RESTING ON THE FLOOR SHALL BE COMPLETELY SEALED TO FLOOR, MOUNTED ON MINIMUM 6" HIGH LEGS, MOUNTED ON CASTERS, INSTALLED ON A RAISED CURB WITH COVERED BASE, OR INSTALLED AS DIRECTED BY THE GOVERNING HEALTH DEPARTMENT.</div> <div>12. EMPLOYEE LOCKERS SHALL HAVE MINIMUM 6" HIGH ROUND METAL LEGS OR MOUNTED TO THE WALL WITH MINIMUM 6" AFF CLEAR.</div> <div>13. UNDERBAR SINKS SHALL COMPLY WITH THE REQUIREMENTS OF THE GOVERNING HEALTH DEPARTMENT.</div> <div>14. WAREWASH SINKS SHALL HAVE THREE COMPARTMENTS SIZED TO SUBMERGE THE LARGEST KITCHEN VESSEL AND MINIMUM 18" DRAINBOARD ON BOTH ENDS. SPLASHGUARDS SHALL BE PROVIDED AS REQUIRED BY THE GOVERNING HEALTH DEPARTMENT.</div> <div>15. DISHWASHERS SHALL BE CHEMICAL OR HIGH TEMPERATURE SANITIZERS. HIGH TEMPERATURE MACHINES MUST BE DESIGNED WITH A FINAL RINSE TEMPERATURE OF 180°F AND WASH CYCLE TEMPERATURE OF 160°F.</div> <div>16. ALL REFRIGERATION EQUIPMENT SHALL HAVE THERMOMETERS WHICH ARE EASILY READABLE, IN PROPER WORKING CONDITION, AND ACCURATE WITHIN PLUS OR MINUS 2°.</div> <div>17. VACUUM BREAKERS, WHEN REQUIRED, SHALL BE A MINIMUM OF 6 INCHES ABOVE THE FLOOD LEVEL RIM WITH NO SHUT OFF DEVICES BEYOND THE DISCHARGE OF THE VACUUM BREAKER.</div> <div>18. WATER FILTRATION DEVICES SHALL NOT BE LOCATED DIRECTLY ABOVE FOODSERVICE EQUIPMENT OR FIXTURES WHERE DIRECTED BY THE AUTHORITIES HAVING JURISDICTION.</div> <div>19. DEDICATED HANDWASHING FACILITIES SHALL BE LOCATED WITHIN REQUIRED PROXIMITY AND ACCESSIBILITY OF ALL FOODSERVICE AREAS.</div> <div>20. UTILITY FAUCETS AT MOP SINK(S) SHALL HAVE BACKFLOW PROTECTION AND SHALL BE THREADED FOR HOSE ATTACHMENT.CHEMICAL DISPENSING SYSTEMS SHALL NOT BE PLUMBED TO THE FAUCET.</div> <div>21. AIR CURTAIN(S) SHALL HAVE MINIMUM 1600 CFM VELOCITY MEASURED 3'-0" AFF AND SHALL OPERATE VIA DOOR ACTIVATED MICROSWITCH.</div>	<div>1. GENERAL CONTRACTOR AND/OR SUBDIVISIONS SHALL PROVIDE FLOOR REQUIREMENTS AND/OR SLAB RECESS(ES) AT WALK-IN COOLERS AND FREEZERS AS SPECIFIED.</div> <div>2. EVAPORATOR CONDENSATE DRAIN LINE(S) SHALL BE REFRIGERATION GRADE HARD COPPER USING 1" STANDOFFS, "P" TRAP DRAIN OUTSIDE WALK-IN COOLER/FREEZER AREA(S). PROVIDE AND INSTALL SLEEVES THRU WALK-IN AND BUILDING WALLS FOR DRAIN LINE(S). FOAM & CAULK AROUND SLEEVES AND DRAIN LINES. WRAP WITH DRAIN LINE HEATER AND INSULATION WHERE SUBJECT TO FREEZING TEMPERATURES.</div> <div>3. KEC (SECTION 114000) SHALL FURNISH AND INSTALL METAL CLOSURE PANELS & TRIM TO MATCH WALK-IN FACING WHERE WALK-IN ABUTS BUILDING WALLS AND CEILINGS.</div> <div>4. BUILDING FLOOR UNDER WALK-IN MUST BE SMOOTH AND LEVEL WITHIN PLUS OR MINUS 1/8".</div> <div>5. REFRIGERATION CONTRACTOR SHALL VERIFY LOCATION OF CONDENSING UNIT(S) PRIOR TO INSTALLATION.</div> <div>6. INDOOR RACK SYSTEMS SHALL REQUIRE MECHANICAL VENTILATION OF NOT LESS THAN 800 CFM PER H.P. FOR AIR-COOLED UNITS AND 250 CFM PER H.P. FOR WATER-COOLED UNITS UNLESS DIRECTED OTHERWISE BY MANUFACTURER'S RECOMMENDATIONS.</div> <div>7. GENERAL CONTRACTOR AND/OR SUBDIVISIONS SHALL COORDINATE CLEARANCE REQUIREMENTS OF ROOFTOP REFRIGERATION UNIT(S) FROM BUILDING EDGES AND OTHER ROOFTOP MECHANICAL UNITS AS DIRECTED BY CODE.</div> <div>8. GENERAL CONTRACTOR AND/OR SUBDIVISIONS SHALL PROVIDE STRUCTURAL REINFORCEMENT TO BUILDING AS REQUIRED FOR HANGING AND/OR MOUNTING OF REFRIGERATION EQUIPMENT. COORDINATE EQUIPMENT LOCATON(S) WITH REFRIGERATION CONTRACTOR.</div> <div>9. ALL ROOF MATERIAL/FLASHING AND REQUIRED ROOF PENETRATION(S) FOR REFRIGERATION SYSTEMS ARE THE RESPONSIBILITY OF THE GENERAL CONTRACTOR AND/OR SUBDIVISIONS.</div> <div>10. REFRIGERATION CONTRACTOR SHALL PITCH OR SEAL PENETRATIONS THRU PIPE CURB(S) WITH TAR UPON INSTALLATION OF REFRIGERATION LINES.</div> <div>11. REFRIGERATION CONTRACTOR SHALL FURNISH REFRIGERATION PIPING AND INSTALL CONDENSERS, CONDENSING UNITS, AND EVAPORATOR COILS. REFRIGERATION CONTRACTOR TO CHARGE, START-UP, RUN, AND CHECK FOR PROPER OPERATING TEMPERATURES.</div> <div>12. REFRIGERATION CONTRACTOR SHALL FURNISH AND INSTALL FLEXIBLE CLOSED CELL INSULATION ON REFRIGERATION LINES TO PREVENT CONDENSATION.</div> <div>13. GENERAL CONTRACTOR AND/OR SUBDIVISIONS SHALL COORDINATE ACCESSIBILITY OF REFRIGERATION PIPING TO CONDENSING UNITS (THRU MULTIPLE FLOORS WHERE REQ'D) WITH REFRIGERATION CONTRACTOR.</div> <div>14. REFRIGERATION LINES TO BE CONCEALED WITHIN WALLS, ABOVE CEILINGS, AND BENEATH FLOORS WHERE POSSIBLE. REFRIGERATION CONTRACTOR TO INSTALL LINE SETS IN WALLS DURING FRAMING.</div> <div>15. REFRIGERATION CONTRACTOR SHALL FOAM & SEAL INSIDE AND OUTSIDE OF ALL REFRIGERATION PENETRATIONS THRU WALK-IN COOLER/FREEZER(S) AND REMOTE REFRIGERATION UNITS.</div> <div>16. REFRIGERATION CONTRACTOR SHALL FOAM AND SEAL BOTH ENDS OF CONDUIT (WHERE SPECIFIED) UPON INSTALLATION OF REFRIGERATION LINES.</div> <div>17. PULL BOXES FOR REFRIGERATION LINES (WHERE SPECIFIED) SHALL BE MINIMUM 12" X 12".</div> <div>18. KEC (SECTION 114000) FURNISHED REMOTE CONDENSERS/CONDENSING UNITS FOR ICE MACHINES SHALL BE INSTALLED NO FURTHER THAN 75'-0" FROM UNIT OR WITHIN MANUFACTURER'S RECOMMENDED MAXIMUM DISTANCE.</div> <div>19. REFRIGERATION CONTRACTOR SHALL INSTALL REFRIGERATION LINE SETS FOR ICE MACHINES.</div>	<div>1. FOODSERVICE DRAWINGS INDICATE PLUMBING ROUGH-IN/CONNECTION POINTS ONLY FOR EQUIPMENT SPECIFIED UNDER THE KITCHEN EQUIPMENT (SECTION 114000) CONTRACT. ANY ADDITIONAL PLUMBING REQUIREMENTS ARE NOT INDICATED ON FOODSERVICE DRAWINGS. THE PLUMBING CONTRACTOR (DIVISION 22) SHALL FURNISH AND INSTALL PRESSURE REDUCING VALVES, FLOW CONTROLS, BACK FLOW PREVENTION, RPZ (REDUCED PRESSURE ZONE) VALVES, WATER HAMMER ARRESTOR, GATE VALVES, FOR WATER CONNECTIONS AS REQUIRED BY THE AUTHORITIES HAVING JURISDICTION.</div> <div>2. DIMENSIONS ARE SHOWN FROM FINISHED FLOORS, FINISHED WALLS, AND/OR COLUMN CENTERLINES TO CENTER OF ROUGH-IN. HEIGHTS ARE SHOWN FROM FINISHED FLOOR (NOT FINISHED CURB) TO CENTER OF ROUGH-IN. A ROUGH-IN "STUB-UP" SHALL EXIT FINISHED FLOOR OR CURB TO HEIGHT AND LOCATION INDICATED.</div> <div>3. ROUGH-INS, FIELD INTERCONNECTIONS (EXPOSED AND UNEXPOSED), AND FINAL CONNECTIONS TO ALL FOODSERVICE EQUIPMENT SHALL BE PROVIDED BY PLUMBING CONTRACTOR (DIVISION 22).</div> <div>4. PLUMBING TO BE CONCEALED WITHIN WALLS, CEILINGS, AND FLOORS WHERE POSSIBLE.</div> <div>5. REUSE PLUMBING SERVICES WHERE APPLICABLE IN EXISTING/REMODELED FOODSERVICE AREAS. CAP OR REMOVE EXISTING SERVICE(S) MADE OBSOLETE BY NEW CONSTRUCTION AS DIRECTED BY CODE.</div> <div>6. DIRECT AND INDIRECT WASTES ARE INDICATED IN FOODSERVICE AREAS. ADDITIONAL DRAINS MAY BE REQUIRED UNDER DIVISION 22.</div> <div>7. FLOOR SINKS SHALL BE FLUSH WITH FINISH FLOOR UNLESS DIRECTED OTHERWISE BY THE AUTHORITIES HAVING JURISDICTION.</div> <div>8. PROVIDE REMOVABLE GRATES OR COVERS ON PARTIALLY AND FULLY EXPOSED FLOOR SINKS.</div> <div>9. FLOOR SINKS FOR DISHWASHERS, SCULLERY SINKS, AND WATER-WASH HOODS TO BE A MINIMUM 10" DEEP WITH 3" DRAIN WHERE APPLICABLE.</div> <div>10. PROVIDE AND ROUTE DRAIN LINES FROM EQUIPMENT TO FLOOR SINKS WITH A MINIMUM 1/4" PER 1'-0" SLOPE. INSULATE DRAIN LINES SUSCEPTIBLE TO CONDENSATION (ICE BINS, REFRIGERATION UNITS, ETC).</div> <div>11. SUPPORT ALL PLUMBING TIGHT AGAINST UNDERSIDE OF EQUIPMENT TO ALLOW SPACE FOR CLEANING.</div> <div>12. KEC (SECTION 114000) SHALL FURNISH ALL FAUCETS, BASKET WASTES, TWIST/LEVER WASTES, GAS HOSES, AND VACUUM BREAKER/SAFETY REGULATORS AS SPECIFIED. PLUMBING CONTRACTOR (DIVISION 22) SHALL INSTALL ALL FAUCETS, BASKET WASTES, TWIST/LEVER WASTES, GAS HOSES, AND VACUUM BREAKER/SAFETY REGULATORS WITH THE NECESSARY COMPONENTS AND SUPPLY NIPPLES TO MAKE FINAL CONNECTIONS. INCLUDING THE INSTALLATION OF COMPONENTS NOT SHOWN OR SHIPPED LOOSE.</div> <div>13. FLOOR AND WALL PENETRATIONS MUST BE SEALED WATER-TIGHT AND VERMIN PROOF.</div> <div>14. FOODSERVICE EQUIPMENT DRAIN(S) ARE TO BE PIPED TO GREASE TRAP/INTERCEPTOR(S) AS DIRECTED BY THE AUTHORITIES HAVING JURISDICTION. FURNISH AND INSTALL GREASE TRAP/INTERCEPTOR(S) AS SPECIFIED BY THE PLUMBING ENGINEER.</div> <div>15. POTABLE WATER PRESSURE TO FOODSERVICE EQUIPMENT SHALL MEET THE REQUIREMENTS OF THE AUTHORITIES HAVING JURISDICTION.</div> <div>16. INCOMING GAS PRESSURE AT POINTS OF USE MUST MEET MANUFACTURER'S SPECIFIED WATER COLUMN REQUIREMENTS. INSTALL KEC (SECTION 114000) FURNISHED PRESSURE REGULATORS WHEN SHIPPED LOOSE WITH EQUIPMENT.</div> <div>17. WATER HEATER(S) SHALL BE SIZED BY THE PLUMBING ENGINEER TO MEET THE CONSUMPTION REQUIREMENTS OF THE AUTHORITIES HAVING JURISDICTION.</div> <div>18. PROVIDE 120 DEGREE F HOT WATER SUPPLY AT THREE-COMPARTMENT SINK(S).</div> <div>19. UNLESS SPECIFIED AS FURNISHED BY KEC (SECTION 114000), PLUMBING CONTRACTOR (DIVISION 26) SHALL FURNISH AND INSTALL TEMPERATURE REDUCING DEVICES ON DRAIN LINES WHERE DISCHARGE WATER EXCEEDS MAXIMUM ALLOWABLE TEMPERATURE AS DIRECTED BY THE AUTHORITIES HAVING JURISDICTION.</div> <div>20. ALL STEAM AND CONDENSATE CONNECTIONS SHALL BE INSTALLED AS DIRECTED BY CODE. PROVIDE PRESSURE REDUCING VALVES, STEAM TRAPS, SAFETY VALVES, SHUT-OFF VALVES, STRAINERS, WRAP, AND INSULATION AS REQ'D.</div>	<div>1. FOODSERVICE DRAWINGS INDICATE ELECTRICAL ROUGH-IN/CONNECTION POINTS ONLY FOR EQUIPMENT SPECIFIED UNDER THE KITCHEN EQUIPMENT (SECTION 114000) CONTRACT. ANY ADDITIONAL ELECTRICAL REQUIREMENTS ARE NOT INDICATED ON FOODSERVICE DRAWINGS.</div> <div>2. ROUGH-INS, INTERWIRING, AND FINAL CONNECTIONS TO ALL FOODSERVICE EQUIPMENT SHALL BE COMPLETED BY ELECTRICAL CONTRACTOR (DIVISION 26).</div> <div>3. FURNISH AND INSTALL ALL NECESSARY COMPONENTS TO MAKE FINAL CONNECTIONS; INCLUDING THE INSTALLATION OF COMPONENTS NOT SHOWN OR SHIPPED LOOSE.</div> <div>4. VERIFY AVAILABLE BUILDING SERVICES WITH ELECTRICAL REQUIREMENTS OF ALL FOODSERVICE EQUIPMENT.</div> <div>5. COVER PLATES IN FOODSERVICE AREAS SHALL BE STAINLESS STEEL UNLESS NOTED OTHERWISE.</div> <div>6. COUNTERTOP HEIGHT RECEPTACLES IN FOODSERVICE AREAS SHALL BE INSTALLED HORIZONTALLY.</div> <div>7. PROVIDE DEDICATED CIRCUITS FOR FOODSERVICE EQUIPMENT.</div> <div>8. REUSE ELECTRICAL SERVICE WHERE APPLICABLE IN EXISTING/REMODELED FOODSERVICE AREAS. CAP OR REMOVE EXISTING SERVICE(S) MADE OBSOLETE BY NEW CONSTRUCTION AS DIRECTED BY CODE.</div> <div>9. DIMENSIONS ARE SHOWN FROM FINISHED FLOORS, FINISHED WALLS, AND/OR COLUMN CENTERLINES TO CENTER OF ROUGH-IN. HEIGHTS ARE SHOWN FROM FINISHED FLOOR (NOT FINISHED CURB) TO CENTER OF ROUGH-IN. A ROUGH-IN "STUB-UP" SHALL EXIT FINISHED FLOOR OR CURB TO HEIGHT AND LOCATION INDICATED.</div> <div>10. ALL ELECTRICAL CONDUIT TO BE CONCEALED WITHIN WALLS, CEILINGS, AND FLOORS WHERE POSSIBLE.</div> <div>11. PROVIDE GFCI PROTECTION IN FOODSERVICE AREAS AS DIRECTED BY CODE. GFCI SHALL MEET THE MOTOR RATING AS REQ'D.</div> <div>12. UNLESS SPECIFIED AS FURNISHED BY KEC (SECTION 114000), ELECTRICAL CONTRACTOR (DIVISION 26) SHALL FURNISH AND INSTALL ACCEPTABLE MEANS OF DISCONNECT FOR ALL ITEMS AS DIRECTED BY CODE.</div> <div>13. PROVIDE LIQUID TIGHT CONDUIT WHERE EXPOSED IN FOODSERVICE AREAS UNLESS DIRECTED OTHERWISE BY CODE.</div> <div>14. PROVIDE MINIMUM 6'-0" FLEXIBLE CONDUIT WHIP ON ALL MOBILE OR UNFASTENED FOODSERVICE EQUIPMENT WITH DIRECT CONNECTION(S).</div> <div>15. CONDUIT PENETRATING WALK-IN REFRIGERATION UNITS SHALL BE INSULATED OR OF MATERIAL TO PREVENT THERMAL TRANSFER. FOAM & SEAL INSIDE AND OUTSIDE OF PENETRATION(S) THRU WALK-IN TO PREVENT CONDENSATION.</div> <div>16. INSTALL KEC (SECTION 114000) FURNISHED AIR CURTAIN(S) AND MICRO SWITCH(S) WHERE SPECIFIED.</div>
ALT	ALTERNATE	INSUL	INSULATE(ION)				
AMP	AMPERE	INT	INTERIOR				
ANSI	AMERICAN NATIONAL STANDARDS INSTITUTE	IW	INDIRECT WASTE				
BLDG	BUILDING	JB	JUNCTION BOX - CEILING/FLOOR MOUNTED				
BTU	BRITISH THERMAL UNIT	JBW	JUNCTION BOX - WALL MOUNTED				
C&P	CORD AND PLUG	KEC	KITCHEN EQUIPMENT CONTRACTOR				
CFM	CUBIC FEET PER MINUTE	KW	KILOWATT HOUR				
CLR	CENTER LINE	LAM	LAMINATE				
CLG	CEILING	LBS	POUNDS				
CO	CONCRETE MASONRY UNIT	LT	LIGHT				
COL	COLUMN	MBTU	1000 BTU/HOUR				
CW	COLD WATER	MECH	MECHANICAL				
DC	DROP CORD	MTD	MOUNTED				
DFA	DOWN FROM ABOVE	MTP	MALE PIPE THREAD				
DIA	DIAMETER	N/A	NOT APPLICABLE				
DIM	DIMENSION	NIC	NOT IN CONTRACT				
DIV	DIVISION	NTS	NOT TO SCALE				
DR	DUPLEX RECEPTACLE	OC	ON CENTER				
DW	DIRECT WASTE	OD	OUTSIDE DIAMETER				
DWVG	DRAWING	PC	PLUMBING CONTRACTOR				
EA	EACH	PERF	PERFORATE(D)				
EC	ELECTRICAL CONTRACTOR	PH	PHASE				
EQ	EQUAL	PLAM	PLASTIC LAMINATE				
EQUIP	EQUIPMENT	PLYWD	PLYWOOD				
EXT	EXTERIOR	PSI	POUNDS PER SQUARE INCH				
FD	FLOOR DRAIN	QR	QUAD RECEPTACLE				
FF	FINISHED FLOOR	QT	QUARRY TILE				
FIN	FINISH(ED)	QTY	QUANTITY				
FLR	FLOOR	RAD	RADIUS				
FLUOR	FLUORESCENT	RCP	REFLECTED CEILING PLAN				
FPT	FEMALE PIPE THREAD	REQD	REQUIRED				
FRZ	FREEZER	RFG	REFRIGERATOR				
GA	GAUGE	RI	ROUGH-IN				
GAL	GALLON	RM	ROOM				
GALV	GALVANIZED	SP	SPECIAL RECEPTACLE				
GC	GENERAL CONTRACTOR	SPEC	SPECIFICATION				
GFCI	GROUND FAULT CIRCUIT INTERRUPTER	SR	SINGLE RECEPTACLE				
GPM	GALLONS PER MINUTE	SS	STAINLESS STEEL				
HGT	HEIGHT	STD	STANDARD				
HORZ	HORIZONTAL	STP	STATIC PRESSURE				
HP	HORSEPOWER	TYP	TYPICAL				
HVAC	HEATING, VENTILATING, AIR CONDITIONING	UDS	UTILITY DISTRIBUTION SYSTEM				
HW	HOT WATER	VAC	VACUUM				
ID	INSIDE DIAMETER	VERT	VERTICAL				
IN	INCH	WH	WATER HEATER				
INCL	INCLUDE	WL	WALL				
		WP	WEATHER PROOF				
		B.T.C.	BRANCH TO CONNECTION				
		S.U.	STUB-UP				
		B.F.F.	BELOW FINISHED FLOOR				

CUSTOM FABRICATION GENERAL REQUIREMENTS		
1.	THESE NOTES APPLY TO ITEMS LISTED AS "CUSTOM" FABRICATION AND DO NOT APPLY TO STAINLESS STEEL BUY-OUT ITEMS WITH A MANUFACTURER/BRAND AND MODEL NUMBER.	
2.	STAINLESS STEEL SHALL BE 18-8, TYPE 304 UNLESS NOTED OTHERWISE.	
3.	COUNTERTOPS AND SINKS SHALL BE 14 GAUGE UNLESS NOTED OTHERWISE.	
4.	UNDERSHELVES AND OVERSHELVES SHALL BE 18 GAUGE UNLESS NOTED OTHERWISE.	
5.	ENCLOSED CABINET BASES SHALL BE 18 GAUGE. DOORS SHALL BE DOUBLE WALL CONSTRUCTION WITH 18 GAUGE EXTERIOR.	
6.	LEGS SHALL BE 16 GAUGE, 1-5/8" O.D. TUBING WITH STAINLESS STEEL BULLET SHAPED FEET. CROSS-RAILS SHALL BE 16 GAUGE, 1-1/4" O.D. TUBING. ALL JOINTS BETWEEN LEGS, CROSS BRACES, AND UNDERSHELVES TO BE FULLY WELDED, GROUND, AND POLISHED SMOOTH. SPACING BETWEEN LEGS NOT TO EXCEED 5'-0" O.C.	
7.	REINFORCE TOPS, SHELVES, AND CABINET BASES WITH 14 GAUGE CHANNEL. ONE CENTER CHANNEL UP TO 36" WIDE AND TWO CHANNELS WHEN OVER 36" WIDE. CHANNEL SHALL BE STAINLESS STEEL IN WET AREAS OR WHERE EXPOSED.	

FLOOR CURB AND DEPRESSION GENERAL REQUIREMENTS (DIVISION 3, 6, 7, & 9)		
1.	GENERAL CONTRACTOR AND/OR SUBDIVISIONS SHALL PROVIDE FLOOR RECESS(ES) AND RAISED CONCRETE CURB(S) AS SPECIFIED.	
2.	FLOOR SLAB RECESS(ES) AND RAISED CONCRETE CURB(S) MUST BE SMOOTH AND LEVEL WITHIN PLUS OR MINUS 1/8".	
3.	DIMENSIONS ARE SHOWN FROM FINISHED FLOORS, FINISHED WALLS, AND/OR COLUMN CENTERLINES TO FINISHED EDGE OF RAISED CURB AND/OR FLOOR RECESS. HEIGHTS ARE SHOWN FROM FINISHED FLOOR TO FINISHED SURFACE OF RAISED CURB AND/OR FLOOR RECESS.	
4.	OFFSET CURB 3" MINIMUM AROUND PERIMETER OF FLOOR SINKS WHEN SHOWN WITHIN RAISED CURB(S).	
5.	GENERAL CONTRACTOR AND/OR SUBDIVISIONS SHALL BACKFILL FLOOR RECESS(ES) AND EXPOSED OPENINGS IN CONCRETE CURBS UPON INSTALLATION OF FOODSERVICE EQUIPMENT.	
6.	KEC (SECTION 114000) SHALL CONFIRM RAISED CURB FRAMING PRIOR TO POURING OF CONCRETE BY GENERAL CONTRACTOR AND/OR SUBDIVISIONS.	
7.	GENERAL CONTRACTOR AND/OR SUBDIVISIONS TO FURNISH AND INSTALL INTEGRAL COVE BASE ON RAISED CONCRETE CURB(S) PRIOR TO INSTALLATION OF FOODSERVICE EQUIPMENT.	
8.	KEC (SECTION 114000) TO PROVIDE MINIMUM 1/2" BORIC ACID IN ENCLOSED CURBS OF FRAME CONSTRUCTION FOR VERMIN CONTROL OR AS ACCEPTABLE BY THE AUTHORITIES HAVING JURISDICTION.	

VENTILATION GENERAL REQUIREMENTS		
1.	MECHANICAL EXHAUST SYSTEMS SHALL BE PROVIDED ABOVE ALL COOKING EQUIPMENT AND DISHWASHERS AS DIRECTED BY THE AUTHORITIES HAVING JURISDICTION.	
2.	EXHAUST HOODS SHALL BE CONSTRUCTED IN ACCORDANCE WITH LOCAL BUILDING CODES AND MEET NSF, UL, AND NFPA-96 STANDARDS. HOODS ARE TO BEAR UL CLASSIFIED LABEL WITHOUT DAMPERS IN EXHAUST VENT COLLARS. HOODS SHALL BE DESIGNED WITH A MINIMUM 6 INCH OVERHANG AT ALL EXPOSED COOKING AREAS.	
3.	MAKE-UP AIR MUST BE PROVIDED FOR MECHANICAL EXHAUST SYSTEMS AS REQ'D BY THE AUTHORITIES HAVING JURISDICTION. MAKE-UP AIR SHALL NOT CAUSE UNDUE TURBULENCE IN WORKING AREAS.	
4.	HVAC/MECHANICAL CONTRACTOR (DIVISION 23) TO COORDINATE LOCATIONS OF EXHAUST AND MAKE-UP AIR DUCT(S) WITH THE KEC (SECTION 114000).	
5.	EXHAUST DUCT IN ENCLOSED EXHAUST SHAFTS SHALL BE WRAPPED WITH APPROVED DUCT INSULATION OR SHALL MEET THE MINIMUM FIRE RATING AND CLEARANCE REQUIREMENTS TO COMBUSTIBLE AND NONCOMBUSTIBLE CONSTRUCTION AS DIRECTED BY CODE.	
6.	GENERAL CONTRACTOR AND/OR SUBDIVISIONS SHALL FLASH-IN ALL ROOF CURBS FOR EXHAUST/MAKE-UP AIR FAN(S).	
7.	THE EXHAUST HOODS AND EXHAUST DUCT SYSTEMS SHALL BE PROVIDED WITH AN AUTOMATIC FIRE EXTINGUISHING SYSTEM. THE FIRE SUPPRESSION SYSTEM SHALL BE ENGINEERED, SIZED, AND INSTALLED IN ACCORDANCE WITH UL 300, NFPA AND CODE.	

VENTILATION REQUIREMENTS		
1.	KEC (SECTION 114000) SHALL FURNISH AND INSTALL EXHAUST HOODS, EXHAUST/MAKE-UP AIR FAN(S), AND CURBS. HVAC/MECHANICAL CONTRACTOR (DIVISION 23) SHALL FURNISH AND INSTALL DUCTWORK BETWEEN EXHAUST HOOD COLLARS AND FAN(S). FINAL CONNECTION BY HVAC/MECHANICAL CONTRACTOR (DIVISION 23).	
2.	FIRE SUPPRESSION SYSTEM FOR EXHAUST HOODS SHALL BE FURNISHED AND INSTALLED BY KEC (SECTION 114000).	
3.	ALL EXHAUST AND MAKE-UP AIR SYSTEMS FOR EXHAUST HOODS TO BE TESTED AND BALANCED BY THE HVAC/MECHANICAL CONTRACTOR (DIVISION 23).	

BEVERAGE SYSTEM GENERAL REQUIREMENTS (DIVISION 26)		
1.	PROVIDE ELECTRICAL METALLIC TUBING (EMT) OR PVC SCHEDULE 40 ELECTRICAL CONDUIT UNLESS DIRECTED OTHERWISE BY CODE.	
2.	CONDUIT IS TO BE SMOOTH AND WATER TIGHT.	
3.	ALL CONDUIT BENDS ARE TO BE WIDE SWEEPS WITH 24" MIN. RADIUS. NO 90° OR 45° ANGLES. VERIFY REQUIREMENTS WITH BEVERAGE CONDUIT DETAILS.	
4.	PROVIDE PULL-BOX FOR OVERHEAD CONDUIT RUNS EVERY 3 BENDS OR 75' - 0".	
5.	CAP CONDUITS DURING CONSTRUCTION.	

<div><div></div><div>B</div></div>		
PROJECT NUMBER: 22.1228		
DATE: 02/09/2022		
SCALE: NTS		
DRAWN BY: RJF		APPROVED BY: JBS
SHEET TITLE: FOODSERVICE GENERAL NOTES, LEGENDS, SHEET INDEX		
SHEET NUMBER: QF001		

7 Tequila

Holly Springs, GA.

Back of House and Bar

2801 South Valley Parkway, Suite 200
Lewisville, TX 75067

p. 469-2407-7200

trimarkusa.com

This document contains confidential information, is an instrument of a professional service, and the property of TriMark. It shall not be used on other projects or for the extension of this project without TriMark's written approval.

Owner and all Contractors to check and verify existing dimensions and conditions in the field before starting construction and to notify TriMark of any material or detail changes.



2801 South Valley Parkway, Suite 200
Lewisville, TX 75067
p. 469-240-7200

trimarkusa.com

This document contains confidential information, is an instrument of a professional service, and the property of TriMark. It shall not be used on other projects or for the extension of this project without TriMark's written approval.

Owner and all Contractors to check and verify existing dimensions and conditions in the field before starting construction and to notify TriMark of any material or detail changes.

REVISIONS

DATE	NO.	DESCRIPTION
03-14-22	B	G.C.SHOP DWG. COORD.2

7 Tequila
Holly Springs, GA.

Back of House and Bar

REVISIONS

DATE	NO.	DESCRIPTION
03-14-22	B	G.C.SHOP DWG. COORD.2

7 Tequila
Holly Springs, GA.

Back of House and Bar

PROJECT NUMBER
22.1228

DATE
02/09/2022

SCALE
1/4" = 1'-0"

DRAWN BY:
RJF

APPROVED BY:
JBS

SHEET TITLE:

FOODSERVICE EQUIPMENT
PLAN

SHEET NUMBER:

QF101


THIS DOCUMENT WAS ORIGINALLY PRINTED ON A 30" x 42" SIZE SHEET

EQUIPMENT SCHEDULE

ITEM NO	QTY	EQUIPMENT CATEGORY	MANUFACTURER	MODEL NUMBER	REMARKS
1	1	WALK-IN COOLER/FREEZER	AMERIKOOLER	21-29898	
1A	1	WALK-IN FREEZER CONDENSING UNIT	AMERIKOOLER	BCH0014LBACHA0200	
1C	1	WALK-IN FREEZER EVAPORATOR COIL	AMERIKOOLER	BELO045B86EEAB0400	
1D	1	WALK-IN COOLER CONDENSING UNIT	AMERIKOOLER	BCH0005MBACZA0000	
1E	1	WALK-IN COOLER EVAPORATOR	AMERIKOOLER	BELO060A56AMAB0400	
2	1	REACH IN REFRIGERATOR	KINTERA	KBM2R	
3	1	ICE MAKER	HOSHIZAKI	KM-1601SRJ	
3.1	1	ICE BIN	HOSHIZAKI	B-1150SS	INCLUDED WITH ITEM #3
3.2	1	ICE MACHINE REMOTE CONDENSER	HOSHIZAKI	URC-22F	INCLUDED WITH ITEM #3
3.3	1	WATER FILTER	HOSHIZAKI	H9320-53	INCLUDED WITH ITEM #3
3B	1	FLOOR TROUGH	BK RESOURCES	FTRS-1248	
4	1	SALAD PREPARATION REFRIGERATOR	TURBO AIR	MST-72-N	
5	1	HOT FOOD SERVING COUNTER	DUKE	E305	
5A	1	SPILL PAN	VOLLRATH	99185 (32023)	
6	1	FRYER	VULCAN	LG500	5" CASTERS
6-2	1	FRYER	VULCAN	LG400	5" CASTERS
7	1	CHARBROILER	VULCAN	VACB25	
8	1	GRIDDLE	VULCAN	MSA48	
9	1	REFRIGERATED EQUIPMENT STAND	HOSHIZAKI	OR72A	
10	1	RANGE	VULCAN	605S-10BN	5" CASTERS
10B	1	SALAMANDER BROILER	VULCAN	36IRB-N	INCLUDED WITH ITEM #10
11	1	CONVECTION OVEN	VULCAN	VC56D	W/CASTSET-SINGLE CASTERS
12A	6	GAS CONNECTOR HOSE KIT	KROWNE	M7548K	NOT SHOWN FOR CLARITY
13	1	MIXER	GLOBE	SP40	
13A	1	SHREDDER/GRATER ATTACHMENT	UNIWORLD	UVS-9DHN	FOR ITEM #13 MIXER
13B	1	WORK TABLE	ADVANCE TABCO	TTS-304-X	
13C	1	WORK TABLE	ADVANCE TABCO	TTS-304-X	
14	1	THREE COMPARTMENT SINK	ADVANCE TABCO	FC-3-2424-24R	
14A	1	PRE-RINSE FAUCET WITH ADD ON	KROWNE	17-109WL	
14B	3	LEVER DRAIN	KROWNE	22-404	
15	2	ONE COMPARTMENT SINK	TRIMARK	KESIC1824S-218	
15A	2	LEVER DRAIN	KROWNE	22-404	
15B	2	SPLASH MOUNT FAUCET	KROWNE	12-810L	
16	1	DISH MACHINE	CMA	CB	
17	1	DISHTABLE "L" SHAPED	ADVANCE TABCO	DTS-D30-B4R	W/ SCRAP BASKET
17B	1	PRE-RINSE FAUCET	KROWNE	17-108WL	
18	1	CLEAN DISHTABLE	ADVANCE TABCO	DTC-S60-36L-X	W/DO-22-EC-X SORTING SHELF
19	1	DROP IN SINK	SERV-WARE	DIS-1C1014-CWP	
19A	1	MILLWORK COUNTER	BY G.C.	CUSTOM	NOT IN QUOTE
20	1	FROZEN BEVEAGE MACHINE	STOELTING	E112-37	
20A	1	EQUIPMENT STAND	EAGLE	BPT-3015EG	W/ 1 5/8" CASTERS
21	1	BACK BAR KEG COOLER W/(3) DRAFT ARMS	PERLUCK	DD584 W/ (3) 69526-3DA	W/ 3 3/4" CASTERS
22	1	BACK BAR COOLER	KROWNE	BS60	W/ 1" CASTERS
23	1	GLASS FROSTER	PERLUCK	FR24RT-3	
24	2	ICE BIN W/ SPEED RAIL	KROWNE	KR19-24-10 W/RD-24	
24A	2	SODA GUN	BY OTHERS	BY OTHERS	
24B	1	POUR RAIL	BY OTHERS	BY OTHERS	
25	2	DRAIN BOARD CABINET	KROWNE	KR24-GSB3	
25A	1	UNDER BAR HAND SINK	KROWNE	KR19-1C	
25B	1	GLASS WASHER	CMA	L-1C	
25C	2	GLASS RINSER	ADVANCE TABCO	SU-16	
25D	1	UNDER BAR DUMP SINK	KROWNE	KR24-MC12	
26	1	PLASTIC SHELVING UNIT	CAMBRO	CBA186072V4580	
27	2	PLASTIC SHELVING UNIT	CAMBRO	CBU186072V4580	
27A	1	SHEET PAN RACK	CHANNEL	401AC	
27B	1	PLASTIC SHELVING UNIT	CAMBRO	CBU183672V4580	
27C	3	PLASTIC SHELVING UNIT	CAMBRO	CBA183672V4580	
28	8	WALL MOUNTED SHELF	KINTERA	KWS1248	
29	5	WALL MOUNTED SHELF	KINTERA	KWS1236	
30	4	WALL MOUNTED SHELF	KINTERA	KWS1260	
31	3	HAND SINK	KINTERA	KHS9	
32	1	WIRE SHELVING	QUANTUM	WR86-2448C-5	
33		SPARE			
34	2	CHANGING TABLE	KOALA	KB101-01	
35		SPARE			
36	1	MOP SINK	ADVANCE TABCO	9-OP-48DF	
37	1	SERVICE FAUCET	KROWNE	16-127	
38	1	TANKLESS WATER HEATER	TRIMARK	VERIFY	VERIFY LOCATION
39	1	MOP BROOM HOLDER	T&S BRASS	B-0653	
40	1	BAG IN A BOX SYSTEM	BY PURVEYOR	CUSTOM	
41	6	TRASH RECEPTACLE	TRIMARK	CO2 TANK	
43	1	CO2 TANK	TRIMARK	VERIFY	
44	LOT	FIRE EXTINGUISHER	TRIMARK	VERIFY	
45	1	DUNNAGE RACK	CHANNEL	ADE2448	
46	1	NACHO CHIP WARMER	TEXICAN	TCO-1	
47	2	WORK TABLE	ADVANCE TABCO	SS-303	
48		SPARE			
49		SPARE			
50	2	PASS THRU SHELF	ADVANCE TABCO	PA-18-84-2	
50A	2	HEAT LAMPS	HATCO	GRAH-36	
51	2	DISH CABINET	ADVANCE TABCO	DC-187	
52	1	CHEST FREEZER	EXCELLENCE	HB-7HCD	
54	1	WORK TABLE	ADVANCE TABCO	FT-3015-X	
55	1	SALAMANDER BROILER	ADMIRAL CRAFT	SAL-4000W	
56	1	EXHAUST HOOD	ACCUREX	Q198763	
56A	1	FIRE SUPPRESSION SYSTEM	ACCUREX	FSSC	
56B	2	EXHAUST FAN	ACCUREX	XUCE-160-A	
56C	1	SUPPLY AIR FAN	ACCUREX	XDGX-P116-H12-MF	
56D	1	WALL PANELING	VERIFY	VERIFY	
57		SPARE			
58	1	TORTILLA MACHINE	X-PRESS	CC	BY OTHERS
59	1	PLASTIC SHELVING UNIT	CAMBRO	CBU246072V4580	
60	1	PLASTIC SHELVING UNIT	CAMBRO	CBA246072V4580	


EXHAUST/SUPPLY FAN SCHEDULE

FANS LOCATED ON BUILDING ROOF. SEE ARCHITECTURAL DRAWINGS FOR EXACT LOCATIONS.

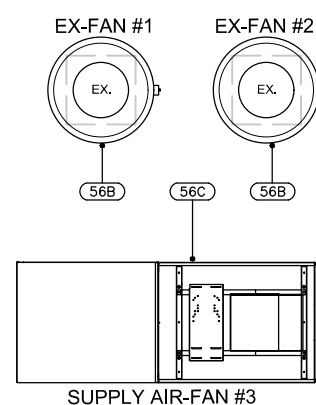

REFRIGERATION SCHEDULE

CONDENSING UNITS LOCATED ON CONCRETE SLAB/ BUILDING ROOF. SEE ARCHITECTURAL DRAWINGS FOR EXACT LOCATIONS.

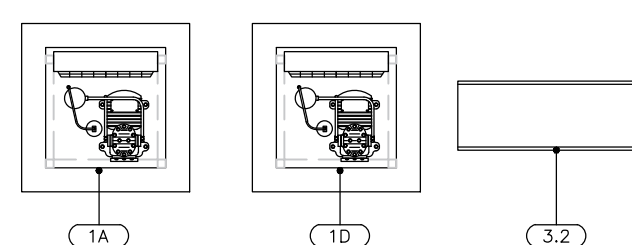




IT IS THE RESPONSIBILITY OF THE ARCHITECT'S ENGINEERS TO LOCATE ADEQUATE NUMBERS OF FLOOR DRAINS, PROPERLY LOCATED & SLOPED TO DRAIN THE FOOD SERVICE AREAS. FLOOR DRAINS BY THE GENERAL CONTRACTOR.



PLUMBING NOTES (DIVISION 22)

- A. INSTALL KEC (SECTION 114000) FURNISHED FLOOR TROUGH(S).
- B. INSTALL KEC (SECTION 114000) FURNISH MOP SINK(S).
- C. INSTALL KEC (SECTION 114000) FURNISHED FIRE SUPPRESSION SYSTEM GAS SHUT OFF VALVE. MUST BE ACCESSIBLE AND NOT CONCEALED IN WALL OR CEILING.
- D. INSTALL KEC (SECTION 114000) FURNISHED DRAIN LINE TEMPERING KIT PER MANUFACTURER'S RECOMMENDATIONS.
- E. MANIFOLD DRAINS TO SINGLE CONNECTION.
- F. FURNISH AND INSTALL BALL VALVE IN DRAIN LINE. VALVE TO BE IN EASILY ACCESSIBLE LOCATION.
- G. PIPING FROM WATER FILTER OUTLET TO POINTS OF USE SHALL BE CONCEALED WITHIN WALLS AND CEILINGS. EXTEND DRAIN(S) TO FLOOR SINK/FLOOR DRAIN, IF REQUIRED.
- H. CONNECT MIN. 1" HOT WATER SUPPLY TO BUILT-IN OR EXTERNAL (70° RISE) BOOSTER HEATER, WHEN EXTERNAL. INSTALL TEMPERATURE/PRESSURE GAUGE(S) AS REQ'D AND EXTEND TO DISHWASHER INLET.
- I. CONNECT DRAIN(S) WITH REFRIGERATION GRADE HARD COPPER USING 1" STANDOFFS, "P" TRAP DRAIN OUTSIDE WALK-IN COMPARTMENT(S). WIRE AND INSTALL SLEEVES THRU WALK-IN AND BUILDING WALLS FOR DRAIN LINE(S). FOAM & CAULK around SLEEVES AND DRAIN LINES. WRAP WITH DRAIN LINE HEATER AND INSULATION WHERE SUBJECT TO FREEZING TEMPERATURES.
- J. PROVIDE GRAY WATER AND SLURRY PIPING TO AND FROM (SECTION 11000) FURNISHED PULPER, TROUGH, AND WATER EXTRACTOR. INSURE (SECTION 114000) FURNISHED TROUGH INLET NOZZLES AND PROVIDE SHUT OFF VALVE AT EACH NOZZLE.
- K. PROVIDE "TEE" IN HOT WATER LINE AND CAP FOR FUTURE INSTALLATION OF CHEMICAL DISPENSING SYSTEM BY OTHERS.
- L. PROVIDE CHROME PLATED PIPE AND FITTINGS WHERE EXPOSED.
- M. INSTALL AND INSTALL 3" MIN. DRAIN LINE TO 12"X12"X10" DEEP FLOOR SINK.
- N. VERIFY EXACT LOCATION AND QUANTITY OF AREA FLOOR DRAIN(S) WITH THE PLUMBING ENGINEER.



REVISIONS		
DATE	NO.	DESCRIPTION
03-14-22	B	G.C.SHOP DWG. COORD.2

7 Tequila

Back of House and Bar

PROJECT NUMBER:	
22.1228	
DATE:	
02/09/2022	
SCALE:	
1/4" = 1'-0"	
DRAWN BY:	APPROVED BY:
RJF	JBS


SHEET TITLE:

FOODSERVICE PLUMBING
IN-SLAB ROUGH-IN PLAN

SHEET NUMBER:


QF201

THIS DOCUMENT WAS ORIGINALLY PRINTED ON A 10" X 12" SIZE SHEET

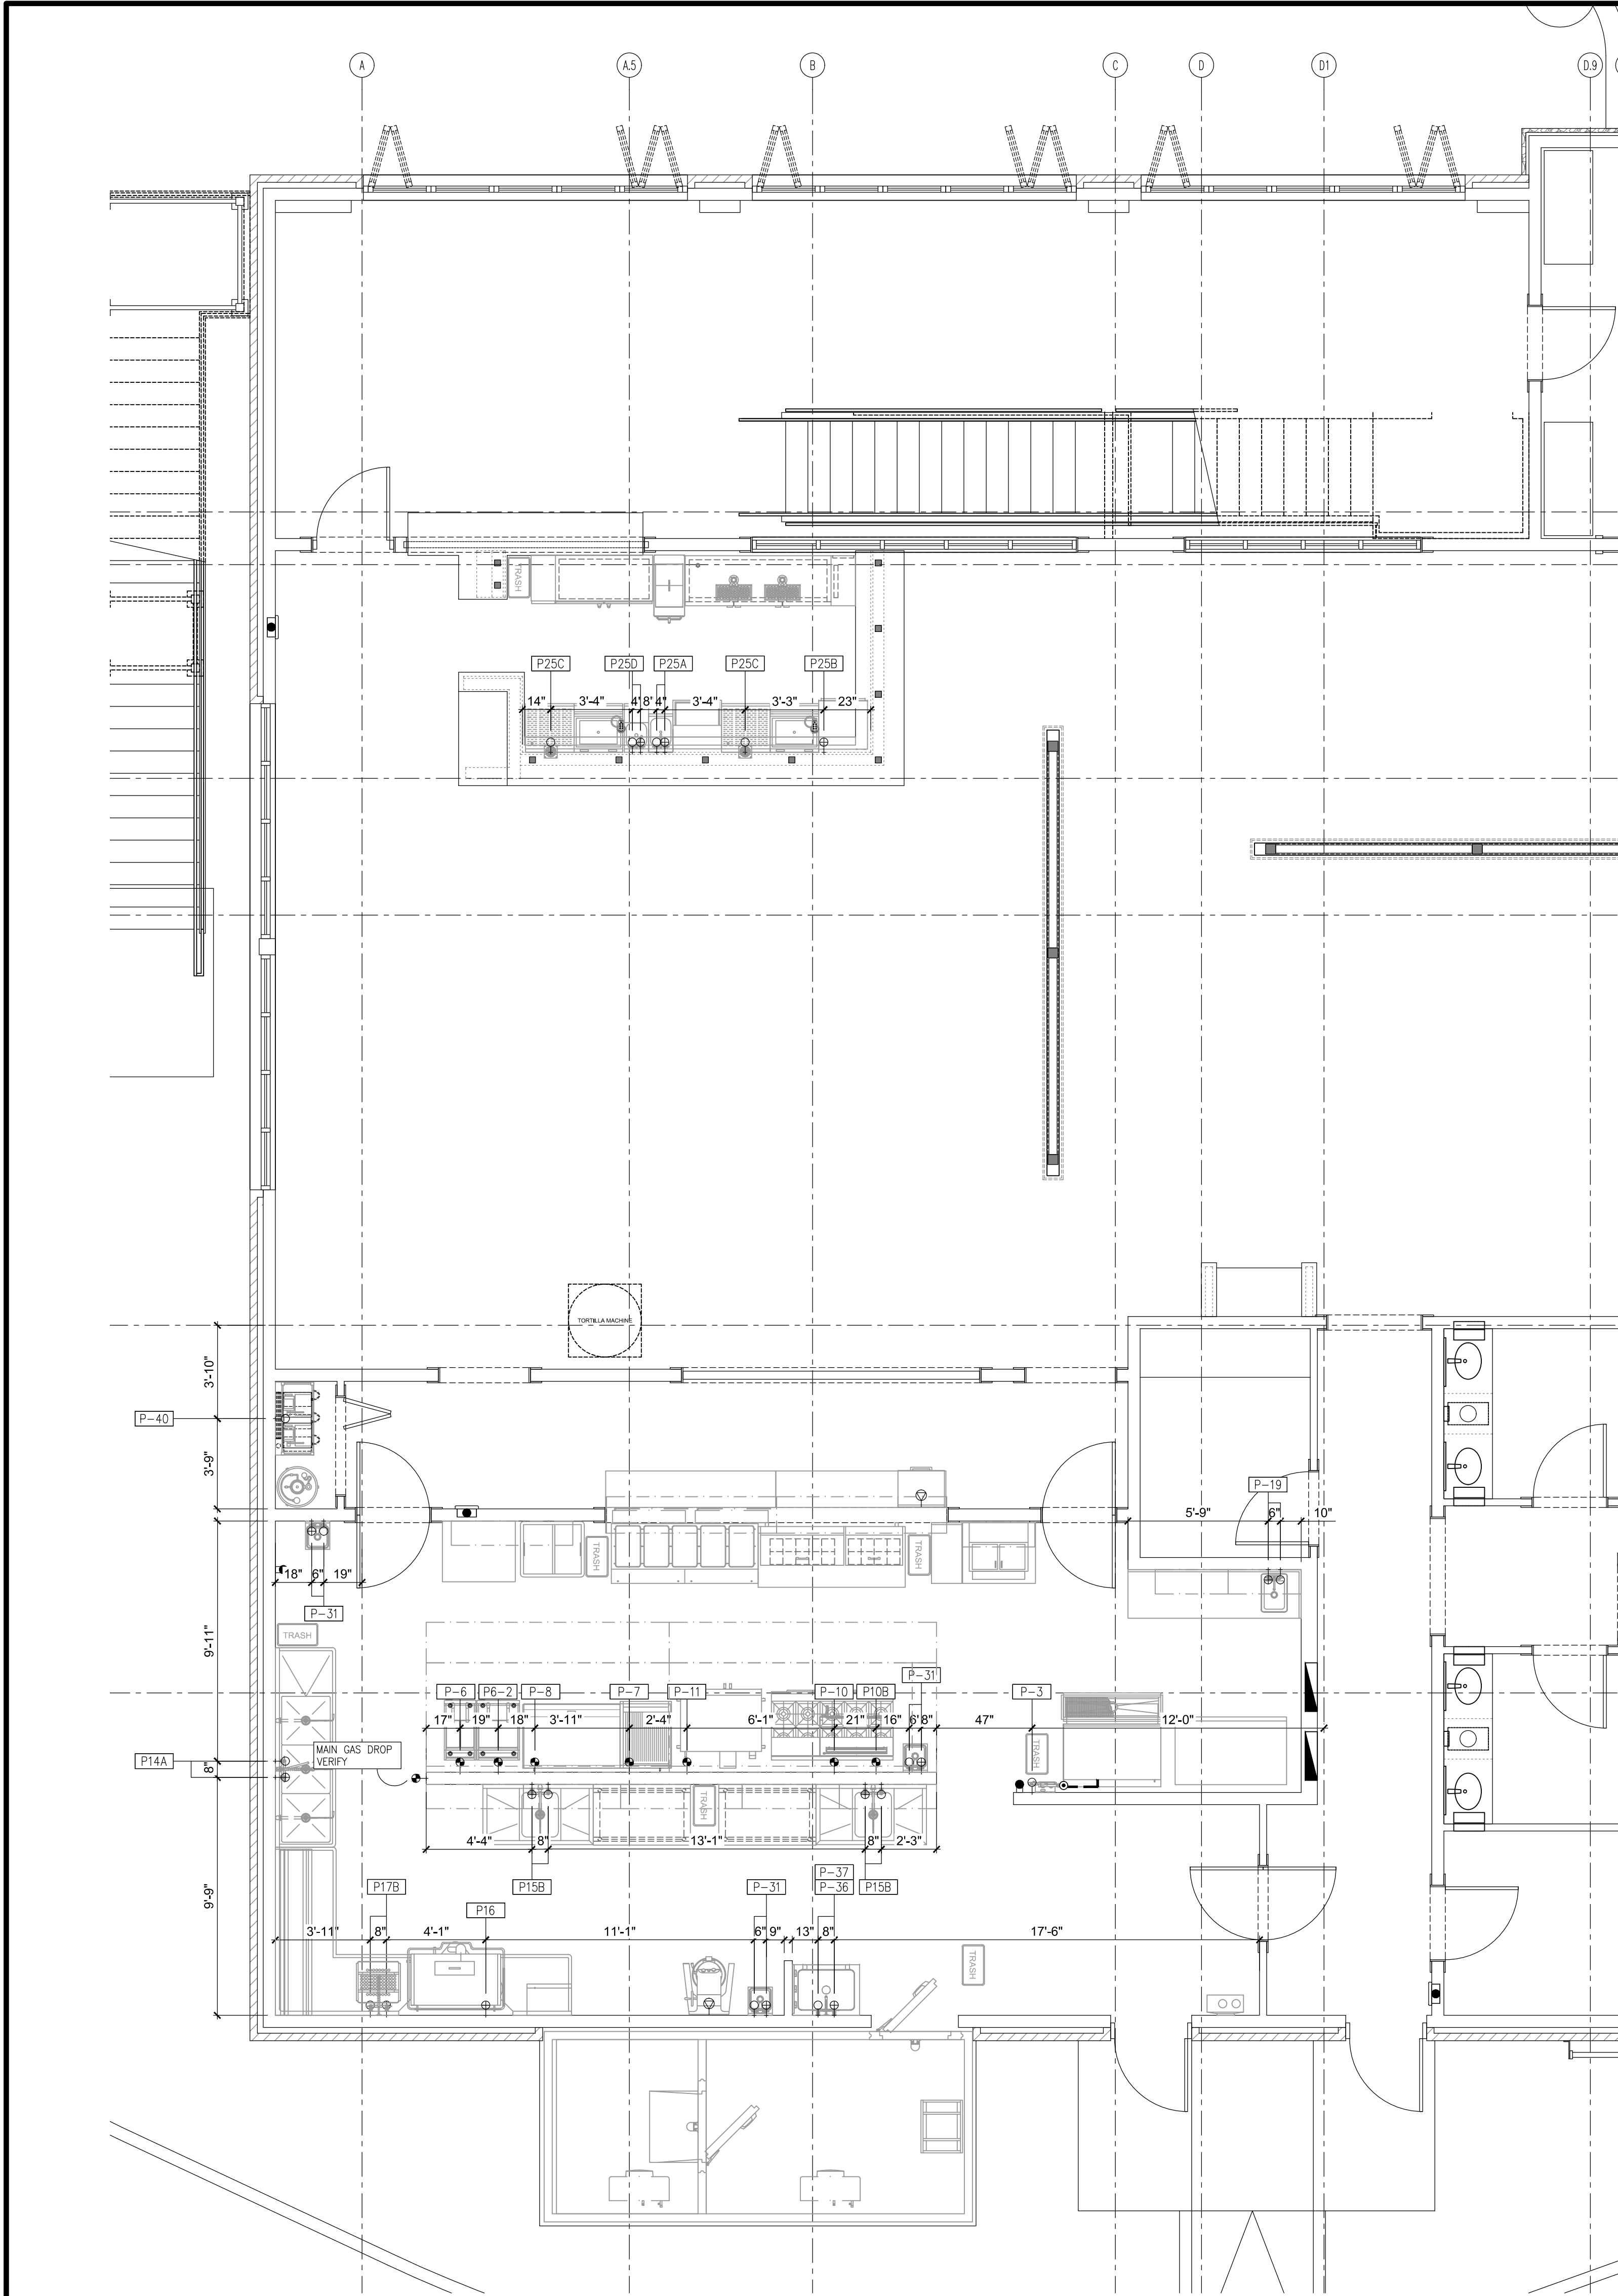

EQUIPMENT PLUMBING SCHEDULE															
ITEM #	COLD WATER SIZE (IN)	HOT WATER SIZE (IN)	COLD WATER A.F.F. (IN)	HOT WATER A.F.F. (IN)	CONNECTION ON UNIT (IN)	INDIR. DRAIN SIZE (IN)	INDIR. WASTE	DIRECT DRAIN SIZE (IN)	DIRECT DRAIN A.F.F. (IN)	GAS SIZE (IN)	MBTUH	EQUIPMENT CATEGORY		PLUMBING REMARKS	
12	-	-	-	-	-	1"	FRD-1	-	-	-	-	EVAPORATOR COIL-FREEZER		RUN DRAIN LINE TO FUNNEL FLOOR DRAIN	
13	-	-	-	-	-	3/4"	FRD-2	-	-	-	-	EVAPORATOR COIL-COOLER		RUN DRAIN LINE TO FUNNEL FLOOR DRAIN	
3	1/2"	-	84"	-	-	3/4"	P-36	-	-	-	-	ICE MAKER		B/C THRU WATER FILTER, ITEM #3.3	
31	-	-	-	-	-	1"	P-38	-	-	-	-	ICE BIN		RUN DRAIN LINE TO FLOOR TROUGH	
38	-	-	-	-	-	-	-	-	-	-	-	FLOOR TROUGH		-	
5	-	-	-	-	-	-	FS-8	-	-	-	-	HOT WELL UNIT		-	
6	-	-	-	-	-	-	-	-	-	3/4"	150	GAS FRYER		B.T.C. THRU GAS CONNECTOR	
6-2	-	-	-	-	-	-	-	-	-	3/4"	120	GAS FRYER		B.T.C. THRU GAS CONNECTOR	
7	-	-	-	-	-	-	-	-	-	3/4"	68	25" CHAR-BROILER		B.T.C. THRU GAS CONNECTOR	
8	-	-	-	-	-	-	-	-	-	3/4"	108	48" BROILER		B.T.C. THRU GAS CONNECTOR	
10	-	-	-	-	-	-	-	-	-	3/4"	358	RANGE, 60" TO OPEN BURNERS		B.T.C. THRU GAS CONNECTOR	
10B	-	-	-	-	-	-	-	-	-	3/4"	30	36" SALAMANDER BROILER		B.T.C. THRU GAS CONNECTOR	
11	-	-	-	-	-	-	-	-	-	3/4"	50	CONVECTION OVEN, GAS		B.T.C. THRU GAS CONNECTOR	
14	-	-	-	-	-	(3) 1/2"	FS-1	-	-	-	-	THREE COMP SINK		MANFOLD DRAINS AND RUN TO FLOOR SINK	
14A	1/2"	1/2"	16"	16"	-	-	-	-	-	-	-	PRE-RINSE FAUCET W/ ADD ON		RUN DRAIN TO FLOOR SINK	
15	-	-	-	-	-	1 1/2"	FS-2 & 3	-	-	-	-	ONE COMP SINK		-	
15B	1/2"	1/2"	16"	16"	-	-	-	-	-	-	-	SPRINK MOUNT FAUCET		-	
16	-	-	-	-	-	2"	FS-4	-	-	-	-	DISHWASHER		RUN DRAIN LINE TO FLOOR SINK	
17	-	-	-	-	-	1 1/2"	FS-4	-	-	-	-	SOLEID DISHTABLE		RUN DRAIN LINE TO FLOOR SINK	
17B	1/2"	1/2"	16"	16"	-	-	-	-	-	-	-	PRE-RINSE FAUCET		RUN DRAIN LINE TO FLOOR SINK	
19	1/2"	1/2"	16"	16"	-	3 1/2"	FS-5	-	-	-	-	DROP IN SINK & FAUCET		RUN DRAIN LINE TO FLOOR SINK	
21	-	-	-	-	-	(3) 3/4"	FRD-3	-	-	-	-	BACK BAR KEE COOLER W/ DRAFT ARM		RUN DRAIN LINE TO FUNNEL DRAIN	
24	-	-	-	-	-	1/2"	FS-7	-	-	-	-	ICE BIN		RUN DRAIN LINE TO FLOOR SINK	
24B	-	-	-	-	-	3/4"	FS-7	-	-	-	-	BAR POUR RAIL		VERIFY REQUIREMENTS W/ PROVIDER	
25	-	-	-	-	-	1"	FS-6 & 7	-	-	-	-	GLASS RACK		RUN DRAIN LINE TO FLOOR SINK	
25A	1/2"	1/2"	12"	12"	-	1 1/2"	FS-6	-	-	-	-	UNDER BAR HAND SINK		RUN DRAIN LINE TO FLOOR SINK	
25B	-	1/2"	-	8"	-	1"	FS-7	-	-	-	-	GLASS WASHER		RUN DRAIN LINES TO FLOOR SINK	
25C	1/2"	-	12"	-	-	1/2"	FS-6 & 7	-	-	-	-	GLASS RINSER		RUN DRAIN LINES TO FLOOR SINK	
25D	1/2"	1/2"	12"	12"	-	1 1/2"	FS-6	-	-	-	-	UNDER BAR DUMP SINK		RUN DRAIN LINES TO FLOOR SINK	
31	1/2"	1/2"	16"	16"	-	-	-	1 1/2"	20"	-	-	HAND SINK		-	
36	-	-	-	-	-	-	-	2"	4"	-	-	MOP SINK		-	
37	1/2"	1/2"	36"	36"	-	-	-	-	-	-	-	MOP SINK SERVICE FAUCET		-	
38	3/4"	-	72"	-	-	-	-	-	-	-	-	WATER HEATER		VERIFY LOCATION	
40	1/2"	-	84"	-	-	-	FD-1	-	-	-	-	SODA SYSTEM		VERIFY REQUIREMENTS W/ PROVIDER	

DORMONT MANUFACTURING COMPANY
6015 Enterprise Drive
Export, PA 15632
Phone # 1-800-367-6668
Fax # 1-724-733-4808
www.dormont.com

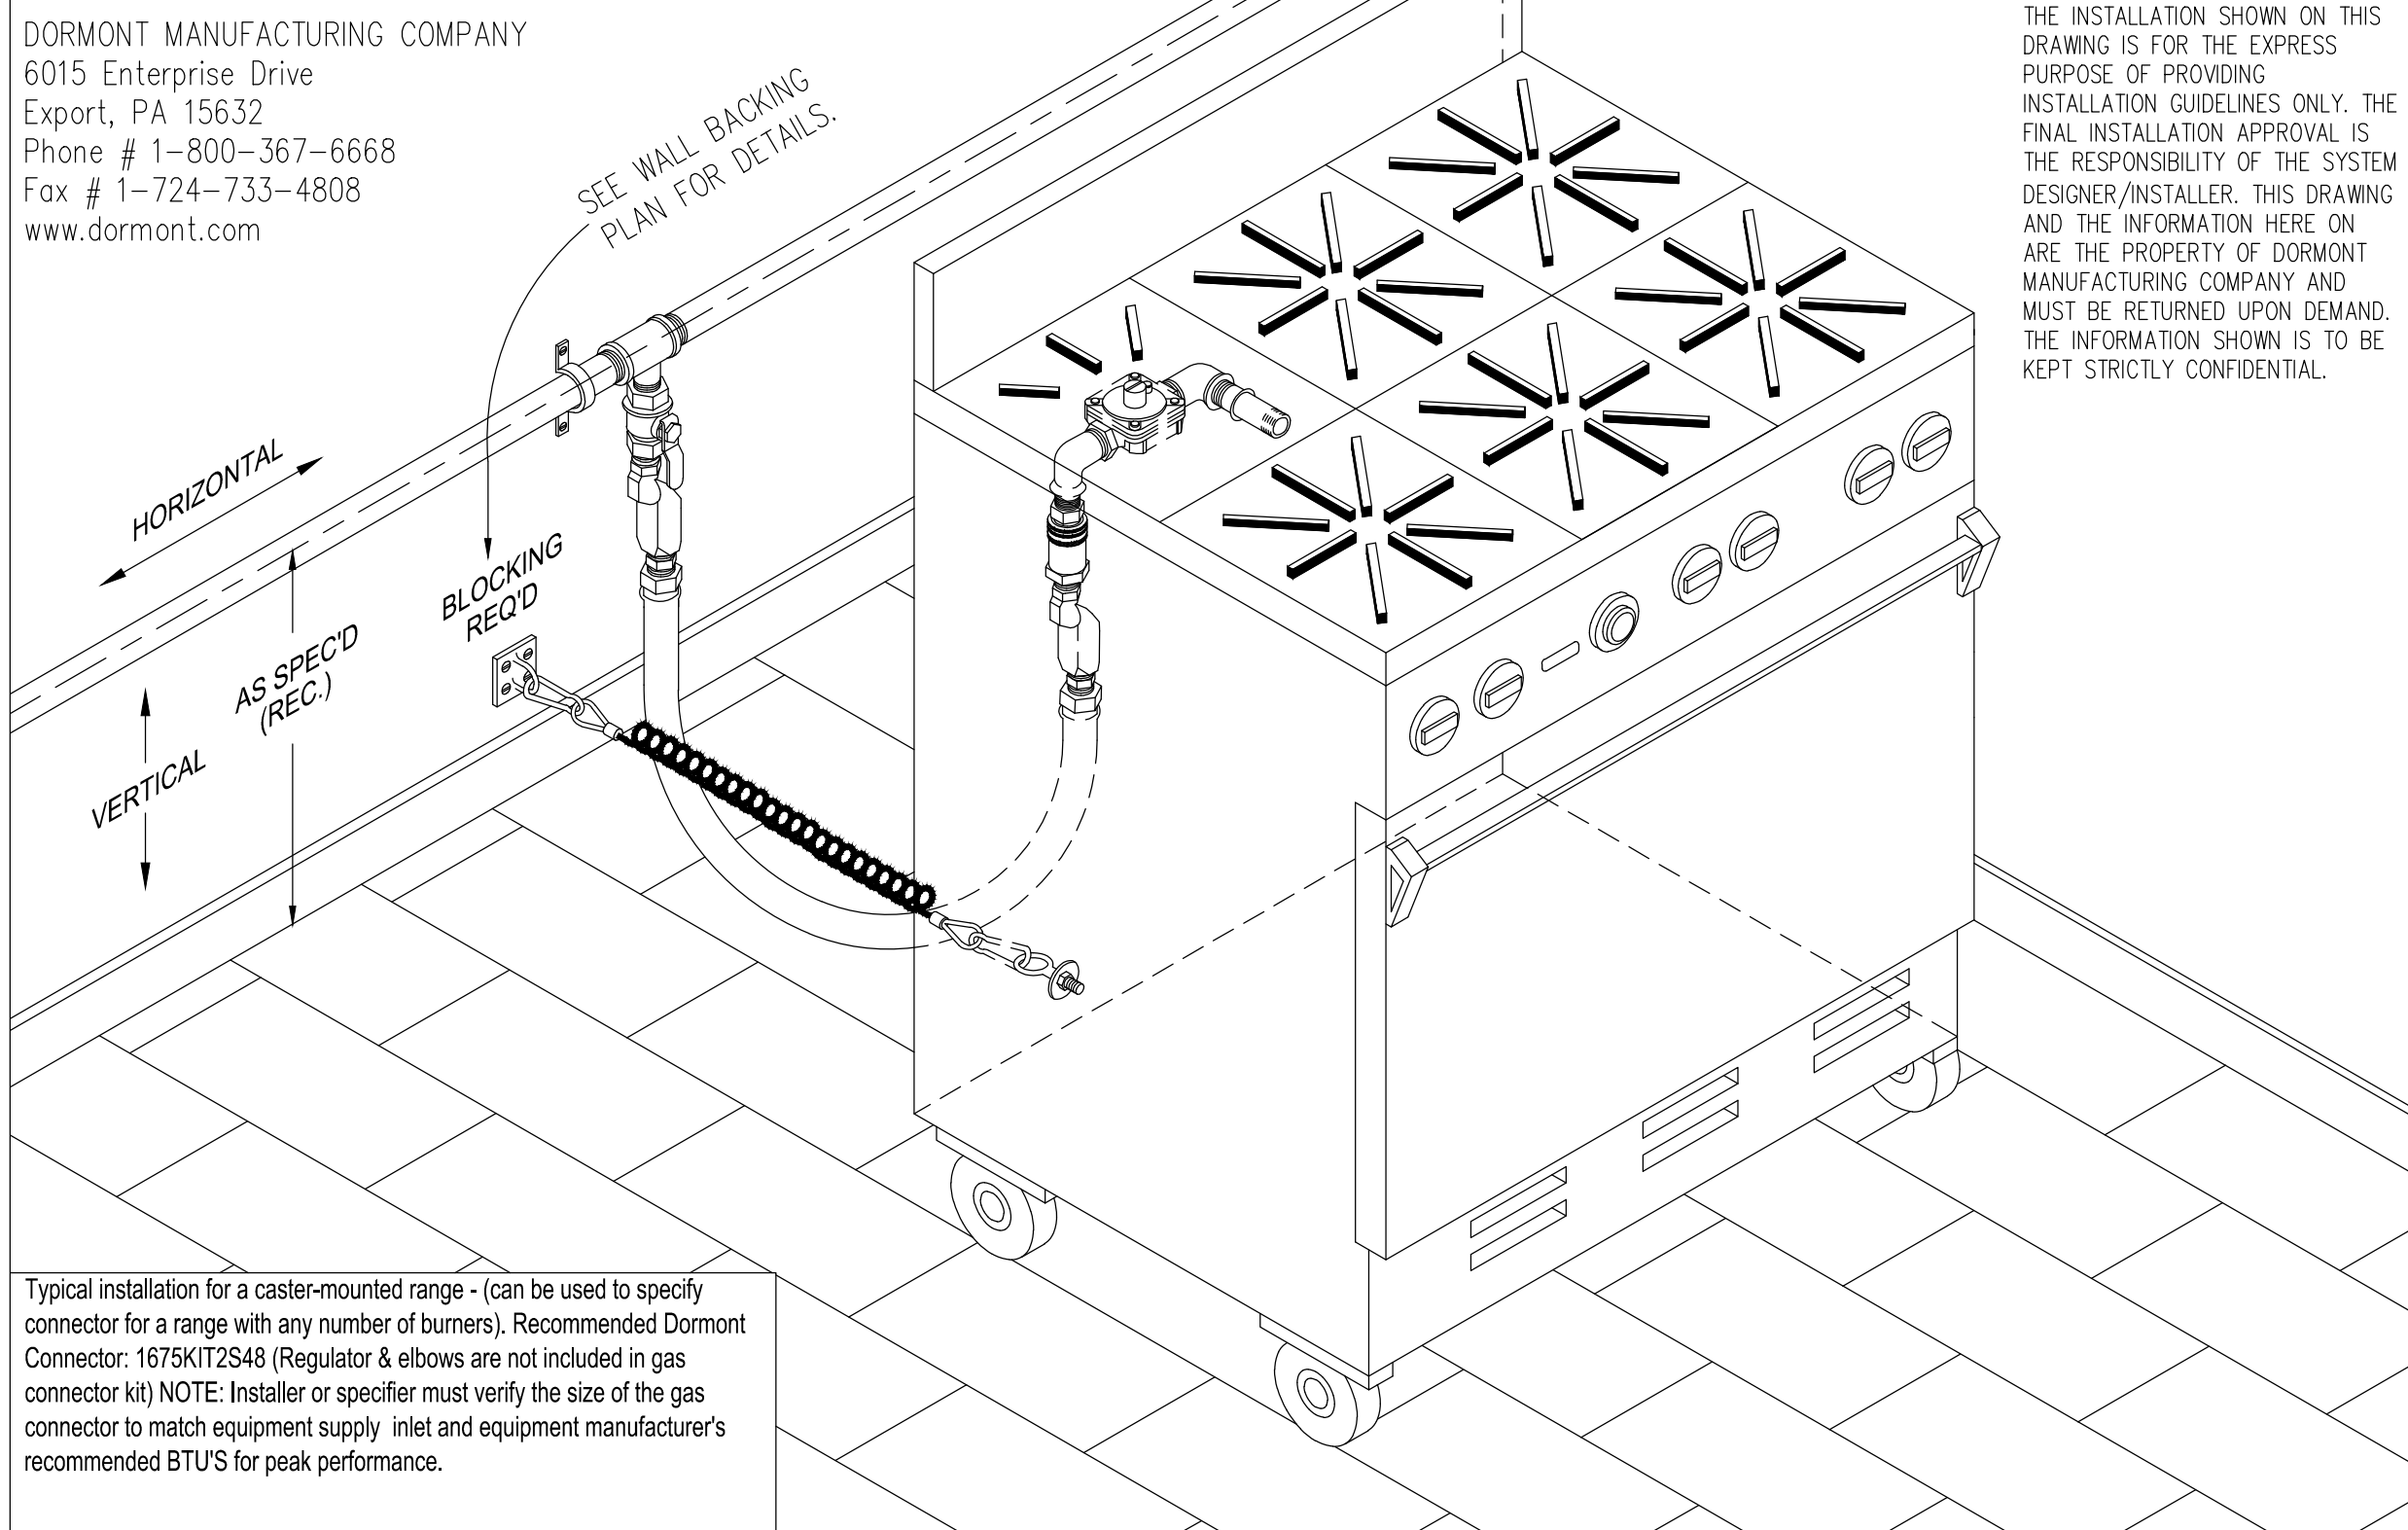

THE INSTALLATION SHOWN ON THIS DRAWING IS FOR THE EXPRESS PURPOSE OF PROVIDING INSTALLATION GUIDELINES ONLY. THE FINAL INSTALLATION APPROVAL IS THE RESPONSIBILITY OF THE SYSTEM DESIGNER/INSTALLER. THIS DRAWING AND THE INFORMATION HERE ON ARE THE PROPERTY OF DORMONT MANUFACTURING COMPANY AND MUST BE RETURNED UPON DEMAND. THE INFORMATION SHOWN IS TO BE KEPT STRICTLY CONFIDENTIAL.

PLUMBING LEGEND


- HOT WATER
- HOT WATER - SOFTENED
- COLD WATER
- COLD WATER - SOFTENED
- FILTERED WATER
- DIRECT WASTE
- FLOOR SINK - THREE-QUARTER GRATE
- FLOOR SINK - HALF GRATE
- FLOOR SINK - NO GRATE
- FLOOR DRAIN
- FUNNEL FLOOR DRAIN
- HUB FLOOR DRAIN
- AREA FLOOR DRAIN - SLOPED PER CODE
- GAS DROP FROM MANIFOLD
- FIRE SUPPRESSION GAS SHUT-OFF VALVE
- CHILLED WATER
- CHILLED WATER RETURN
- STEAM SUPPLY
- CONDENSATE RETURN

PLUMBING NOTES (DIVISION 22)

- INSTALL KEC (SECTION 114000) FURNISHED FLOOR TROUGH(S).
- INSTALL KEC (SECTION 114000) FURNISH MOP SINK(S).
- INSTALL KEC (SECTION 114000) FURNISHED FIRE SUPPRESSION SYSTEM GAS SHUT OFF VALVE. MUST BE ACCESSIBLE AND NOT CONCEALED IN WALL OR CEILING.
- INSTALL KEC (SECTION 114000) FURNISHED DRAIN LINE TEMPERING KIT PER MANUFACTURER'S RECOMMENDATIONS.
- MANFOLD DRAINS TO SINGLE CONNECTION.
- FURNISH AND INSTALL BALL VALVE IN DRAIN LINE. VALVE TO BE IN EASILY ACCESSIBLE LOCATION.
- PIPING FROM WATER FILTER OUTLET TO POINTS OF USE SHALL BE CONCEALED WITHIN WALLS AND CEILINGS. EXTEND DRAIN(S) TO FLOOR SINK/FLOOR DRAIN, IF REQUIRED.
- CONNECT MIN. 110°F HOT WATER SUPPLY TO BUILT-IN OR EXTERNAL (70" RISE) BOOSTER HEATER. WHEN EXTERNAL, INSTALL TEMPERATURE/PRESSURE GAUGE(S) AS REQ'D AND EXTEND TO DISHWASHER INLET.
- CONNECT DRAIN(S) WITH REFRIGERATION GRADE HARD COPPER USING 1" STANDOFFS. "P" TRAP DRAIN OUTSIDE WALK-IN COMPARTMENT(S). PROVIDE AND INSTALL SLEEVES THRU WALK-IN AND BUILDING WALLS FOR DRAIN LINE(S). FOAM & CAULK AROUND SLEEVES AND DRAIN LINES. WRAP WITH DRAIN LINE HEATER AND INSULATION WHERE SUBJECT TO FREEZING TEMPERATURES.
- PROVIDE GRAY WATER AND SLURRY PIPING TO AND FROM (SECTION 114000) FURNISHED PULPER, TROUGH, AND WATER EXTRACTOR. INSTALL KEC (SECTION 114000) FURNISHED TROUGH INLET NOZZLES AND PROVIDE SHUT OFF VALVE AT EACH NOZZLE.
- PROVIDE "TEE" IN HOT WATER LINE AND CAP FOR FUTURE INSTALLATION OF CHEMICAL DISPENSING SYSTEM BY OTHERS.
- PROVIDE CHROME PLATED PIPE AND FITTINGS WHERE EXPOSED.
- PROVIDE AND INSTALL 3" MIN. DRAIN LINE TO 12"x12"x10" DEEP FLOOR SINK.
- VERIFY EXACT LOCATION AND QUANTITY OF AREA FLOOR DRAIN(S) WITH THE PLUMBING ENGINEER.



REFRIGERATION SCHEDULE

CONDENSING UNITS LOCATED ON CONCRETE SLAB/ BUILDING ROOF. SEE ARCHITECTURAL DRAWINGS FOR EXACT LOCATIONS.

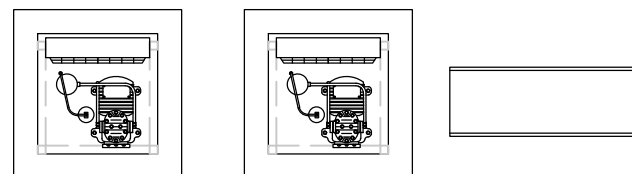

EXHAUST/SUPPLY FAN SCHEDULE

FANS LOCATED ON BUILDING ROOF. SEE ARCHITECTURAL DRAWINGS FOR EXACT LOCATIONS.

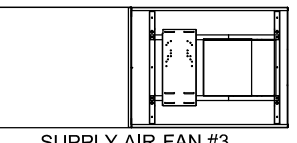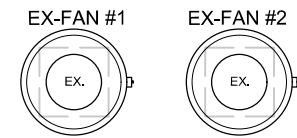

B

FOODSERVICE DRAWINGS INDICATE PLUMBING ROUGH-IN/CONNECTION POINTS ONLY FOR EQUIPMENT SPECIFIED UNDER THE KITCHEN EQUIPMENT (SECTION 114000) CONTRACT. ANY ADDITIONAL PLUMBING REQUIREMENTS ARE NOT INDICATED ON FOODSERVICE DRAWINGS. THE PLUMBING CONTRACTOR (DIVISION 22) SHALL FURNISH AND INSTALL PRESSURE REDUCING VALVES, FLOW CONTROLS, BACK FLOW PREVENTION, RPZ (REDUCED PRESSURE ZONE) VALVES, WATER HAMMER ARRESTOR, GATE VALVES, FOR WATER CONNECTIONS AS REQUIRED PER LOCAL CODES.



2801 South Valley Parkway, Suite 200
Lewisville, TX 75067
p. 469-240-7200

trimarkusa.com

This document contains confidential information, is an instrument of a professional service, and the property of TriMark. It shall not be used on other projects or for the extension of this project without TriMark's written approval.

Owner and all Contractors to check and verify existing dimensions and conditions in the field before starting construction and to notify TriMark of any material or detail changes.

REVISIONS

DATE	NO.	DESCRIPTION
03-14-22	B	G.C.SHOP DWG. COORD.2

7 Tequila
Holly Springs, GA.

Back of House and Bar

PROJECT NUMBER: 22.1228

DATE: 02/09/2022

SCALE: 1/4" = 1'-0"

DRAWN BY: RJF APPROVED BY: JBS


SHEET TITLE:

FOODSERVICE PLUMBING
ABOVE SLAB ROUGH-IN PLAN

SHEET NUMBER:

QF202

THIS DOCUMENT WAS ORIGINALLY PRINTED ON A 30" x 42" SIZE SHEET

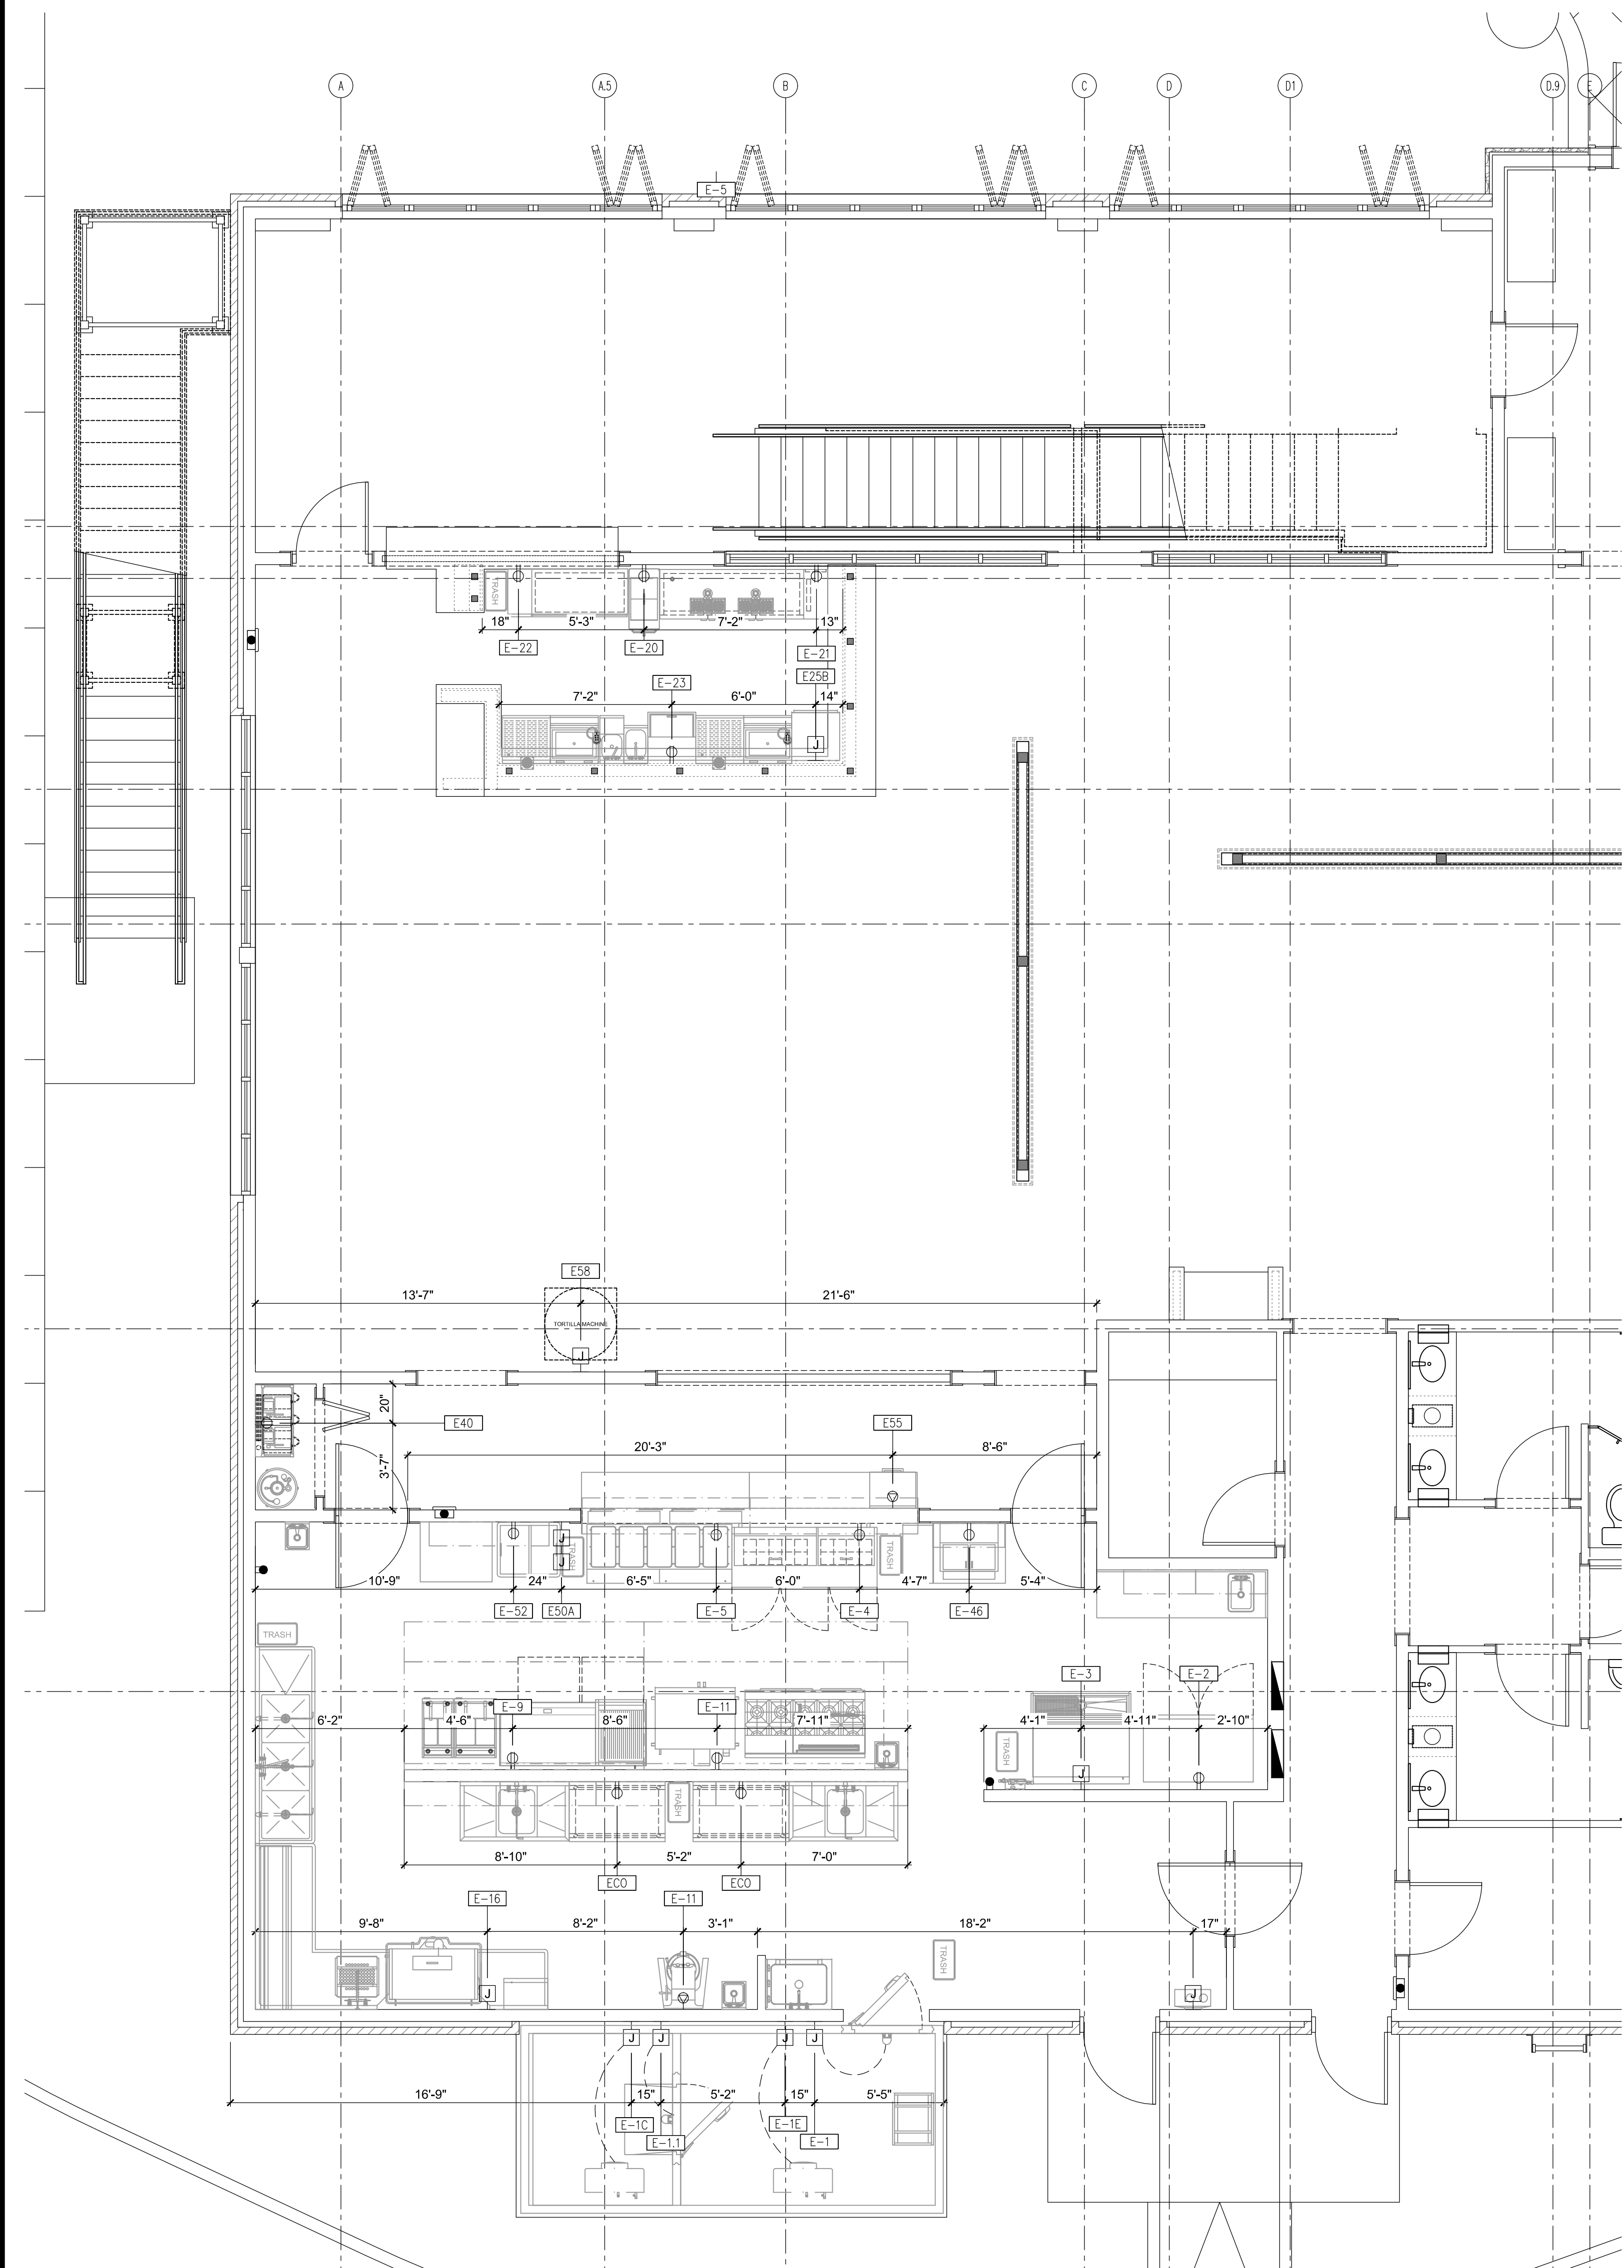


FOODSERVICE DRAWINGS INDICATE ELECTRICAL ROUGH-IN/CONNECTION POINTS ONLY FOR EQUIPMENT SPECIFIED UNDER THE KITCHEN EQUIPMENT (SECTION 114000) CONTRACT. ANY ADDITIONAL ELECTRICAL REQUIREMENTS ARE NOT INDICATED ON FOODSERVICE DRAWINGS.

EQUIPMENT ELECTRICAL SCHEDULE

ITEM #	VOLTS	PHASE	AMPS	KW	HP	DIRECT	PLUG	NEMA	ELEVATION AFT. (IN)	EQUIPMENT CATEGORY	ELECTRICAL REMARKS
E1	115	1	1.0	-	-	-	-	-	108"	WALK-IN COOLER	FOR LIGHTS & ACCESSORIES
E1.1	115	1	2.2	-	-	X	-	-	108"	WALK-IN FREEZER	FOR LIGHTS & ACCESSORIES
E1A	208-230	1	15.0	-	1.5	X	-	-	ROOF	WALK-IN FREEZER CONDENSING UNIT	REFER TO SHOP DRAWINGS
E1C	208-230	1	0.5	-	-	X	-	-	108"	WALK-IN FREEZER REFRIGERATION COIL	REFER TO SHOP DRAWINGS
E1D	0	1	15.0	-	0.5	X	-	-	ROOF	WALK-IN COOLER CONDENSING UNIT	REFER TO SHOP DRAWINGS
E1E	208-230	1	0.9	-	-	X	-	-	108"	WALK-IN COOLER REFRIGERATION COIL	REFER TO SHOP DRAWINGS
E2	115	1	4.5	-	1/4	-	X	5-15P	24"	REACH IN REFRIGERATOR	-
E3	208-230	1	15.9	-	-	X	-	-	72"	ICE MACHINE	POWER THRU ICE MACHINE
E3B	115	1	*	-	-	X	-	-	ROOF	ICE MACHINE REMOTE CONDENSER	-
E4	115	1	5.7	-	2/5	-	X	5-15P	24"	REFRIGERATED SANDWICH/SALAD PREP	-
E5	120	1	20.8	2.5	-	-	X	L5-30	24"	HOT FOOD SERVING COUNTER	-
E9	115	1	3.0	-	1/5	-	X	5-15P	24"	EQUIPMENT STAND	-
E11	120	1	7.7	-	1/2	-	X	5-15P	33"	CONVECTION OVEN	-
E13	208	3	7.0	-	2.0	-	X	L15-20P	24"	FLOOR MIXER	-
E16	115	1	30.0	-	1.0	X	-	-	60"	DISH MACHINE	-
E20	115	1	16.0	-	1/3	-	X	5-20P	24"	FROZEN BEVERAGE MACHINE	-
E21	120	1	4.2	-	1/4	-	X	5-15P	24"	KEG COOLER REFRIGERATOR	-
E22	115	1	4.8	-	1/4	-	X	5-15P	24"	BACK BAR REFRIGERATOR	-
E23	120	1	3.8	-	1/4	-	X	5-15P	24"	GLASS FROSTER	-
E25B	115	1	16.0	-	-	1.0	X	-	24"	GLASS WASHER	-
E48	120	-	-	-	-	-	-	-	-	INSTANT WATER HEATER	VERIFY REQUIREMENTS W/ PROVIDER
E40	120	1	20.0	-	-	-	X	5-20P	96"	SODA SYSTEM, CARBONATOR	BY PURVEYOR
E46	120	1	13.6	-	-	-	X	5-15P	48"	NACHO CHIP WARMER	-
E50A	120	1	6.7	0.8	-	-	X	-	60"	HEAT LAMPS	-
E52	115	1	1.3	-	-	-	-	-	24"	CHEST FREEZER	-
E55	240	1	16.6	4.0	-	-	X	6-20P	48"	SALAMANDER BROILER	-
E56	120	1	15.0	-	-	-	X	-	108"	EXHAUST HOOD, MAIN HOOD VERIFY	FOR LIGHTS & CONTROLS, REF. TO SHOP DWGS
E56A	120	-	15.0	-	-	-	X	-	108"	FIRE SYSTEM	BY MICRO-SWITCH SEE SHOP DRAWINGS
E56B	208	3	7.5	-	2.0	X	-	-	ROOF	EXHAUST FAN, FAN 1 & FAN 2	REFER TO SHOP DRAWINGS
E56C	208	3	9.4	-	2.0	X	-	-	ROOF	MAKEUP AIR FAN, FAN 3	REFER TO SHOP DRAWINGS
E58	-	-	-	-	-	-	-	-	24"	X-PRESS TORTILLA MACHINE	VERIFY REQUIREMENTS W/ PROVIDER

RECESSED REMOTE FIRE PULL DETAIL

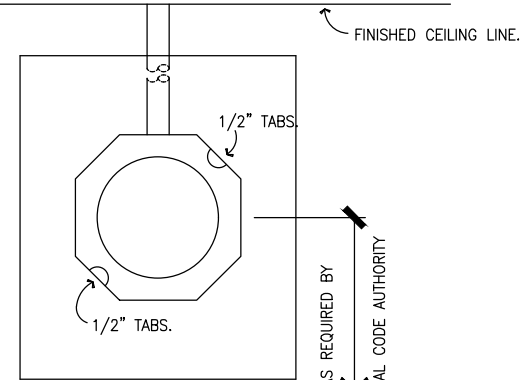


ONE (1) 1/2\"/>

FIRE SYSTEM NOTES
ALL ELECTRICAL EQUIPMENT UNDER HOODS, INCLUDING CONTROL, CIRCUITRY AND CONVENTIONAL RELAYS, MUST BE WIRED TO HOOD FIRE SYSTEM FOR SHUNT TRIP TRIP BREAKER(S) OR SHUNT DOWN OF POWER TO ALL ELECTRICAL DEVICES UNDER HOOD(S) AND 18\"/>

MICRO-SWITCH PROVIDED AT HOOD FIRE SYSTEM FOR TIE IN TO BUILDING ALARM SYSTEM BY ALARM CONTRACTOR. (IF REQUIRED)
NOTE: HOOD FIRE SYSTEM ACTIVATES MECHANICALLY AND REQUIRES NO POWER TO OPERATE. HOOD FIRE SYSTEM MICRO-SWITCHES PROVIDED FOR SHUT DOWN:
MECHANICAL GAS VALVE FURNISHED BY FIRE PROTECTION CONTRACTOR AND INSTALLED BY PLUMBING CONTRACTOR.


FOR BEST PERFORMANCE ALLOW 24\"/>

REFER TO ARCHITECTURAL DRAWING FOR PENETRATION APPLICATION.

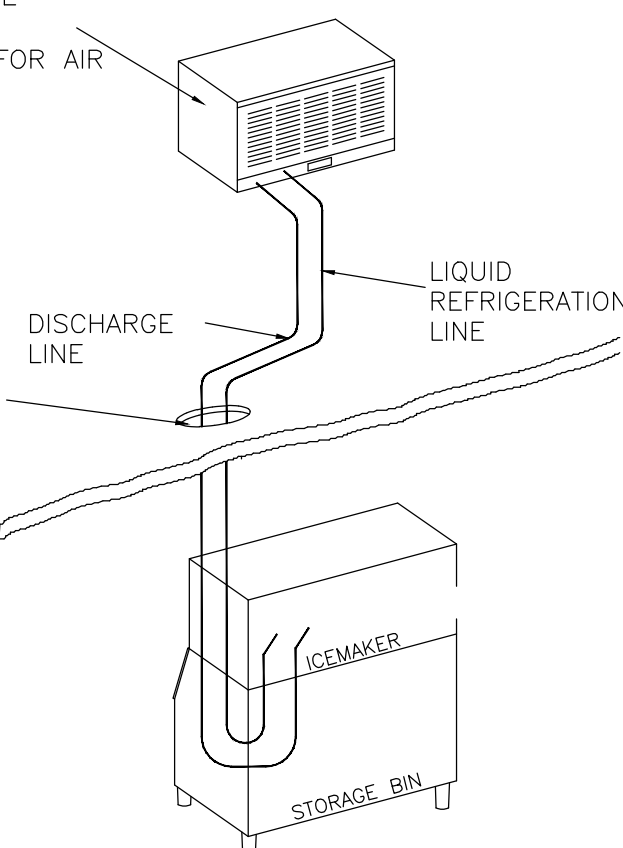

REFRIGERATION SCHEDULE

CONDENSING UNITS LOCATED ON CONCRETE SLAB/ BUILDING ROOF. SEE ARCHITECTURAL DRAWINGS FOR EXACT LOCATIONS.

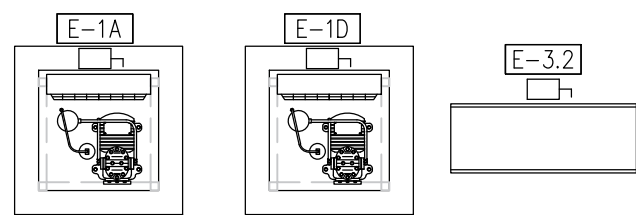

ELECTRICAL LEGEND




- DUPLEX RECEPTACLE
- WEATHERPROOF RECEPTACLE
- SINGLE RECEPTACLE
- SPECIAL PURPOSE RECEPTACLE
- QUAD RECEPTACLE
- FLUSH FLOOR MOUNT RECEPTACLE
- JUNCTION BOX - FLOOR/CLG MOUNTED
- JUNCTION BOX - WALL MOUNTED
- SWITCH
- DATA CONNECTION
- MANUAL FIRE PULL STATION
- DROP CORD MOUNTED FROM CEILING
- CONDUIT STUB LOCATION
- DEFROST TIME CLOCK
- DISCONNECT
- LIGHT - RECTANGULAR
- LIGHT - ROUND
- MOTOR
- EXHAUST HOOD SENSOR
- TEMPERATURE SENSOR
- PLUG MOLD

ELECTRIC NOTES (DIVISION 26)

- FURNISH AND INSTALL CORD AND PLUG SET(S).
- FURNISH AND INSTALL DEVICE & COVER IN KEC (SECTION 114000) FURNISHED JUNCTION BOX.
- FURNISH AND INSTALL JUNCTION BOX(S), DEVICE(S), AND COVER(S) IN KEC (SECTION 114000) FURNISHED EQUIPMENT.
- CONNECT THRU DISPOSER CONTROL TO SOLENOID VALVE AND MOTOR.
- CONNECT FROM KEC (SECTION 114000) FURNISHED ICE MACHINE TO REMOTE CONDENSER AS REQ'D.
- CONNECT THRU KEC (SECTION 114000) FURNISHED AIR CURTAIN TO DOOR ACTIVATED MICROSWITCH.
- CONNECT THRU KEC (SECTION 114000) FURNISHED REMOTE CONTROL SWITCH(ES).
- FURNISH AND INSTALL SWITCH. CONNECT TO LIGHTS FURNISHED BY KEC (SECTION 114000).
- CONNECT POWER SUPPLY TO KEC (SECTION 114000) FURNISHED LOAD CENTER. COUNTER SHALL BE PREWIRED AND SHIPPED IN SECTIONS. CONNECT BETWEEN SECTIONS.
- CONNECT TO KEC (SECTION 114000) FURNISHED JUNCTION BOX AT WALK-IN DOOR ASSEMBLY. LIGHT FIXTURE AT DOOR IS PREWIRED TO FACTORY MOUNTED LIGHT SWITCH. MOUNT ADDITIONAL KEC (SECTION 114000) FURNISHED LIGHTS WHERE INDICATED AND CONNECT TO SWITCH. CONDUIT SHALL BE INSTALLED ABOVE WALK-IN AND NOT EXPOSED ON INTERIOR UNLESS REQ'D. CONDUIT PENETRATING WALK-IN SHALL BE NON-METALLIC OR PVC.
- CONNECT KEC (SECTION 114000) FURNISHED TEMPERATURE ALARM SYSTEM. COORDINATE WITH BUILDING SYSTEM(S).
- INSTALL KEC (SECTION 114000) FURNISHED DEFROST TIMER. CONNECT THRU TIMER TO EVAPORATOR COIL.
- CONNECT FROM KEC (SECTION 114000) FURNISHED CONDENSING UNIT, THRU DEFROST TIMER, TO EVAPORATOR COIL.
- FURNISH AND INSTALL NEMA RECEPTACLE WITH WEATHER COVER BEHIND FREEZER EVAPORATOR COIL FOR DRAIN LINE HEATER.
- CONNECT EXHAUST FAN THRU FAN CONTROL CONTACTS IN DISHWASHER.
- CONNECT TABLE LIMIT SWITCH TO DRY CONTACT ON KEC (SECTION 11400) FURNISHED DISH MACHINE.
- CONNECT DRAIN WATER TEMPERING DEVICE PER MANUFACTURER'S RECOMMENDATIONS.
- CONNECT TO EXHAUST HOOD LIGHT(S), CONTROL(S), AND EXHAUST FAN(S)/MAKE-UP AIR UNIT(S) AS REQ'D. INTERWIRE HOOD SECTIONS, MOTOR STARTER(S)/DRIVES, AND OVERLOAD PROTECTION AS REQ'D. INSTALL COMPONENTS AND SENSORS SHIPPED LOOSE. REFER TO SYSTEM SHOP DRAWING(S) FOR ADDITIONAL SCHEMATICS.
- CONNECT 120 VOLT FROM KEC (SECTION 114000) FURNISHED MICRO SWITCH IN FIRE SUPPRESSION SYSTEM CONTROL PANEL TO SHUNT TRIP BREAKER(S) FOR SHUT DOWN OF POWER TO ALL ELECTRICAL DEVICES UNDER HOOD(S) AND 18\"/>
- CONNECT FROM MICRO SWITCH TO DIVISION 26 FURNISHED RELAY(S) OR SWITCHES FOR SHUT DOWN/CONTROL OF HOOD LIGHTS, MAKE-UP AIR FAN, AND FIRE ALARM SYSTEM.
- CONNECT 120 VOLT FROM KEC (SECTION 114000) FURNISHED MICRO SWITCH IN FIRE SUPPRESSION SYSTEM CONTROL PANEL THRU MANUAL RESET RELAY TO ELECTRIC GAS VALVE. PROVIDE CONTROL/INTERWIRING BETWEEN THE FIRE SUPPRESSION SYSTEM AND ASSOCIATED ELECTRICAL GAS SOLENOID VALVES, RESET RELAYS, AND PULL STATIONS AS REQ'D.
- FURNISH AND INSTALL CONCEALED CONDUIT AND RECESSED OCTAGONAL JUNCTION BOX IN WALL AT 42\"/>
- PROVIDE 3/4\"/>

EXHAUST/SUPPLY FAN SCHEDULE

FANS LOCATED ON BUILDING ROOF. SEE ARCHITECTURAL DRAWINGS FOR EXACT LOCATIONS.

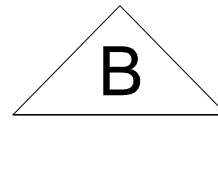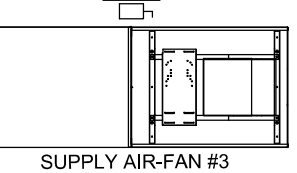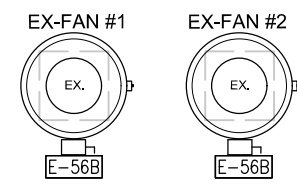


REVISIONS

DATE	NO.	DESCRIPTION
03-14-22	B	G.C.SHOP DWG. COORD.2

PROJECT NUMBER	22.1228
DATE:	02/09/2022
SCALE:	1/4" = 1'-0"
DRAWN BY:	RJF
APPROVED BY:	JBS

SHEET TITLE:	FOODSERVICE ELECTRICAL ROUGH-IN PLAN
--------------	--------------------------------------

SHEET NUMBER:	QF301
---------------	-------

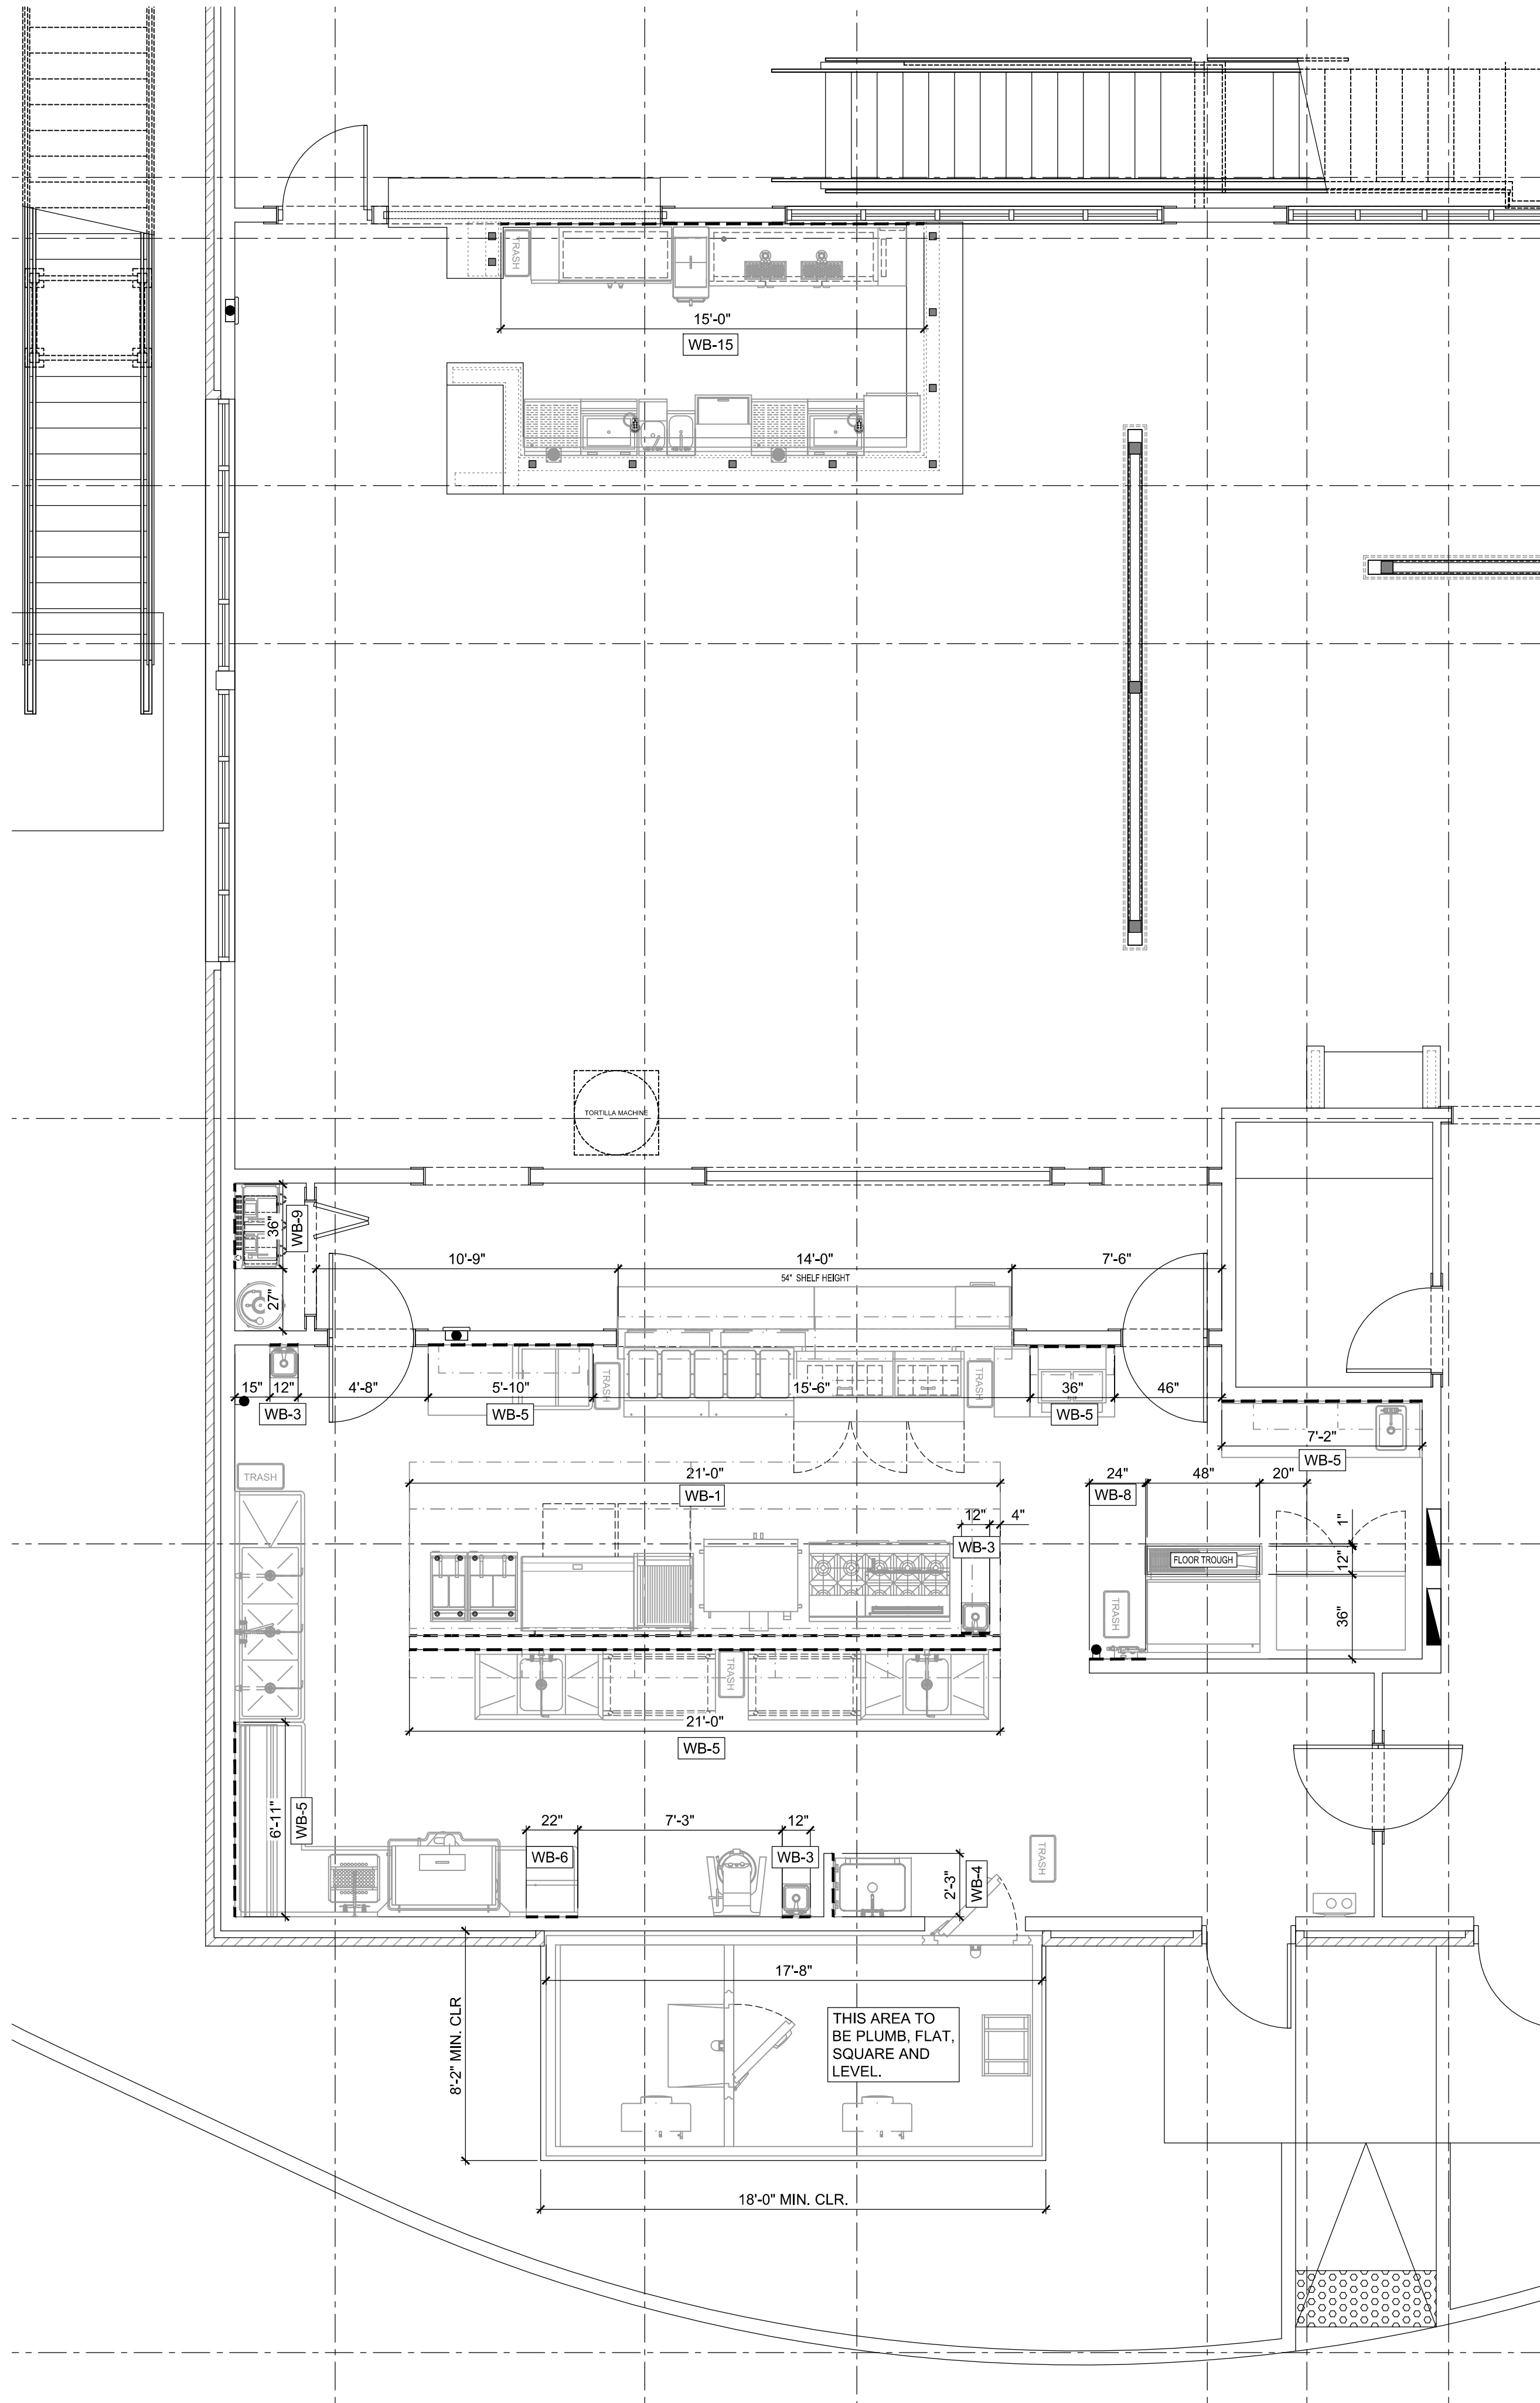

SPECIAL CONDITIONS LEGEND

- ⓑ BEVERAGE CONDUIT STUB UP
— R — REFRIGERATION LINE SET
- - - - - WALL BLOCKING
- · - · - ENGINEERED STRUCTURAL SUPPORT
□ □ □ □ □ NON-COMBUSTIBLE WALL CONSTRUCTION

SPECIAL CONDITIONS NOTES

- A. BUILDING FLOOR BENEATH WALK-IN MUST BE LEVEL WITHIN PLUS OR MINUS 1/8". REFER TO DETAIL #X/QFXXX.
B. GENERAL CONTRACTOR AND/OR SUBDIVISIONS SHALL PROVIDE INSULATED FLOOR SLAB BENEATH WALK-IN. REFER TO DETAIL #X/QFXXX.
C. GENERAL CONTRACTOR AND/OR SUBDIVISIONS SHALL PROVIDE 4" DEEP FLOOR DEPRESSION FROM FINISHED FLOOR FOR INSTALLATION OF FLOOR TROUGH BY PLUMBING CONTRACTOR (DIVISION 26). GENERAL CONTRACTOR TO BACK-FILL WITH GROUT.
D. GENERAL CONTRACTOR AND/OR SUBDIVISIONS SHALL FURNISH AND INSTALL CONCRETE PAD FOR KEC (SECTION 114000) FURNISHED REFRIGERATION RACK/CONDENSING UNITS.
E. HVAC/MECHANICAL CONTRACTOR (DIVISION 23) SHALL INSTALL KEC (SECTION 114000) FURNISHED RAILS & ROOF CURBS FOR EXHAUST FAN(S) AND MAKE-UP AIR UNIT(S).
F. KEC (SECTION 114000) SHALL FURNISH AND INSTALL RAILS AND ROOF CURBS FOR EXHAUST FAN(S) AND MAKE-UP AIR UNIT(S). GENERAL CONTRACTOR AND/OR SUBDIVISIONS SHALL FLASH-IN RAILS AND ROOF CURBS.
G. GENERAL CONTRACTOR AND/OR SUBDIVISIONS SHALL PROVIDE STRUCTURAL REINFORCEMENT ABOVE CEILING AS REQ'D FOR KEC (SECTION 114000) FURNISHED EQUIPMENT.
H. GENERAL CONTRACTOR AND/OR SUBDIVISIONS SHALL PROVIDE MINIMUM VERTICAL CLEARANCE OF 9'-0" AT WALK-IN.
I. GENERAL CONTRACTOR AND/OR SUBDIVISIONS SHALL PROVIDE MINIMUM VERTICAL CLEARANCE OF 9'-0" AT EXHAUST HOOD.
J. GENERAL CONTRACTOR AND/OR SUBDIVISIONS SHALL PROVIDE MINIMUM VERTICAL CLEARANCE OF X'-X" AT ICE MAKER.


WALL BLOCKING NOTES (DIVISION 6)

- WB-1 12" AFF TO 24" AFF FOR RESTRAINING DEVICE
WB-2 18" AFF TO 30" AFF FOR WATER FILTER
WB-3 30" AFF TO 54" AFF FOR HAND SINK
WB-4 48" AFF TO 60" AFF FOR WALL SHELF/MOP RACK/POT FILLER
WB-5 48" AFF TO 78" AFF FOR 2-TIER WALL SHELVES
WB-6 48" AFF TO 84" AFF FOR RACK SHELF
WB-7 54" AFF TO 90" AFF FOR WALL CABINET/SALAMANDER
WB-8 60" AFF TO 78" AFF FOR WATER FILTER
WB-9 66" AFF TO 84" AFF FOR POT RACK / SODA SYSTEM
WB-10 72" AFF TO CEILING FOR FIRE SUPPRESSION/hood CONTROL
WB-11 78" AFF TO 114" AFF FOR EXHAUST HOOD
WB-12 84" AFF TO 102" AFF FOR WATER FILTER/AIR CURTAIN
WB-13 102" AFF TO 114" AFF FOR CLG MOUNT AIR CURTAIN
WB-14 36" AFF TO 60" AFF FOR SALAMANDER BRACKET
WB-15 VERIFY WITH ARCHITECT FOR BACK BAR SUPERSTRUCTURE

NOTE: ALL WALL BLOCKING TO BE 5/8" FIRE RATED/TREATED PLYWOOD MINIMUM OR 18 GAUGE METAL WHERE REQUIRED



EXHAUST/SUPPLY FAN SCHEDULE

FANS LOCATED ON BUILDING ROOF. SEE ARCHITECTURAL DRAWINGS FOR EXACT LOCATIONS.

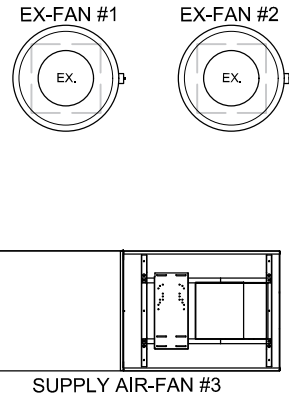

REFRIGERATION SCHEDULE

CONDENSING UNITS LOCATED ON CONCRETE SLAB/ BUILDING ROOF. SEE ARCHITECTURAL DRAWINGS FOR EXACT LOCATIONS.

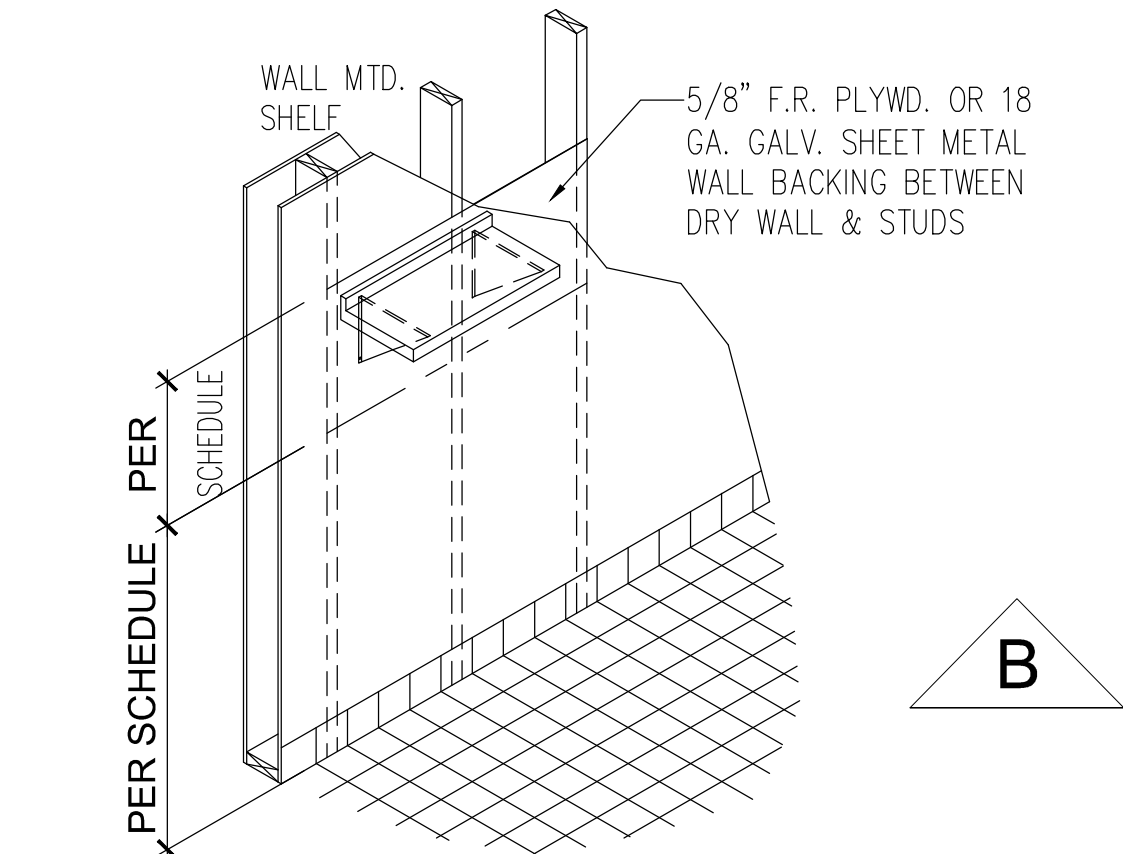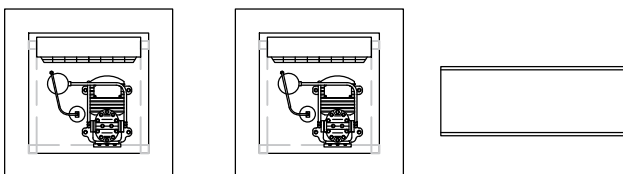

WALL BACKING EXAMPLE

REVISIONS

DATE	NO.	DESCRIPTION
03-14-22	B	G.C.SHOP DWG. COORD.2

7 Tequila


Holly Springs, GA.

Back of House and Bar

PROJECT NUMBER:	22.1228
DATE:	02/09/2022
SCALE:	1/4" = 1'-0"
DRAWN BY:	RJF
APPROVED BY:	JBS

SHEET TITLE:
FOODSERVICE SPECIAL CONDITIONS PLAN

SHEET NUMBER:
QF401

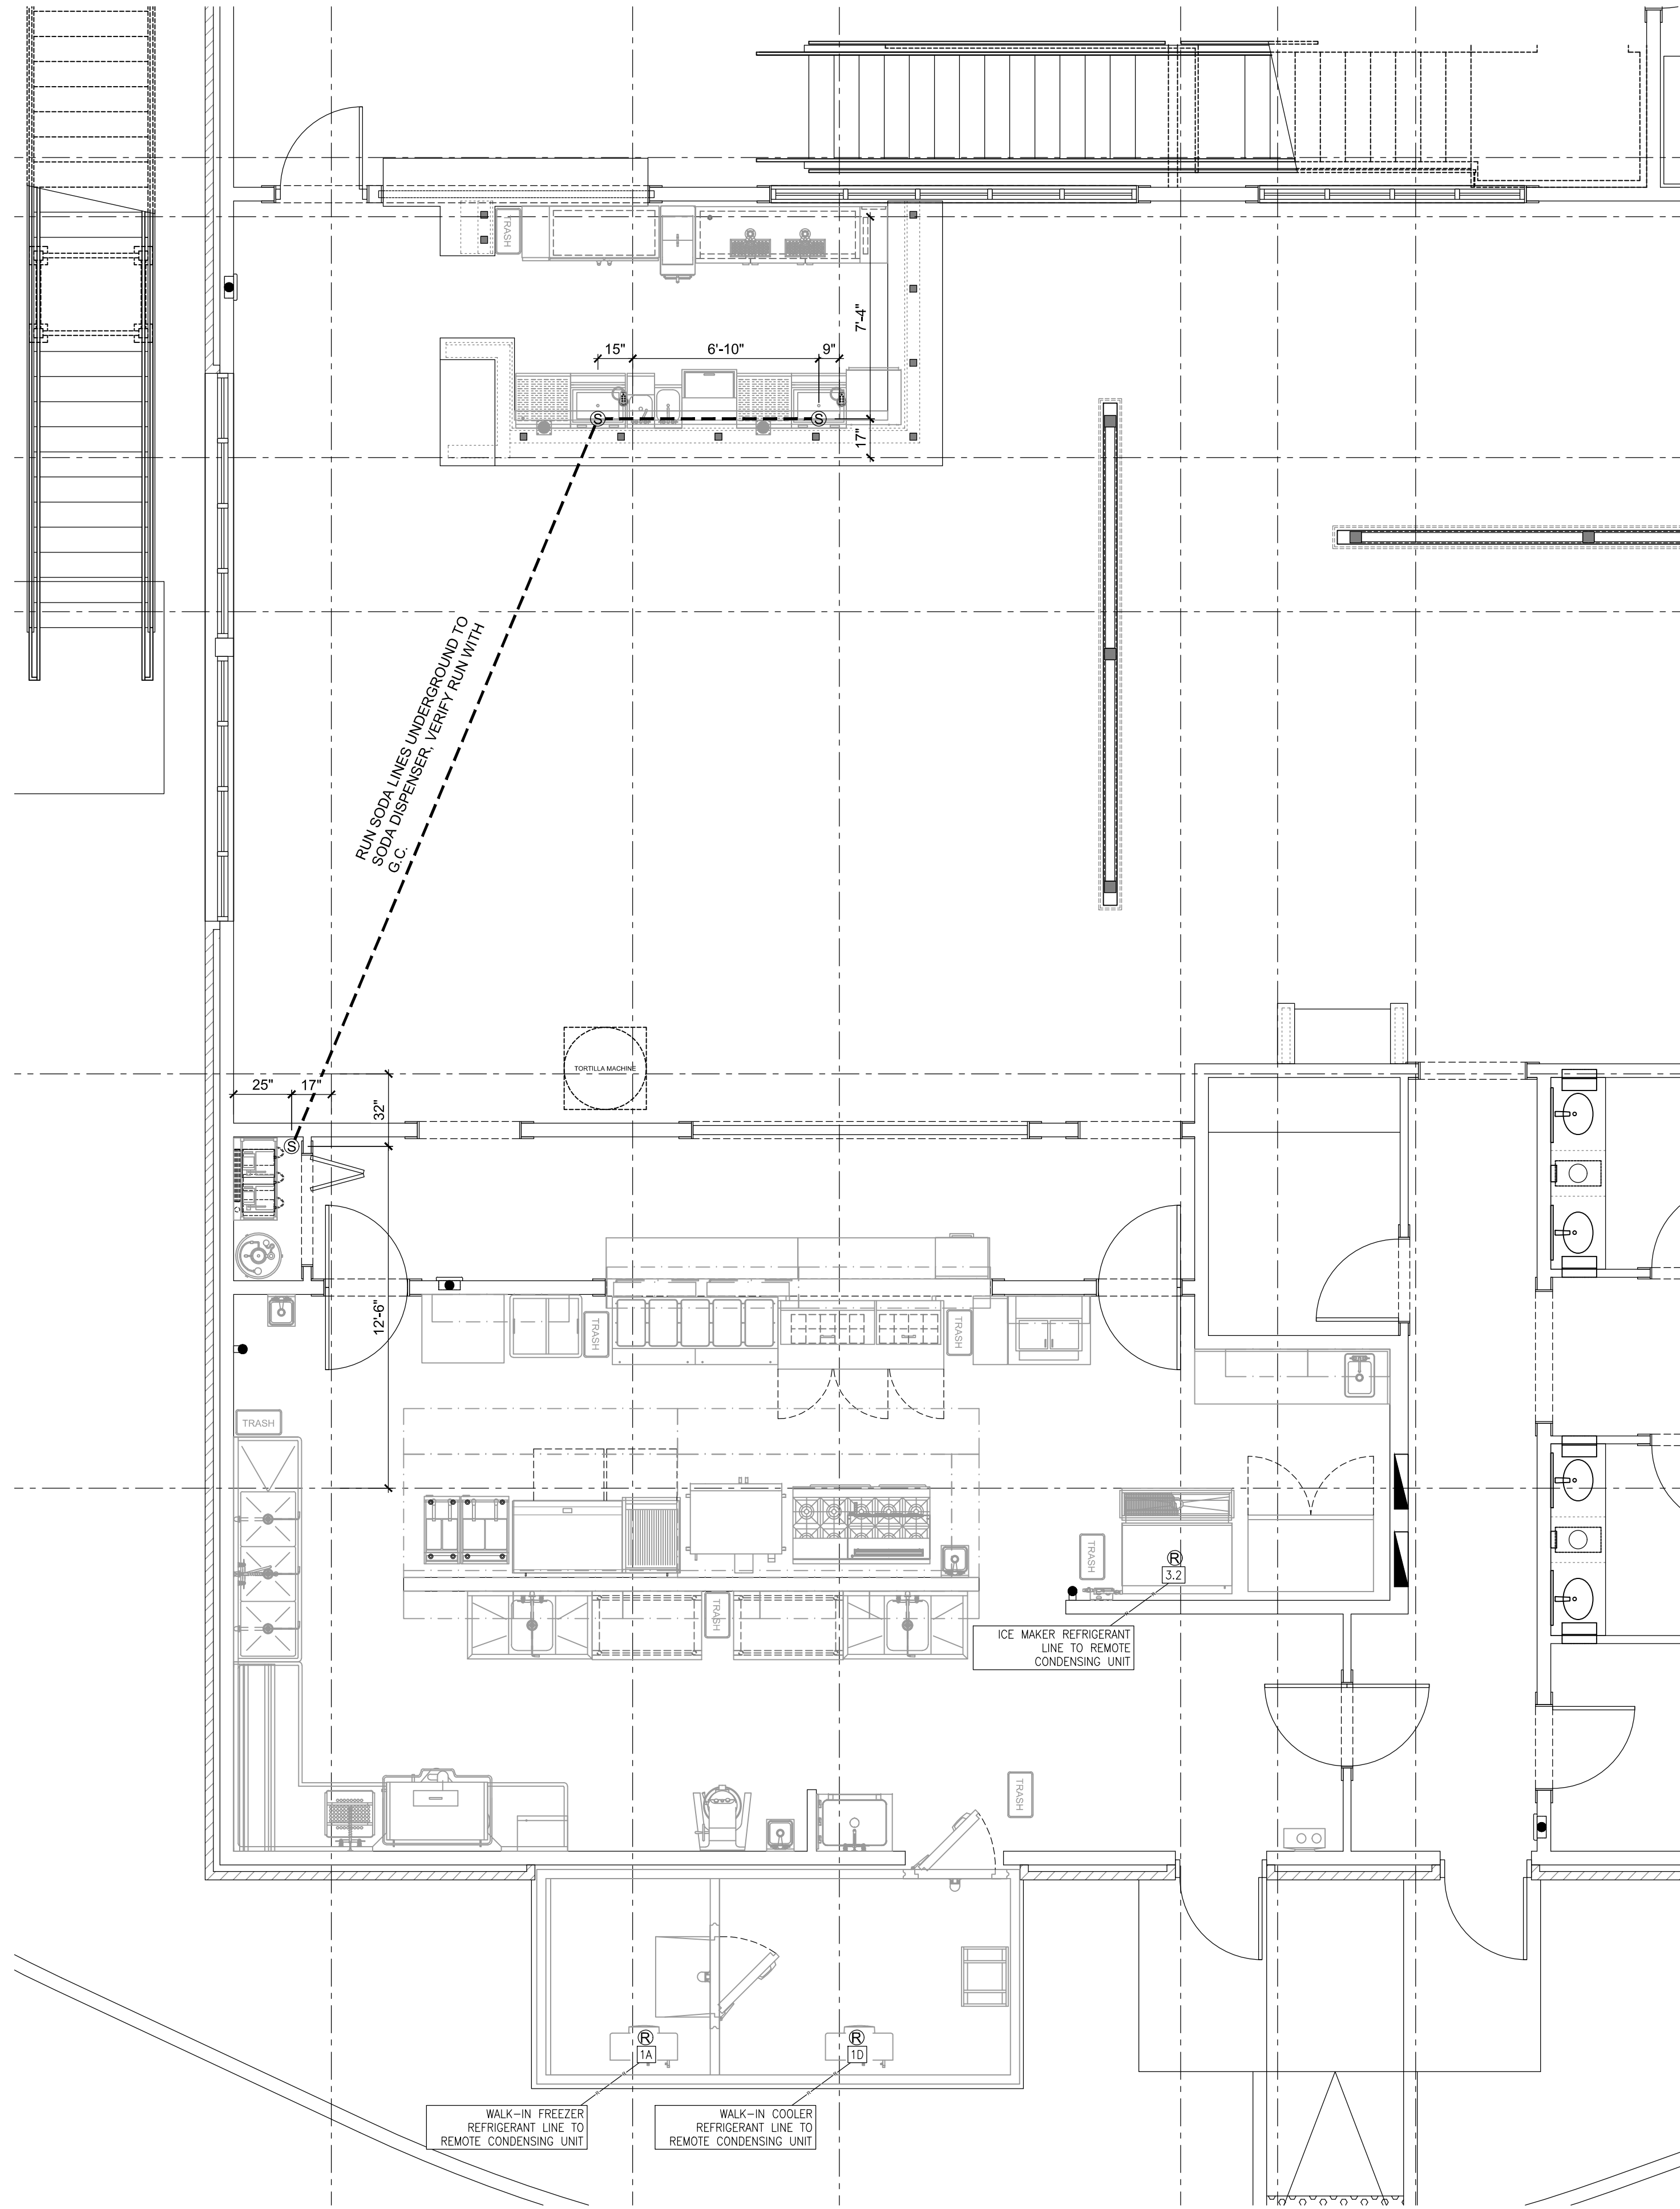

SPECIAL CONDITIONS LEGEND

- Ⓟ BEVERAGE CONDUIT STUB UP
- R — REFRIGERATION LINE SET
- WALL BLOCKING
- . - . - ENGINEERED STRUCTURAL SUPPORT
- □ □ □ □ NON-COMBUSTIBLE WALL CONSTRUCTION

BEVERAGE SYSTEM NOTES
(DIVISION 26)


- B-1 PROVIDE 6" ID CONDUIT.
- B-2 PROVIDE 8" ID CONDUIT.
- B-3 ROUTE CONDUIT BENEATH FLOOR AND STUB UP TO 4" AFF.
- B-4 ROUTE CONDUIT ABOVE FINISHED CEILING AND DOWN THRU WALL/CHASE.
- B-5 ROUTE CONDUIT THRU WALL/CHASE AND STUB OUT AT 12" AFF.

REFRIGERATION NOTES

- A. REFRIGERATION CONTRACTOR SHALL PROVIDE INSULATED REFRIGERATION PIPING TO SYSTEM ON ROOF. PIPING SHALL BE CONCEALED WITHIN WALLS AND CEILINGS WHERE APPLICABLE.
- B. ELECTRICAL CONTRACTOR (DIVISION 26) SHALL PROVIDE CONDUIT IN WALL TO ABOVE CEILING FOR REFRIGERATION PIPING.
- C. ELECTRICAL CONTRACTOR (DIVISION 26) SHALL PROVIDE CONDUIT ABOVE FINISHED CEILING FOR REFRIGERATION LINES.
- D. ELECTRICAL CONTRACTOR (DIVISION 26) SHALL PROVIDE MIN. 12"x12" PULL BOX IN WALL FOR REFRIGERATION LINES. ROUTE CONDUIT WITHIN WALLS AND ABOVE CEILINGS TO PULL BOX.
- E. ELECTRICAL CONTRACTOR (DIVISION 26) SHALL PROVIDE MIN. 18"x18" PULL BOX IN WALL FOR REFRIGERATION LINES. ROUTE CONDUIT WITHIN WALLS AND ABOVE CEILINGS TO PULL BOX.


EXHAUST/SUPPLY FAN SCHEDULE

FANS LOCATED ON BUILDING ROOF. SEE ARCHITECTURAL DRAWINGS FOR EXACT LOCATIONS.

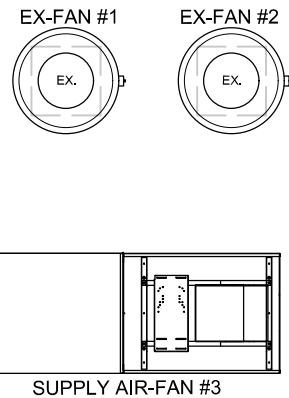


REFRIGERATION SCHEDULE

CONDENSING UNITS LOCATED ON CONCRETE SLAB/ BUILDING ROOF. SEE ARCHITECTURAL DRAWINGS FOR EXACT LOCATIONS.

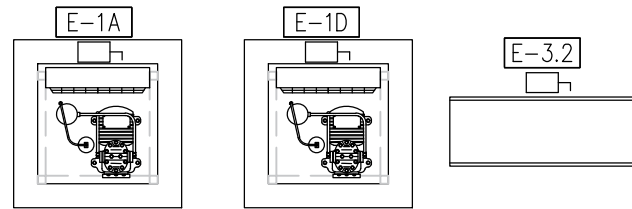

UNDERGROUND CONDUIT DETAIL

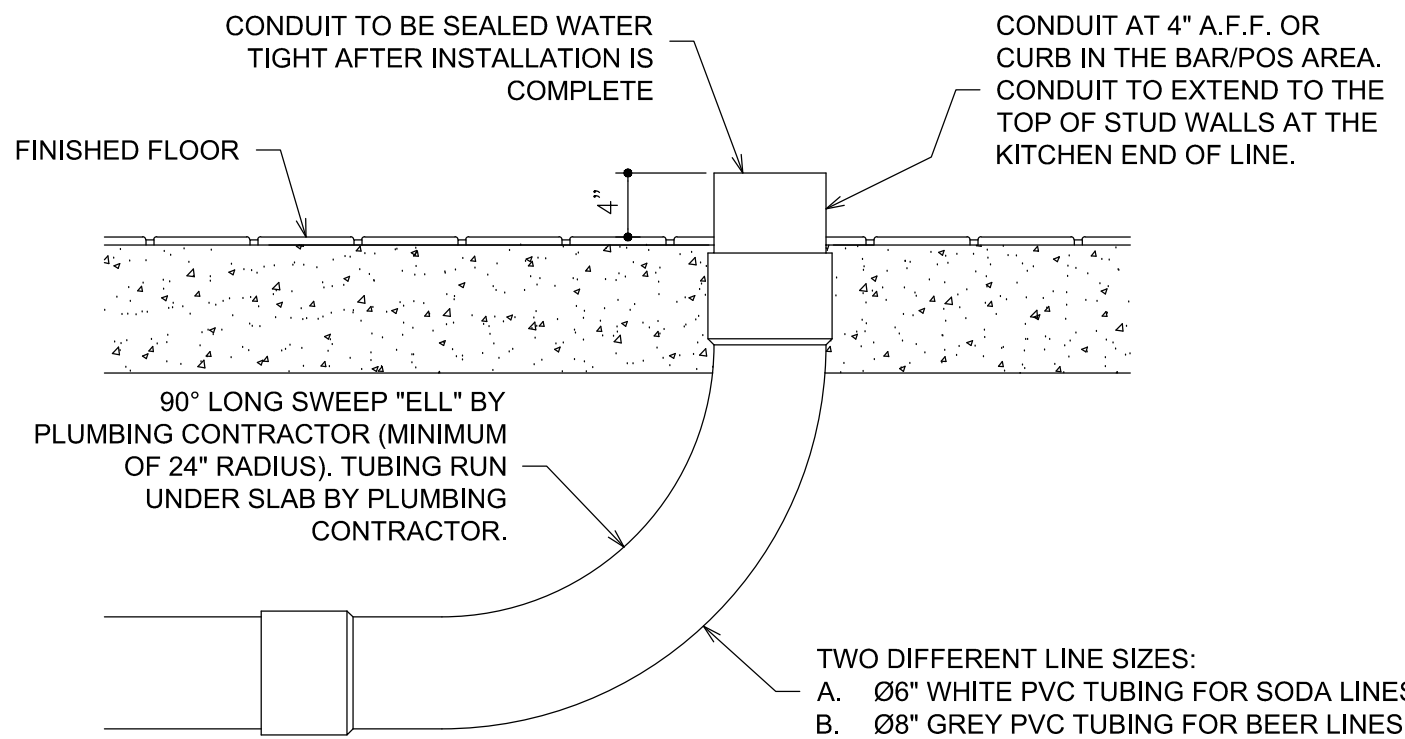

B

REVISIONS

DATE	NO.	DESCRIPTION
03-14-22	B	G.C.SHOP DWG. COORD.2

7 Tequila
Holly Springs, GA.

Back of House and Bar

PROJECT NUMBER:	22.1228
DATE:	02/09/2022
SCALE:	1/4" = 1'-0"
DRAWN BY:	RJF
APPROVED BY:	JBS

SHEET TITLE:	FOODSERVICE BEVERAGE CONDUIT PLAN
--------------	--------------------------------------

SHEET NUMBER:	QF402
---------------	-------

REVISIONS

DATE	NO.	DESCRIPTION
03-14-22	B	G.C.SHOP DWG. COORD.2


7 Tequila
Holly Springs, GA.

Back of House and Bar

PROJECT NUMBER	22.1228
DATE:	02/09/2022
SCALE:	1/2" = 1'-0"
DRAWN BY:	RJF
APPROVED BY:	JBS

SHEET TITLE:	FOODSERVICE ELEVATIONS
--------------	------------------------

SHEET NUMBER:	QF501
---------------	-------

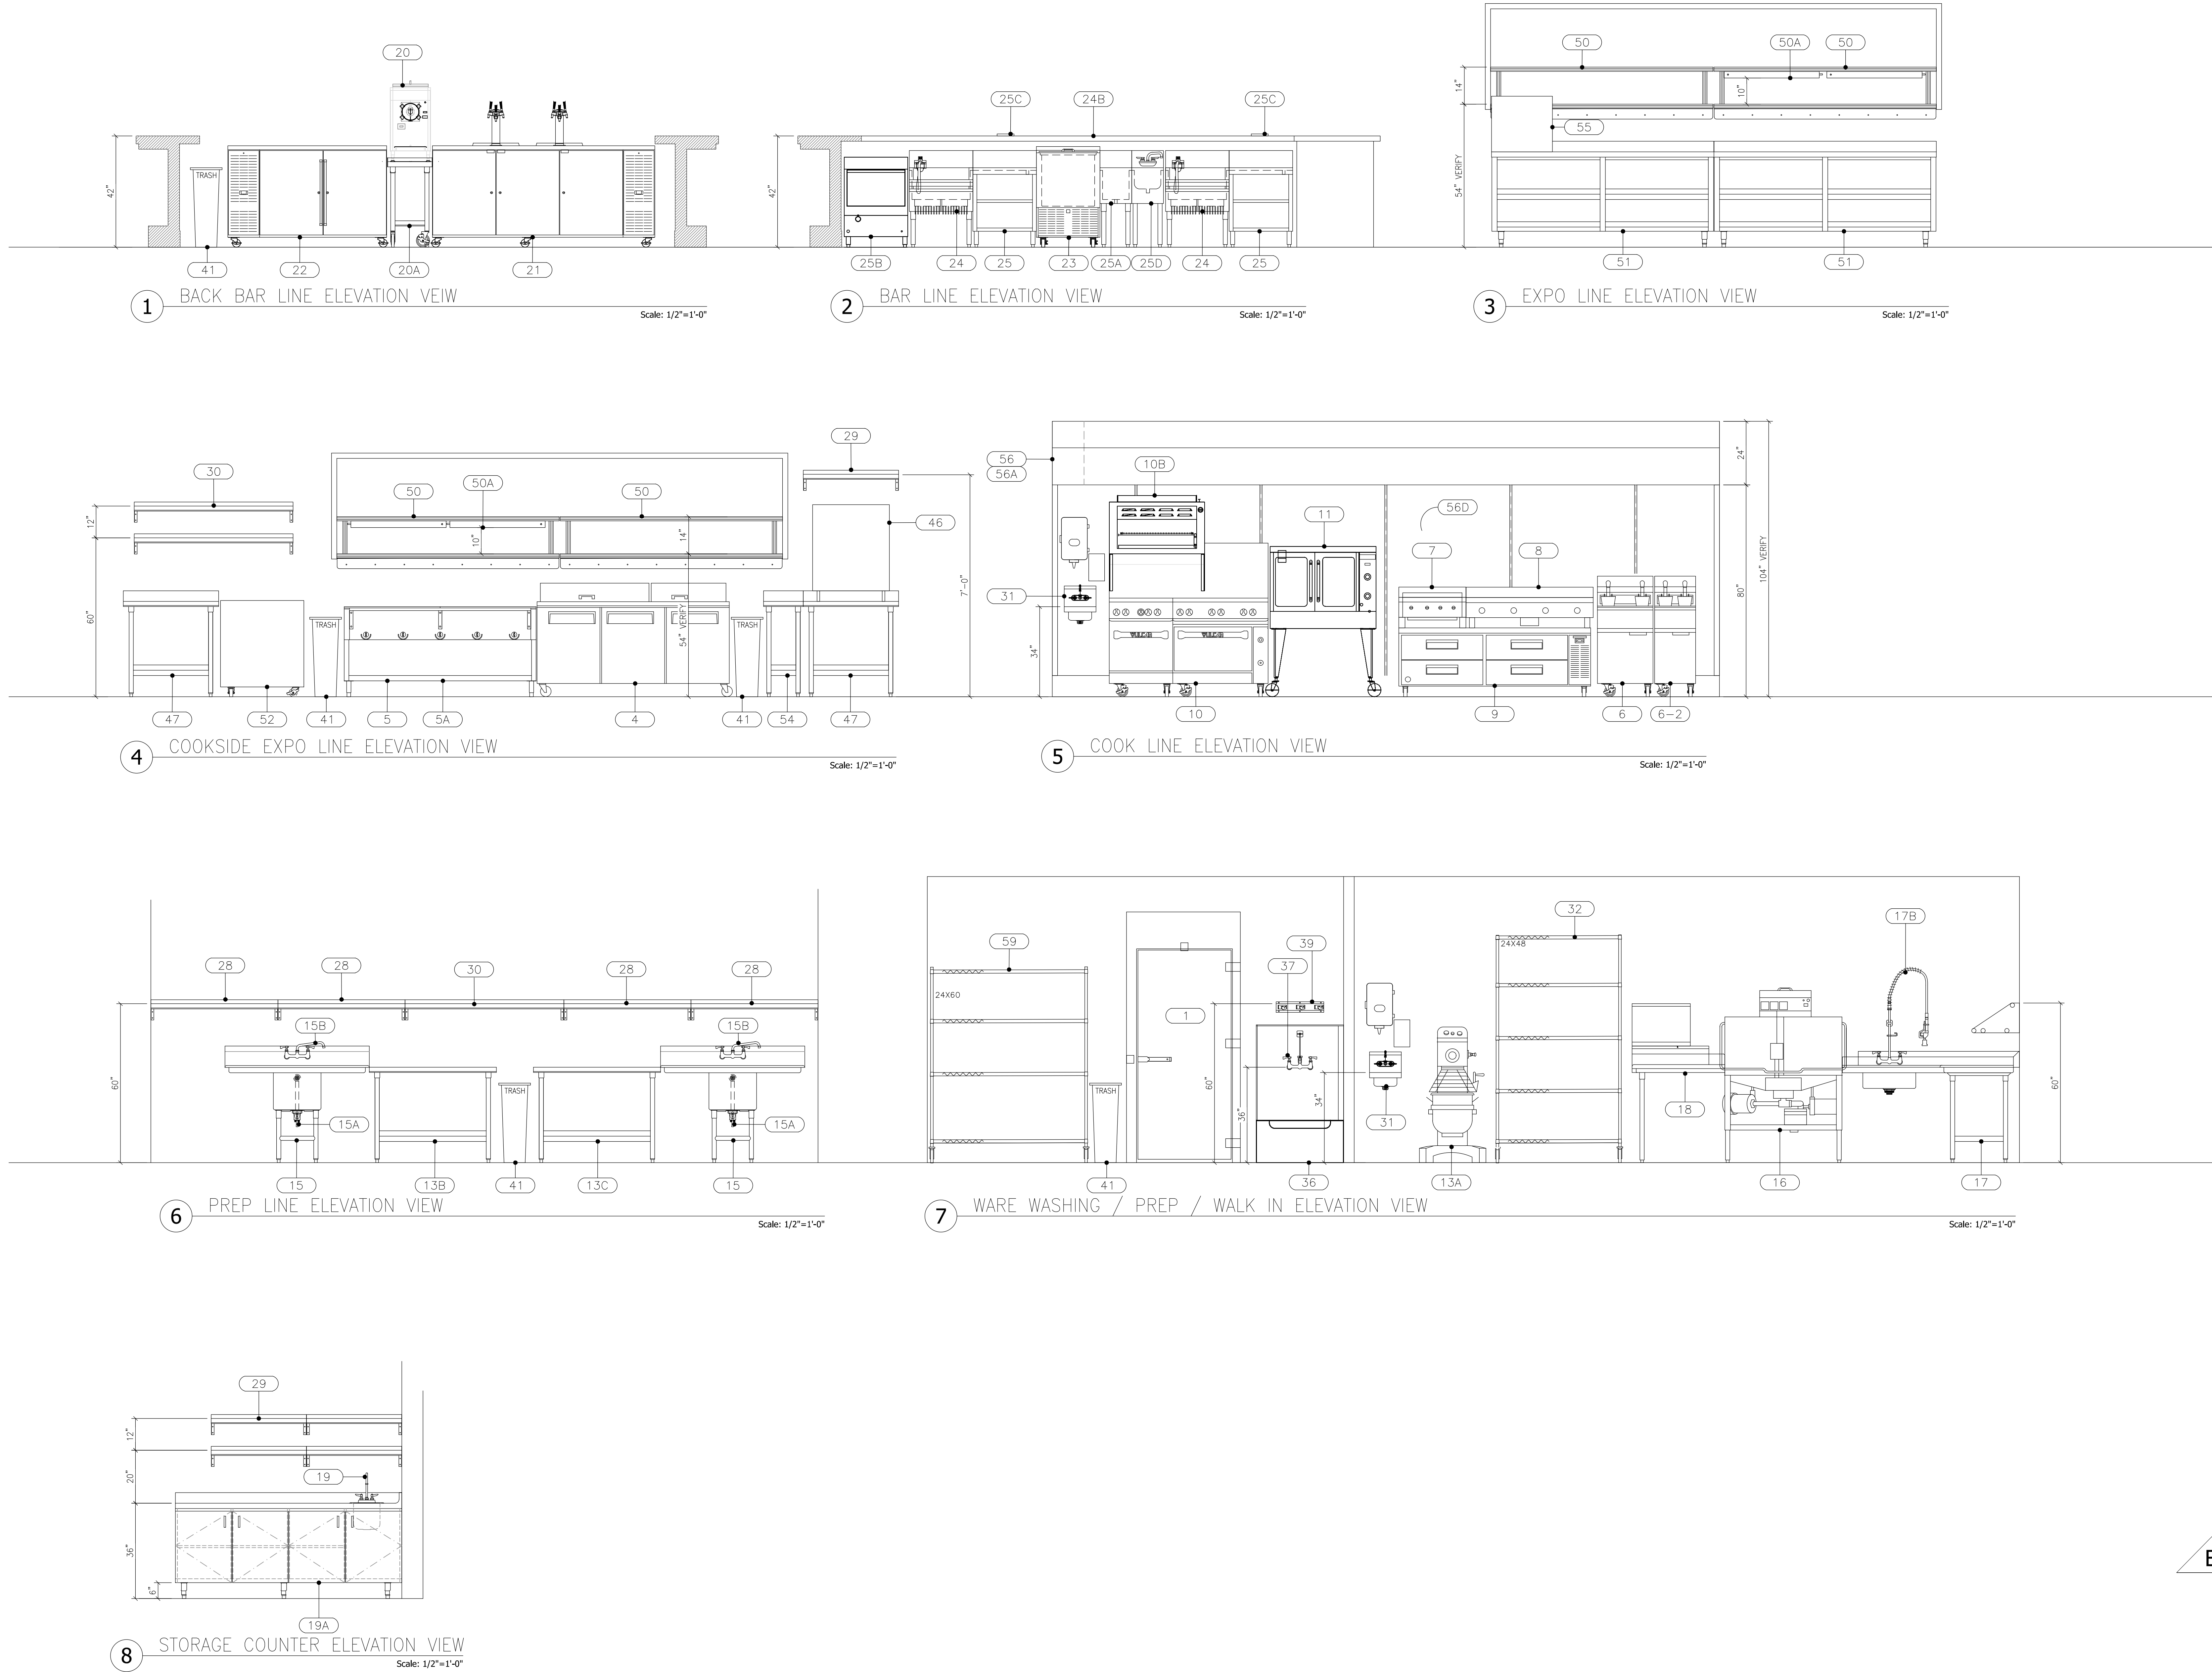


B

MARK INFORMATION		FAN INFORMATION						MOTOR INFORMATION					
QTY	MARK	MODEL	VOLUME (CFM)	TOTAL EXTERNAL SP (IN WG)	FAN RPM	OPERATING POWER (HP)	WEIGHT (LB.)	SIZE (HP)	V/C/P	ENCLOSURE	MOTOR RPM	WINDINGS	NEC FLA*
1	KEF-1	XCUE-160-A	2,500	1	1,258	0.73	112	2	208/60/3	OP	1725	1	7.5




NEC FLA - Based on table 430.250 or 430.248 of National Electrical Code 2020. Actual motor FLA may vary for sizing thermal overload, consult factory

KEF-1 : SELECTED OPTIONS AND ACCESSORIES
Motor VFD Rated without Shaft Grounding Protection
One piece fully welded windband
Tapered bushing wheel hub
Breather tube outlet area min. 4.4 sq. in. (sizes 99-480), 2.0 sq. in. (sizes 60-95)
Min. windband material thickness: 0.051" aluminum (060-240), 0.064" aluminum (240HP, 240XP), 0.080" aluminum (sizes 300-480)
Larger Curb Cap Size - 26 Square
ULcUL 762 Listed - "Power Ventilators for Rest. Exh. Appliances"
Switch, NEMA-3R, Toggle, Shipped with Unit
Hinge, Factory Installed
High Temp Curb Seal Rated for Continuous Duty at 1500 F (Factory Attached)
Grease Trap (PN 475538)

KEF-1 & 2

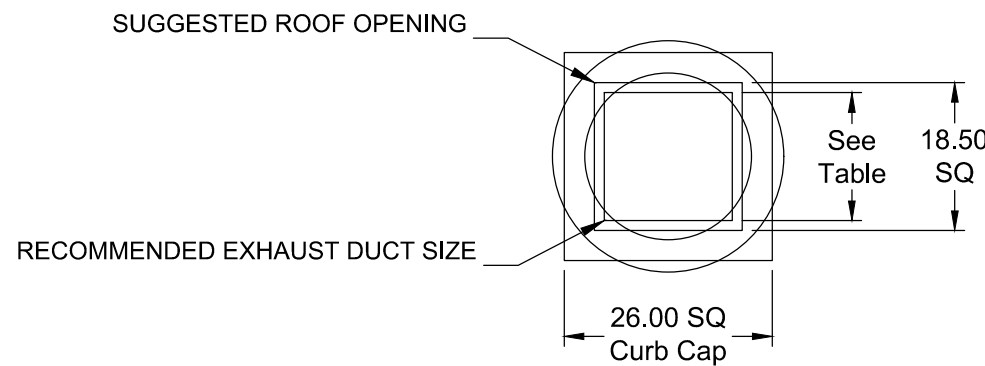


DUCT TYPE	SIZE
STANDARD	16 SQ
FIRE-WRAPPED	8 SQ

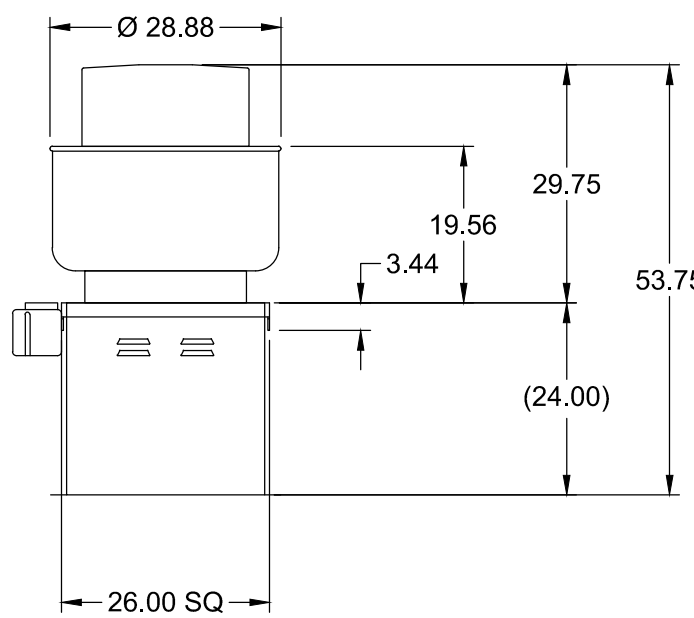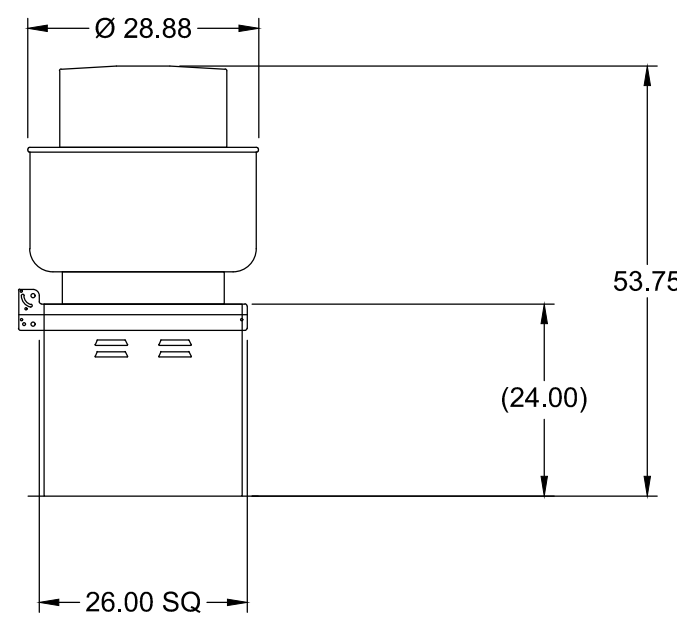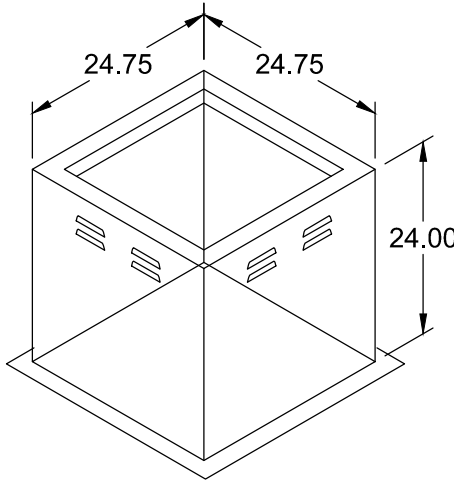


DUCT DIMENSIONS ARE LARGEST POSSIBLE DUCT TO FIT THROUGH CURB.
CONSULT SYSTEM DESIGN ENGINEER FOR RECOMMENDED DUCT SIZE.

OVERALL HEIGHT MAY BE GREATER DEPENDING ON MOTOR, ADAPTER, AND/OR
HINGE BASE.

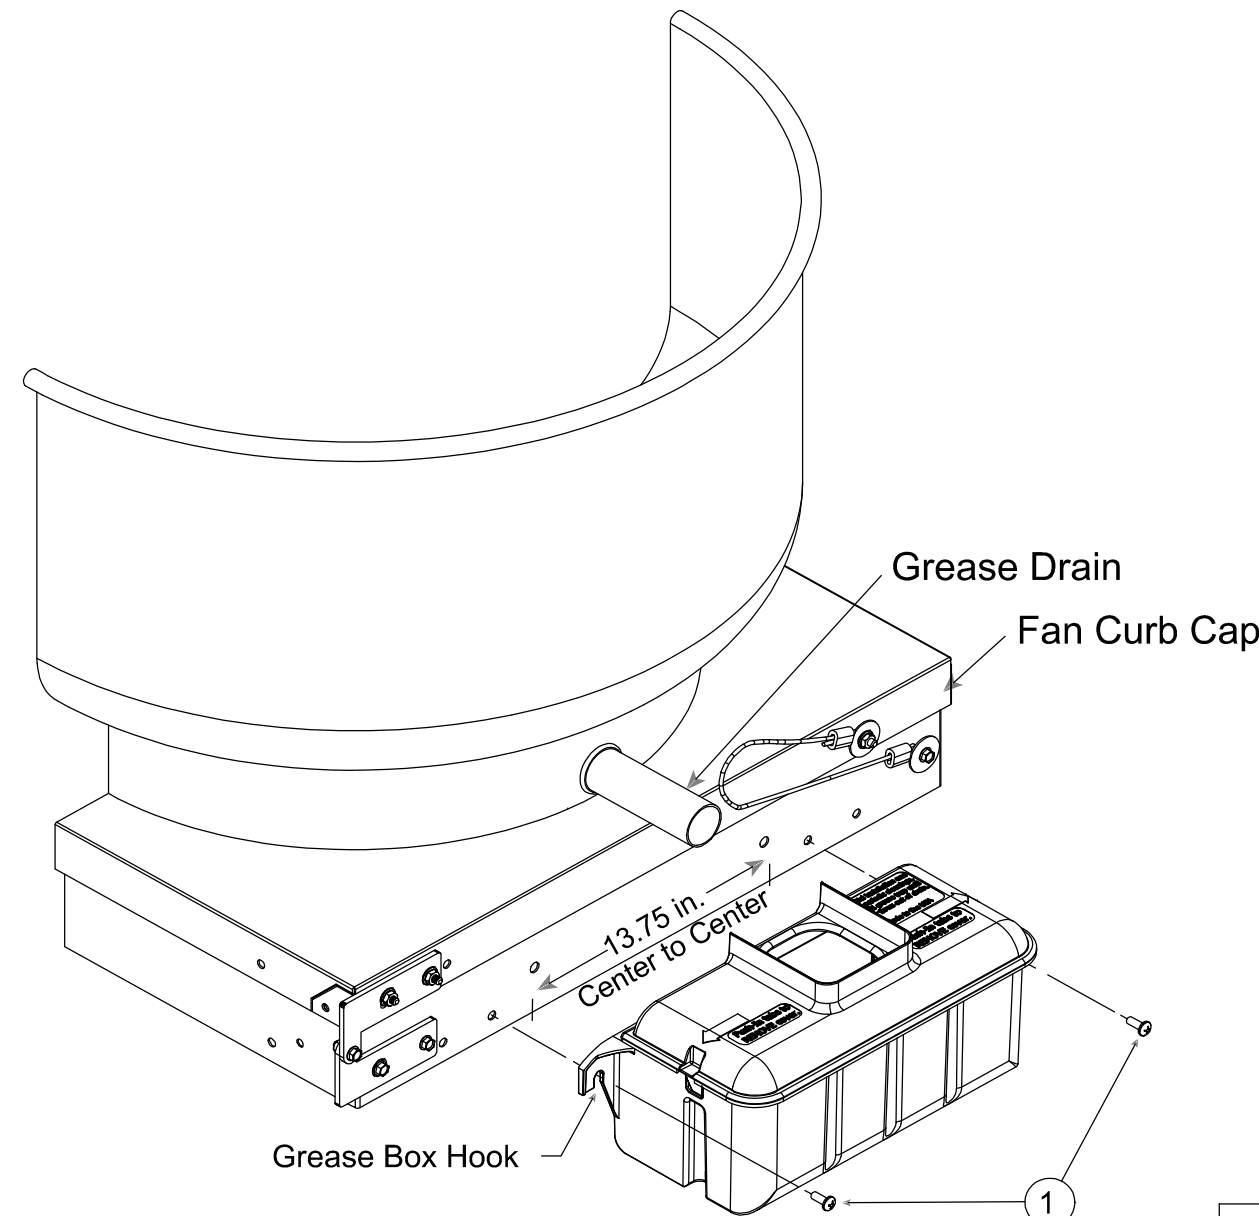

Grease Trap Detail

NOTE: GREASE TRAP
REQUIRED FOR UL762
FANS PER IMC 506.5.3.

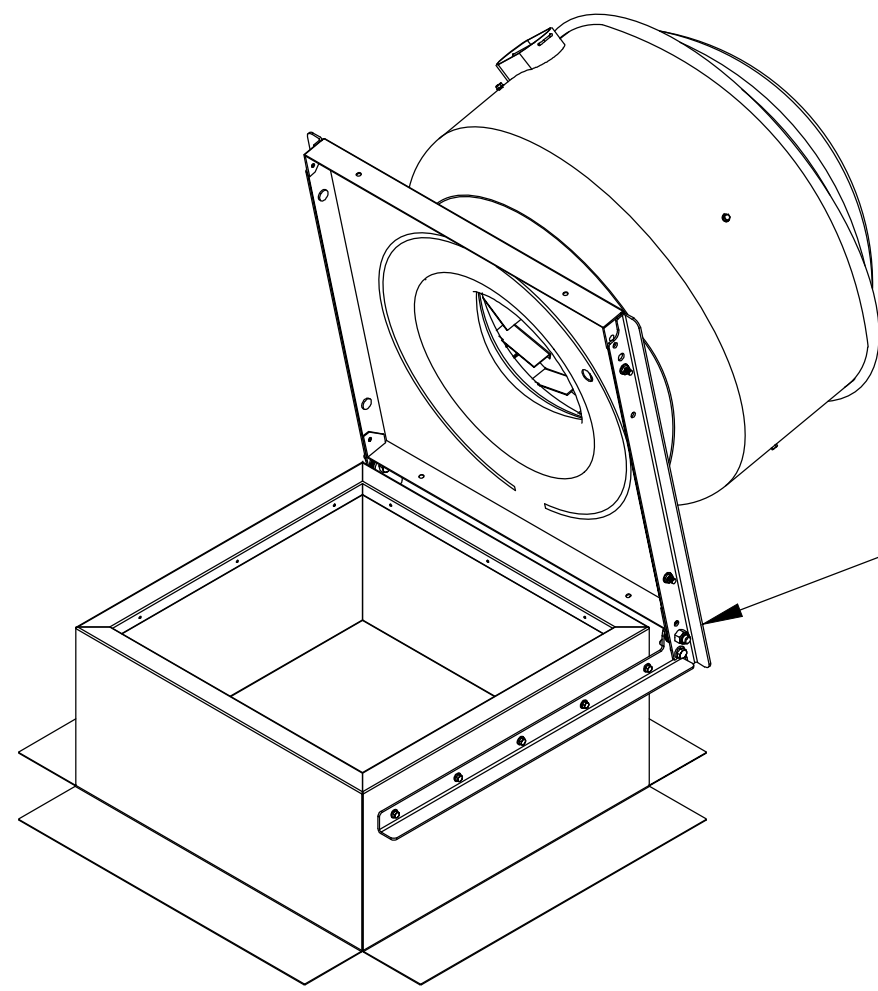

Hinge Kit Detail

NOTE: HINGE KIT REQUIRED
FOR MAINTENANCE PER
IMC 506.5.4.

B

ACCUREX

ACCUREX, CA
EDWIN JOHNSON
EDWIN.JOHNSON@ACCUREX.COM
(408)521-6063

7 TEQUILA REV2

KEF-1

UL 18E

TriMark
Foodservice Equipment, Supplies and Design

2801 South Valley Parkway, Suite 200
Lewisville, TX 75067
p. 469-240-7200

trimarkusa.com

This document contains confidential
information, is an instrument of a
professional service, and the property of
TriMark. It shall not be used on other
projects or for the extension of this project
without TriMark's written approval.

Owner and all Contractors to check
and verify existing dimensions and
conditions in the field before starting
construction and to notify TriMark of
any material or detail changes.

REVISIONS

DATE	NO.	DESCRIPTION
03-14-22	B	G.C.SHOP DWG. COORD.2

7 Tequila
Holly Springs, GA.

Back of House and Bar

PROJECT NUMBER	22.1228
DATE:	02/09/2022
SCALE:	NTS
DRAWN BY:	RJF
APPROVED BY:	JBS

SHEET TITLE:	MANUFACTURER SHOP DRAWINGS
--------------	-------------------------------


SHEET NUMBER:

QF702


THIS DOCUMENT WAS ORIGINALLY PRINTED ON A 30" x 42" SIZE SHEET

EQUIPMENT SCHEDULE										OPTIONS AND ACCESSORIES																			
Non-Tempered Make-Up Air Unit										Mark: KSF-1																			
Qty	Access Model	Volume	External SP	Total SP	FRPM	Operating Power	Weight																						
1	XKSF8-115-H25-01	4,000 CFM	0.75 in. wg	0.816 in. wg	702	1.35 hp	351 lb																						
Motor Information																													
Size	VICP	Enclosure	Motor with	Motor RPM	Windings	MCA	MCP																						
2 hp	200R03	ODP	No	1725	1	9.4	15																						
Outlet Sound Power By Octave Band																													
125	125	250	500	1000	2000	4000	8000	LWA	dBA	Sones																			
NAN	NAN	NAN	NAN	NAN	NAN	NAN	NAN	NAN	NAN	0																			
* LWA: A weighted sound power level based on ANSI S1.1																													
* dBA: A weighted sound pressure level based on IEC 6167 alternative one scale based on dBS																													
* Sones: Sones based on a reference value of 0.00196 at 1125 Hz per octave band at 0.1 ft																													


KSF-1

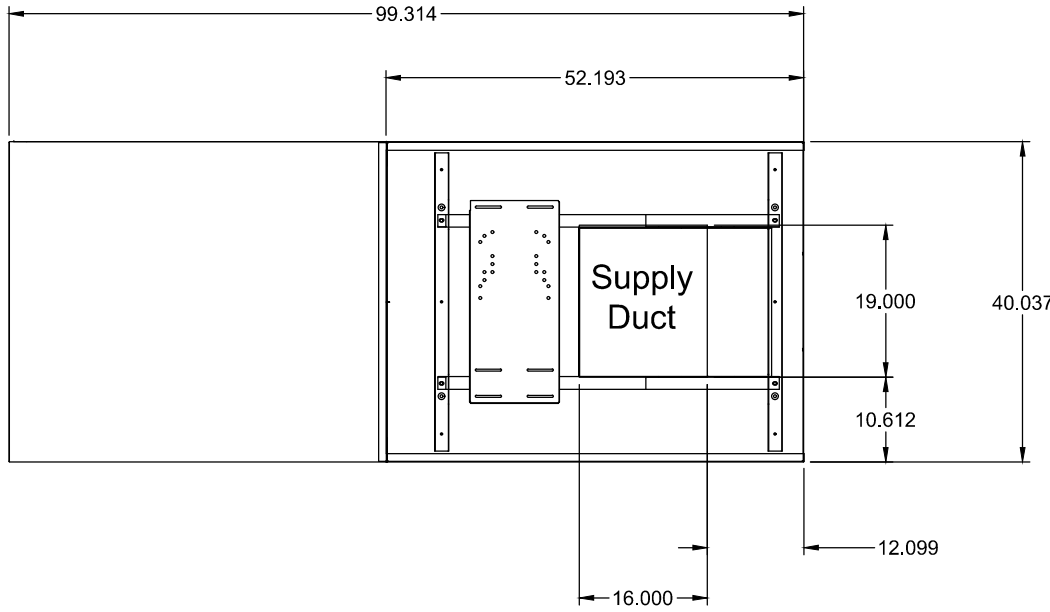


PLAN VIEW

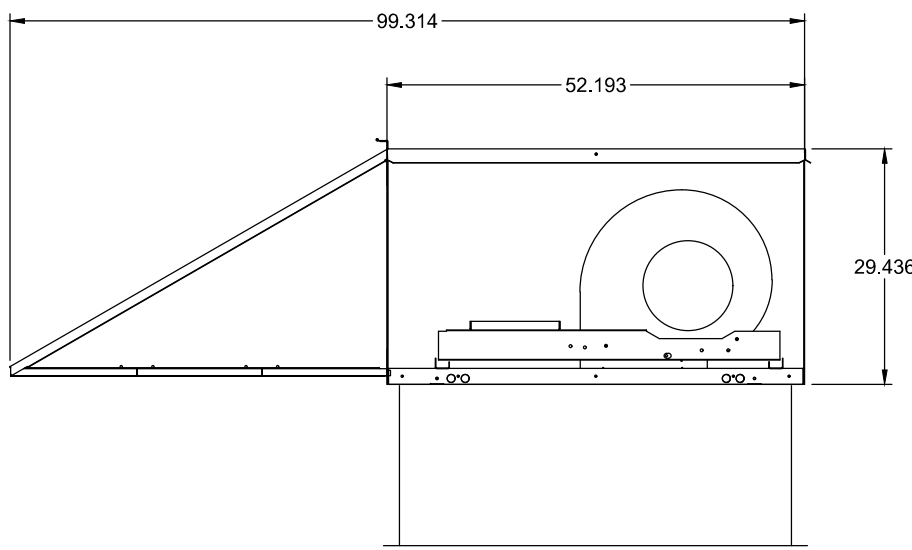

ELEVATION VIEW

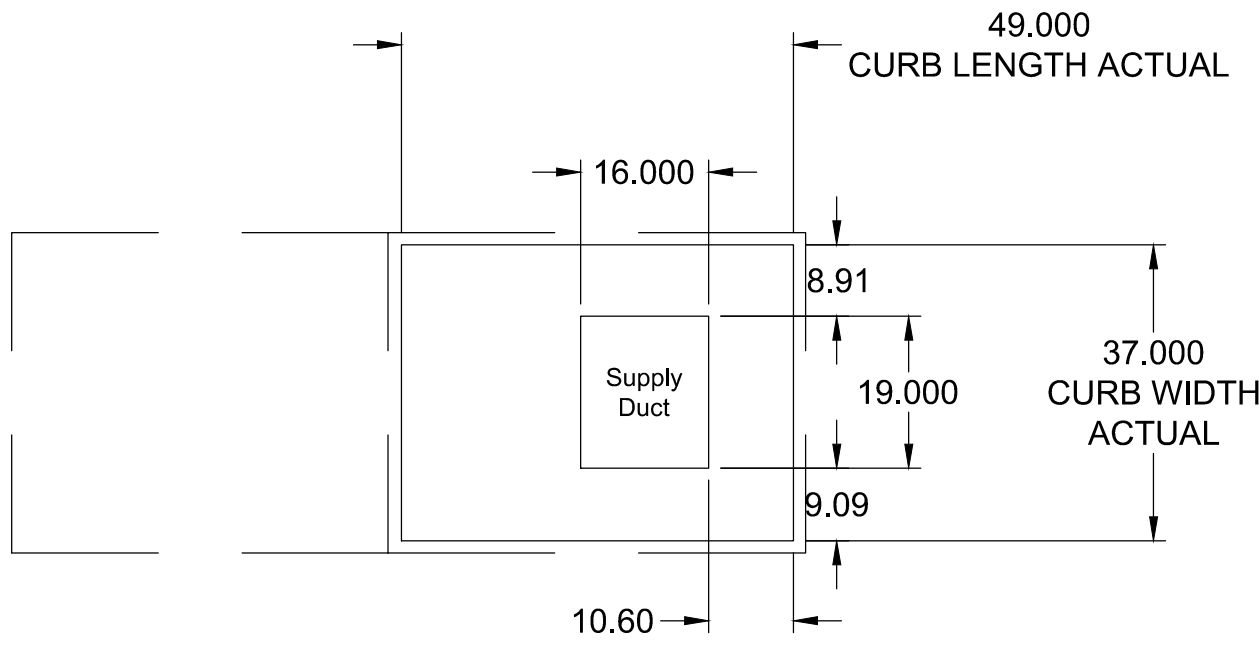

FOOTPRINT

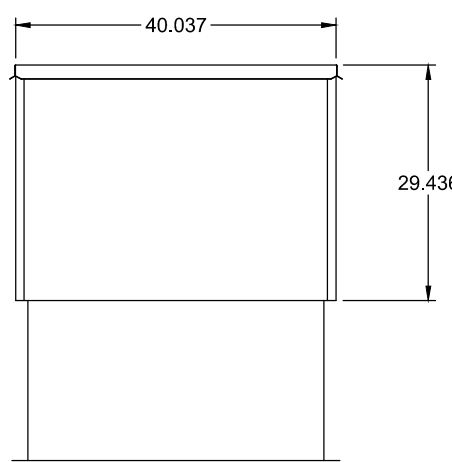

END VIEW

NOTE: Roof Opening Requirements:

Minimum Roof Opening: The minimum roof opening size is the illustrated duct diameter plus 0.25 in. on all sides.
For example: If the duct size is 14 x 14 in. square, the minimum roof opening size is 14.5 x 14.5 in. square.

Maximum Roof Opening: There must be a minimum perimeter of 1.75 in. between the roof opening and the roof curb.
For example: If the roof curb is 75 x 30 in. square, the maximum roof opening is 71.5 x 26.5 in. inches square.

NOTE: The weatherhood and filter sections of the make-up air unit are not supported by the curb.
This is by design, in order to help alleviate water infiltration issues.


B

ACCUREX

ACCUREX GA
EDWIN JOHNSON
EDWIN.JOHNSON@ACCUREX.COM
(404) 521-6063

7 TEQUILA REV2

KSF-1

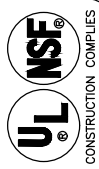

2801 South Valley Parkway, Suite 200
Lewisville, TX 75067
p. 469-240-7200

trimarkusa.com

This document contains confidential information, is an instrument of a professional service, and the property of TriMark. It shall not be used on other projects or for the extension of this project without TriMark's written approval.

Owner and all Contractors to check and verify existing dimensions and conditions in the field before starting construction and to notify TriMark of any material or detail changes.

REVISIONS

DATE	NO.	DESCRIPTION
03-14-22	B	G.C.SHOP DWG. COORD.2

7 Tequila
Holly Springs, GA.

Back of House and Bar

PROJECT NUMBER 22.1228	
DATE 02/09/2022	
SCALE NTS	
DRAWN BY: RJF	APPROVED BY: JBS

SHEET TITLE MANUFACTURER SHOP DRAWINGS	
--	--

SHEET NUMBER QF703	
-----------------------	--

CONTROL INFORMATION																	
MARK	ELECTRICAL CONTROL PACKAGE		TYPE	USER INTERFACE	FANS CONTROLLED												
	MODEL	LOCATION			LOCATION	FAN #	TYPE	FAN	FAN MARK	ZONE	CFM	MOTOR HP	MOTOR VOLT	CYCLE	MOTOR PHASE	MOTOR STARTER IN PANEL	VFD IN PANEL
CONTROLS	XKC-CV-S-21-2-1-0	RIGHT CABINET ON HOOD	FULL COLOR TOUCHSCREEN	CABINET – RIGHT CABINET ON HOOD	1	EXHAUST	E1	KEF-1	1	2500	2	208	44	3	NO	YES	
					2	EXHAUST	E2	KEF-2	1	2500	2	208	44	3	NO	YES	
					3	SUPPLY	S1	KSF-1	1	4000	2	208	60	3	NO	YES	
CONTROL FEATURES																	



 

CONTROL FEATURES
HOOD LIGHT CONTROL
TEMP SENSORS (FACTORY INSTALLED) - QTY. 2
DRY FIRE CONTACTS - QTY. 1
LIGHTS OFF DURING FIRE
EXHAUST MAX DURING FIRE
SUPPLY OFF DURING FIRE
VFD(S) IN CONTROL PANEL PROVIDED FOR BALANCING



DOC NUMBER: ####
REV: ####
CAUTION
UNIT MUST BE GROUNDED IN ACCORDANCE WITH N.E.C. POWER MUST BE OFF WHILE SERVICING.
ATTENTION
L'APPAREIL DOIT ÊTRE MIS À LA TERRE CONFORMEMENT AU CODE C.E. L'ALIMENTATION DOIT ÊTRE COUPÉE DURANT L'ENTRETIEN.
COMMERCIAL APPLIANCE OUTLET CENTER
ELECTRICAL RATINGS: 110-240V, 1PHASE, 50-60HZ, 15A
BASE FILE #E200616, ML FILE #E313951

THESE DRAWINGS SHALL NOT BE REMOVED FROM THIS EQUIPMENT. USE COPPER CONDUCTORS RATED TO 90°C UNLESS SPECIFIED. TORQUE CONTROL & GROUND BOLTS TO 4 LBS. IN. TORQUE. POWER LUGS/SCREWS TO COMPONENT RATINGS LISTED. TORQUE CONTROL BOARD SCREW TERMINALS TO 3.5 LBS. IN. FIELD CONTROL WIRING RESISTANCE SHOULD NOT EXCEED 0.75 OHM. SEE IOM FOR ADDITIONAL INFORMATION. OR CALL FACTORY AT 1-800-371-6858.
NE PAS RETENIR CES DESSINS DE CET ÉQUIPEMENT. SAUF INDICATION CONTRAIRE, UTILISER DES CONDUCTEURS EN CUivre CLASSÉS À 90°C. SERRER LES BORNES DE COMMANDE ET DE CONTRÔLE À 4 LBS. PO. SERRER LES COSSÉS/VS D'ALIMENTATION AUX COUPLES INDiquÉES POUR LE COMPOSANT. SERRER LES BORNES À VUE DE LA CARTE DE COMMANDE À 3.5 LBS. PO. LA RÉSISTANCE DU CÂBLAGE DE COMMANDE LOCAL NE DOIT PAS DÉPASSER 0.75 OHM. POUR PLUS D'INFORMATION, CONSULTER LE MANUEL, OU APPELER 1-800-371-6858.

WIRING DIAGRAM CODE: ####
JOB NAME: 7 TEQUILA REV2
MODEL: XKC-CV-S-21-2-1-0
SERIAL NUMBER: WDSN#
MARK: CONTROLS

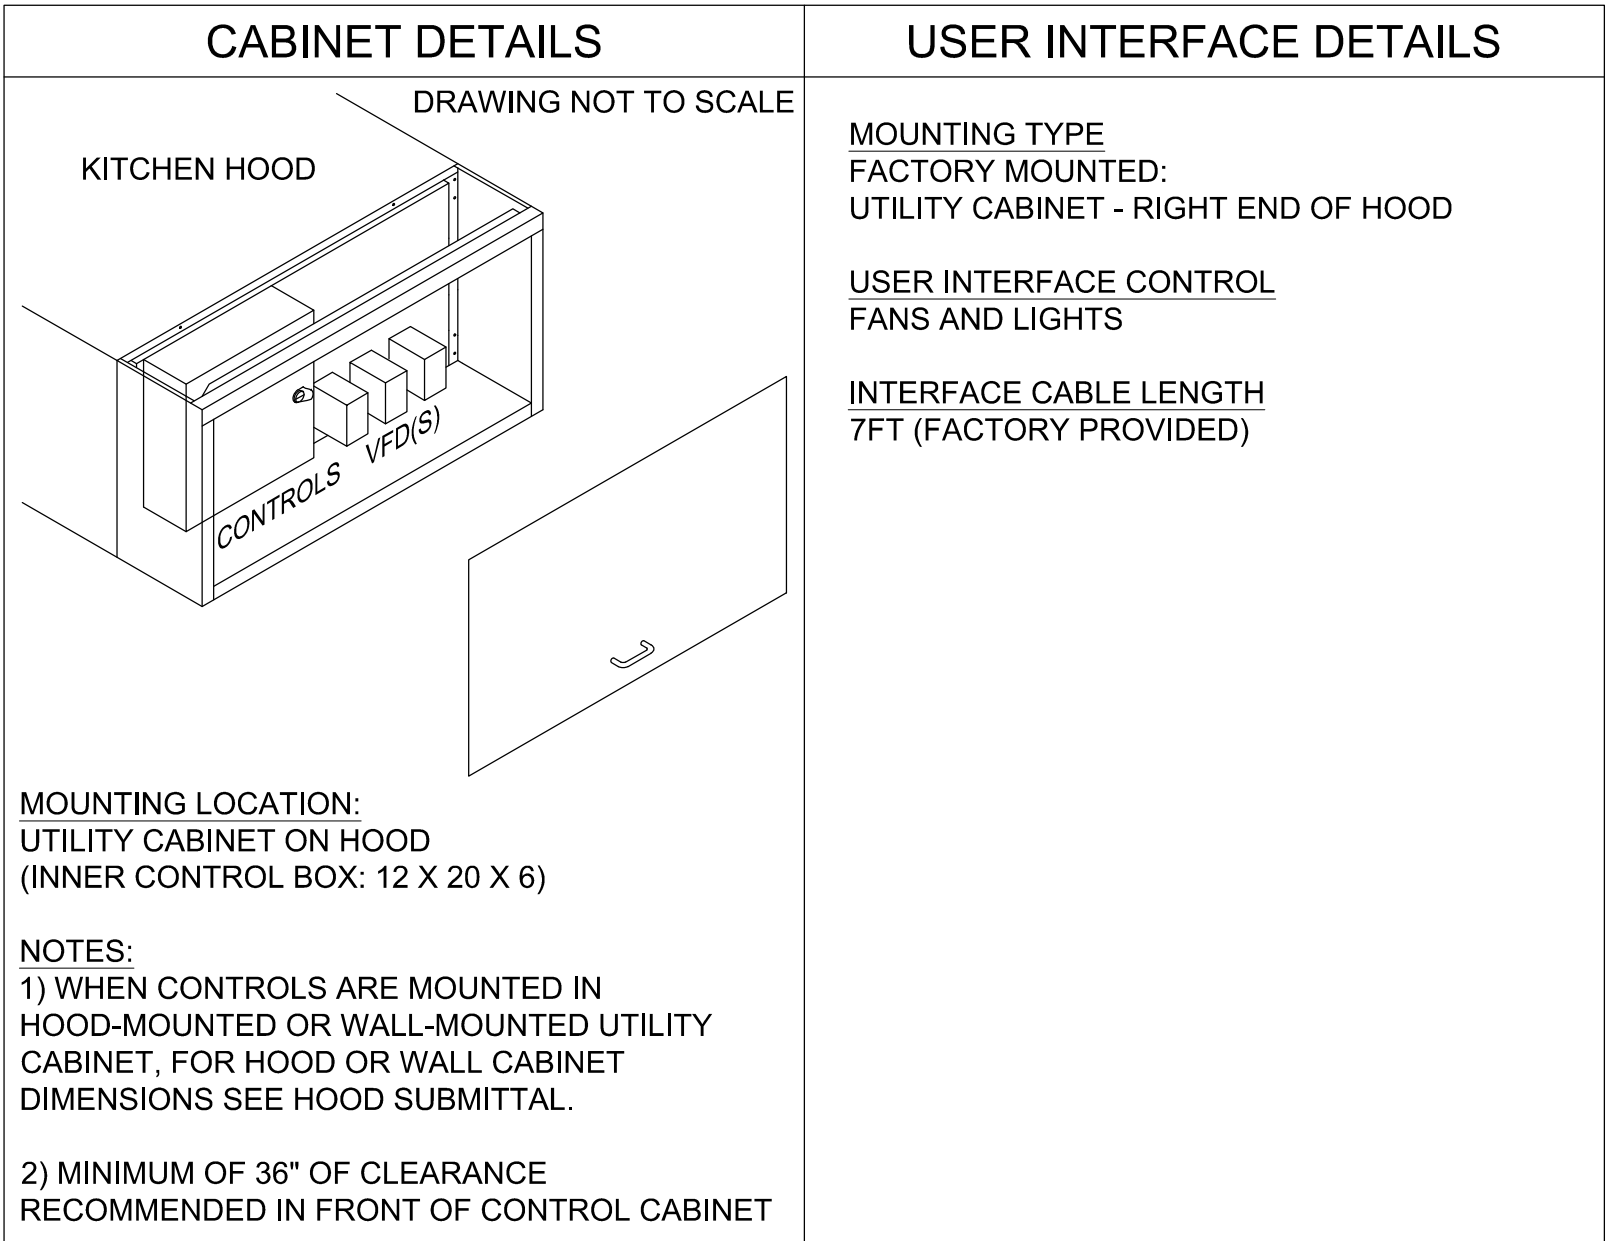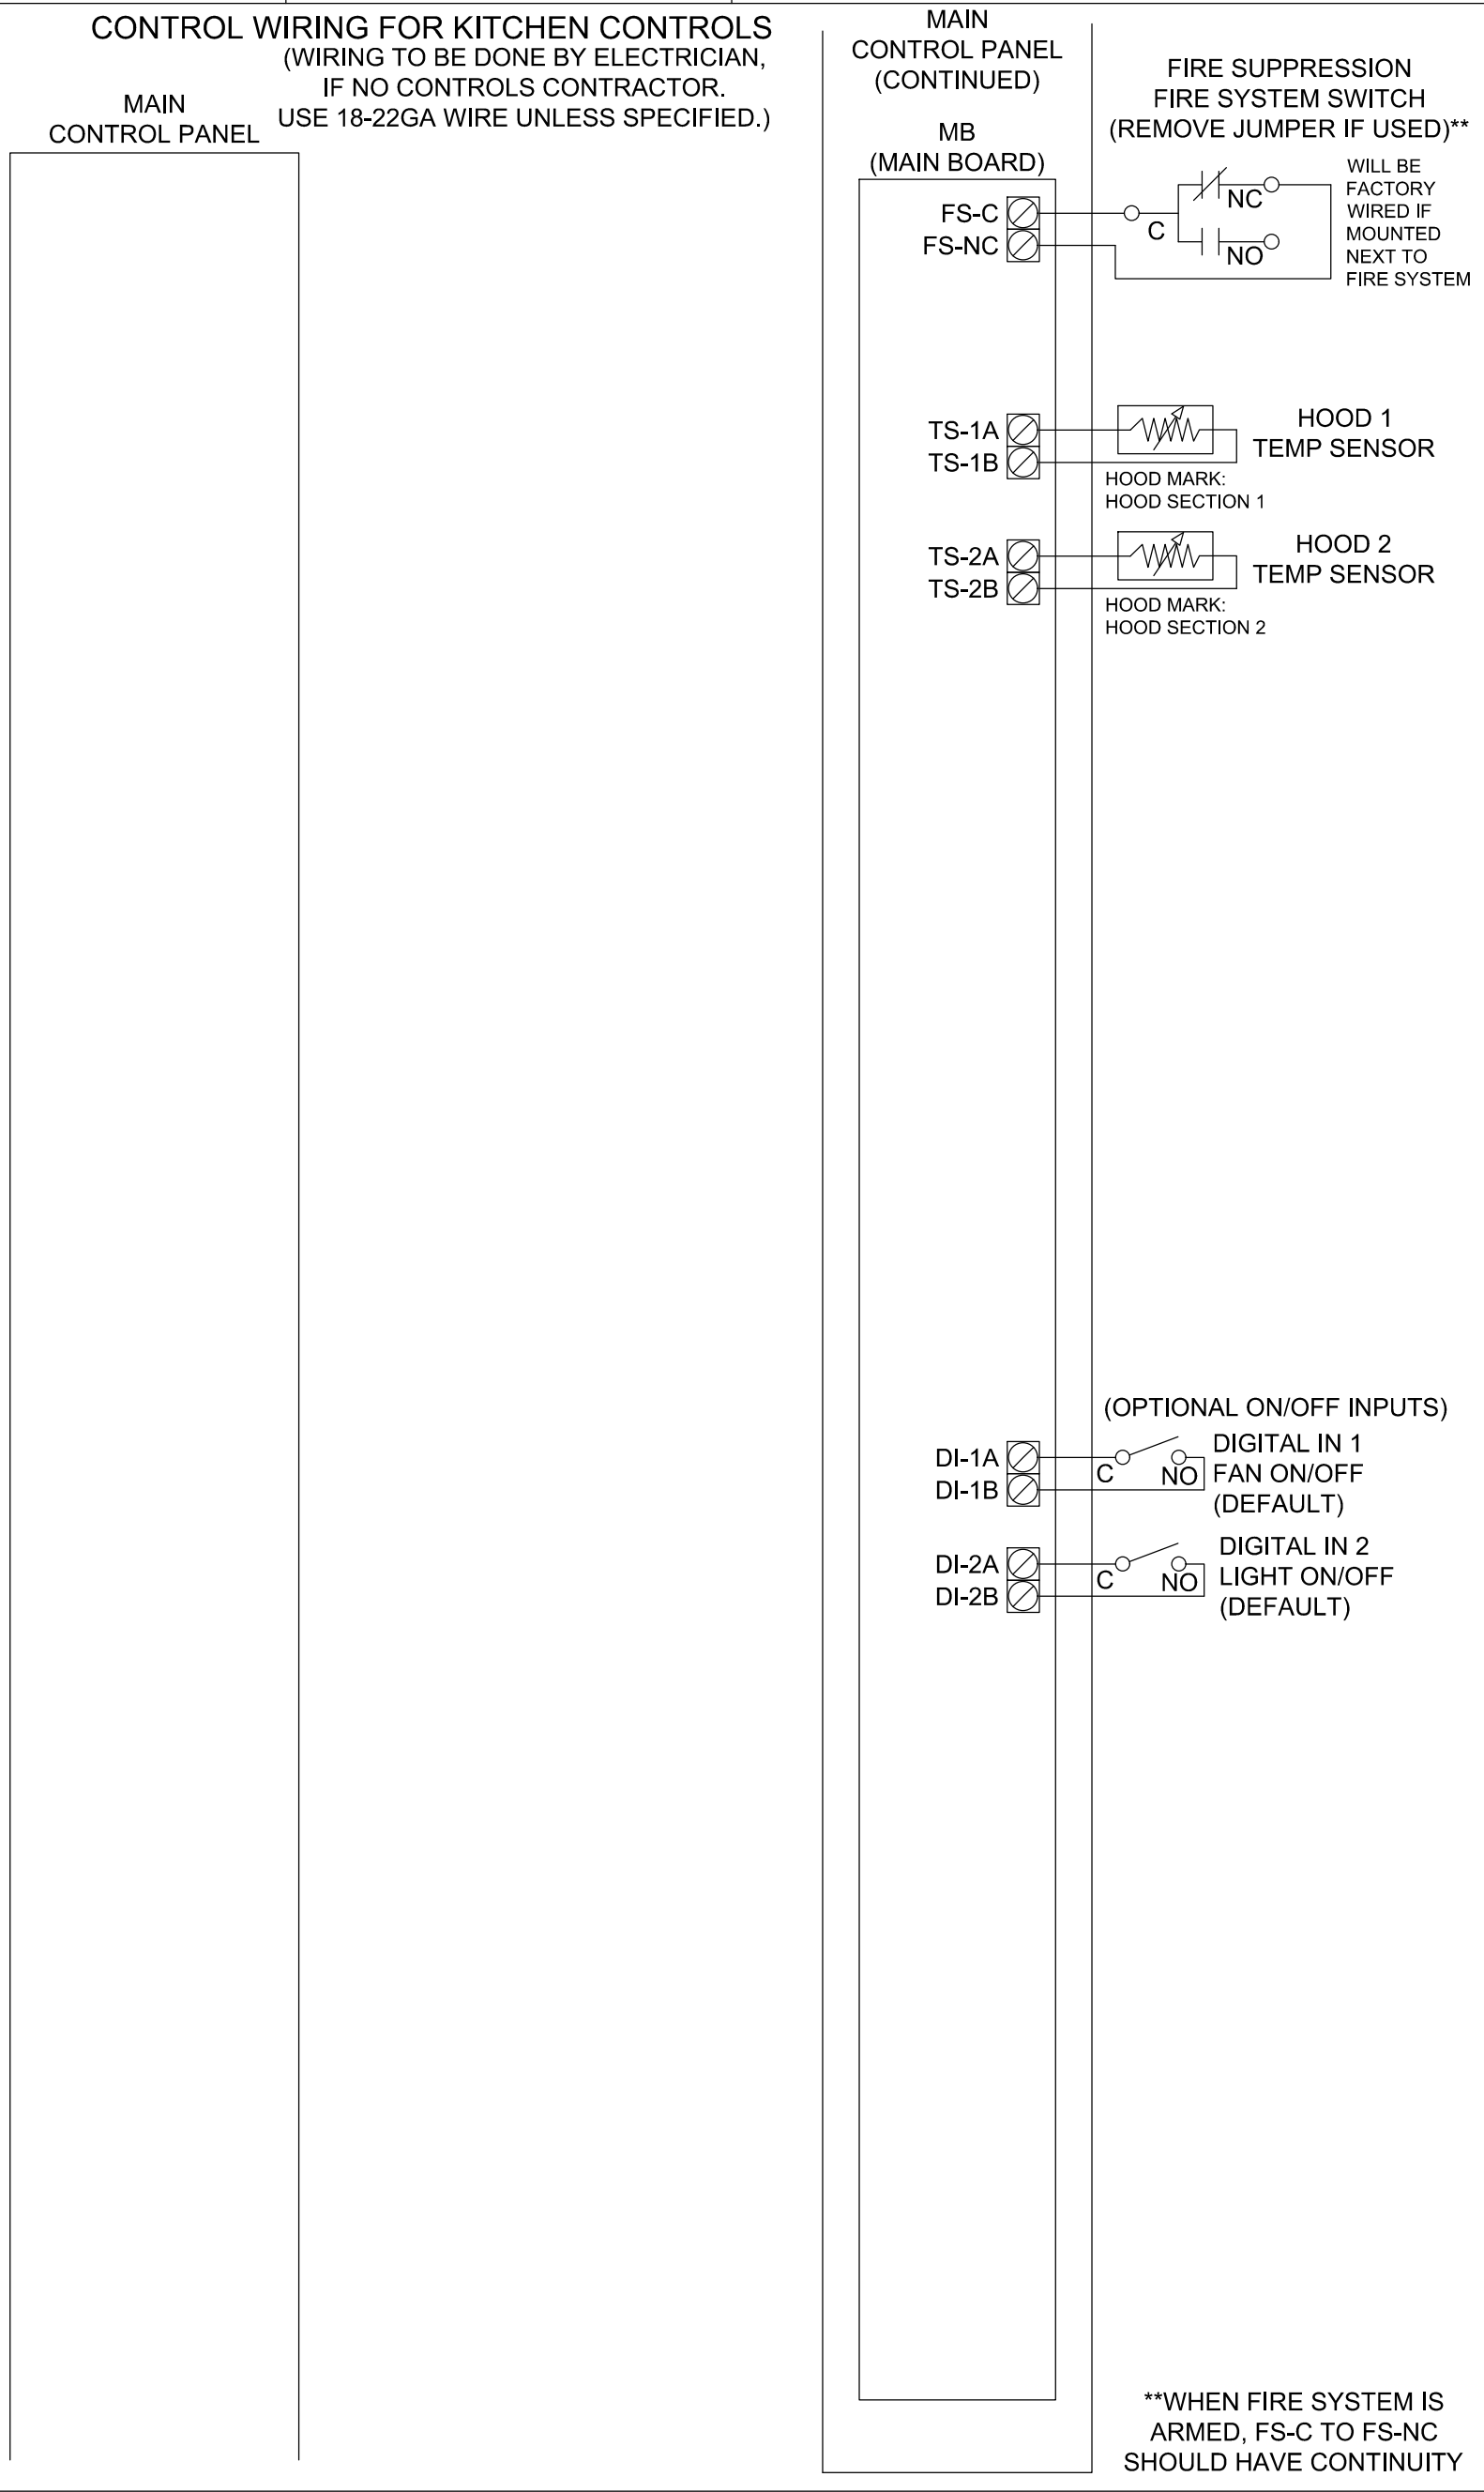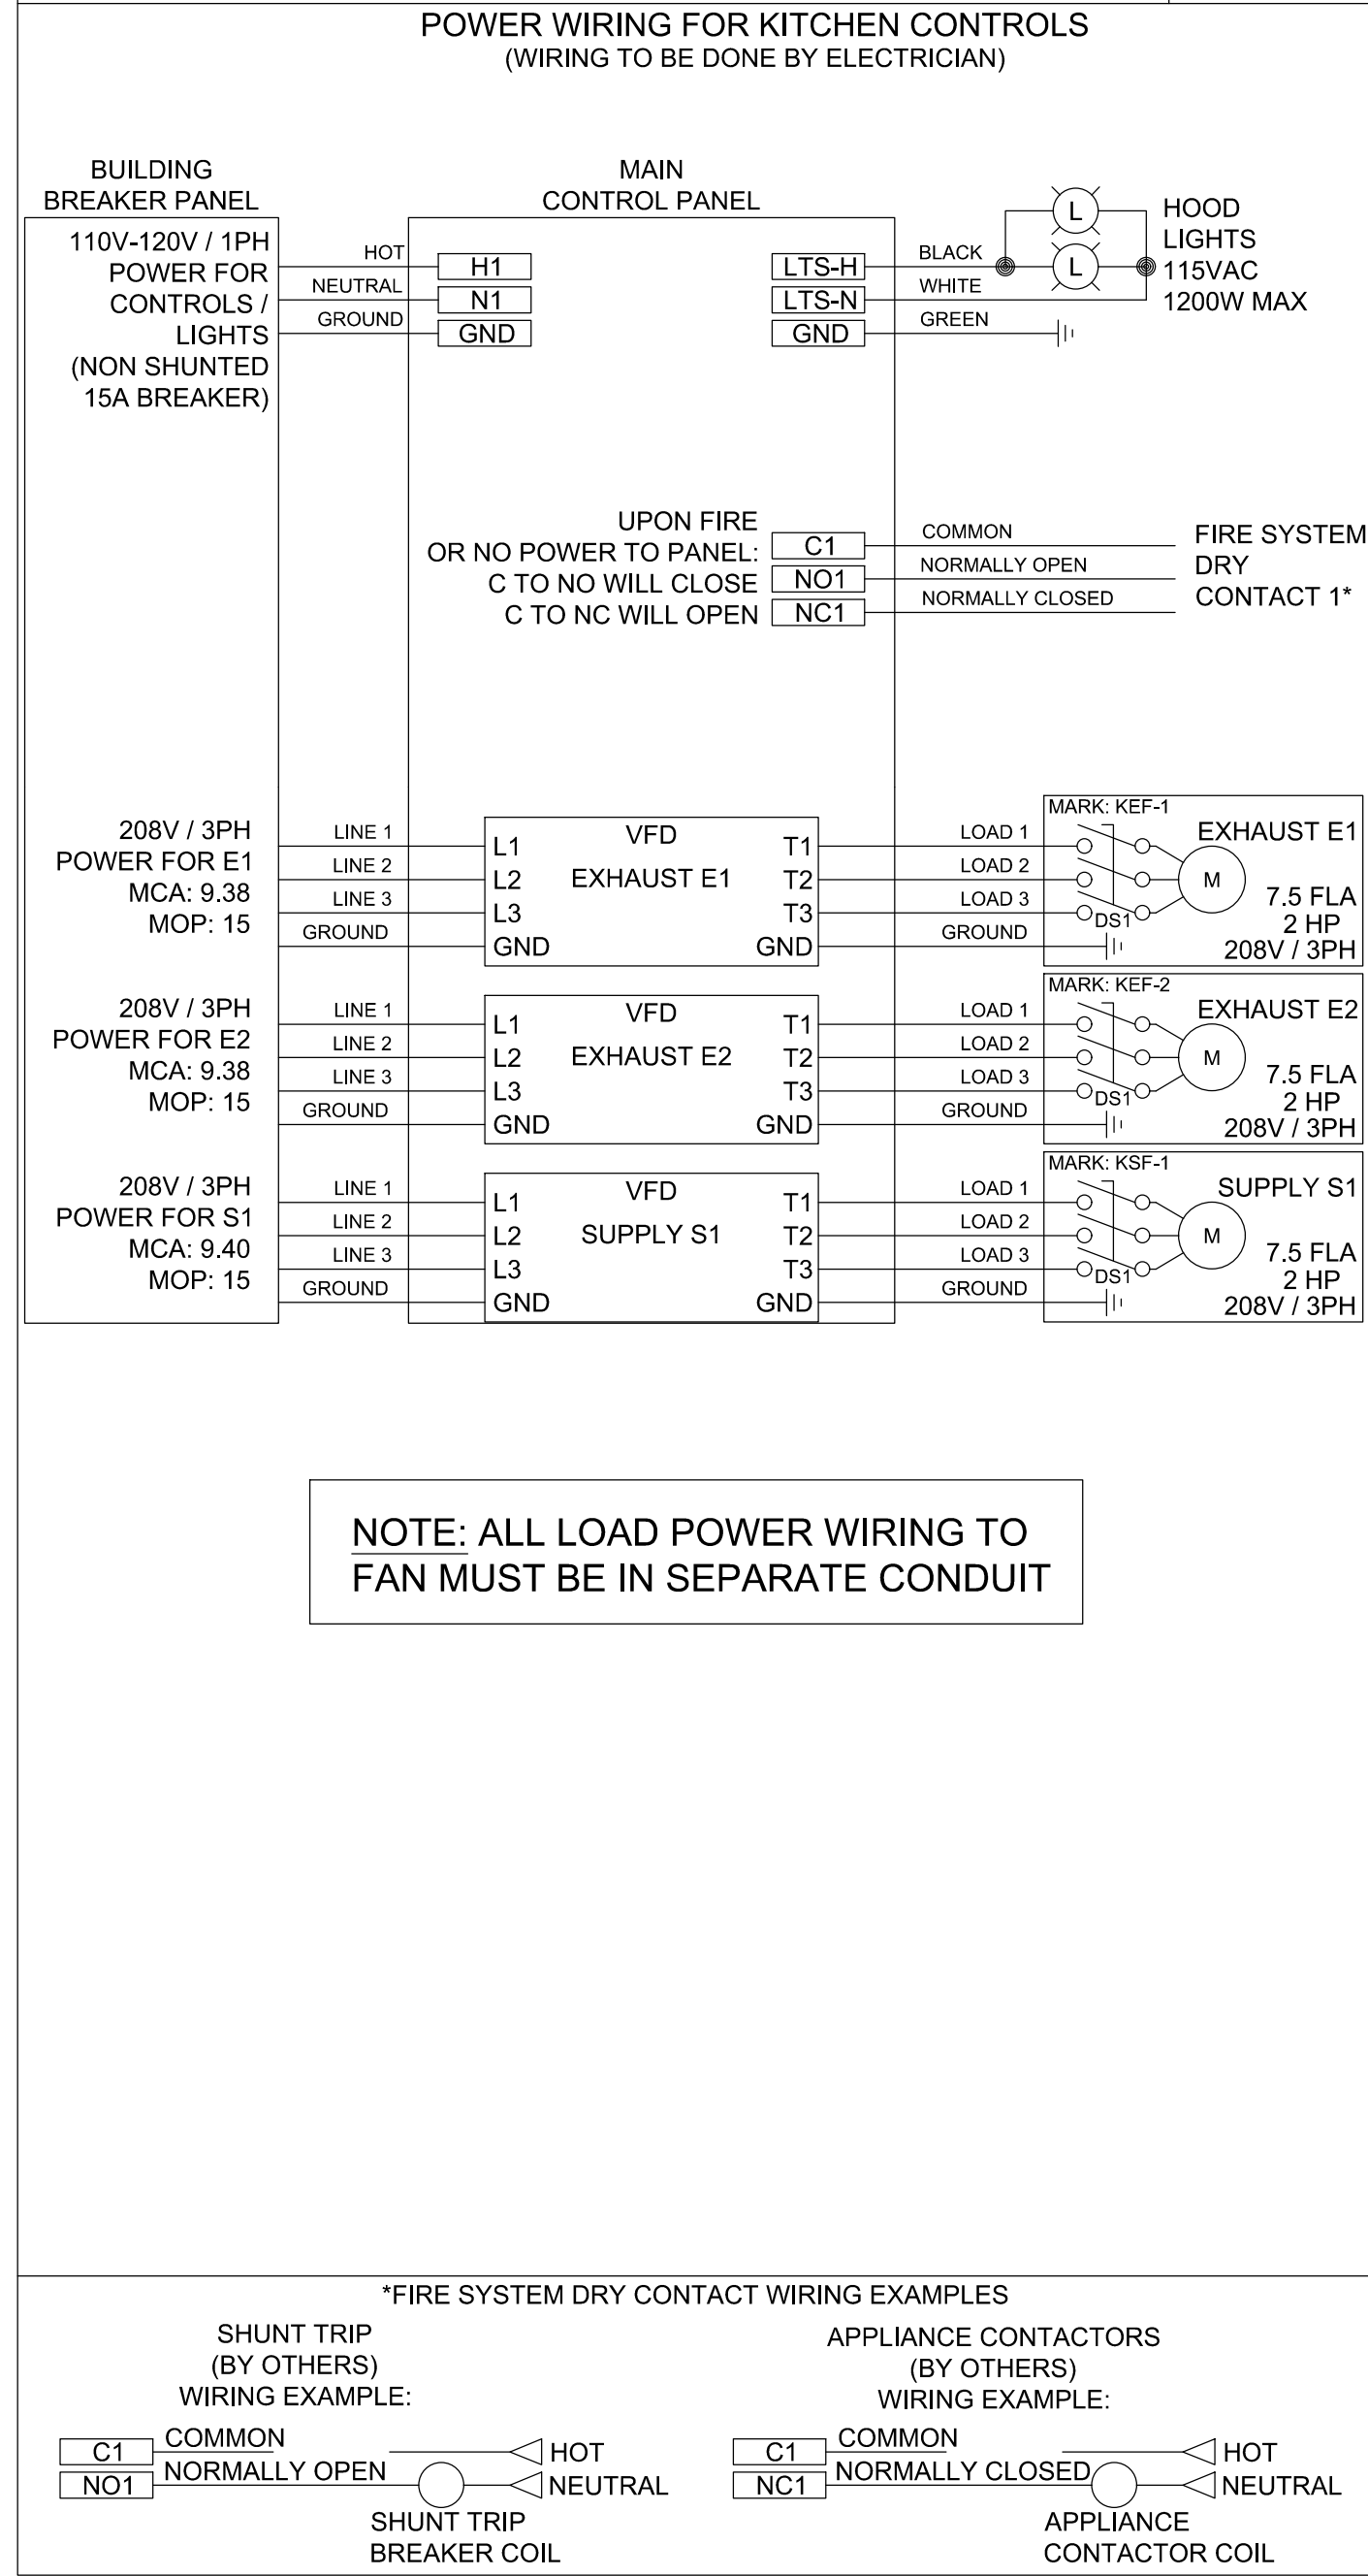

ZONE CONFIGURATION				WIRING DIAGRAM CODE: ####									
ZONE #	ZONE	ROOM TEMP		JOB NAME: 7 TEQUILA REV2									
1	Z1	PRESET		MODEL: XKC-CV-S-21-2-1-0									
				SERIAL NUMBER: WDSN#									
				MARK: CONTROLS									
				DOC NUMBER: ####									
				DEFAULT SETTINGS / PARAMÈTRES PAR DÉFAUT									
				FACTORY SETTINGS									
				TYPE CY CONFIGURATION: STANDARD									
				HOODS: 2									
				SUMPS: 0									
				EXHAUST FANS: 2									
				MB ROOM SENSOR: NO									
				MB TEMP SENSORS: 2									
				HIGH TEMP FAULT: NO									
				FREEZE PROTECTION: YES									
				GAS RESET: NO									
				FAN PROVING: NO									
				BMS: NONE									
				ZONE SETTINGS									
				SEE ZONE CONFIGURATION IN TABLE ON LEFT									
				HOOD SETTINGS									
				SEE HOOD CONFIGURATION IN TABLE ON LEFT									
				EXHAUST FAN SETTINGS									
				SEE FAN CONFIGURATION IN TABLE ON LEFT									
				SUPPLY FAN SETTINGS									
				SEE FAN CONFIGURATION IN TABLE ON LEFT									
				SENSOR SETTINGS									
				SEE HOOD CONFIGURATION IN TABLE ON LEFT									
				USER INTERFACE SETTINGS (MB)									
				FAN & LIGHT BUTTONS: SHOW BOTH (SEPERATE)									
				USER INTERFACE SETTINGS (HCB)									
				NA									
				GENERAL SETTINGS									
				TIME ZONE: CENTRAL DAYLIGHT (DEFAULT)									
				FIREFAULT SETTINGS									
				EXHAUST DURING FIRE: MAX									
				SUPPLY DURING FIRE: OFF									
				LIGHTS DURING FIRE: OFF									
				BMS SETTINGS									
				NA									
				FAN CONFIGURATION									
FAN #	TYPE	FAN		FAN MARK	ZONE	MIN CFM	MAX CFM	MODBUS VFD	VFD ADDRESS	MIN FREQ	MAX FREQ	MIN VDC	MAX VDC
1	EXHAUST	E1		KEF-1	Z1	-	2500	YES	1	22	44	-	-
2	EXHAUST	E2		KEF-2	Z1	-	2500	YES	2	22	44	-	-
3	SUPPLY	S1		KSF-1	Z1	-	4000	YES	3	30	60	-	-

ACCUREX

7 TEQUILA REV2

PROJECT 2/23/2022
ACCUREX GA
EDWIN JOHNSON
EDWIN.JOHNSON@ACCUREX.COM
(404)521-6063

B



2801 South Valley Parkway, Suite 200
Lewisville, TX 75067
p. 469-240-7200

trimarkusa.com

This document contains confidential information, is an instrument of a professional service, and the property of TriMark. It shall not be used on other projects or for the extension of this project without TriMark's written approval.

Owner and all Contractors to check and verify existing dimensions and conditions in the field before starting construction and to notify TriMark of any material or detail changes.

REVISIONS

DATE	NO.	DESCRIPTION
03-14-22	B	G.C.SHOP DWG. COORD.2


7 Tequila
Holly Springs, GA.

PROJECT NUMBER	22.1228
DATE:	02/09/2022
SCALE:	NTS
DRAWN BY:	RJF
APPROVED BY:	JBS

SHEET TITLE:
MANUFACTURER SHOP
DRAWINGS

SHEET NUMBER:
QF704

THIS DOCUMENT WAS ORIGINALLY PRINTED ON A 30" x 42" SIZE SHEET

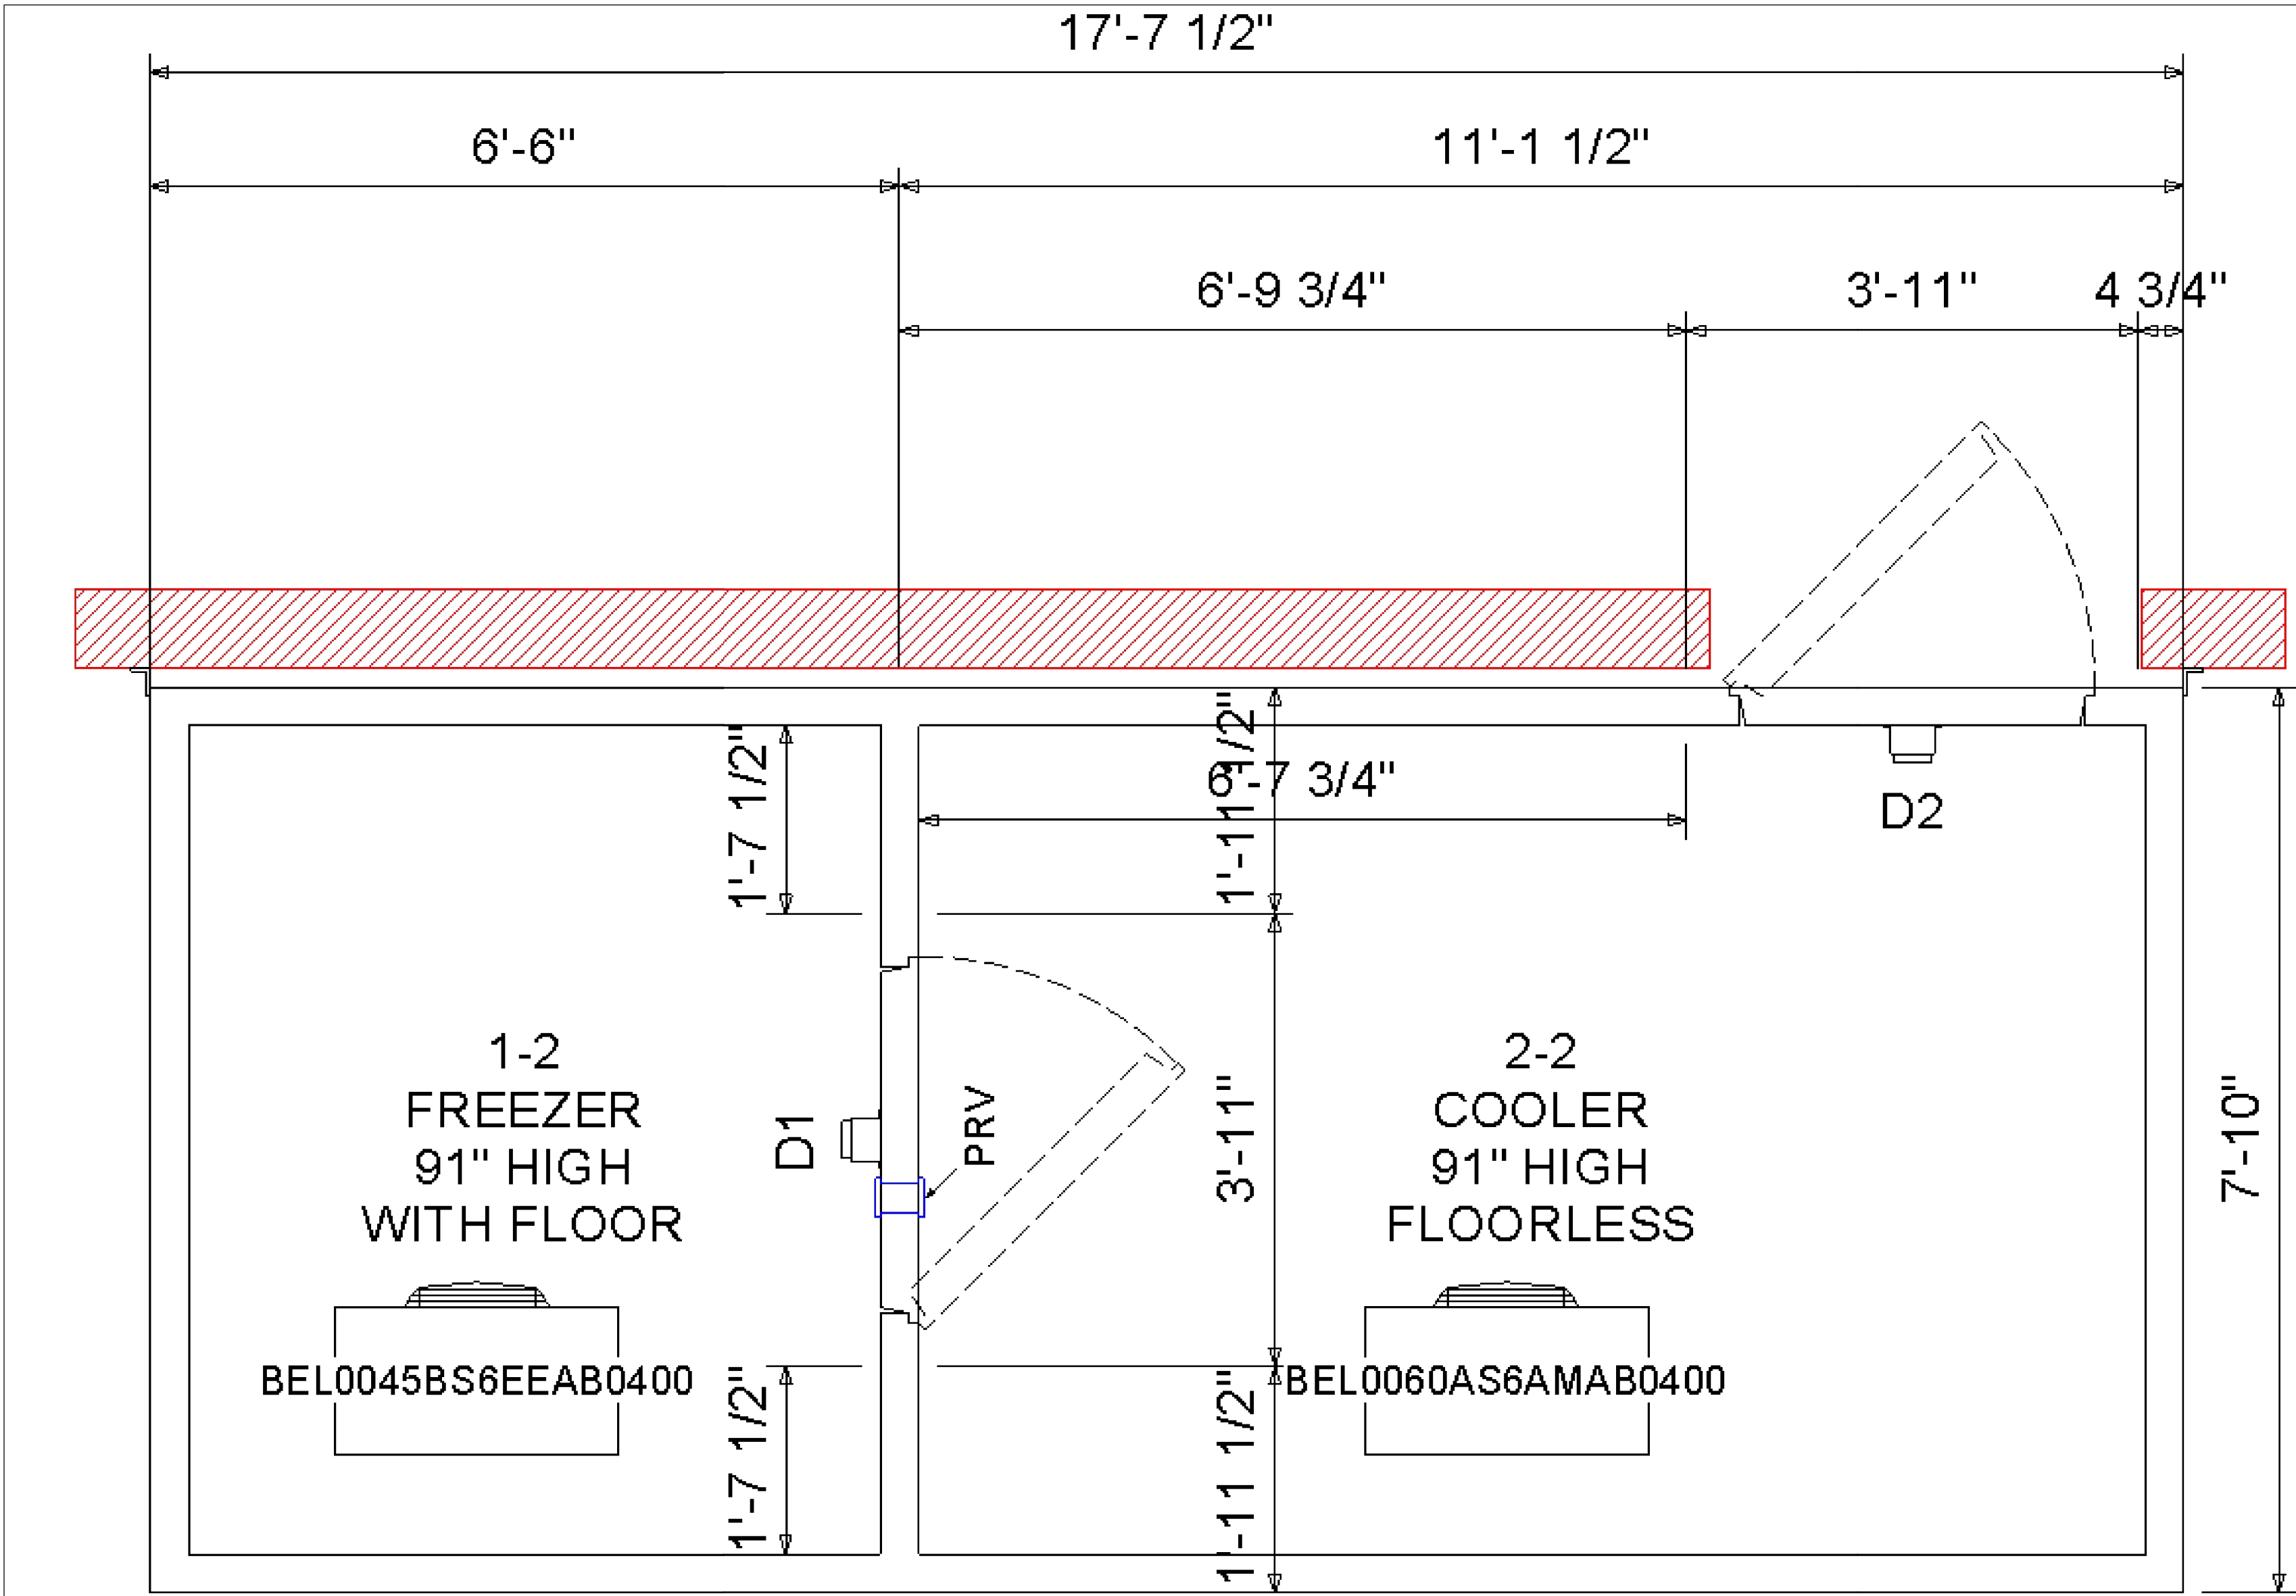

-SPECIFICATION-
Box Height: Freezer 7'-7" (6'-11" Interior)
Cooler 7'-7" (7'-3" Interior)
Insulation: 4" thick AK-XP54 Extruded foam UL classified core flame spread 15, Smoke rating less than 165

Compartment 1 - Freezer
D1 - (1) Standard 36" x 76" Left hinged flush door with brushed hardware. Interior & Exterior finish: 26 Ga. Stucco Embossed Acrylume. Energy saving temperature regulating thermostat heater wire and heated relief vent. Heavy duty deadbolt handle latch. Digital LED Thermometer with pilot light switch. 1807 11w, Vapor Proof, 120V. LED fixture. 82 Lumens /watt Angled face . Requires 115vac. 2.2 amps.

Refrigeration:
(1) 1.5 HP Bohn DOE Compliant Outdoor Condensing Unit, Model BCH0014LBACHA0200, 208-230/1/60, MCA 15 Amps, Low Temperature, Hermetic, Air-cooled, R-404A, This refrigeration system is designed and certified for use in walk-in freezer applications - AWEF3, 1 y (5637 Btu/hr @ -10°F room temperature and 95°F ambient)
(1) Bohn DOE Compliant BEL0045BS6EEAB0400, Low Profile Electric Defrost, 0.5 Fan Amps with Fixed Speed EC motor
(1) Extended 4 year compressor Warranty

Wall Panels
Interior Finish: 26 Ga. Stucco Embossed Acrylume
Exterior Finish: 26 Ga. Stucco Embossed Acrylume

Ceiling Panels
Interior Finish: 26 Ga. Stucco Embossed Acrylume
Exterior Finish: 26 Ga. Stucco Embossed Acrylume

Floor Panels
NSF Floor panel rated for 700 LBS/ SQ. FT.
22 Ga. Stainless Steel Integral


Application: Foot Traffic - No Rolling Carts

Compartment 2 - Cooler
D2 - (1) Standard 36" x 76" Right hinged flush door with brushed hardware. Interior & Exterior finish: 26 Ga. Stucco Embossed Acrylume. Heavy duty deadbolt handle latch. Digital LED Thermometer with pilot light switch. 1807 11w, Vapor Proof, 120V. LED fixture. 82 Lumens /watt Angled face . Requires 115vac. 1 amps.

Refrigeration:

Customer Approval:

Quote #: 21-29898 Revision:	Project: 7 Tequila walkin Holly Springs	Date: 10/20/2021
Customer:Trimark Strategic Food Service Design Eq.	Page 1 of 3	

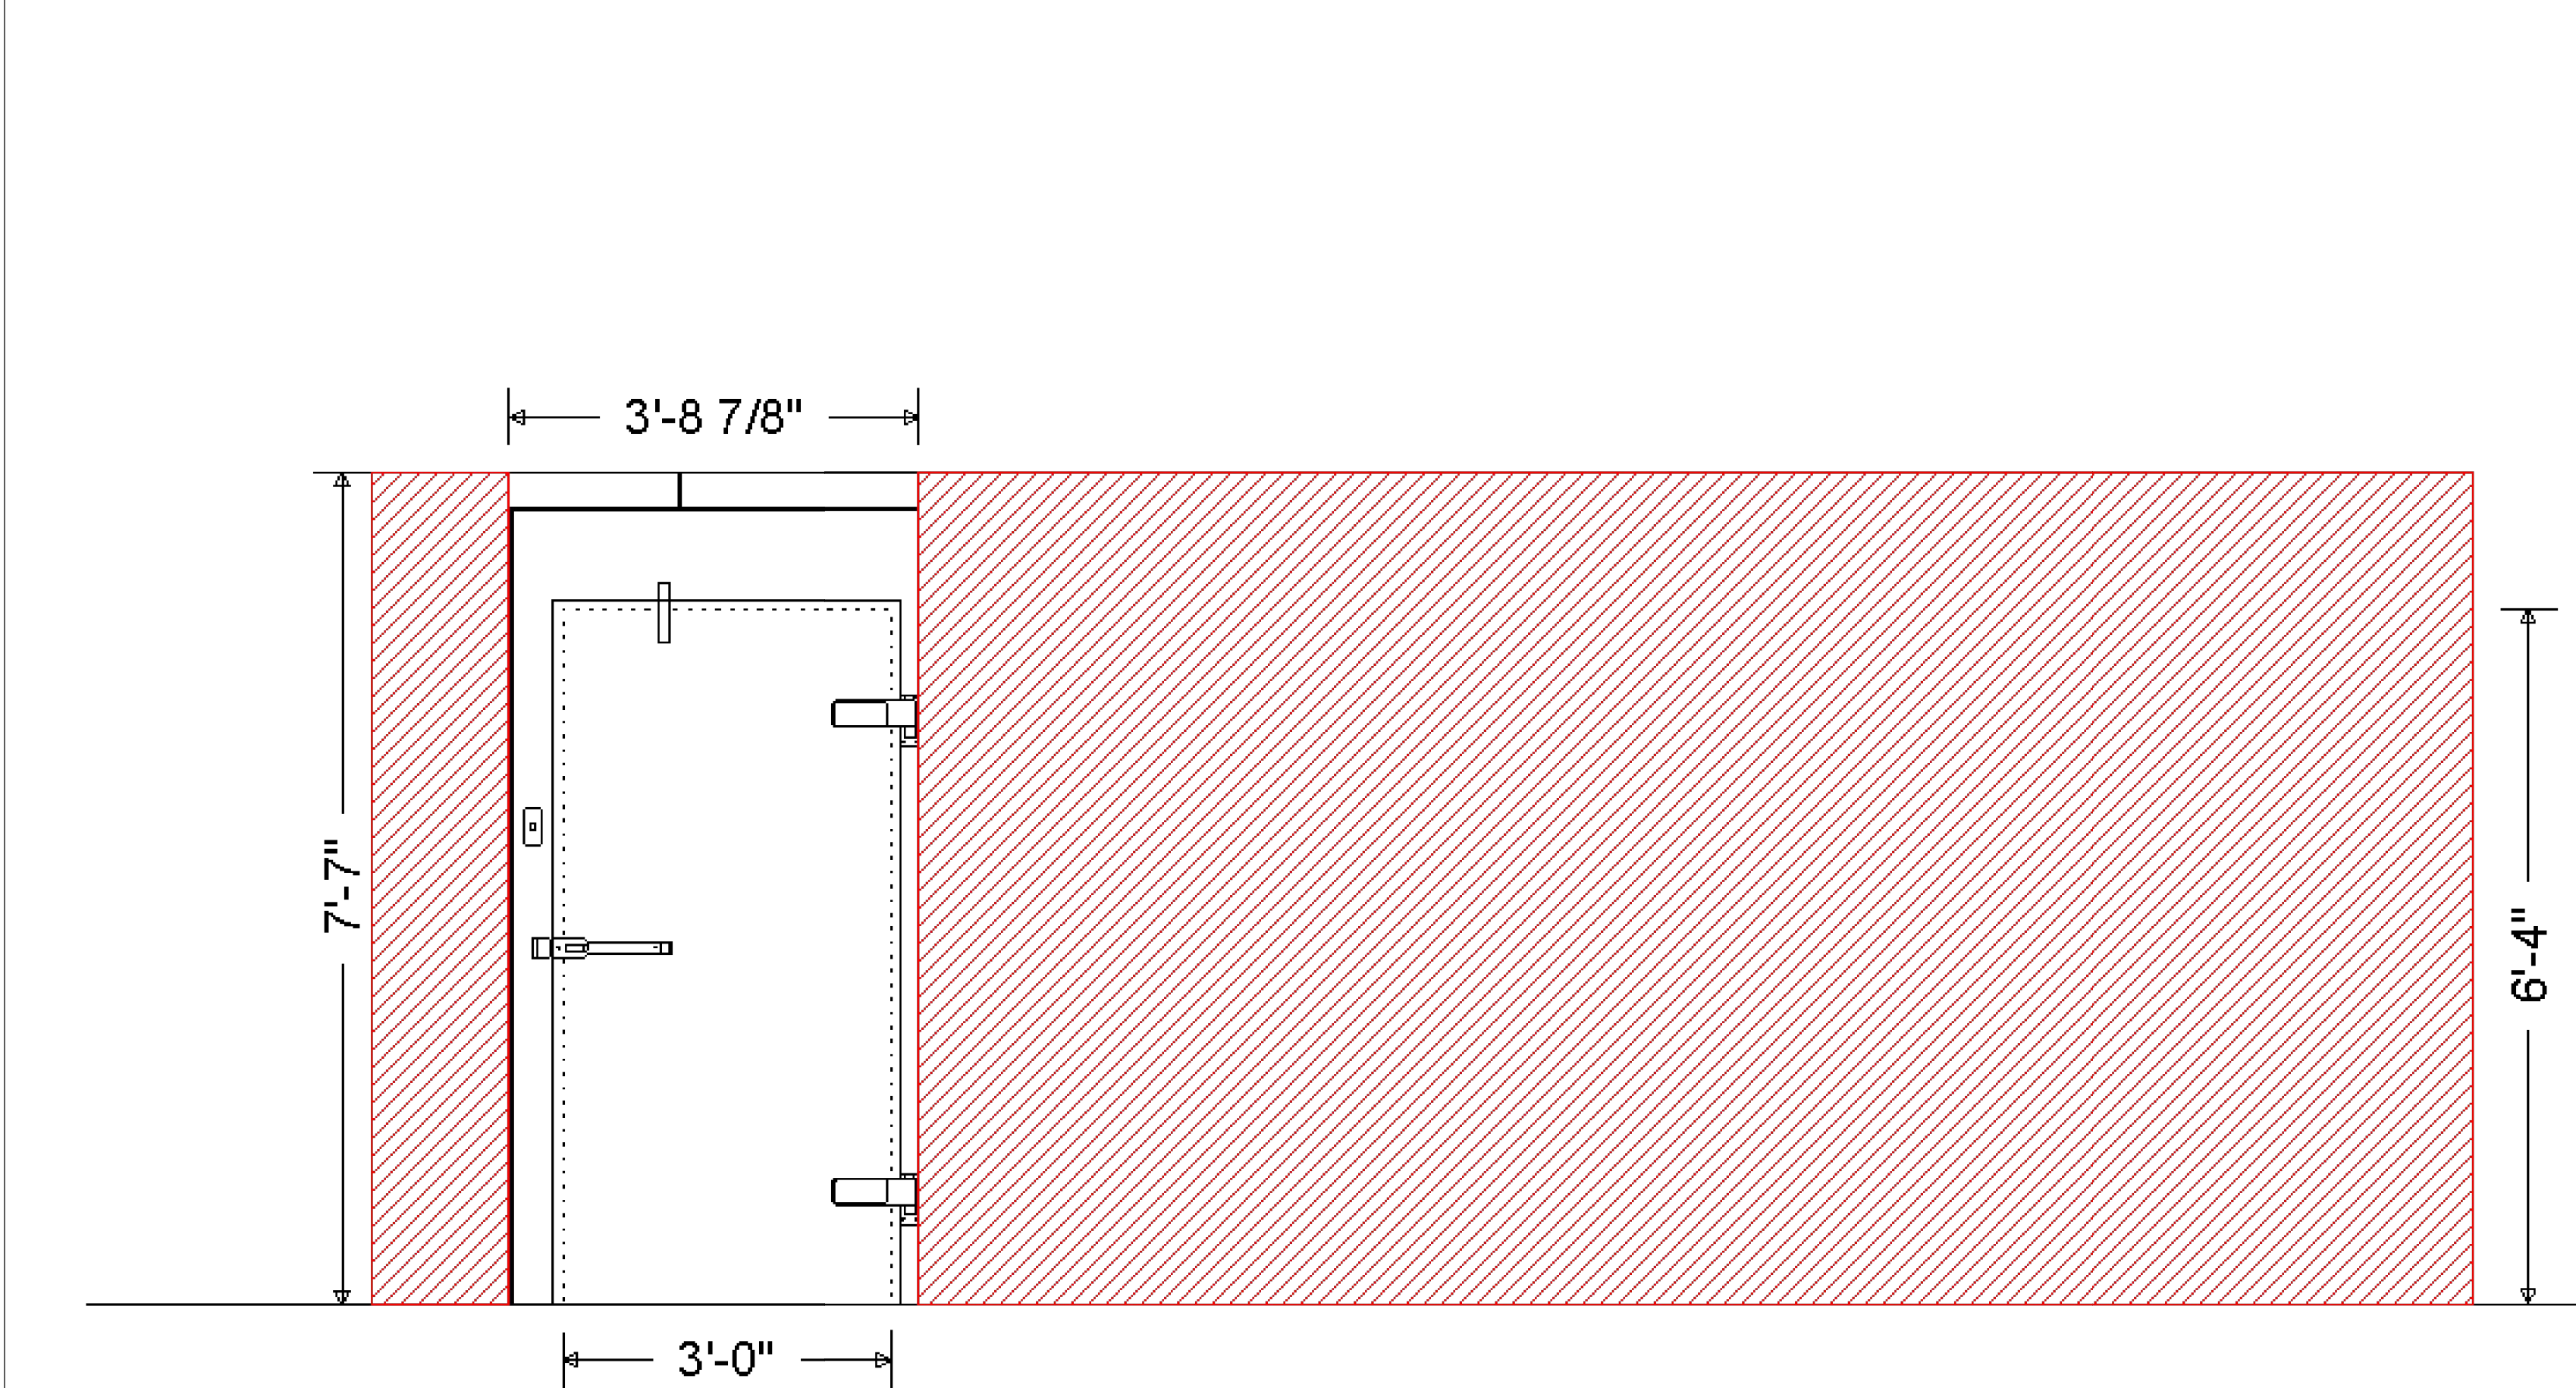

-SPECIFICATION-Continued
(1) 0.5 HP Bohn DOE Compliant Outdoor Condensing Unit, Model BCH0005MBACZA0000, 208-230/1/60, MCA 15 Amps, BTUH 7660, Medium Temperature, Scroll, Air-cooled, R-404A, This refrigeration system is designed and certified for use in walk-in cooler applications -
(1) Bohn DOE Compliant BEL0060AS6AMAB0400, Low Profile Air Defrost, 0.9 Fan Amps with 2 Speed EC motor

Wall Panels
Interior Finish: 26 Ga. Stucco Embossed Acrylume
Exterior Finish: 26 Ga. Stucco Embossed Acrylume

Ceiling Panels
Interior Finish: 26 Ga. Stucco Embossed Acrylume
Exterior Finish: 26 Ga. Stucco Embossed Acrylume

Accessories Shipped Loose
(144) Rain roof membrane w/ 10 ft. long with termination bars with1 screw every 12inch (per sq.ft.)
(1) Cooler - Extended 4 Year Compressor Warranty
(5) NSF VINYL FLOOR SCREED 72"
(9) OUTDOOR WALK-IN PERIMETER REINFORCEMENT FLOOR ANGLE (.050 THICK ALUMINUM) 1 1/2" X 6 " X 48" EACH SECTION - SUPPLIED WITH STAINLESS STEEL TEK SCREWS, TO SECURE WALL AND FLOOR. CONCRETE ANCHORS (BY OTHERS)
(1) VERTICAL AND HORIZONTAL TRIMS 2" X 3" FOR WALK-IN DOOR ACCESSING INTO BUILDING
(2) VERTICAL TRIM 2" X 3" X 91" FOR OUTDOOR BOXES AGAINST BUILDING STRUCTURE

Notes:
* Allow a minimum of 2" clearance around all sides of the walk-in for proper air circulation

Customer Approval:

Quote #: 21-29898 Revision:	Project: 7 Tequila walkin Holly Springs	Date: 10/20/2021
Customer:Trimark Strategic Food Service Design Eq.	Page 2 of 3	



2801 South Valley Parkway, Suite 200
Lewisville, TX 75067
p. 469-240-7200

trimarkusa.com

This document contains confidential information, is an instrument of a professional service, and the property of TriMark. It shall not be used on other projects or for the extension of this project without TriMark's written approval.

Owner and all Contractors to check and verify existing dimensions and conditions in the field before starting construction and to notify TriMark of any material or detail changes.

REVISIONS

DATE	NO.	DESCRIPTION
03-14-22	B	G.C.SHOP DWG. COORD.2

7 Tequila
Holly Springs, GA.

Back of House and Bar

PROJECT NUMBER 22.1228	
DATE:	02/09/2022
SCALE:	NTS
DRAWN BY: RJF	APPROVED BY: JBS

SHEET TITLE: MANUFACTURER SHOP DRAWINGS

SHEET NUMBER: QF705

B

This document contains confidential information, is an instrument of a professional service, and the property of TriMark. It shall not be used on other projects or for the extension of this project without TriMark's written approval.

Owner and all Contractors to check and verify existing dimensions and conditions in the field before starting construction and to notify TriMark of any material or detail changes.

REVISIONS

DATE	NO.	DESCRIPTION
03-14-22	B	G.C.SHOP DWG. COORD.2

7 Tequila
Holly Springs, GA.

Back of House and Bar

PROJECT NUMBER 22.1228	
DATE:	02/09/2022
SCALE:	NTS
DRAWN BY: RJF	APPROVED BY: JBS

SHEET TITLE: MANUFACTURER SHOP DRAWINGS

SHEET NUMBER: QF706

B

D1

D2

FLUSH DOOR JAMB ALUMINUM ANGLE

FLOOR & WALL DETAIL (700 LBS / FT² DIST. LOAD)

VINYL CREED WALL PANEL

RAIN ROOF WINDOW FRAME

Quote #: 21-29898 Revision:

Customer:Trimark Strategic Food Service Design Eq.

Project: 7 Tequila walkin Holly Springs

Page 3 of 3

Date: 10/20/2021

GENERAL

1. NO PROVISION OF ANY REFERENCED STANDARD SPECIFICATION, MANUAL OR CODE (WHETHER OR NOT SPECIFICALLY INCORPORATED BY REFERENCE IN THE CONTRACT DOCUMENTS) SHALL BE EFFECTIVE TO CHANGE THE DUTIES AND RESPONSIBILITIES OF OWNER, CONTRACTOR, DESIGN PROFESSIONAL, SUPPLIER, OR ANY OF THEIR CONSULTANTS, AGENTS, OR EMPLOYEES FROM THOSE SET FORTH IN THE CONTRACT DOCUMENTS, NOR SHALL IT BE EFFECTIVE TO ASSIGN TO THE DESIGN PROFESSIONAL OF RECORD OR ANY OF THE DESIGN PROFESSIONAL OF RECORD'S CONSULTANTS, AGENTS, OR EMPLOYEES ANY DUTY OR AUTHORITY TO SUPERVISE OR DIRECT THE FURNISHING OR PERFORMANCE OF THE WORK OR ANY DUTY OR AUTHORITY TO UNDERTAKE RESPONSIBILITIES CONTRARY TO THE PROVISIONS OF THE CONTRACT DOCUMENTS.
2. CONTRACT DOCUMENTS INCLUDE, BUT ARE NOT LIMITED TO, THE STRUCTURAL DOCUMENTS (DRAWINGS AND SPECIFICATIONS), BUT DO NOT INCLUDE SHOP DRAWINGS, VENDOR DRAWINGS, OR MATERIAL PREPARED AND SUBMITTED BY THE CONTRACTOR.
3. REFERENCE TO STANDARD SPECIFICATIONS OF ANY TECHNICAL SOCIETY, ORGANIZATION, OR ASSOCIATION OR TO CODES OF LOCAL OR STATE AUTHORITIES, SHALL MEAN THE LATEST STANDARD, CODE, SPECIFICATION OR TENTATIVE SPECIFICATION ADOPTED AT THE DATE OF TAKING BIDS, UNLESS SPECIFICALLY STATED OTHERWISE.
4. CONTRACT DOCUMENTS SHALL GOVERN IN THE EVENT OF A CONFLICT WITH THE CODE OF PRACTICE OR SPECIFICATIONS OF ACI, PCI, AISC, SJI OR OTHER STANDARDS, WHERE A CONFLICT OCCURS WITHIN THE CONTRACT DOCUMENTS, THE STRICTEST REQUIREMENT SHALL GOVERN.
5. MATERIAL, WORKMANSHIP, AND DESIGN SHALL CONFORM TO THE REFERENCED BUILDING CODE.
6. CONTRACTOR SHALL COORDINATE THE STRUCTURAL DOCUMENTS WITH THE ARCHITECTURAL, MECHANICAL, ELECTRICAL, PLUMBING AND CIVIL DOCUMENTS. DESIGN PROFESSIONAL SHALL BE NOTIFIED OF ANY DISCREPANCY OR OMISSION, FOR DIMENSIONS NOT SHOWN ON THE STRUCTURAL DRAWINGS SEE THE ARCHITECTURAL DRAWINGS.
7. CONTRACTOR SHALL VERIFY EXISTING DIMENSIONS, ELEVATIONS, AND SITE CONDITIONS BEFORE STARTING WORK. DESIGN PROFESSIONAL SHALL BE NOTIFIED OF ANY DISCREPANCY.
8. CONTRACTOR SHALL VERIFY THE STRUCTURALLY SUPPORTED MECHANICAL EQUIPMENT WEIGHTS, OPENING SIZES AND LOCATIONS IDENTIFIED ON THE STRUCTURAL DRAWINGS WITH ARCHITECTURAL AND MECHANICAL DRAWINGS.
9. CONTRACTOR SHALL VERIFY THAT MISCELLANEOUS FRAMING SHOWN ON THE STRUCTURAL DRAWINGS FOR MECHANICAL EQUIPMENT, OWNER-FURNISHED ITEMS, PARTITIONS, ETC. IS CONSISTENT WITH THE REQUIREMENTS OF SUCH ITEMS.
10. CONTRACTOR HAS SOLE RESPONSIBILITY FOR MEANS, METHODS, TECHNIQUES, SEQUENCES, AND PROCEDURES OF CONSTRUCTION.
11. THE STRUCTURE IS STABLE ONLY IN ITS COMPLETED FORM. TEMPORARY SUPPORTS REQUIRED FOR STABILITY DURING ALL INTERMEDIATE STAGES OF CONSTRUCTION SHALL BE DESIGNED, FURNISHED, AND INSTALLED BY THE CONTRACTOR.
12. CONTRACTOR HAS SOLE RESPONSIBILITY TO COMPLY WITH ALL OSHA REGULATIONS.
13. ELECTRONIC DRAWING FILES WILL NOT BE PROVIDED TO THE CONTRACTOR. REPRODUCTION OF STRUCTURAL DRAWINGS FOR SHOP DRAWINGS IS NOT PERMITTED.
14. REVIEW OF SUBMITTALS OR SHOP DRAWINGS BY THE DESIGN PROFESSIONAL DOES NOT RELIEVE THE CONTRACTOR OF THE SOLE RESPONSIBILITY TO REVIEW AND CHECK ALL SUBMITTALS AND SHOP DRAWINGS BEFORE SUBMITTING TO THE DESIGN PROFESSIONAL. CONTRACTOR REMAINS SOLELY RESPONSIBLE FOR ERRORS AND OMISSIONS ASSOCIATED WITH THE PREPARATION OF SHOP DRAWINGS AS THEY RELATE TO MEMBER SIZES, DETAILS, AND DIMENSIONS SPECIFIED IN THE CONTRACT DOCUMENTS.
15. DETAILS LABELED "TYPICAL" ON THE STRUCTURAL DRAWINGS APPLY TO ALL SITUATIONS OCCURRING ON THE PROJECT THAT ARE THE SAME OR SIMILAR TO THE TYPICAL DETAILS UNLESS THOSE LOCATIONS ARE SPECIFICALLY DETAILED OTHERWISE.
16. STRUCTURAL DESIGN PROFESSIONAL IS NOT RESPONSIBLE FOR THE DESIGN OF STEEL STAIRS, CURTAIN WALL/WINDOW WALL SYSTEMS, COLD-FORMED METAL FRAMING, OR OTHER SYSTEMS NOT SHOWN IN THE STRUCTURAL DOCUMENTS. SUCH SYSTEMS SHALL BE DESIGNED, FURNISHED, AND INSTALLED AS REQUIRED BY OTHER PORTIONS OF THE CONTRACT DOCUMENTS.

CODE/DESIGN CRITERIA

1. STRUCTURE IS DESIGNED IN ACCORDANCE WITH THE FOLLOWING:

• INTERNATIONAL BUILDING CODE, 2012 EDITION, WITH GEORGIA AMENDMENTS
2. GRAVITY LOADS

2.1 UNIFORM FLOOR LIVE LOADS (REDUCED AS ALLOWED BY THE BUILDING CODE):

• RESTAURANTS 100 PSF
• STAIRS 100 PSF

2.2 UNIFORM ROOF LIVE LOADS (REDUCED AS ALLOWED BY THE BUILDING CODE):

• ROOF 20 PSF
• GROUND SNOW LOAD 5 PSF

PONDING AND DRIFT EFFECTS HAVE BEEN INCLUDED IN THE DESIGN.
- 2.3 DEAD LOADS (IN ADDITION TO STRUCTURE SELF-WEIGHT):

FLOOR:

• MISCELLANEOUS 5 PSF
• CEILING/MEP 5 PSF

ROOF:

• ROOFING 5 PSF
• INSULATION 5 PSF
• MISCELLANEOUS 5 PSF
• CEILING/MEP 5 PSF
3. WIND LOADS:

• 115 MPH BASIC WIND SPEED
• IMPORTANCE FACTOR = 1.0
• EXPOSURE C
• INTERNAL PRESSURE COEFFICIENT = ± 18
• USE FACTOR = 1.0
- SEE COMPONENT AND CLADDING DESIGN WIND PRESSURE DIAGRAM
4. EARTHQUAKE LOADS:

• SEISMIC IMPORTANCE FACTOR: I = 1.0
• OCCUPANCY CATEGORY: II
• SHORT PERIOD MAPPED SPECTRAL RESPONSE COEFFICIENT, S_s = 0.232
• 1 SECOND PERIOD MAPPED SPECTRAL RESPONSE COEFFICIENT, S₁ = 0.098
• SITE CLASS D
• SHORT PERIOD DESIGN SPECTRAL RESPONSE COEFFICIENT, SD_s = 0.247
• 1 SECOND PERIOD DESIGN SPECTRAL RESPONSE COEFFICIENT, SD₁ = 0.157
• SEISMIC DESIGN CATEGORY: C
• BASIC SEISMIC-FORCE RESISTING SYSTEM: STEEL NOT SPECIFICALLY DETAILED FOR SEISMIC RESISTANCE
• DESIGN BASE SHEAR: 10 KIPS
• OVER STRENGTH FACTOR, OMEGA = 2
• SEISMIC RESPONSE COEFFICIENT, C_s = 0.082
• RESPONSE MODIFICATION FACTOR, R = 3.0
• ANALYSIS PROCEDURE: EQUIVALENT LATERAL FORCE PROCEDURE
5. UNLESS NOTED OTHERWISE CALCULATED INDIVIDUAL MEMBER DEFLECTIONS (IN INCHES) DO NOT EXCEED THE FOLLOWING:

- ROOF MEMBERS: DEAD LOAD L/360
FLOOR MEMBERS: L/360
- LIVE LOAD L/360
- DEAD + LIVE LOAD L/240
- WHERE, L = SPAN LENGTH (IN INCHES) BETWEEN SUPPORTS. (FOR CANTILEVERS, L IS TWICE THE LENGTH OF THE CANTILEVER) NOTE THAT THE TOTAL MAXIMUM CALCULATED FLOOR SYSTEM DEFLECTION WILL BE THE SUM OF THE DEFLECTIONS OF THE SUPPORTED ELEMENTS IN A BAY.
- THE CALCULATED DEFLECTION FOR INDIVIDUAL MEMBERS SUPPORTING MASONRY DO NOT EXCEED L/600 FOR DESIGN LOADS APPLIED AFTER THE INSTALLATION OF THE MASONRY.
6. SPECIAL INSPECTIONS:

6.1 THE STRUCTURAL TESTING/INSPECTION AGENCY, WILL PERFORM SPECIAL INSPECTIONS AS REQUIRED BY CHAPTER 17 OF THE BUILDING CODE. MATERIALS AND WORK TO BE INSPECTED INCLUDE SOIL, STEEL AND CONCRETE CONSTRUCTION.

6.2 SPECIAL INSPECTION AS REQUIRED BY CHAPTER 17 OF THE BUILDING CODE ARE REQUIRED FOR STRUCTURAL COMPONENTS AND ASSEMBLIES WHICH ARE NOT FABRICATED AT THE CONSTRUCTION JOB SITE INCLUDING BUT NOT LIMITED TO STRUCTURAL STEEL FRAMING.

6.3 SPECIAL INSPECTION AS REQUIRED BY CHAPTER 17 OF THE BUILDING CODE MAY BE WAIVED FOR ITEMS WHICH ARE PRODUCED ON THE PREMISES OF A FABRICATOR REGISTERED AND APPROVED TO PERFORM SUCH WORK WITHOUT SPECIAL INSPECTION. APPROVAL SHALL BE BASED UPON REVIEW OF THE FABRICATOR'S WRITTEN PROCEDURAL AND QUALITY CONTROL MANUALS AND BY PERIODIC AUDITING OF FABRICATION PRACTICES BY AN APPROVED SPECIAL INSPECTION AGENCY. THE APPROVED FABRICATOR SHALL SUBMIT A CERTIFICATE OF COMPLIANCE TO THE CHIEF COMMERCIAL BUILDING INSPECTOR OR HIS DESIGNEE WHICH STATES THAT THE FABRICATION WORK WAS PERFORMED IN ACCORDANCE WITH THE APPROVED CONSTRUCTION DOCUMENTS.

6.4 THE PROJECT OWNER WILL EMPLOY ONE OR MORE SPECIAL INSPECTORS TO PERFORM INSPECTIONS AS REQUIRED BY CHAPTER 17 OF THE BUILDING CODE DURING CONSTRUCTION OF THE PROJECT. DOCUMENTATION THAT SUMMARIZES THE QUALIFICATION AND CREDENTIALS OF EACH SPECIAL INSPECTOR AND DEMONSTRATES COMPETENCE FOR INSPECTION OF EACH PARTICULAR TYPE OF CONSTRUCTION REQUIRING SPECIAL INSPECTION SHALL BE SUBMITTED TO THE CHIEF COMMERCIAL BUILDING INSPECTOR OR HIS DESIGNEE FOR REVIEW AND APPROVAL PRIOR TO CONSTRUCTION.

6.5 APPROVED SPECIAL INSPECTORS SHALL FURNISH INSPECTION REPORTS TO THE CHIEF COMMERCIAL BUILDING INSPECTOR OR HIS DESIGNEE WHICH INDICATE THAT THE WORK INSPECTED WAS DONE IN CONFORMANCE WITH THE APPROVED CONSTRUCTION DOCUMENTS. A FINAL REPORT WHICH DOCUMENTS THE RESULTS OF THE SPECIAL INSPECTIONS PERFORMED INCLUDING CORRECTION OF ANY DISCREPANCIES IDENTIFIED DURING INSPECTION SHALL BE SUBMITTED PERIODICALLY AT A FREQUENCY APPROVED BY CHIEF COMMERCIAL BUILDING INSPECTOR PRIOR TO CONSTRUCTION.
7. NO PROVISIONS HAVE BEEN MADE FOR FUTURE HORIZONTAL OR VERTICAL EXPANSION.

FOUNDATION

1. FOUNDATION DESIGN IS BASED ON THE RECOMMENDATIONS IN THE GEOTECHNICAL REPORT PREPARED BY GEO HYDRO ENGINEERS, REPORT NUMBER 180494.20 DATED JUNE 20, 2018. DESIGN PROFESSIONAL IS NOT RESPONSIBLE FOR SUBSURFACE CONDITIONS ENCOUNTERED IN THE FIELD DIFFERENT TO THOSE ASSUMED FOR DESIGN.
2. STRUCTURAL TESTING/INSPECTION AGENCY SHALL CERTIFY THE BEARING MEDIUM.
3. INDIVIDUAL SPREAD FOOTINGS AND CONTINUOUS FOOTINGS SHALL BEAR ON SOIL CAPABLE OF SUPPORTING 3000 PSF.
- 3.1 NO FOOTINGS SHALL BEAR ON ROCK, UNDERCUT ROCK A MINIMUM OF 2 FEET BELOW BOTTOM OF FOOTING AND REPLACE WITH STRUCTURAL FILL.
4. PROOF ROLL BUILDING AREAS WITH TWO COMPLETE COVERAGES OF A LOADED DUMP-TRUCK OR SCRAPER, REPLACE SOFT AREAS WITH COMPACTED STRUCTURAL FILL AS REQUIRED BY THE SPECIFICATIONS.
5. DENSIFY BUILDING AREAS AND A MINIMUM OF 10'-0" OUTSIDE THE BUILDING PERIMETER USING A VIBRATORY ROLLER.
6. SUBMIT A DETAILED BLASTING PLAN IF BLASTING IS REQUIRED. SUCH PLANS SHALL BE REVIEWED AND RETURNED TO THE CONTRACTOR PRIOR TO BLASTING.
7. STRUCTURAL FILL SHALL CONTAIN NO ORGANIC MATERIAL AND BE APPROVED BY A GEOTECHNICAL ENGINEER PRIOR TO PLACEMENT. STRUCTURAL FILL UNDER SLABS AND WITHIN 10'-0" OF THE BUILDING FOOTPRINT SHALL BE PLACED IN LIFTS OF THICKNESS DETERMINED BY THE INDEPENDENT TESTING AGENCY AND COMPACTED TO AT LEAST 95% OF ITS STANDARD PROCTOR MAXIMUM DRY DENSITY IN ACCORDANCE WITH ASTM D698. THE TOP 12" SUB-BASE UNDER SLABS ON GRADE SHALL BE COMPACTED TO AT LEAST 98% OF ITS STANDARD PROCTOR MAXIMUM DRY DENSITY. ALL BACKFILL, COMPACTION AND PROOF ROLLING OPERATIONS SHALL BE OBSERVED BY AN INDEPENDENT TESTING LABORATORY.
8. SLABS-ON-GRADE SHALL BE PLACED ON A 4" GRANULAR BASE, COMPACTED TO 98% OF ITS STANDARD PROCTOR MAXIMUM DRY DENSITY WITH ASTM D698, AND COVERED WITH A 10 MIL CONTINUOUSLY SEALED VAPOR BARRIER. THE BASE FOR SLABS-ON-GRADE SHALL BE INSPECTED BY A GEOTECHNICAL ENGINEER PRIOR TO EACH PLACEMENT OF CONCRETE.
9. FOOTINGS SHALL BE CENTERED ABOUT COLUMN LINES UNLESS NOTED OTHERWISE.
10. ALL FOOTINGS AND TURN DOWN SLAB EDGES SHALL PENETRATE TO A MINIMUM DEPTH OF 1'-4" BELOW FINISHED GRADE.

REINFORCEMENT

1. REINFORCING STEEL SHALL CONFORM TO ASTM A615, GRADE 60, UNLESS NOTED OTHERWISE.
2. WELDED WIRE FABRIC SHALL CONFORM TO ASTM A185 AND HAVE MINIMUM SIDE AND END LAPS OF 8".
3. SUBMIT SHOP DRAWINGS WHICH ADEQUATELY DEPICT THE REINFORCING BAR SIZES AND PLACEMENT. WRITTEN DESCRIPTION OF REINFORCEMENT WITHOUT ADEQUATE SECTIONS, ELEVATIONS, AND DETAILS IS NOT ACCEPTABLE.
4. SPLICES SHALL BE CLASS B IN ACCORDANCE WITH ACI 318, UNLESS NOTED OTHERWISE. REINFORCEMENT SHALL BE SPLICED ONLY AT LOCATIONS SHOWN OR NOTED IN THE STRUCTURAL DOCUMENTS. EXCEPT REINFORCEMENT MARKED "CONTINUOUS" CAN BE SPLICED AT LOCATIONS DETERMINED BY CONTRACTOR. SPLICES AT OTHER LOCATIONS SHALL BE APPROVED IN WRITING BY THE DESIGN PROFESSIONAL.
5. REINFORCING STEEL DESIGNATED CONTINUOUS SHALL BE LAPPED AS FOLLOWS:

• CONCRETE REINFORCEMENT: CLASS B TENSION LAP
6. PLACE REINFORCEMENT AS FOLLOWS, UNLESS NOTED OTHERWISE:

6.1 CONCRETE REINFORCEMENT COVER

EXPOSED TO EARTH OR WEATHER:

• UNFORMED CAST AGAINST EARTH 3" CLEAR
• FORMED #5 AND SMALLER 1-1/2" CLEAR

NOT EXPOSED TO EARTH OR WEATHER:

• SLABS 3/4" CLEAR
7. ADHESIVE FOR REINFORCING DOWELS IN EXISTING CONCRETE SHALL CONFORM TO ASTM C881-02, TYPE IV, GRADE 3, CLASS A, B, & C EXCEPT GEL TIMES AND EPOXY CONTENT. ADHESIVE SHALL CONSIST OF A TWO COMPONENT ADHESIVE SYSTEM CONTAINED IN SIDE BY SIDE PACKAGING CONNECTED TO A MIXING NOZZLE WHICH THOROUGHLY MIXES THE COMPONENTS AS IT IS INJECTED INTO THE HOLE. ADHESIVE SHALL HAVE PASSED ICC EVALUATION SERVICES, INC (ICC-ES) ACCEPTANCE CRITERIA 308 FOR LONG TERM CREEP. REINFORCING INSTALLED IN CONCRETE THAT MAY BECOME CRACKED UNDER SERVICE LOADS SHALL BE EVALUATED BY ICCES ACCEPTANCE CRITERIA 308 AND BE SPECIFICALLY APPROVED FOR USE IN CRACKED CONCRETE. CONTACT DESIGN PROFESSIONAL FOR DETERMINATION OF CRACKED OR UNCRACKED CONCRETE CONDITION UNLESS CONDITION IS NOTED ON THE DRAWINGS. INSTALL IN ACCORDANCE WITH THE MANUFACTURER'S RECOMMENDATIONS. MINIMUM EMBEDMENT LENGTH SHALL BE 12 BAR DIAMETERS, UNLESS NOTED OTHERWISE.

8. ALL DOWELS AND TERMINATING BARS SHALL HAVE A STANDARD 90 DEGREE HOOK.
9. ALL HORIZONTAL REINFORCING SHALL BE CONTINUOUS THROUGH CONTROL AND/OR CONSTRUCTION JOINTS AND AROUND CORNERS.

CAST-IN-PLACE CONCRETE

1. CONCRETE WORK SHALL CONFORM TO ACI 318 AND CRSI STANDARDS.
2. CONCRETE SHALL HAVE THE FOLLOWING MINIMUM SPECIFIED 28-DAY COMPRESSIVE STRENGTH:

2.1 NORMAL WEIGHT STRUCTURAL CONCRETE:

• FOOTINGS 3000 PSI
• SLABS-ON-GRADE 4000 PSI

2.2 LIGHTWEIGHT STRUCTURAL CONCRETE: (110-120 PCF FRESH UNIT WEIGHT/107-116 PCF AIR-DRIED UNIT WEIGHT)

• SLABS ON STEEL DECK 3500 PSI
3. PIPES OR DUCTS SHALL NOT EXCEED ONE-THIRD THE SLAB OR WALL THICKNESS INCLUDING CROSSING UNLESS SPECIFICALLY DETAILED IN THE STRUCTURAL DOCUMENTS. ALL PIPES AND DUCTS SHALL BE PLACED IN THE MIDDLE THIRD OF THE SLAB OR WALL THICKNESS UNLESS SPECIFICALLY DETAILED OTHERWISE IN THE STRUCTURAL DOCUMENTS. SEE MECHANICAL AND ELECTRICAL DRAWINGS FOR LOCATION OF SLEEVES, ACCESSORIES, ETC.
4. REFER TO ARCHITECTURAL DRAWINGS FOR MOLDS, GROOVES, ORNAMENTS, CLIPS OR GROUNDS REQUIRED TO BE ENCASED IN CONCRETE AND FOR LOCATION OF FLOOR FINISHES AND SLAB DEPRESSIONS.
5. CONSTRUCTION JOINT LOCATIONS SHALL BE APPROVED BY THE DESIGN PROFESSIONAL. NO HORIZONTAL CONSTRUCTION JOINTS ARE PERMITTED EXCEPT THOSE SHOWN ON THE STRUCTURAL DRAWINGS.
6. DEFECTIVE AREAS IN CONCRETE INCLUDING, BUT NOT LIMITED TO, HONEY-COMBING, SPALLS, AND CRACKS WITH WIDTHS EXCEEDING 0.016 INCH SHALL BE REPAIRED. EXTENT OF DEFECTIVE AREA TO BE DETERMINED BY THE DESIGN PROFESSIONAL.
7. CONCRETE MIX DESIGN FOR CONCRETE SHALL BE BASED ON A MAXIMUM AGGREGATE SIZE OF 1 IN. MAXIMUM WATER/CEMENT RATIO OF .50 FOR NON-AIR-ENTRAINED CONCRETE AND .45 FOR AIR-ENTRAINED CONCRETE AND A MAXIMUM SLUMP OF 4 IN. AIR ENTRAINED CONCRETE SHALL BE USED FOR EXTERIOR EXPOSED CONCRETE WITH AN AIR CONTENT BETWEEN 3.5 AND 5.5 PERCENT.
8. CONCRETE SLABS ON GRADE SHALL NOT BE LOADED UNTIL A MINIMUM CONCRETE STRENGTH OF 1800 PSI HAS BEEN ATTAINED AND THE CONCRETE IS AT LEAST THREE DAYS OLD. ALL OTHER CONCRETE MEMBERS SHALL NOT BE LOADED UNTIL THE SPECIFIED CONCRETE DESIGN STRENGTH HAS BEEN ATTAINED.
9. CONCRETE SHALL BE TESTED IN ACCORDANCE WITH ACI 301 AND THE SPECIFICATIONS FOR COMPLIANCE WITH THE CONTRACT DOCUMENTS. AT A MINIMUM CONCRETE SPECIMENS SHALL BE TAKEN FOR EVERY 100 YARDS OR PORTION THEREOF FOR EACH MIX DESIGN PLACED IN A DAY. CONCRETE TEST REPORTS SHALL BE AVAILABLE ON SITE FOR INSPECTION.
10. C.J. ON THE SLAB AND FOUNDATION PLAN INDICATES A KEY-FORMED CONSTRUCTION JOINT OR SAW-CUT CONTROL JOINT IN THE CONCRETE SLAB ON GRADE. SAW-CUT CONTROL JOINTS SHALL BE INSTALLED WITHIN 12 HOURS OF SLAB PLACEMENT. CONTINUE REINFORCEMENT THROUGH JOINTS. CONSTRUCTION AND/OR CONTROL JOINTS SHALL BE SPACED NO FARTHER APART THAN 48 TIMES THE SLAB THICKNESS OC IN EACH DIRECTION CREATING PANELS WITH AN ASPECT RATIO NOT GREATER THAN 2:1.
11. UNLESS NOTED OTHERWISE, ALL REINFORCING SHALL BE CONTACT LAP SPLICED WITH A CLASS B SPLICE IN ACCORDANCE WITH ACI 318-05. FOR BARS WITH MINIMUM COVER AND SPACING GREATER THAN 2DB AND 3DB RESPECTIVELY, THE MINIMUM SPLICE LENGTH OF NOT LESS THAN 48DB (DB=BAR DIAMETER) SHALL BE USED. SPLICE LENGTHS SHALL BE INCREASED BY A FACTOR OF 1.3 FOR TOP REINFORCEMENT. LAP WELDED WIRE FABRIC (WWF) ONE SPACE PLUS 2 IN. ON ALL SIDES AT SPLICES.
12. ALL EXPOSED CORNERS OF CONCRETE SHALL HAVE A CHAMFER OR RADIUS OF 3/4", UNLESS NOTED OTHERWISE.
13. CONCRETE SHALL RECEIVE THE FOLLOWING FINISHES:

• INTERIOR EXPOSED SLABS (UNO OR REQUESTED BY THE OWNER): STEEL TROWEL FINISH

• FLOOR QUALITY CLASSIFICATION:

"CONVENTIONAL" FF/FL = 25/20 (CARPETED OFFICE)
"FLAT" FF/FL = 38/20 (THIN-SET CTOR VCT)

• EXTERIOR SLABS: BROOM FINISH IN DIRECTION OF SLOPE

• ALL OTHER CONCRETE: STEEL TROWEL FINISH
14. MAINTAIN CONCRETE AFTER PLACEMENT WITH MINIMAL MOISTURE LOSS AT RELATIVELY CONSTANT TEMPERATURE FOR THE PERIOD NECESSARY FOR HYDRATION OF CEMENT AND HARDENING OF CONCRETE (NOT LESS THAN 7 DAYS). COMPLY WITH THE REQUIREMENTS OF ACI 308- STANDARD PRACTICE FOR CURING CONCRETE; AMERICAN CONCRETE INSTITUTE. A COMBINATION CURING AND SEALING COMPOUND SHALL BE APPLIED AFTER THE CONCRETE HAS BEEN FINISHED OR THE FORMS REMOVED. COMPOUND SHALL MEET THE REQUIREMENTS OF ASTM C1315.

STRUCTURAL STEEL

1. STRUCTURAL STEEL SHALL CONFORM TO ASTM A992, UNLESS NOTED OTHERWISE.

• STRUCTURAL STEEL TUBING SHALL CONFORM TO ASTM A500, GRADE B.
• STRUCTURAL STEEL PIPE SHALL CONFORM TO ASTM A53, GRADE B.
• STRUCTURAL CHANNELS, MISCELLANEOUS PLATES AND CONNECTION MATERIAL SHALL CONFORM TO ASTM A36, UNLESS NOTED OTHERWISE.
2. BOLTS AND ANCHORS:

2.1 BOLTED CONNECTIONS SHALL BE TYPE N (BEARING TYPE WITH THREADS INCLUDED IN SHEAR PLANE) WITH MINIMUM 3/4" DIAMETER (UNO) A325 BOLTS. SUBMIT PROPOSED BOLT TIGHTENING PROCEDURE FOR REVIEW.

2.2 ANCHOR BOLTS SHALL BE HEADED BOLTS CONFORMING TO ASTM F1554 AND SHALL BE HEADED RODS OR THREADED RODS WITH HEAVY HEXAGONAL NUT WELDED TO THE BOTTOM OF THE THREADED ROD, GRADE A36, UNLESS NOTED OTHERWISE.

2.3 EXPANSION ANCHORS SHALL HAVE BEEN EVALUATED BY THE ICC EVALUATION SERVICES, INC (ICC-ES) WITH A PUBLISHED EVALUATION REPORT. ANCHORS INSTALLED IN CONCRETE THAT MAY BECOME CRACKED UNDER SERVICE LOADS SHALL BE EVALUATED BY ICC-ES ACCEPTANCE CRITERIA 193 AND BE SPECIFICALLY APPROVED FOR USE IN CRACKED CONCRETE. CONTACT DESIGN PROFESSIONAL FOR DETERMINATION OF CRACKED OR UNCRACKED CONCRETE CONDITION UNLESS CONDITION IS NOTED ON THE DRAWINGS. ALL ANCHORS SHALL BE APPROVED FOR RESISTING WIND AND SEISMIC LOADS. INSTALL IN ACCORDANCE WITH THE MANUFACTURER'S RECOMMENDATIONS. MINIMUM EMBEDMENT SHALL BE EQUAL TO 4.5 TIMES THE ANCHOR DIAMETER, UNLESS NOTED OTHERWISE.

2.4 ADHESIVE ANCHORS SHALL CONSIST OF AN ALL-THREAD STEEL ANCHOR WITH ADHESIVE CONFORMING TO ASTM C881-02, TYPE IV, GRADE 3, CLASS A, B, & C EXCEPT GEL TIMES AND EPOXY CONTENT. ADHESIVE SHALL CONSIST OF A TWO COMPONENT ADHESIVE SYSTEM CONTAINED IN SIDE BY SIDE PACKAGING CONNECTED TO A MIXING NOZZLE WHICH THOROUGHLY MIXES THE COMPONENTS

AS IT IS INJECTED INTO THE HOLE. ADHESIVE SHALL HAVE PASSED ICC EVALUATION SERVICES, INC (ICC-ES) ACCEPTANCE CRITERIA 308 FOR LONG TERM CREEP. ANCHORS INSTALLED IN CONCRETE THAT MAY BECOME CRACKED UNDER SERVICE LOADS SHALL BE EVALUATED BY ICC-ES ACCEPTANCE CRITERIA 308 AND BE SPECIFICALLY APPROVED FOR USE IN CRACKED CONCRETE. CONTACT DESIGN PROFESSIONAL FOR DETERMINATION OF CRACKED OR UNCRACKED CONCRETE CONDITION UNLESS CONDITION IS NOTED ON THE DRAWINGS. INSTALL IN ACCORDANCE WITH THE MANUFACTURER'S RECOMMENDATIONS. MINIMUM EMBEDMENT SHALL BE EQUAL TO 4.5 TIMES THE ANCHOR DIAMETER, UNLESS NOTED OTHERWISE.

3. STRUCTURAL STEEL SHALL BE FABRICATED AND ERECTED ACCORDING TO BOTH THE AISC "SPECIFICATION FOR STRUCTURAL STEEL BUILDINGS" AND THE AISC "CODE OF STANDARD PRACTICE FOR STEEL BUILDINGS AND BRIDGES".
4. SUBMIT SHOP DRAWINGS WHICH ADEQUATELY DEPICT THE STRUCTURAL ELEMENTS AND CONNECTIONS SHOWN IN THE CONTRACT DOCUMENTS. CONNECTIONS SHALL BE DETAILED BASED ON THE DESIGN INFORMATION PROVIDED IN THE CONTRACT DOCUMENTS. CONNECTIONS SHALL BE DESIGNED FOR THE SERVICE LOAD REACTION VALUES SHOWN ON THE STRUCTURAL DRAWINGS. FOR STEEL MEMBERS WHOSE REACTIONS ARE NOT SHOWN, THE DESIGN REACTION SHALL BE OBTAINED FROM THE TABLES ENTITLED "MAXIMUM TOTAL UNIFORM LOAD" IN PART 3 OF THE AISC "MANUAL OF STEEL CONSTRUCTION", FOURTEENTH (14TH) EDITION. THE DESIGN REACTION IS EQUAL TO HALF THE TABULATED VALUE FOR NONCOMPOSITE BEAMS. DEVIATION FROM THE CONNECTION DETAILS DEPICTED IN THE CONTRACT DOCUMENTS SHALL NOT BE PERMITTED WITHOUT WRITTEN PERMISSION FROM THE DESIGN PROFESSIONAL. REVIEW DOES NOT RELIEVE THE CONTRACTOR OF THE FULL RESPONSIBILITY FOR THE DESIGN AND ADEQUACY OF SUCH CONNECTIONS. DESIGN PROFESSIONAL SHALL BE COMPENSATED BY THE CONTRACTOR FOR THE COST INVOLVED IN THE REVIEW OF CONNECTIONS FOR THE CONVENIENCE OF THE CONTRACTOR. SINGLE ANGLE CONNECTIONS ARE NOT ACCEPTABLE.

CONNECTIONS SHALL BE DESIGNED FOR THE SERVICE LOAD REACTION OF 10 KIPS UNLESS SHOWN OTHERWISE ON THE STRUCTURAL DRAWINGS.

5. USE PRE-QUALIFIED WELDED JOINTS IN ACCORDANCE WITH AISC AND THE STRUCTURAL WELDING CODE OF THE AMERICAN WELDING SOCIETY. "NON-PRE-QUALIFIED JOINTS" SHALL BE QUALIFIED PRIOR TO FABRICATION.
6. STRUCTURAL STEEL EXPOSED TO WEATHER AND EXTERIOR LINTELS SHALL BE HOT-DIPPED GALVANIZED.

STEEL JOISTS

1. STEEL JOISTS, BRIDGING, AND THEIR CONNECTIONS SHALL BE DESIGNED, FABRICATED, AND ERECTED ACCORDING TO THE SPECIFICATIONS OF THE STEEL JOIST INSTITUTE (SJI).
2. STEEL ROOF JOISTS AND BRIDGING SHALL BE DESIGNED FOR A NET UNIFORM UPLIFT LOAD OF 22 PSF (ALLOWABLE).
3. DESIGN OF STEEL JOISTS, BRIDGING, AND THEIR CONNECTIONS SHALL BE THE SOLE RESPONSIBILITY OF THE CONTRACTOR. SUBMIT SHOP DRAWINGS SEALED BY AN ENGINEER LICENSED IN THE PROJECT STATE. REVIEW OF SHOP DRAWINGS SHALL BE FOR CONFORMANCE WITH THE CONTRACT DOCUMENTS REGARDING ARRANGEMENT AND SIZES OF MEMBERS AND THE CONTRACTOR'S INTERPRETATION OF THE DESIGN LOADS AND CONTRACT DOCUMENT DETAILS. SUCH REVIEW SHALL NOT RELIEVE THE CONTRACTOR OF FULL RESPONSIBILITY FOR THE DESIGN OF THE STEEL JOISTS, BRIDGING AND THEIR CONNECTIONS.
4. CONTRACTOR SHALL COORDINATE THE CONSTRUCTION AND ERECTION OF WALLS, BEAM FRAMING, METAL DECKING, ETC. TO ENSURE COMPATIBILITY OF ROOF AND WALL SYSTEMS CONSIDERING PITCH AND CAMBER OF STEEL JOISTS.

METAL DECK

1. DECK DESIGN IS BASED ON THE STEEL DECK INSTITUTE DESIGN MANUAL FOR COMPOSITE DECKS, FORM DECKS AND ROOF DECKS.
2. PROVIDE ROOF DECK WITH THE FOLLOWING MINIMUM PROPERTIES:

• 1.5 INCH DEPTH
• 20 GAGE THICKNESS
• 0.224 IN³/FT SECTION MODULUS
• 0.197 IN⁴/FT² MOMENT OF INERTIA
• 33,000 PSI YIELD STRESS
3. PROVIDE FORM DECK WITH THE FOLLOWING MINIMUM PROPERTIES:

• 1.5 INCH DEPTH
• 18 GAGE THICKNESS
• 0.306 IN³/FT SECTION MODULUS
• 0.277 IN⁴/FT² MOMENT OF INERTIA
• 33,000 PSI YIELD STRESS
4. DECK IS SPECIFIED BASED ON A THREE SPAN CONDITION. FURNISH HEAVIER GAGE DECK IF REQUIRED FOR ONE OR TWO SPAN CONDITIONS.
5. FASTEN ROOF DECK TO RESIST A NET UPLIFT OF 22 PSF OR AS INDICATED ON THE DRAWINGS.
6. FASTEN DECK TO RESIST A DIAPHRAGM SHEAR FORCE OF 240 POUNDS PER LINEAR FOOT.

ENGINEER:

FORESITE
group

ForeSITE Group, Inc.
3740 Davinci Ct.
Suite 100
Peachtree Corners, GA 30092

w | www.fg-inc.net
o | 770.368.1399
f | 770.368.1944

DEVELOPER:

C-D-C-I

CONTRACT DESIGN CONCEPTS, INCORPORATED
COMMERCIAL DESIGN AND PLANNING SERVICES

3665 SWIFTWATER PARKWAY
SUITE 307
SUWANEE, GA 30024

7 TEQUILAS MEXICAN RESTAURANT
NEW CONSTRUCTION

5586 OLD HIGHWAY 5 WOODSTOCK, GA 30188

PROJECT:

SEAL:

PRELIMINARY - NOT FOR CONSTRUCTION

REVISIONS	DATE
<div>Δ G.C.SHOP DWG. COORD. 1</div>	02/04/2022

PROJECT MANAGER:	JMW
DRAWING BY:	BJJ
JURISDICTION:	
DATE:	01/29/2019
SCALE:	AS SHOWN
TITLE:	

GENERAL NOTES

SHEET NUMBER:

S001

COMMENTS:

JOB/FILE NUMBER:

1133.006

ENGINEER:

FORESITE

group

Foresite Group, Inc.

3740 Davinci Ct.

Suite 100

Peachtree Corners, GA 30092

w |

www.fg-inc.net

o |

770.368.1399

f |

770.368.1944

DEVELOPER:

C · D · C · I

CONTRACT DESIGN CONCEPTS, INCORPORATED

COMMERCIAL DESIGN AND PLANNING SERVICES

3665 SWIFTWATER PARKWAY

SUITE 307

SUWANEE, GA 30024

PROJECT:

7 TEQUILAS MEXICAN RESTAURANT

NEW CONSTRUCTION

5586 OLD HIGHWAY 5 WOODSTOCK, GA 30188

SEAL:

PRELIMINARY - NOT FOR CONSTRUCTION

REVISIONS	DATE
<div><div>▲</div><div>G.C. SHOP DWG. COORD. 1</div></div>	02/04/2022

PROJECT MANAGER:	JMW
DRAWING BY:	BJJ
JURISDICTION:	
DATE:	01/29/2019
SCALE:	AS SHOWN
TITLE:	

GENERAL NOTES


SHEET NUMBER:

S002

COMMENTS:

JOB/FILE NUMBER:


1133.006

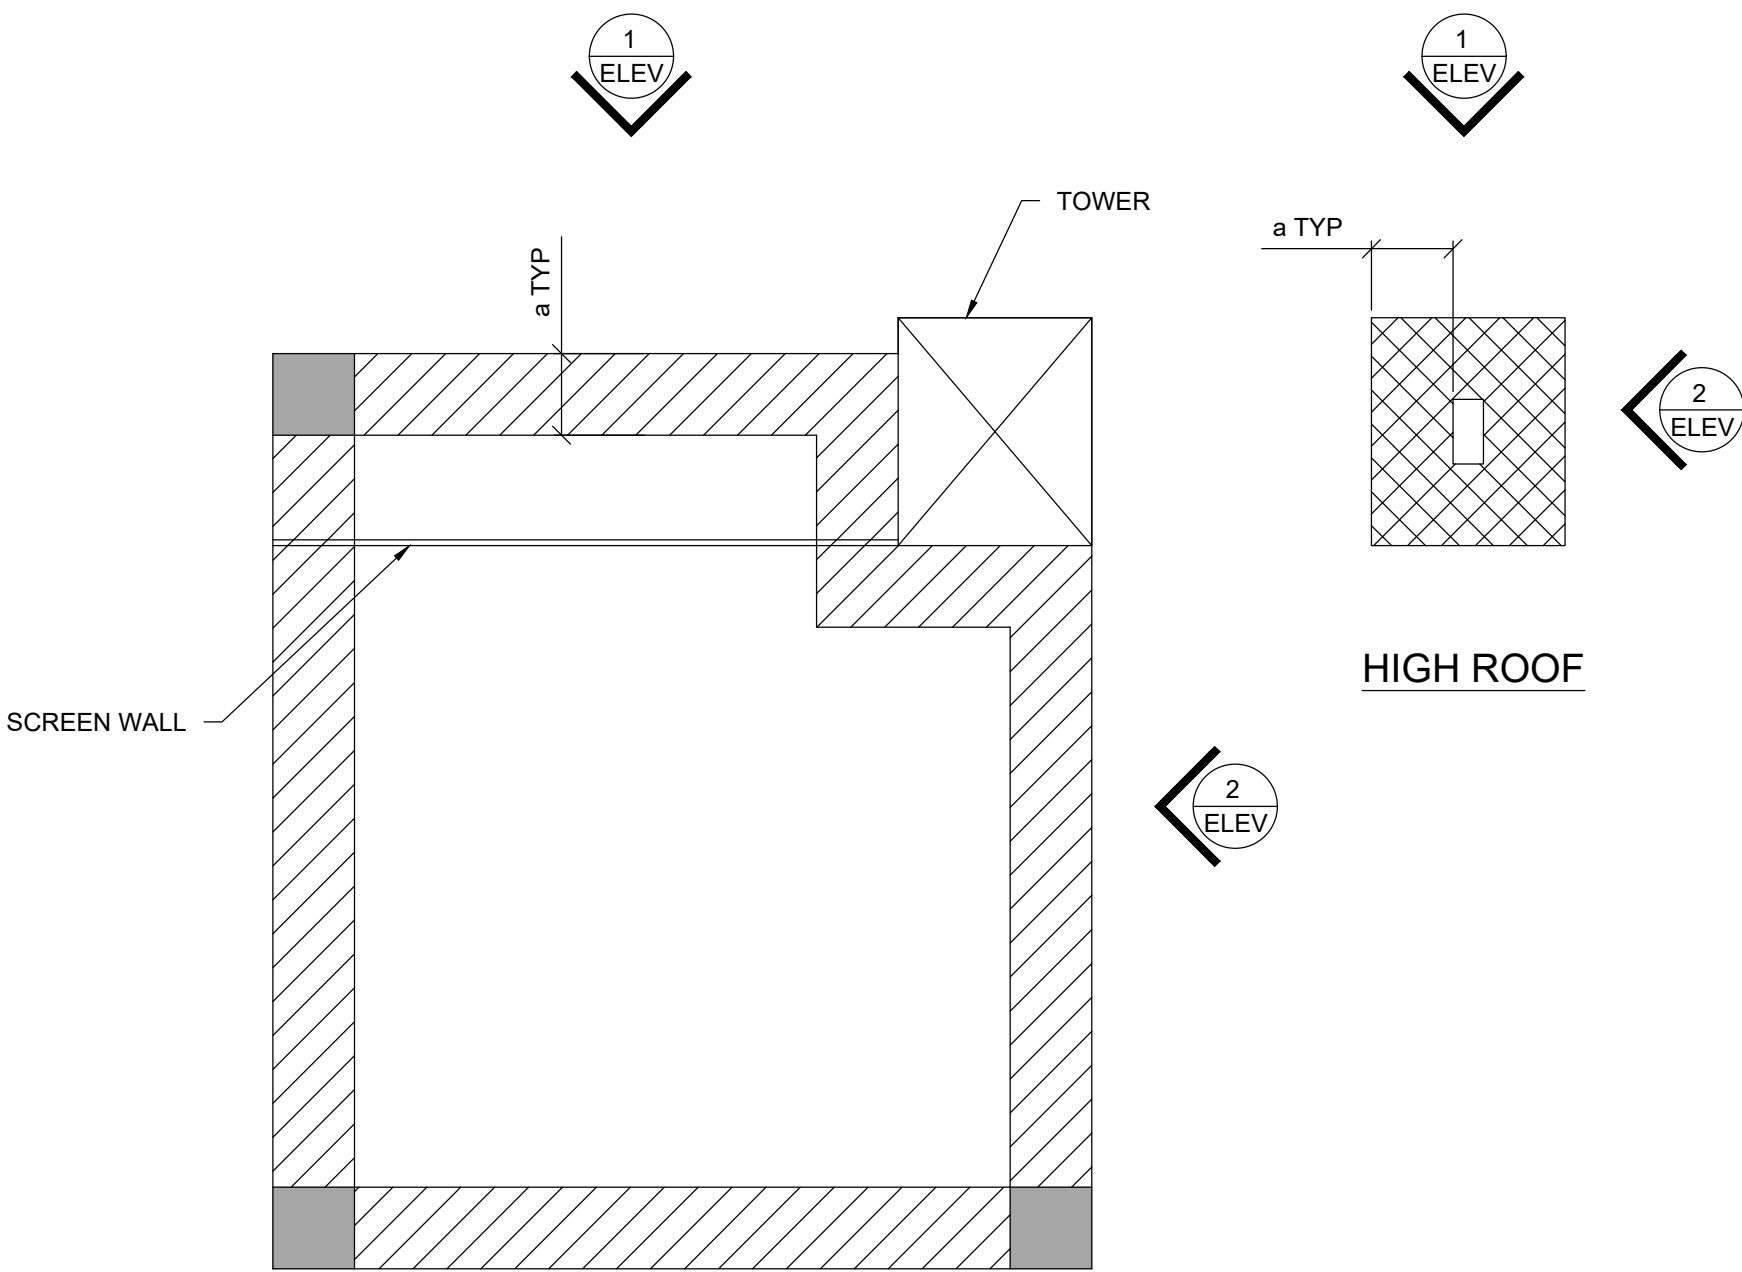


ROOF AND HIGH ROOF PLAN
COMPONENTS AND CLADDING
ULTIMATE WIND PRESSURE DIAGRAM

<div><div></div><div>= -31 PSF/+16 PSF</div></div>	<div><div></div><div>= -50 PSF/+16 PSF</div></div>
<div><div></div><div>= -37 PSF/+16 PSF</div></div>	<div><div>a</div><div>= 6' - 10"</div></div>
<div><div></div><div>= -44 PSF/+16 PSF</div></div>	

NOTE: WIND PRESSURE BASED ON 50 SQUARE FOOT AREA.
NEGATIVE INDICATES PRESSURE AWAY FROM SURFACE

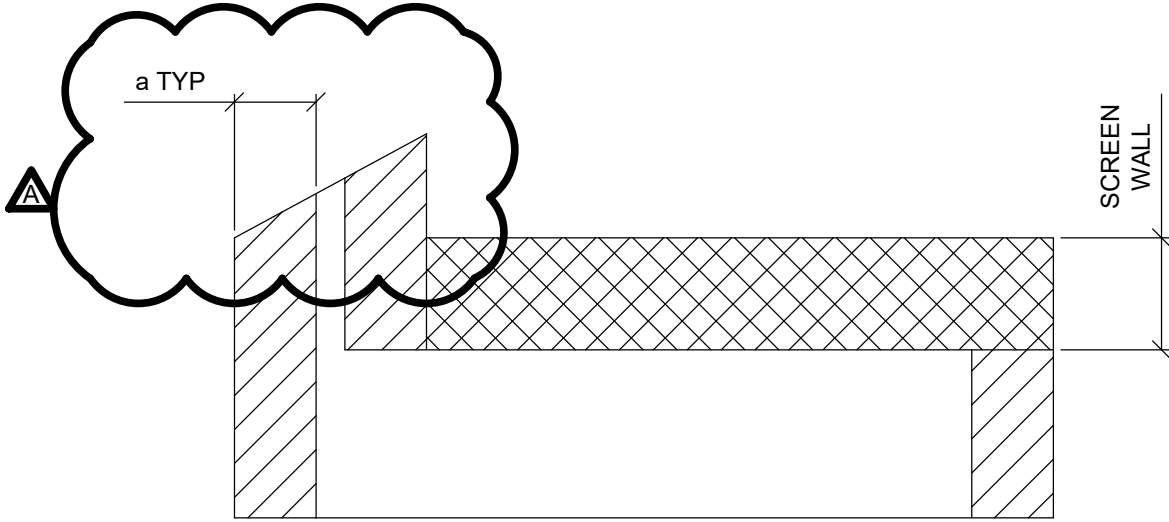

ELEVATION 1

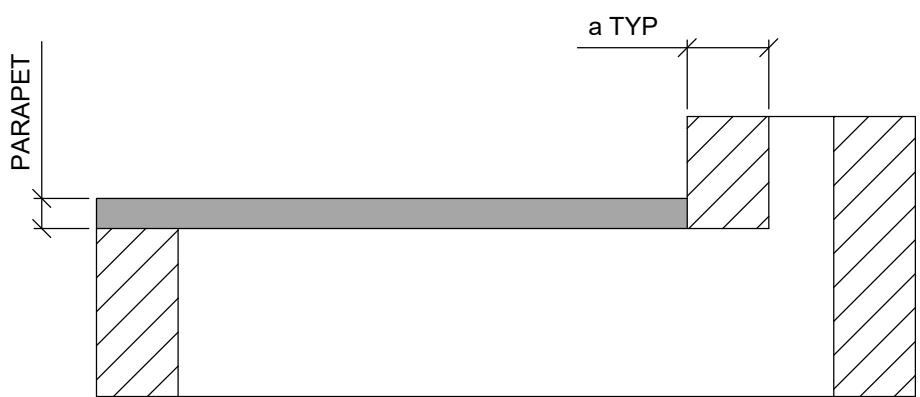


ELEVATION 2

WALL ELEVATION COMPONENTS AND CLADDING
ULTIMATE WIND PRESSURE DIAGRAM

<div><div></div><div>= -30 PSF/+27 PSF</div></div>	<div><div></div><div>= -40 PSF/+27 PSF</div></div>
<div><div></div><div>= -34 PSF/+27 PSF</div></div>	<div><div>a</div><div>= 6' - 10"</div></div>
<div><div></div><div>= -46 PSF/+60 PSF</div></div>	

NOTE: WIND PRESSURE BASED ON 50 SQUARE FOOT AREA.
NEGATIVE INDICATES PRESSURE AWAY FROM SURFACE

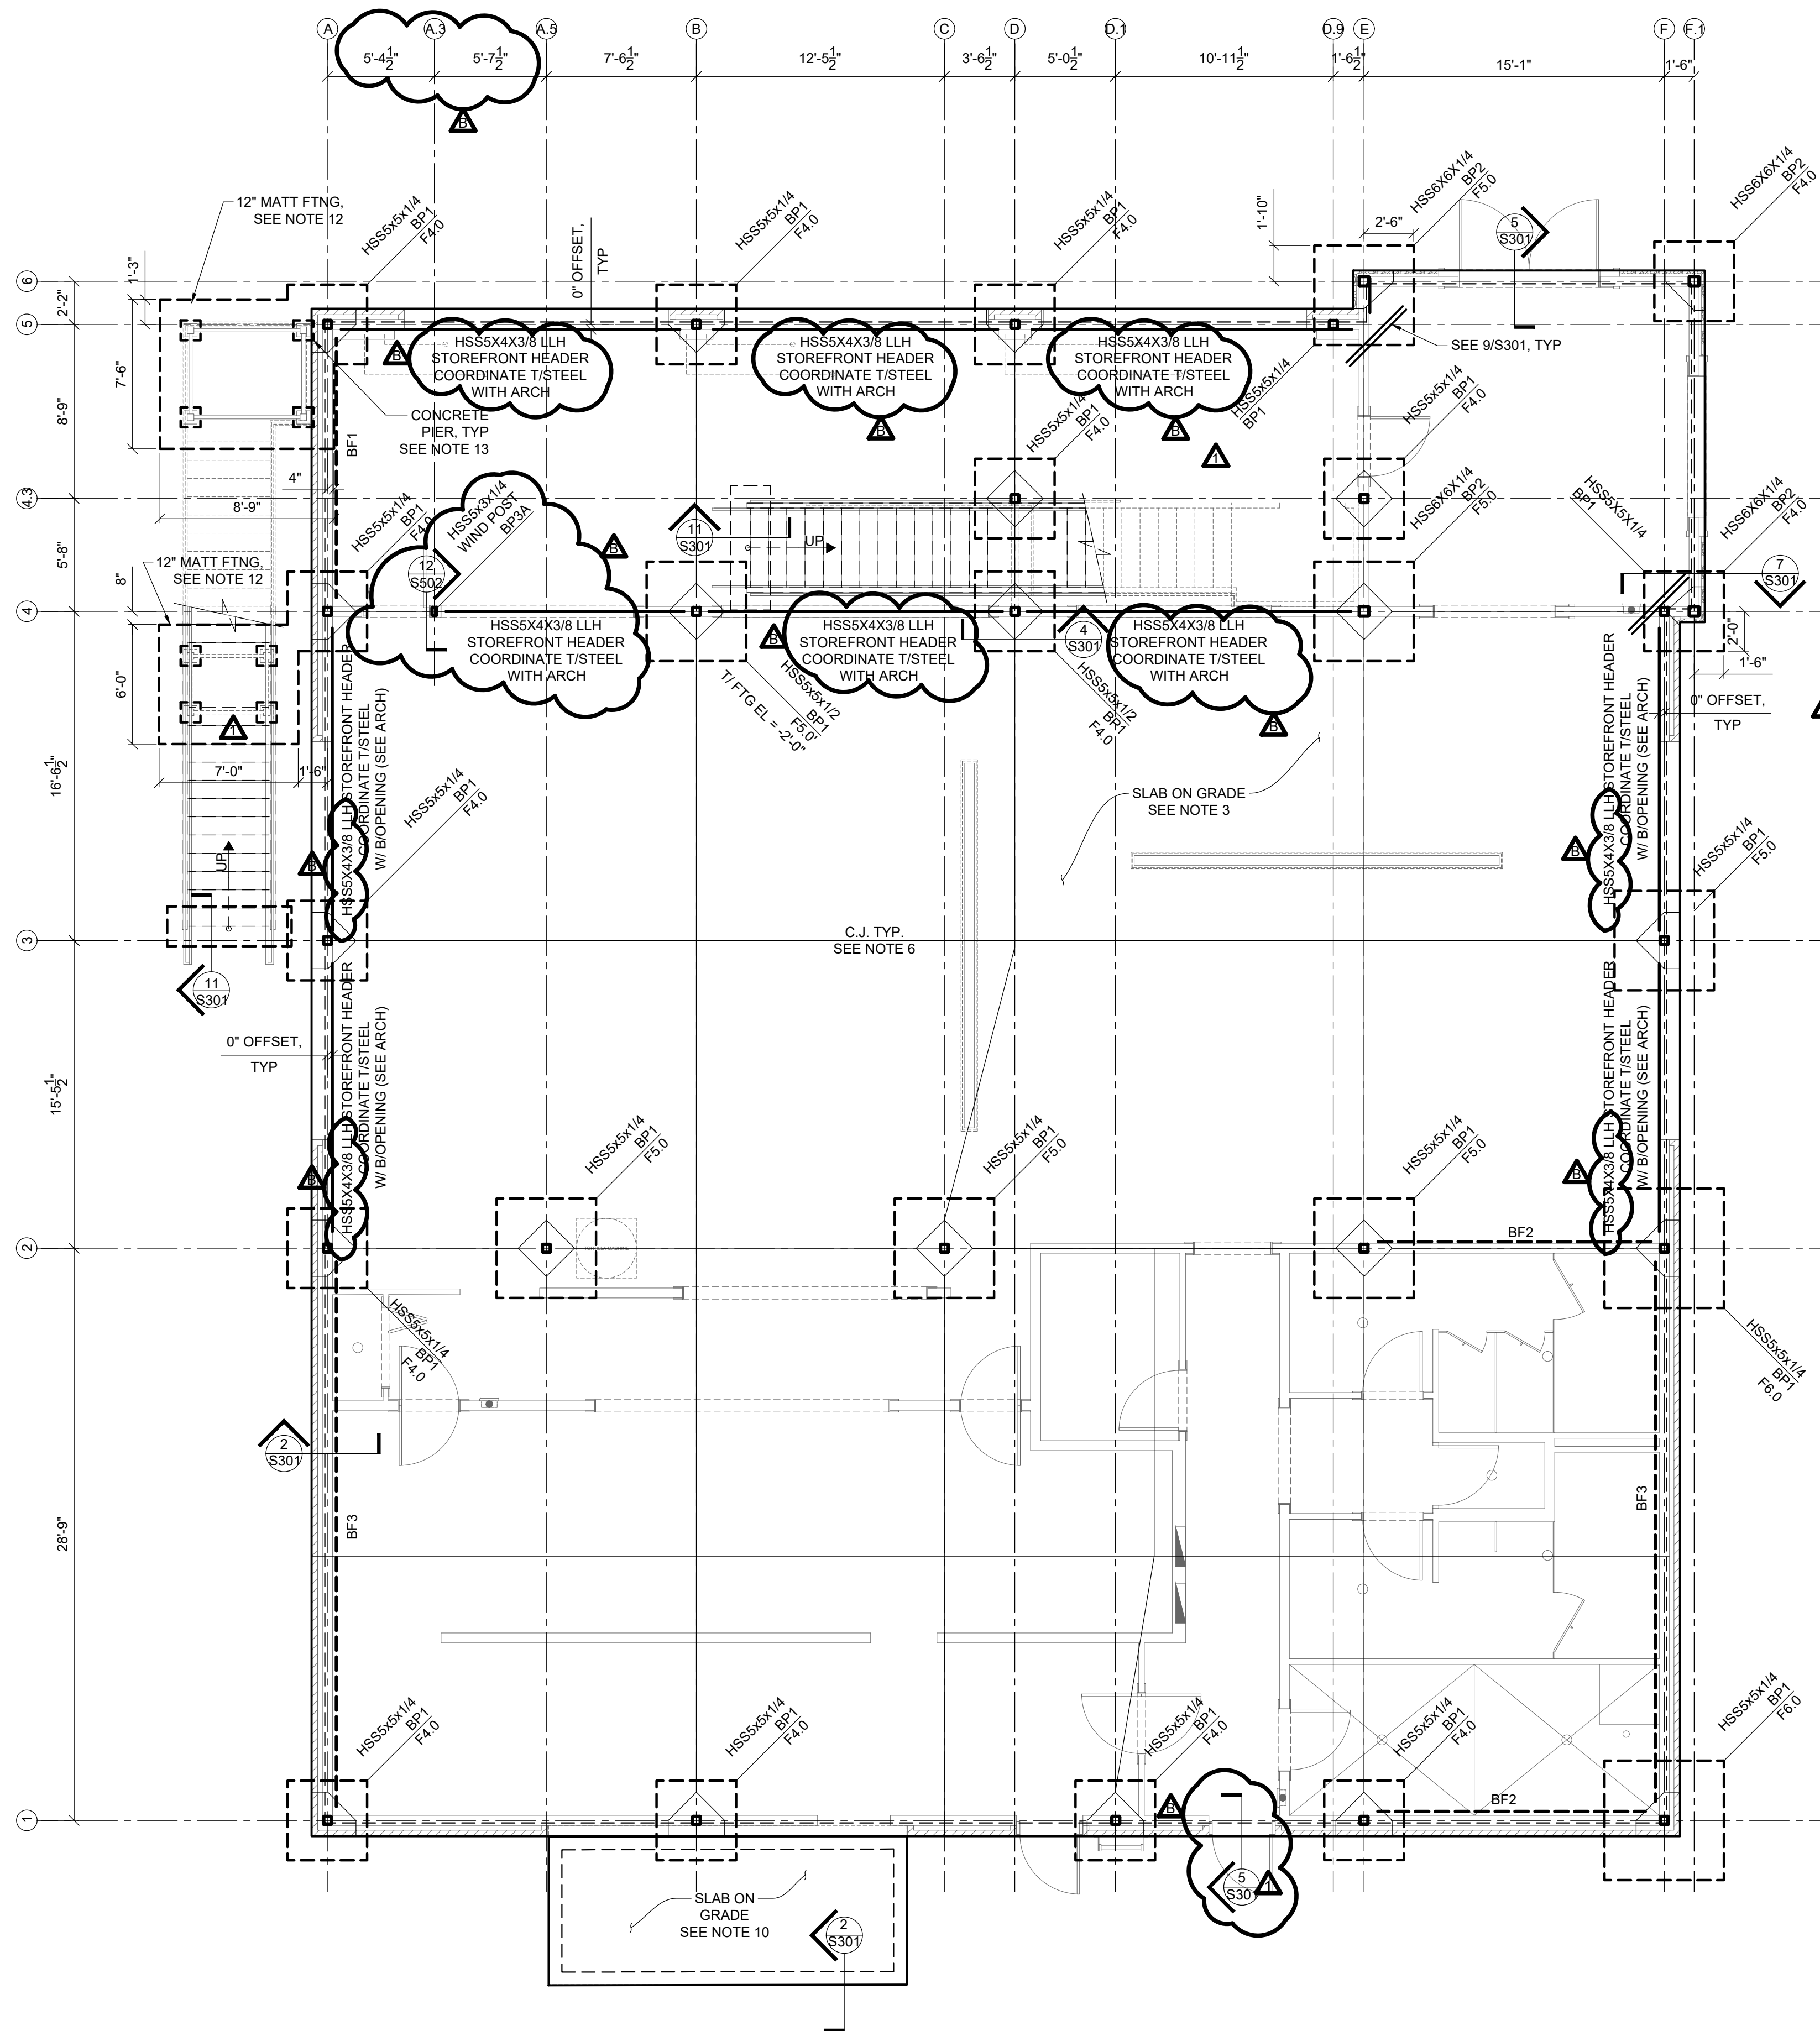

1 FOUNDATION PLAN
3/16" = 1'-0"

- NOTES:
- SEE S001 FOR STRUCTURAL GENERAL NOTES.
 - SEE ARCH DRAWINGS FOR ADDITIONAL INFORMATION AND DIMENSIONS.
 - PROVIDE A 4" SLAB ON GRADE REINFORCED WITH WWF 6x6 W1.4xW1.4 ON VAPOR BARRIER AND 4" GRANULAR BASE.
 - BPX INDICATES COLUMN BASE PLATE, SEE 1/S501.
 - FX INDICATES CONCRETE FOOTING. SEE 1/S301. TOP OF FOOTING SHALL BE -1'-4" BASED ON T/SLAB REFERENCE ELEVATION = 0'-0", UNO.
 - C.J. INDICATES SLAB CONTROL JOINT, SEE 3/S301 AND GENERAL NOTES FOR ADDITIONAL INFORMATION.
 - PROVIDE ISOLATION JOINT AT COLUMNS, SEE 6/S301.
 - BFX INDICATES BRACED FRAME. SEE S503.
 - CONTRACTOR SHALL BE RESPONSIBLE FOR COORDINATION OF ALL UTILITY AND PLUMBING LINES, SEE 10/S301.
 - PROVIDE AN 8" SLAB ON GRADE REINFORCED WITH #4@12" EW ON 4" GRANULAR BASE. T/SLAB EL = -0'-4", VERIFY W/ KITCHEN EQUIPMENT SUPPLIER.
 - SEE DETAIL 4/S504 FOR BRICK LOOSE LINTEL SCHEDULE.
 - 12" DEEP MATT FOOTING, PROVIDE #5@12" O.C. EW BOTTOM. TOP OF FOOTING SHALL BE -1'-4" BASED ON T/SLAB REFERENCE ELEVATION = 0'-0", UNO.
 - 12" x 12" MIN. REINFORCED CONCRETE PIER, SEE 8/S301. LOCATION ON BY STAIRCASE SUPPLIER.

ENGINEER:
FORESITE
group
Foresite Group, Inc.
3740 Davinci Ct.
Suite 100
Peachtree Corners, GA 30092
www.fg-inc.net
770.368.1399
770.368.1944

DEVELOPER:
CDCI
CONTRACT DESIGN CONCEPTS, INCORPORATED
COMMERCIAL DESIGN AND PLANNING SERVICES
3685 SWIFTWATER PARKWAY
SUITE 307
SUWANEE, GA 30024


PROJECT:
7 TEQUILAS MEXICAN RESTAURANT
NEW CONSTRUCTION
5586 OLD HIGHWAY 5 WOODSTOCK, GA 30188

SEAL:
PRELIMINARY - NOT FOR CONSTRUCTION

REVISIONS	DATE
ARCHITECTURAL REVISION	05/21/2021
G.C. SHOP DWG. COORD. 1	02/04/2022
G.C. SHOP DWG. COORD. 2	03/15/2022

PROJECT MANAGER: JMW
DRAWING BY: BJJ
JURISDICTION:
DATE: 01/29/2019
SCALE: AS SHOWN
TITLE:

FOUNDATION PLAN
SHEET NUMBER: **S101**
COMMENTS:
JOB/FILE NUMBER: 1133.006

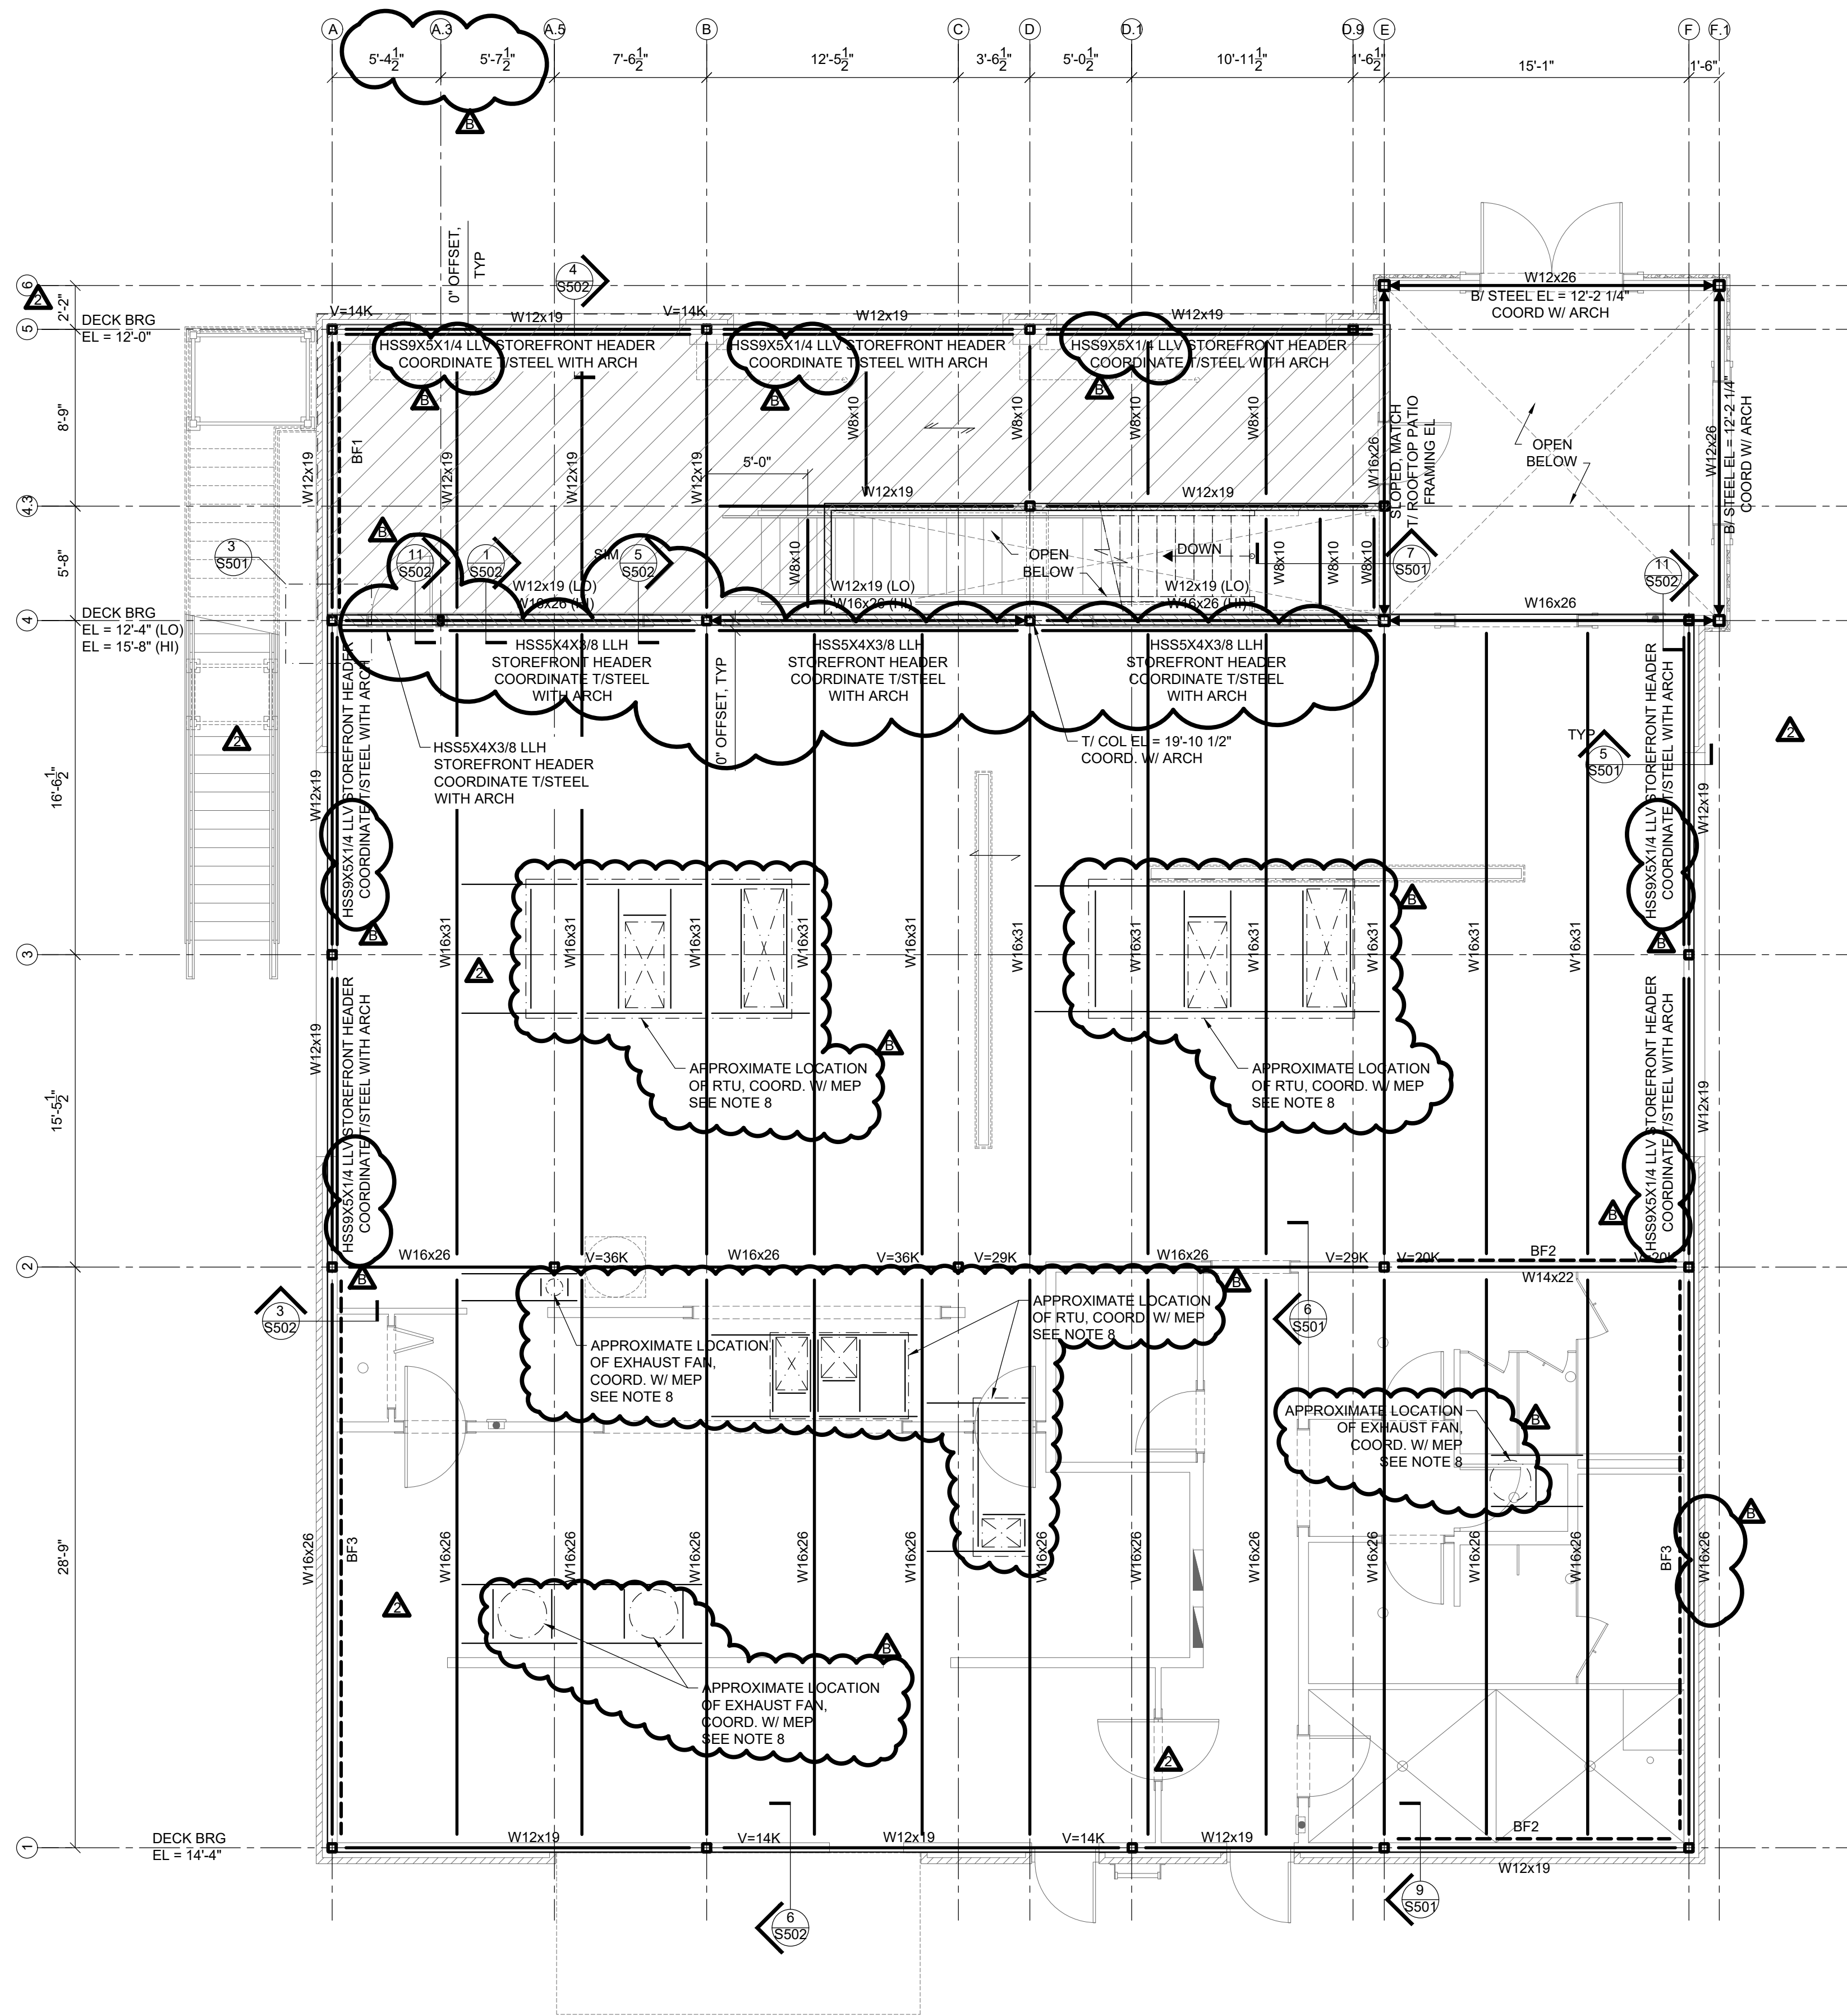

2
S102 ROOF FRAMING PLAN
3/16" = 1'-0"

- NOTES:
1. SEE S001 FOR STRUCTURAL GENERAL NOTES.
 2. SEE ARCH DRAWINGS FOR ADDITIONAL INFORMATION AND DIMENSIONS.
 3. INDICATES DIRECTIONAL SPAN OF 1 1/2' 20 GA GALVANIZED ROOF DECK. SEE 9/S502. SEE PLAN FOR DECK BEARING ELEVATIONS.
 4. & BFX INDICATES BRACED FRAME. SEE S503.
 5. INDICATES MOMENT CONNECTION. SEE S503.
 6. $V=x$ INDICATES MAXIMUM ALLOWABLE SHEAR IN KIPS. UNO. MINIMUM ALLOWABLE SHEAR SHALL BE 10 KIPS.
 7. INDICATES DIRECTIONAL SPAN OF 1 1/2' 18 GA NONCOMPOSITE DECK WITH 2 1/2" CONCRETE REINFORCED WITH WWF6x6-W1.4xW1.4 (4" TOTAL DEPTH) SEE 9/S502 SIM. SEE PLAN FOR DECK BEARING ELEVATIONS.
 8. COORDINATE LOCATION OF ROOF TOP MECHANICAL EQUIPMENT. COORDINATE WITH MECH DRAWINGS. SEE 11&12/S501 FOR FRAME AND OPENING SUPPORT.
 9. INDICATES AREA WITH LEVELING PAVERS. SEE ARCHITECTURAL.
 10. INDICATES PARTITION WALL WITH 600 S200-43 STUDS @ 24" OC IN 600 T200-43 TOP AND BOTTOM TRACKS W/ 5/8" PLYWOOD SHEATHING BOTH SIDES.
 11. INDICATES PARTITION WALL WITH 362 S200-43 STUDS @ 24" OC IN 362 T200-43 TOP AND BOTTOM TRACKS W/ 5/8" PLYWOOD SHEATHING BOTH SIDES.


ENGINEER:

FORESITE
group

Foresite Group, Inc.
3740 Davinci Ct.
Suite 100
Peachtree Corners, GA 30092

w | www.fg-inc.net
o | 770.368.1399
f | 770.368.1944

DEVELOPER:

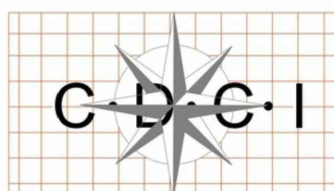

CONTRACT DESIGN CONCEPTS, INCORPORATED
COMMERCIAL DESIGN AND PLANNING SERVICES

3665 SWIFTWATER PARKWAY
SUITE 307
SUWANEE, GA 30024

PROJECT:

7 TEQUILAS MEXICAN RESTAURANT
NEW CONSTRUCTION

5586 OLD HIGHWAY 5 WOODSTOCK, GA 30188

SEAL:

PRELIMINARY - NOT FOR CONSTRUCTION

REVISIONS	DATE
RTU RELOCATION	07/22/2019
ARCHITECTURAL REVISION	05/21/2021
G.C. SHOP DWG. COORD. 1	02/04/2022
G.C. SHOP DWG. COORD. 2	03/15/2022

PROJECT MANAGER:	JMW
DRAWING BY:	BJJ
JURISDICTION:	
DATE:	01/29/2019
SCALE:	AS SHOWN
TITLE:	

ROOF FRAMING PLAN


SHEET NUMBER:

S102

COMMENTS:


JOB/FILE NUMBER:

1133.006

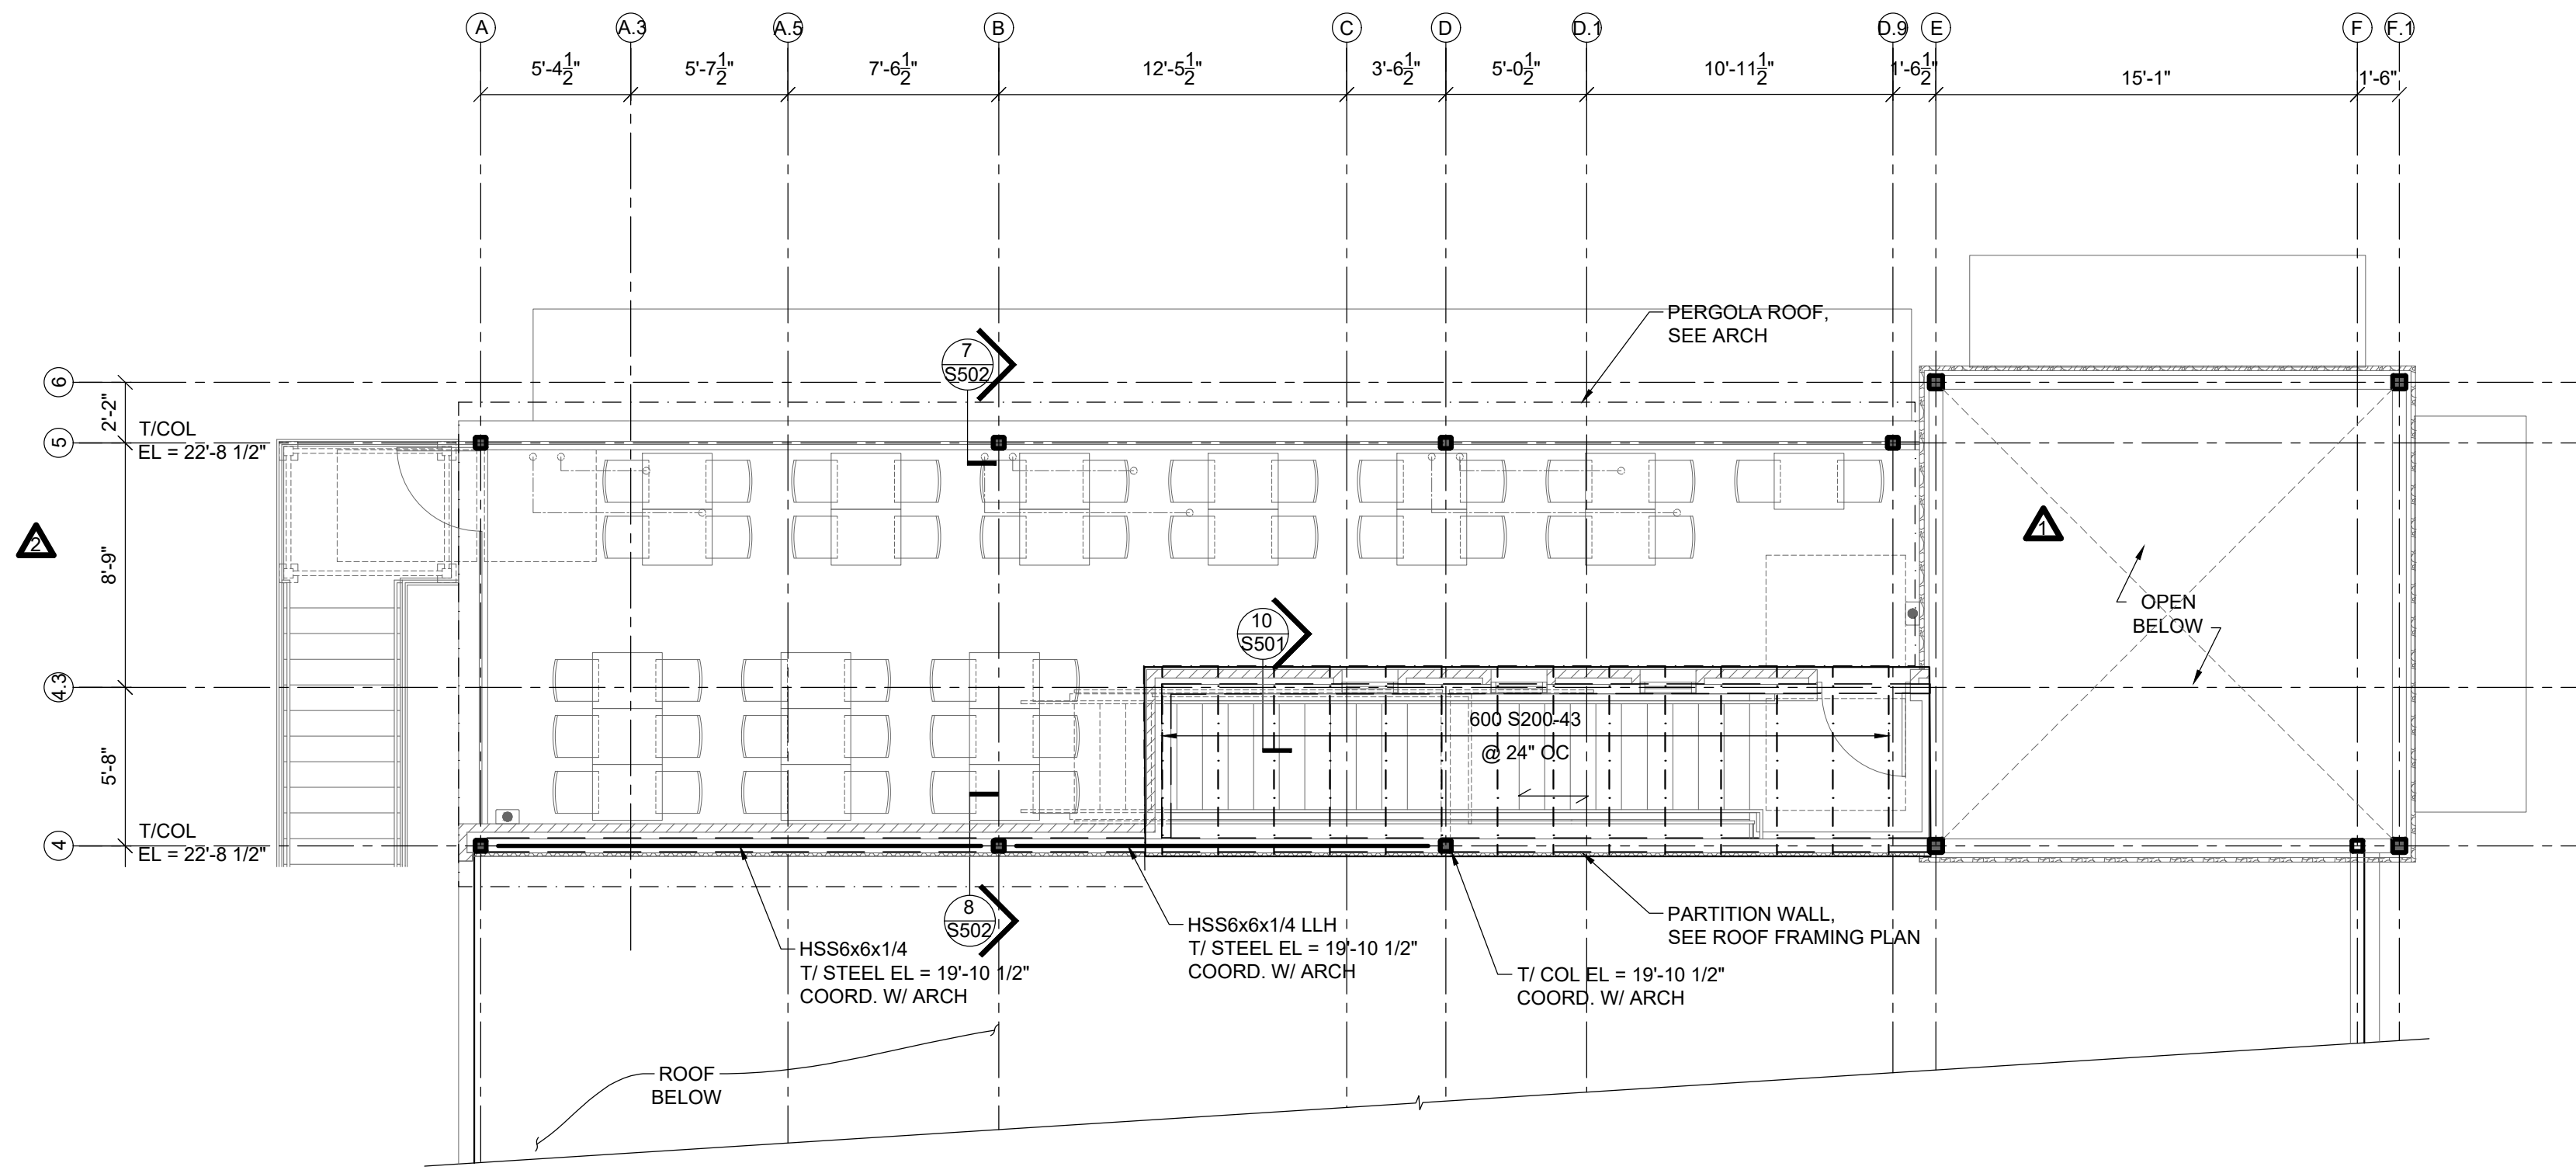

1 HIGH ROOF FRAMING PLAN
3/16" = 1'-0"

- NOTES:
- SEE S001 FOR STRUCTURAL GENERAL NOTES.
 - SEE ARCH DRAWINGS FOR ADDITIONAL INFORMATION AND DIMENSIONS.
 - INDICATES DIRECTIONAL SPAN OF 1 1/2" 20 GA GALVANIZED ROOF DECK, SEE 9/S502. SEE PLAN FOR DECK BEARING ELEVATIONS.

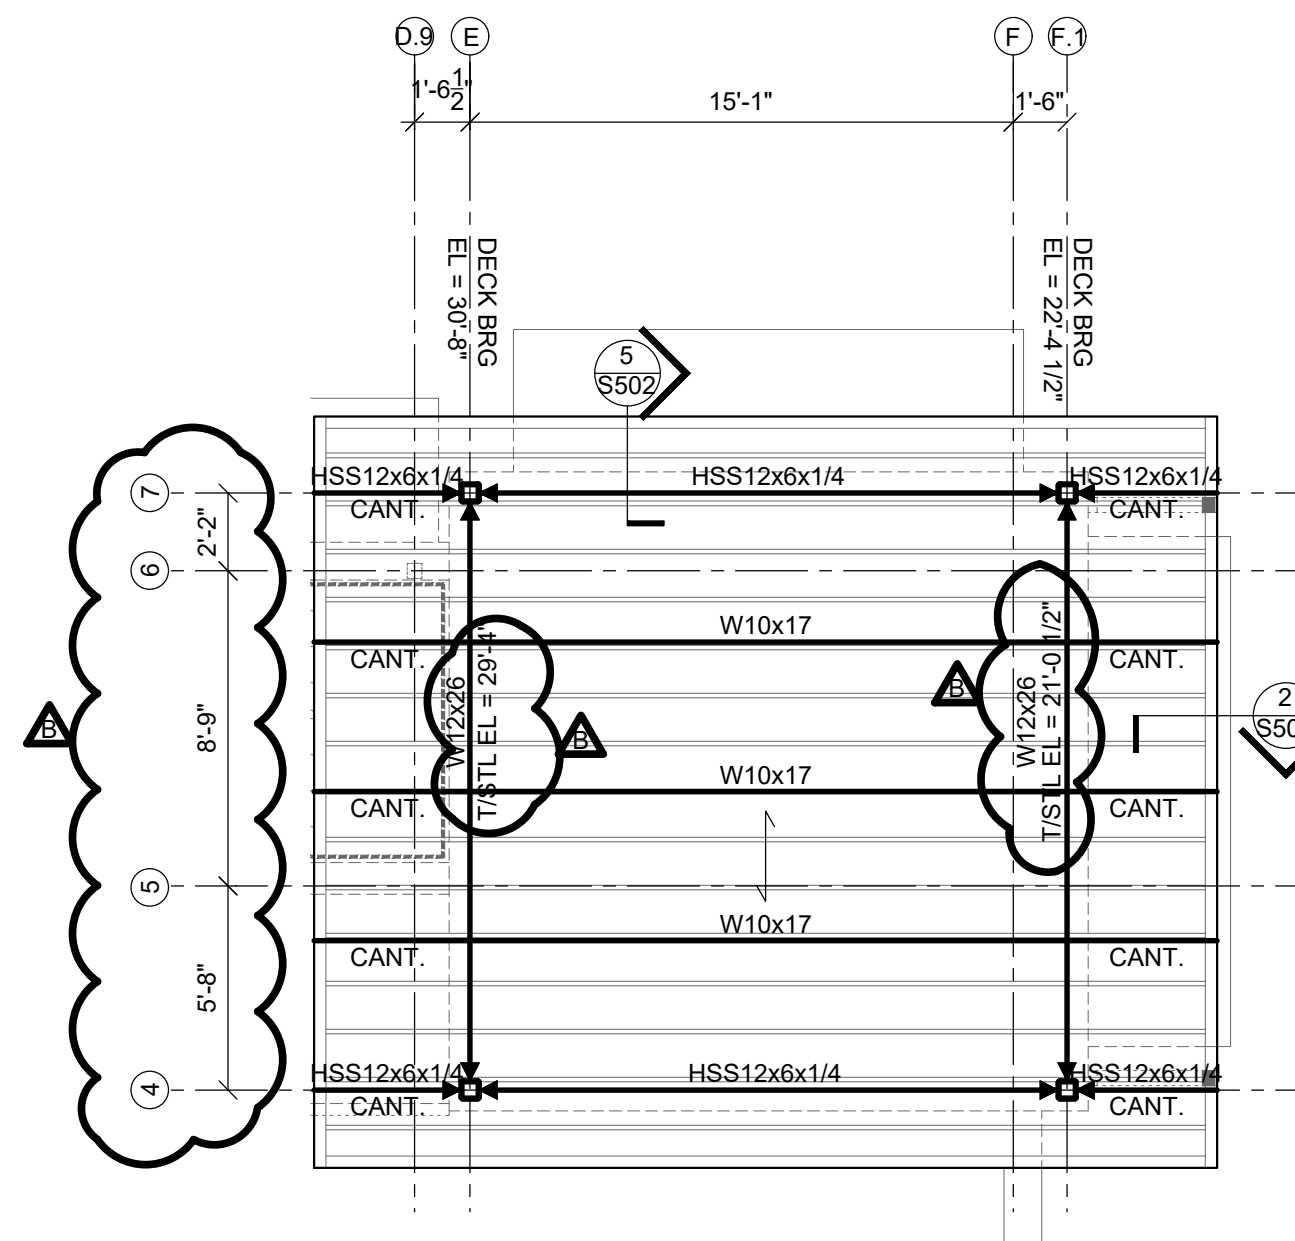

2 TOWER ROOF FRAMING PLAN
3/16" = 1'-0"

- NOTES:
- SEE S001 FOR STRUCTURAL GENERAL NOTES.
 - SEE ARCH DRAWINGS FOR ADDITIONAL INFORMATION AND DIMENSIONS.
 - INDICATES DIRECTIONAL SPAN OF 1 1/2" 20 GA GALVANIZED ROOF DECK, SEE 9/S502. SEE PLAN FOR DECK BEARING ELEVATIONS.
 - INDICATES MOMENT CONNECTION. SEE S503


ENGINEER:

FORESITE
group

Foresite Group, Inc.
3740 Davinci Ct.
Suite 100
Peachtree Corners, GA 30092

w | www.fg-inc.net
o | 770.368.1399
f | 770.368.1944

DEVELOPER:

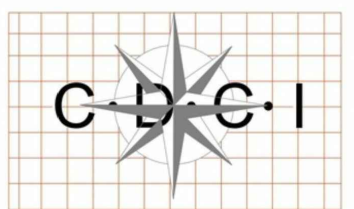

CONTRACT DESIGN CONCEPTS, INCORPORATED
COMMERCIAL DESIGN AND PLANNING SERVICES

3665 SWIFTWATER PARKWAY
SUITE 307
SUWANEE, GA 30024

PROJECT:

7 TEQUILAS MEXICAN RESTAURANT
NEW CONSTRUCTION

5586 OLD HIGHWAY 5 WOODSTOCK, GA 30188

SEAL:

PRELIMINARY - NOT FOR CONSTRUCTION

REVISIONS	DATE
ARCHITECTURAL REVISION	05/21/2021
G.C. SHOP DWG. COORD. 1	02/04/2022
G.C. SHOP DWG. COORD. 2	03/15/2022

PROJECT MANAGER: JMW
DRAWING BY: BJJ
JURISDICTION:
DATE: 01/29/2019
SCALE: AS SHOWN
TITLE:

HIGH ROOF FRAMING PLAN


SHEET NUMBER:

S103


COMMENTS:

JOB/FILE NUMBER:


1133.006

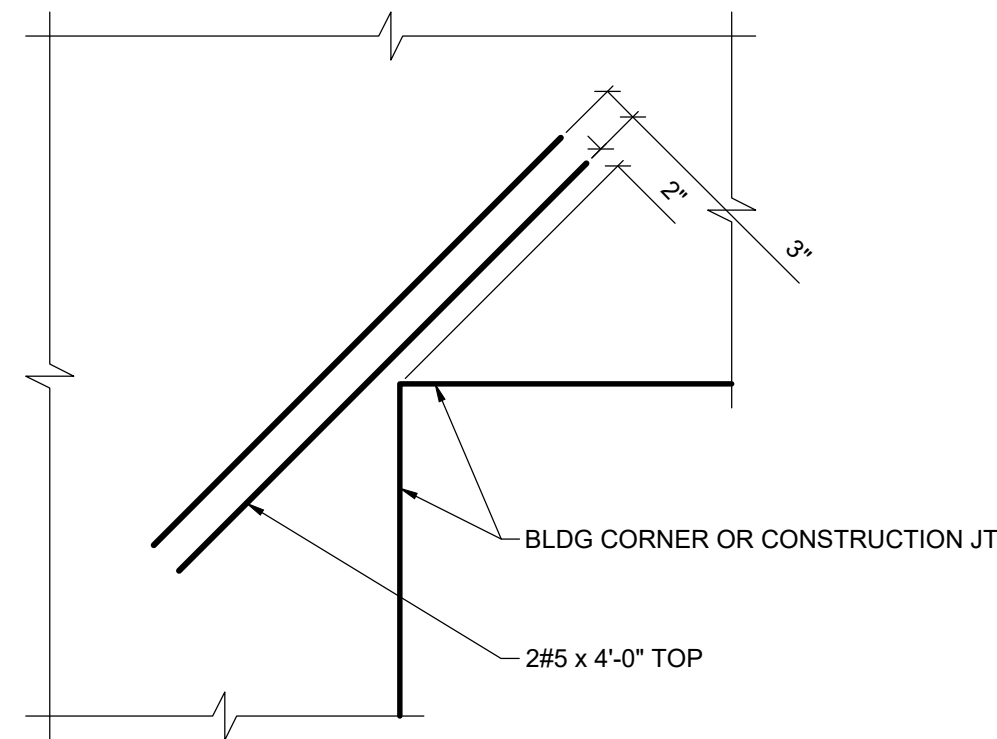


9
S301
TYPICAL REINFORCEMENT AT SLAB RE-ENTRANT CORNER
3/4" = 1'-0"

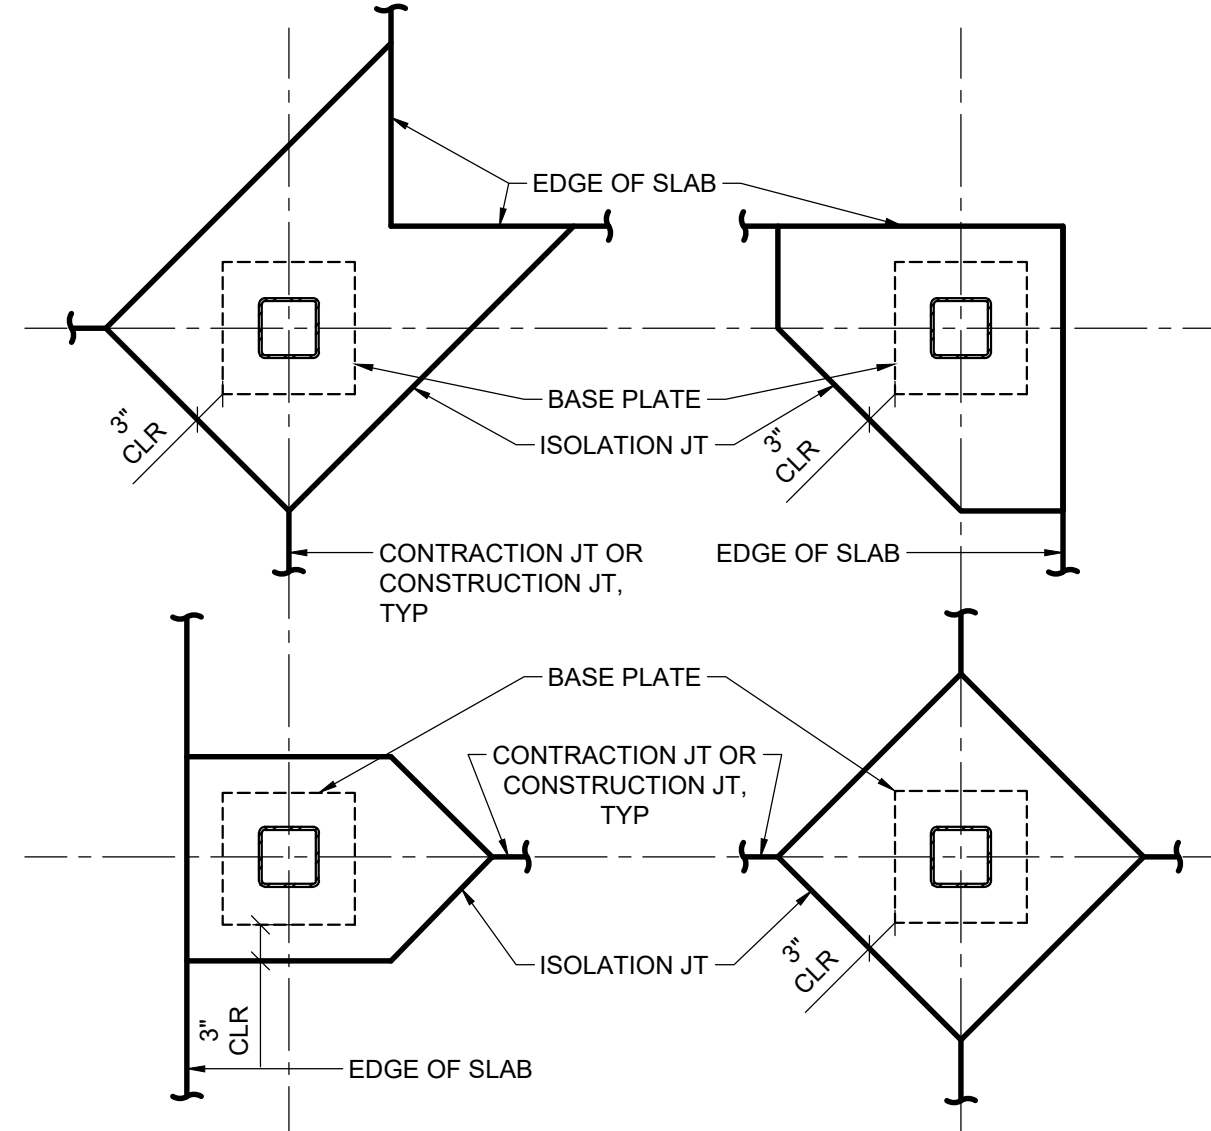



6
S301
TYPICAL ISOLATION JOINT AT STEEL COLUMN
3/4" = 1'-0"

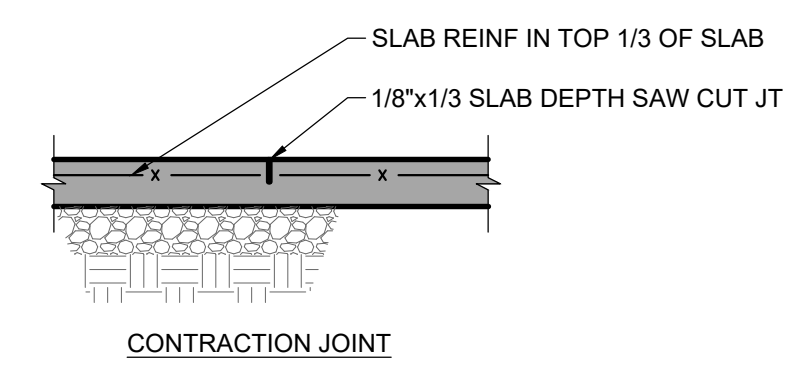


3
S301
TYPICAL GRADE SUPPORTED SLAB AT JOINTS
3/4" = 1'-0"

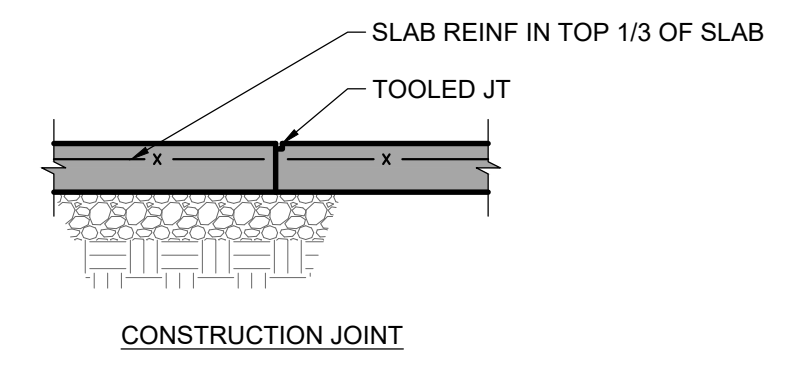


NOTE: SAW CUT OR DISCONTINUE REINF AT CONTRACTION JT

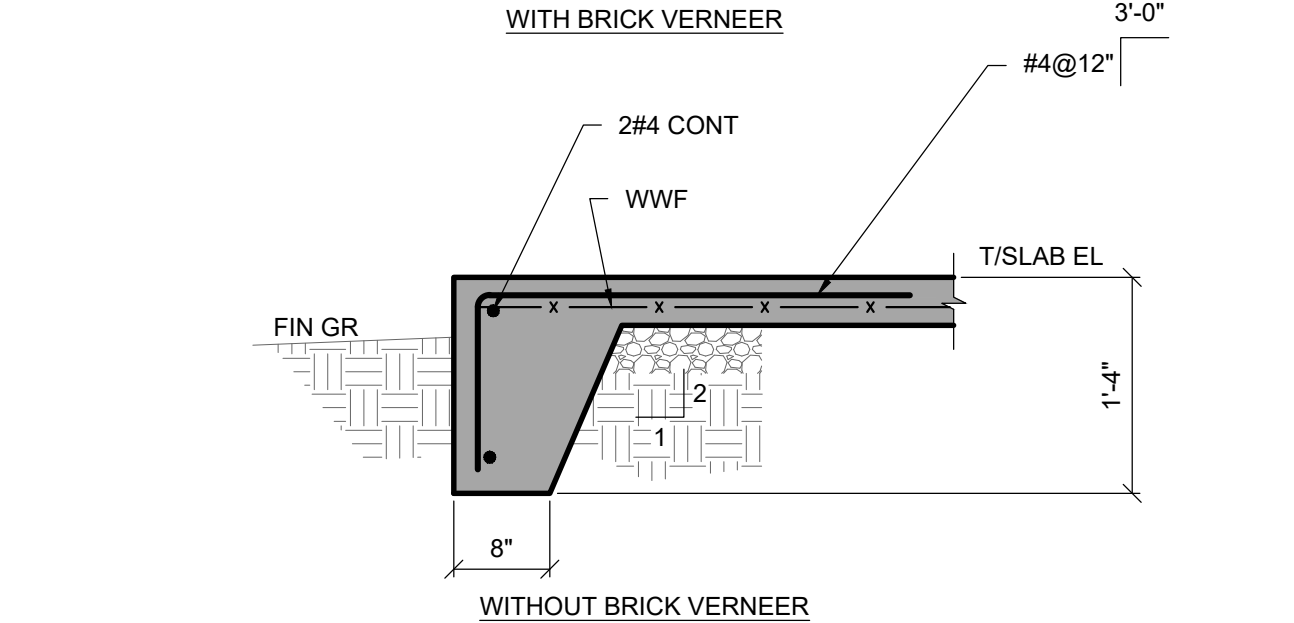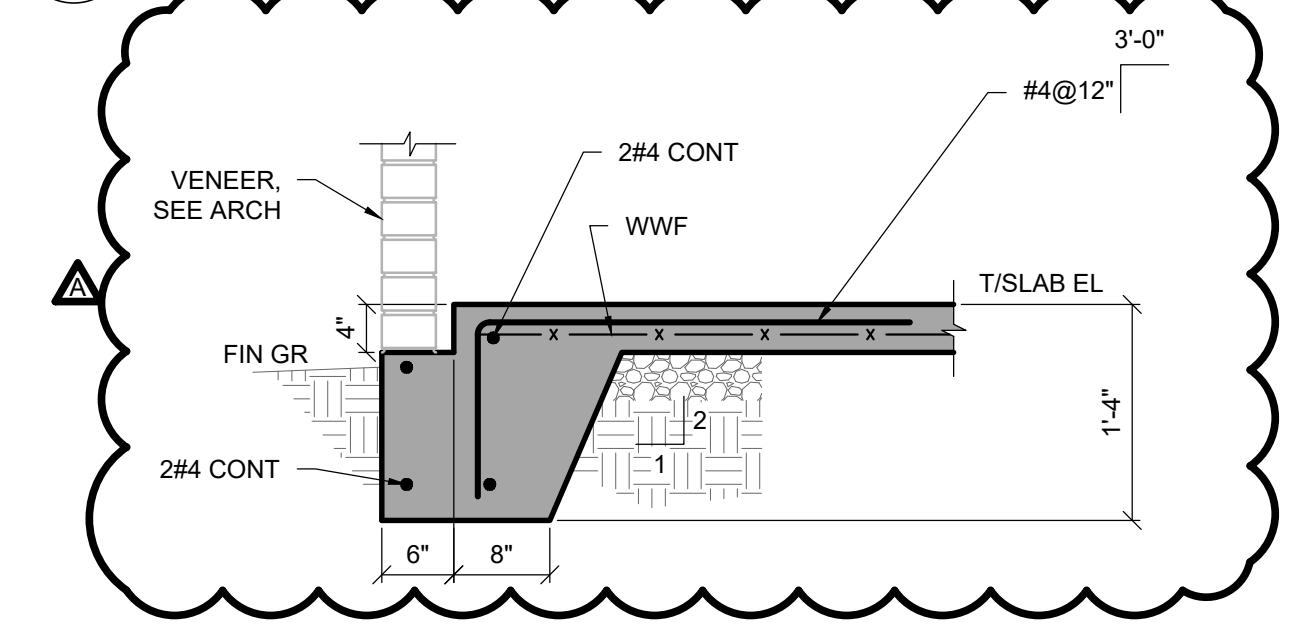


2
S301
TYPICAL TURN DOWN SLAB
3/4" = 1'-0"

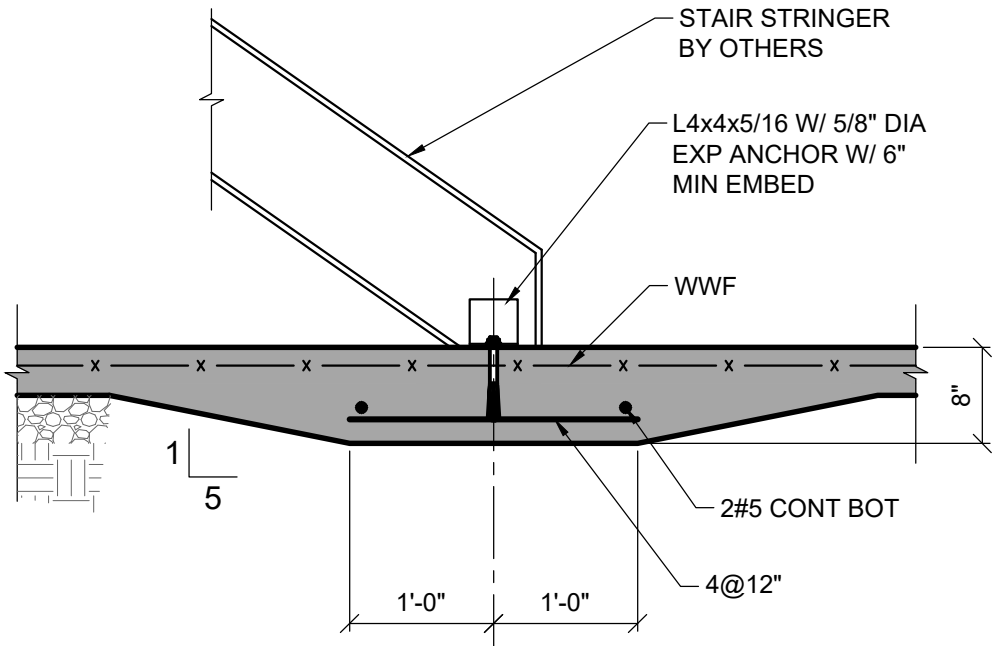


11
S301
TYPICAL THICKENED GRADE SUPPORTED SLAB AT STEEL STAIR
3/4" = 1'-0"

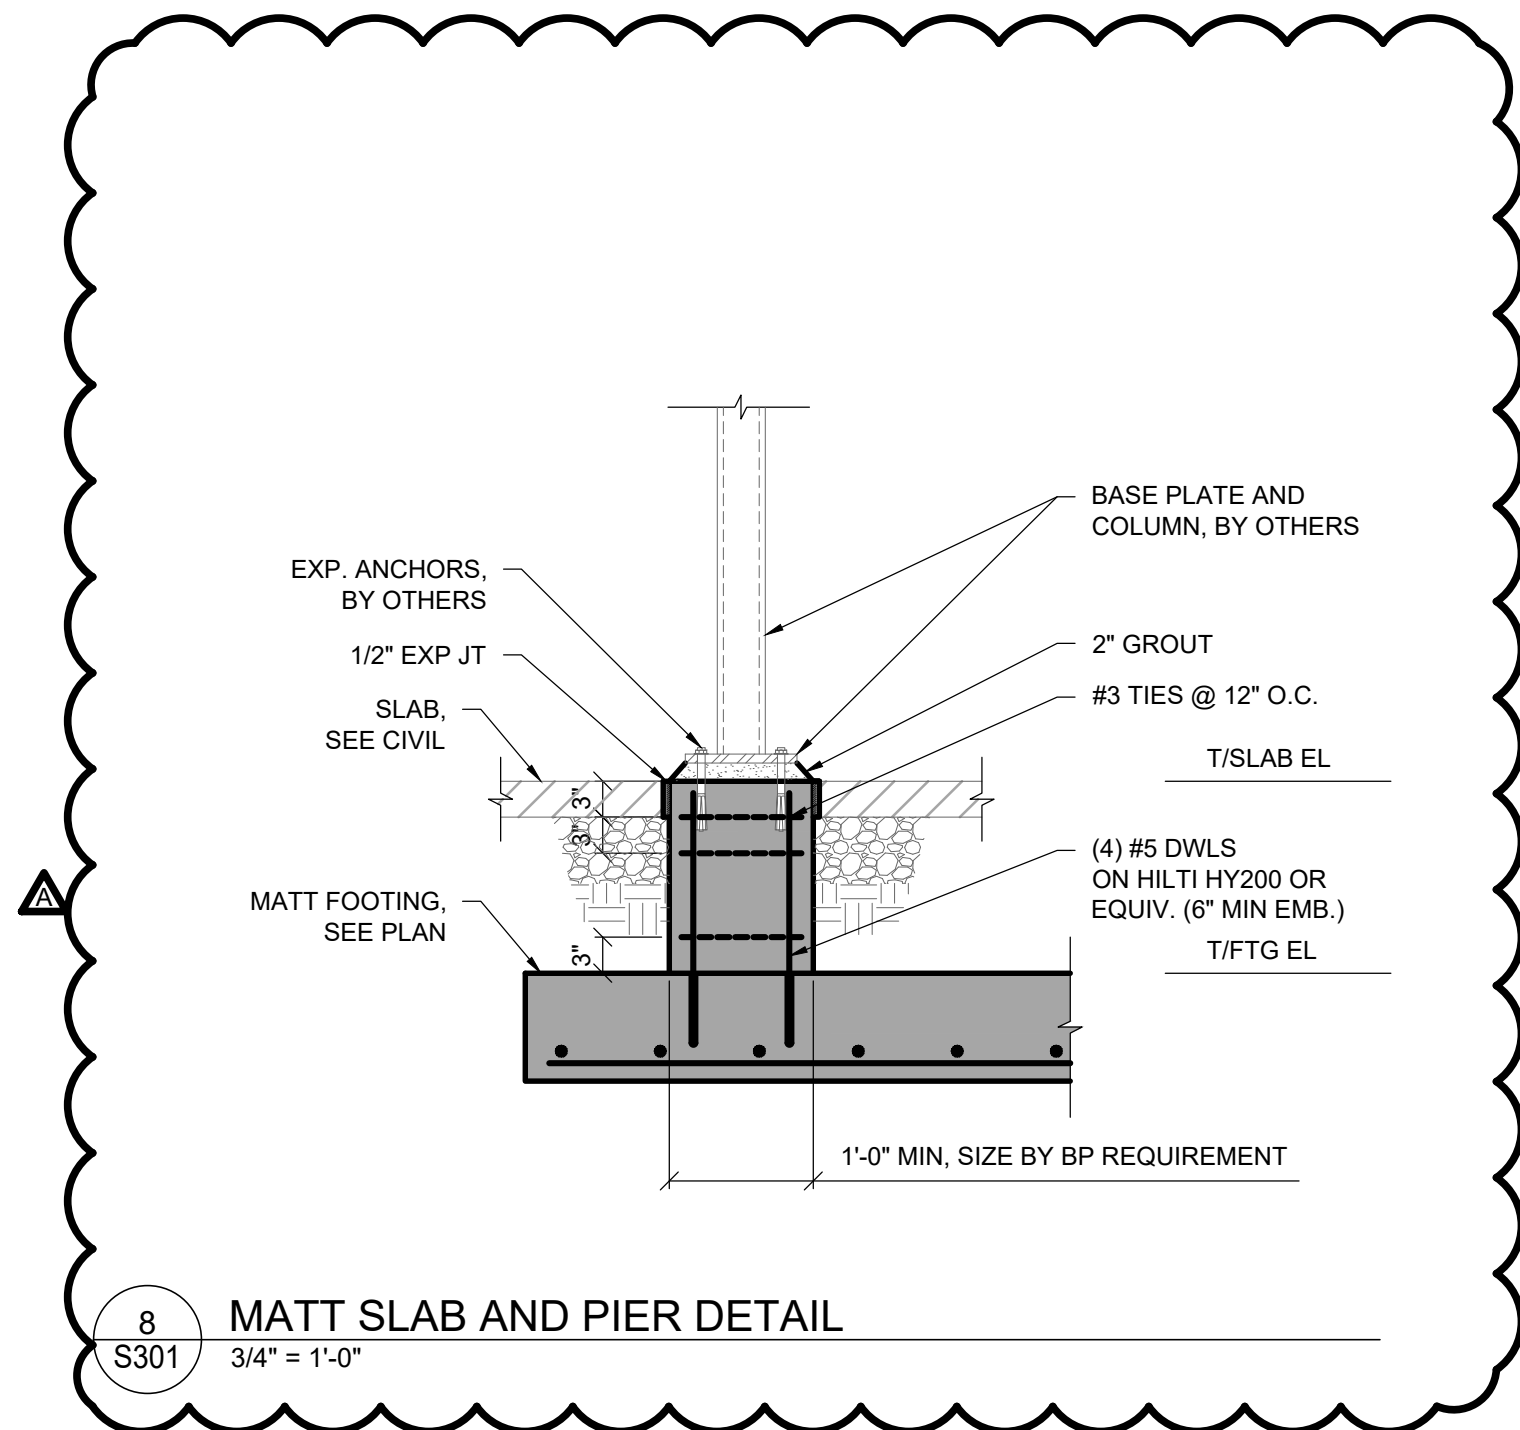


8
S301
MATT SLAB AND PIER DETAIL
3/4" = 1'-0"

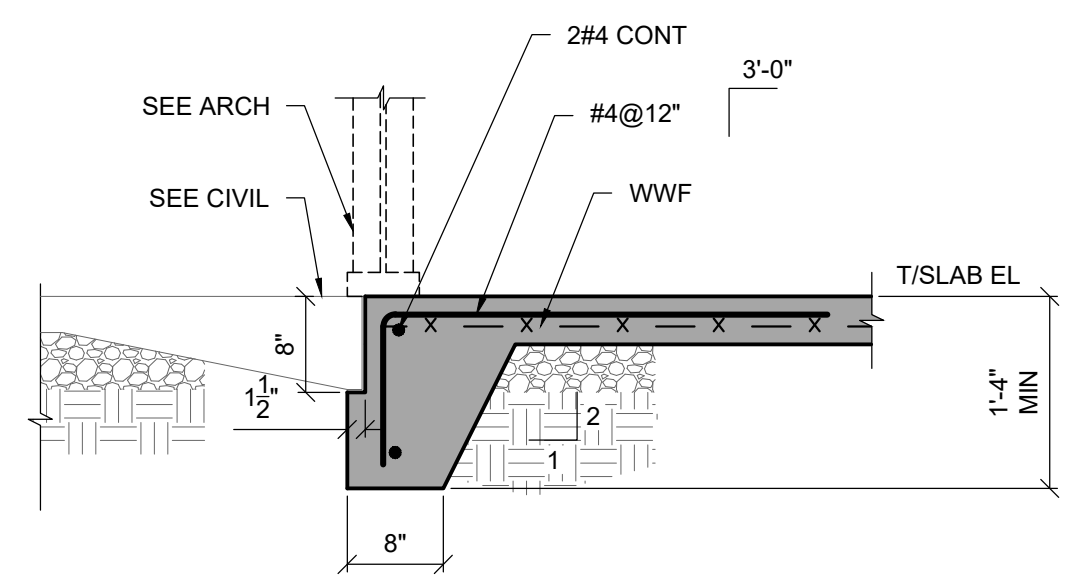


5
S301
TYPICAL TURN DOWN SLAB AT STOREFRONT
3/4" = 1'-0"

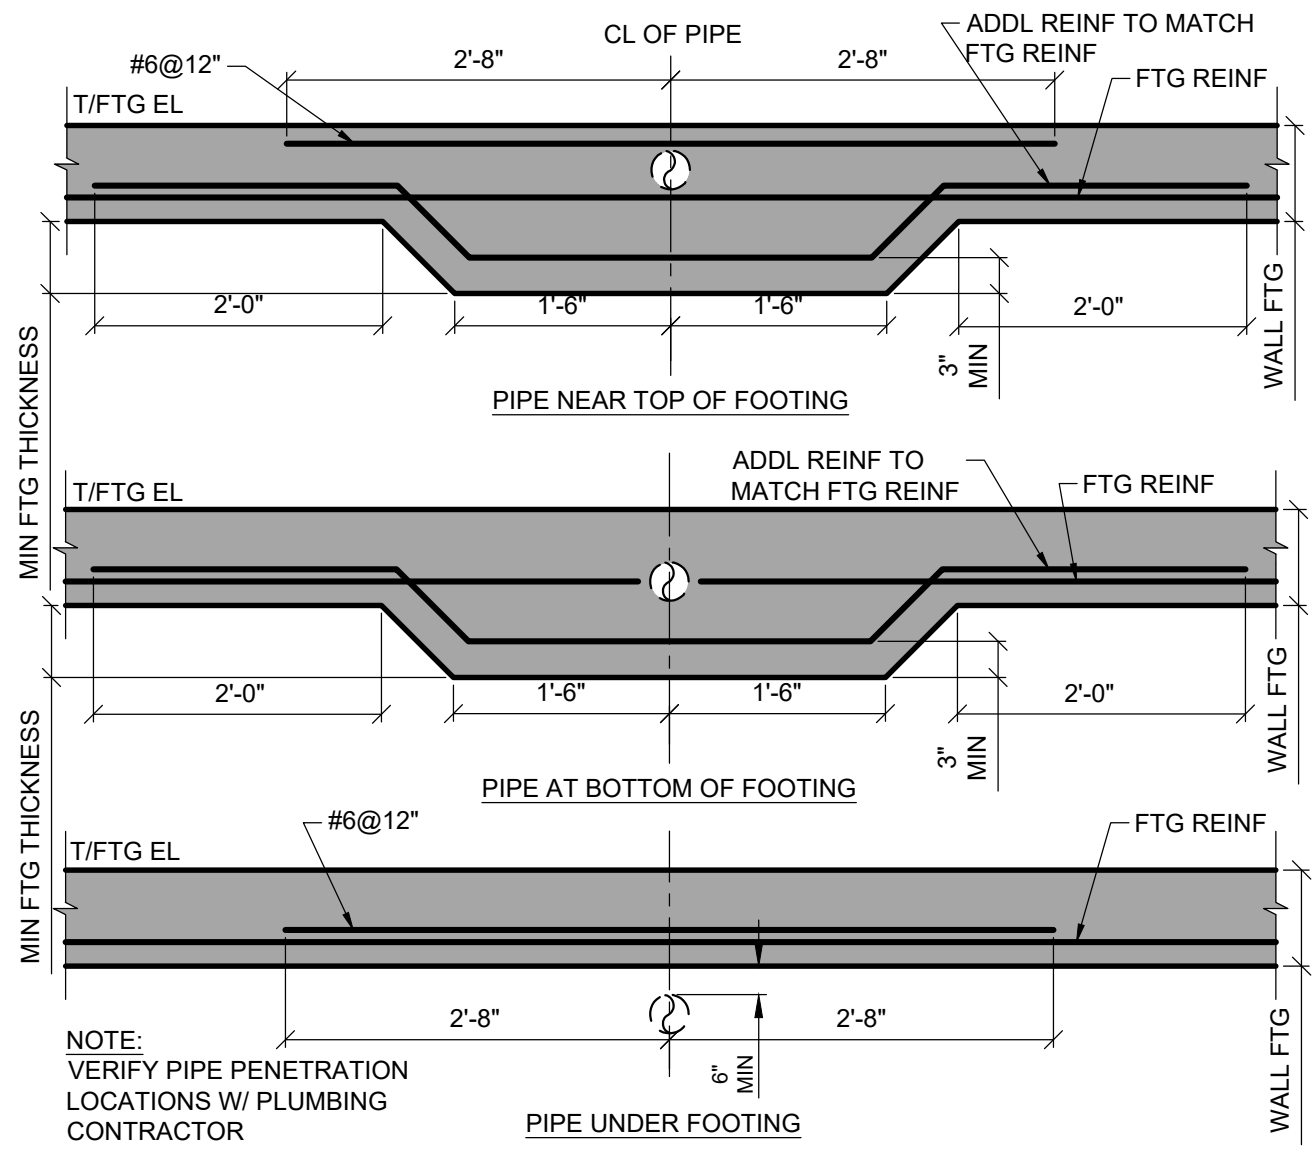

10
S301
TYPICAL THICKENED FOOTING AT UNDERGROUND PIPING
3/4" = 1'-0"

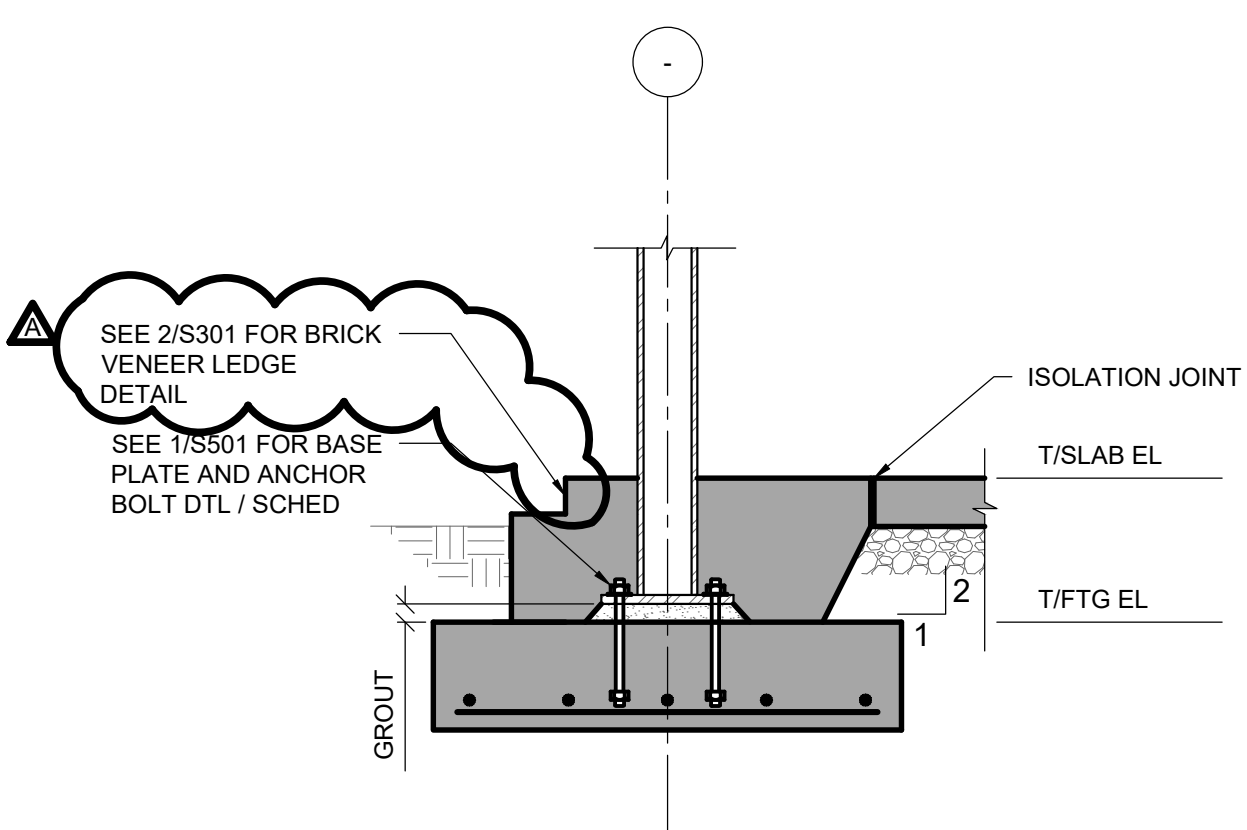

7
S301
TYPICAL EXTERIOR STEEL COLUMN FOOTING
3/4" = 1'-0"

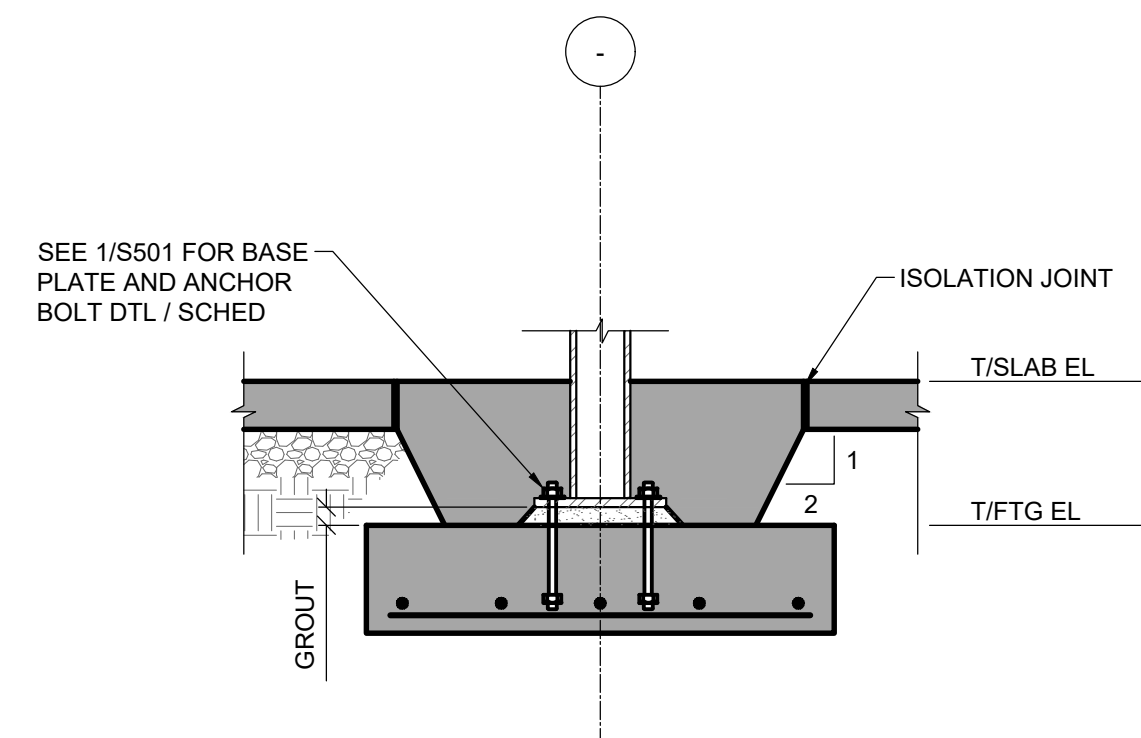

4
S301
TYPICAL INTERIOR STEEL COLUMN FOOTING
3/4" = 1'-0"

FOOTING SCHEDULE			
MARK	SIZE (WxLxT)	REINF	REMARKS
F4.0	4'-0"x4'-0"x1'-0"	4#5 EACH WAY	BOTTOM
F5.0	5'-0"x5'-0"x1'-0"	5#5 EACH WAY	BOTTOM
F6.0	6'-0"x6'-0"x1'-0"	6#5 EACH WAY	BOTTOM

1
S301
FOOTING SCHEDULE
NOT TO SCALE

ENGINEER:
FORESITE
group
Foresite Group, Inc.
3740 Davinci Ct.
Suite 100
Peachtree Corners, GA 30092
w | www.fg-inc.net
o | 770.368.1399
f | 770.368.1944

DEVELOPER:
CDCI
CONTRACT DESIGN CONCEPTS, INCORPORATED
COMMERCIAL DESIGN AND PLANNING SERVICES
3665 SWIFTWATER PARKWAY
SUITE 307
SUWANEE, GA 30024


PROJECT:
7 TEQUILAS MEXICAN RESTAURANT
NEW CONSTRUCTION
5586 OLD HIGHWAY 5 WOODSTOCK, GA 30188

SEAL:
PRELIMINARY - NOT FOR CONSTRUCTION


REVISIONS	DATE
ARCHITECTURAL REVISION	05/21/2021
G.C. SHOP DWG. COORD. 1	02/04/2022

PROJECT MANAGER: JMW
DRAWING BY: BJJ
JURISDICTION:
DATE: 01/29/2019
SCALE: AS SHOWN
TITLE:


FOUNDATION DETAILS
SHEET NUMBER: **S301**
COMMENTS:
JOB/FILE NUMBER: 1133.006

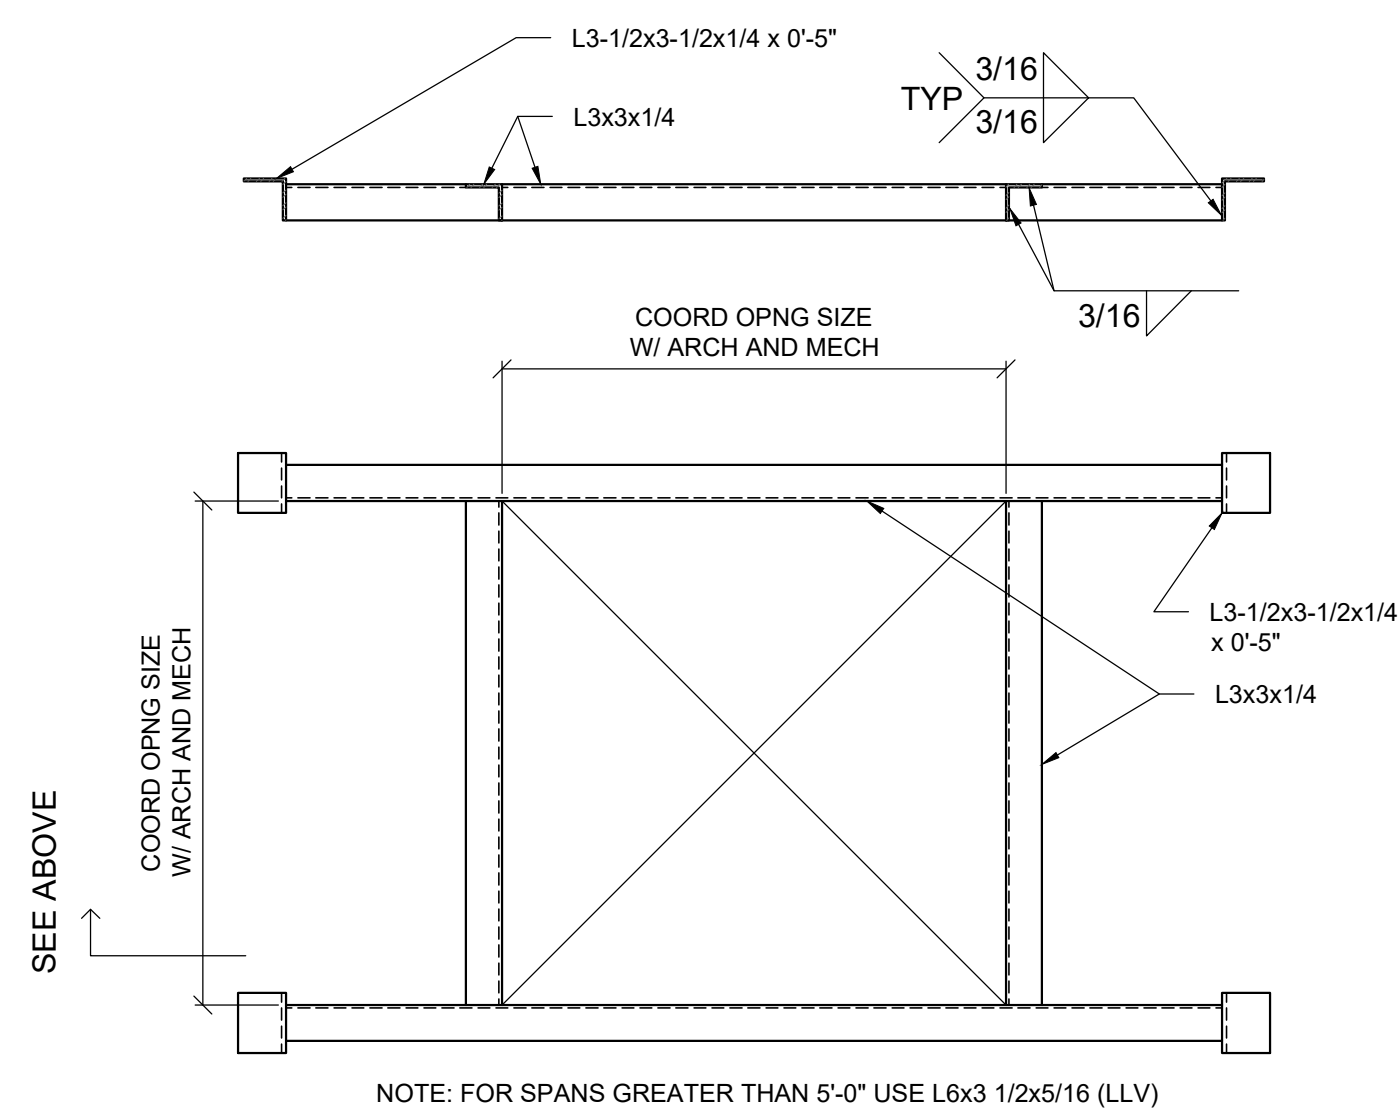


12
S501 TYPICAL FRAMING AT ROOF DECK OPENING
3/4" = 1'-0"

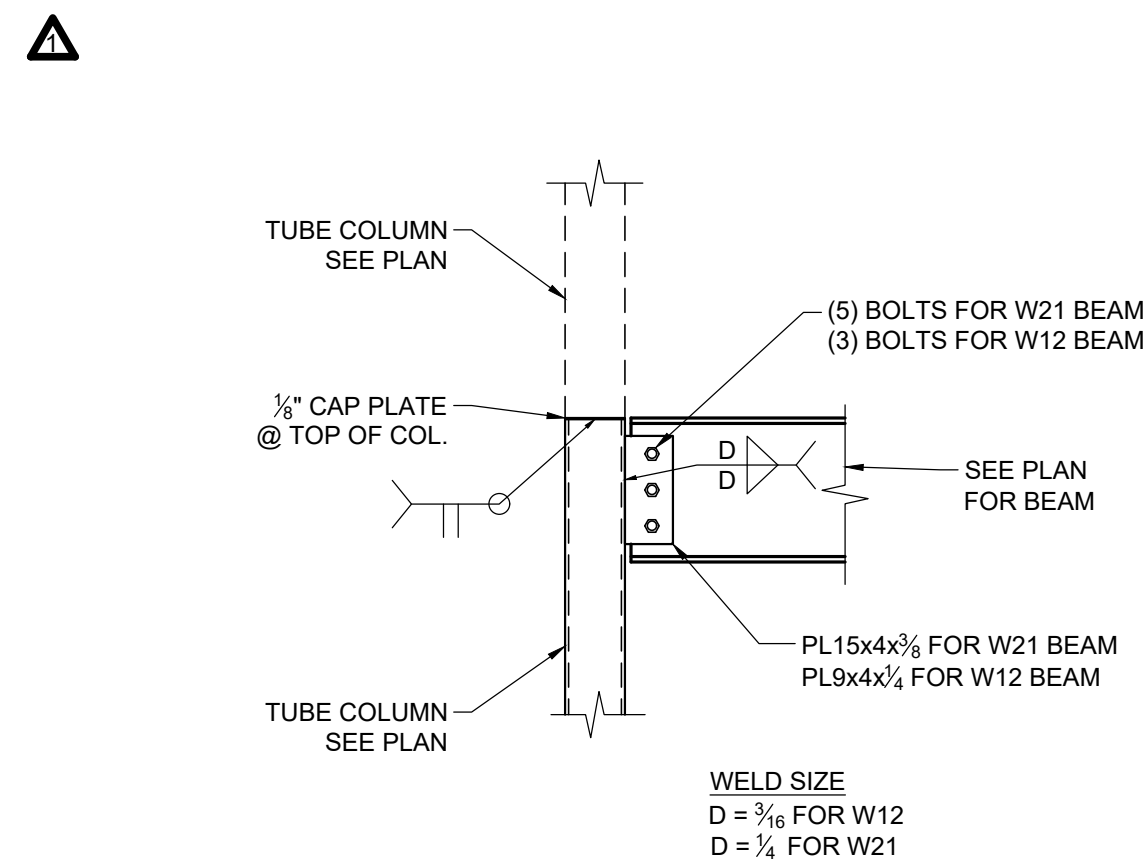


9
S501 W-BEAM TO TUBE COL. CONNECTION
3/4" = 1'-0"

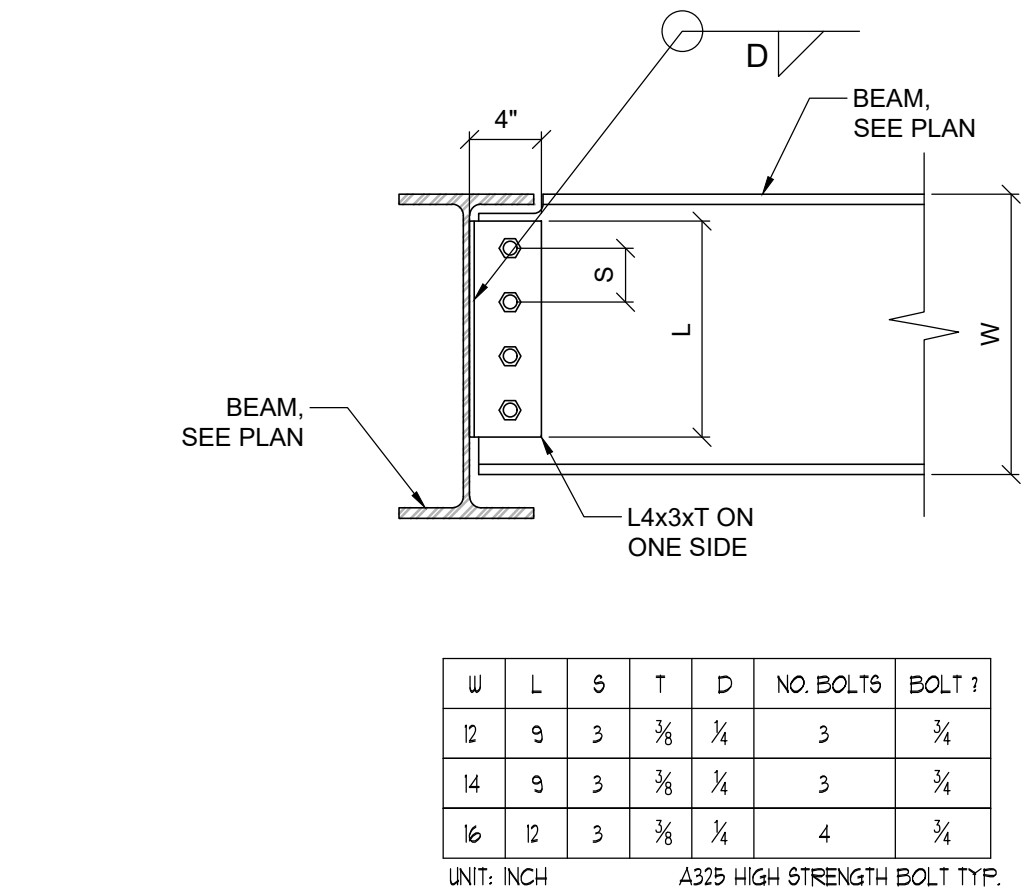


6
S501 TYP. BEAM-BEAM CONNECTION UPTO W18 BEAM
3/4" = 1'-0"

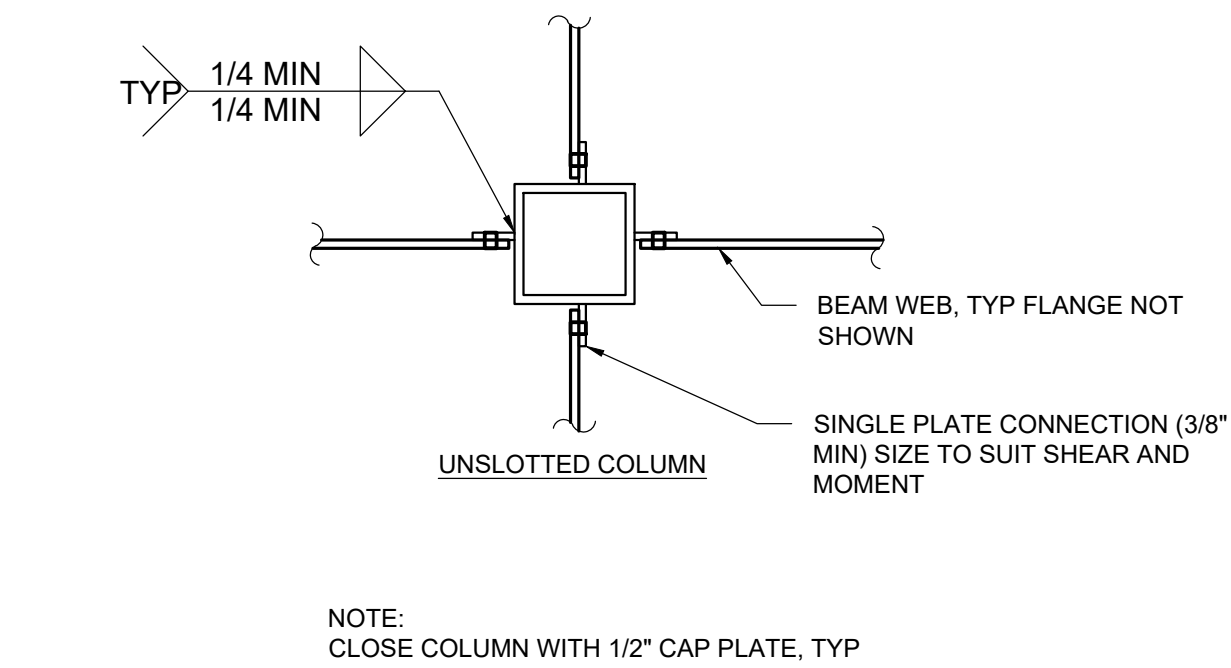


3
S501 TYPICAL TUBE COLUMN CONNECTIONS
3/4" = 1'-0"

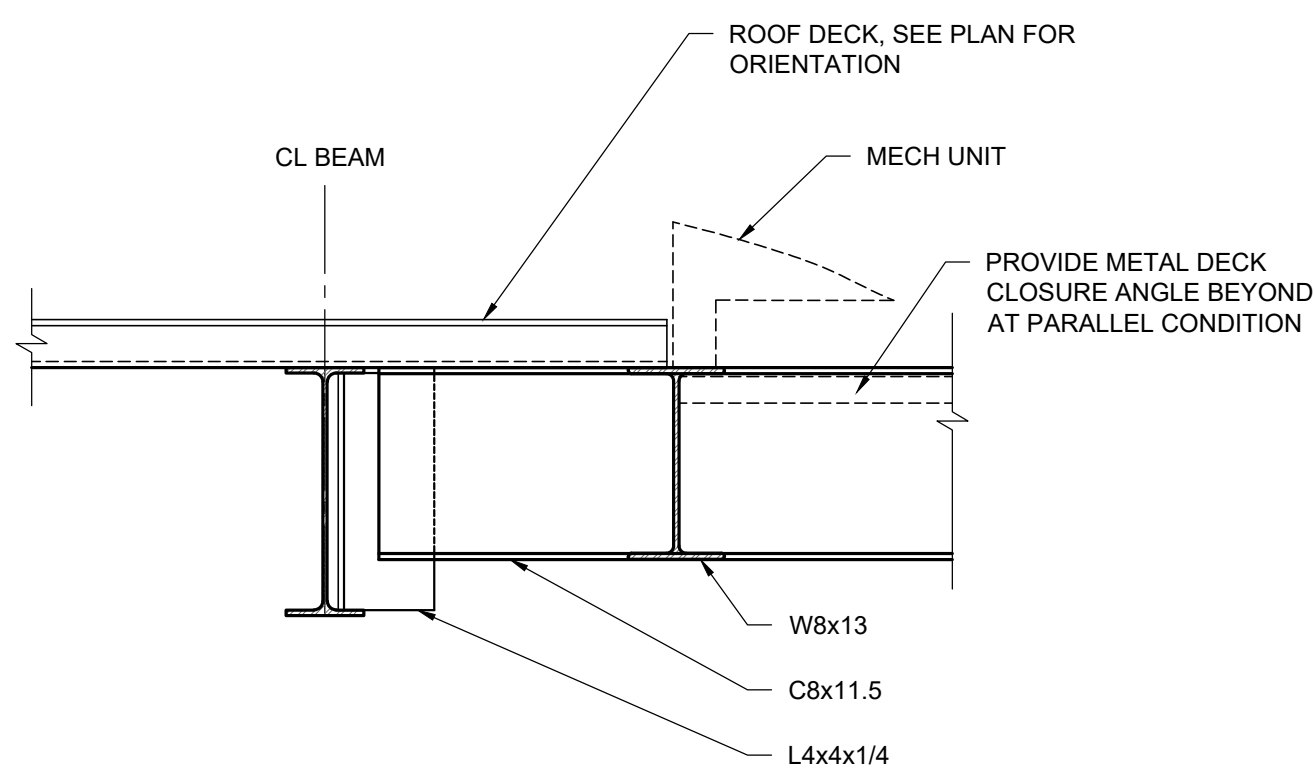

11
S501 TYPICAL ROOF DECK AT MECHANICAL UNIT SUPPORT
3/4" = 1'-0"

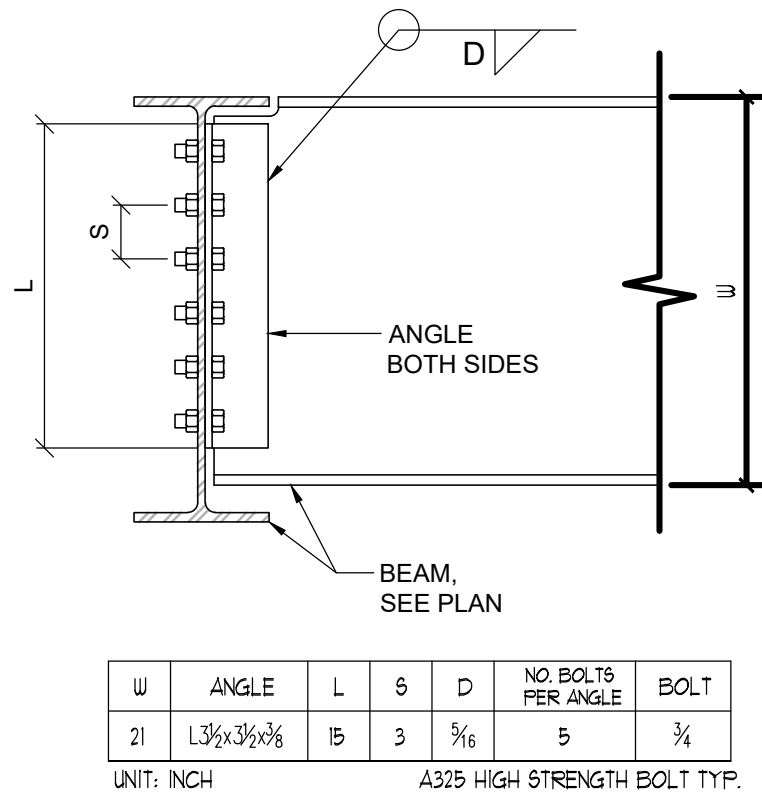


8
S501 TYP. BEAM-BEAM CONNECTION W21 & LARGER BEAM
3/4" = 1'-0"

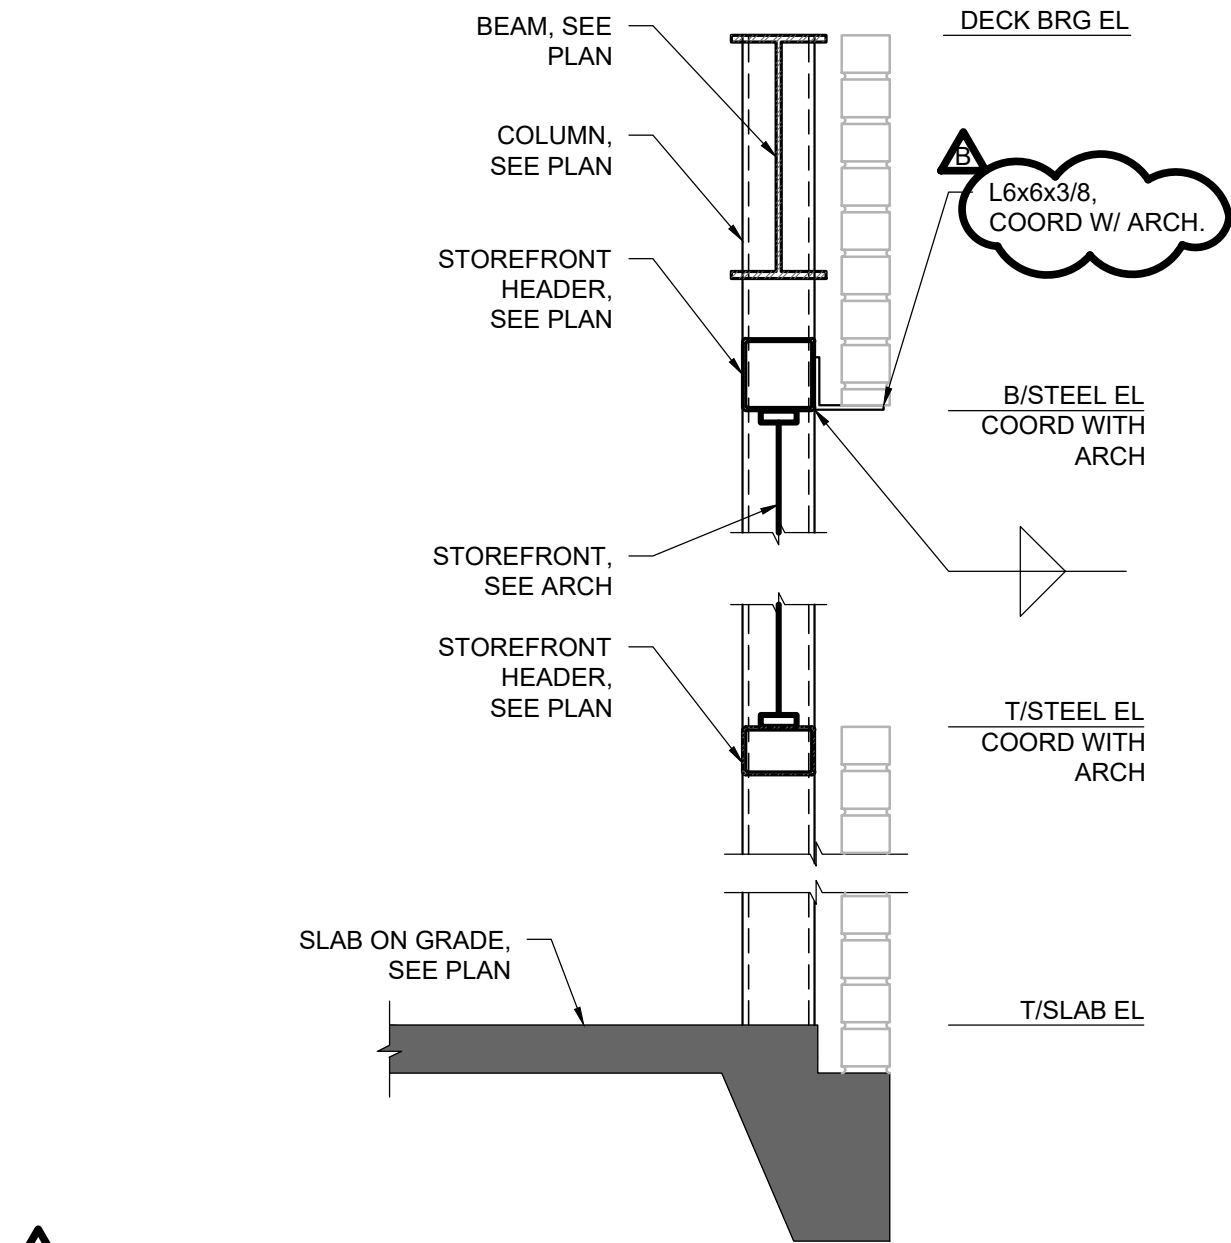


5
S501 STOREFRONT SECTION
3/4" = 1'-0"

BASE PLATE AND ANCHOR BOLT SCHEDULE									
MARK	BASE PLATE				ANCHOR BOLTS			WELD	
	A	B	C	D1	D2	E	F	NO	W
BP1	3/4"	10"	10"	3 1/2"	3 1/2"	3/4"	9"	4	3/16"
BP2	3/4"	12"	12"	4 1/2"	4 1/2"	3/4"	9"	4	3/16"
BP3A	SEE NOTE 2								


NOTE:
1. AT BRACED FRAMES, BASE PLATE DIMENSIONS SHOWN SHALL BE MINIMUMS AND SHALL BE SIZED TO FIT FOR CONNECTION OF BRACES.
2. SEE 12/S502 FOR BASE PLATE AND ANCHOR BOLT INFORMATION FOR BP3A

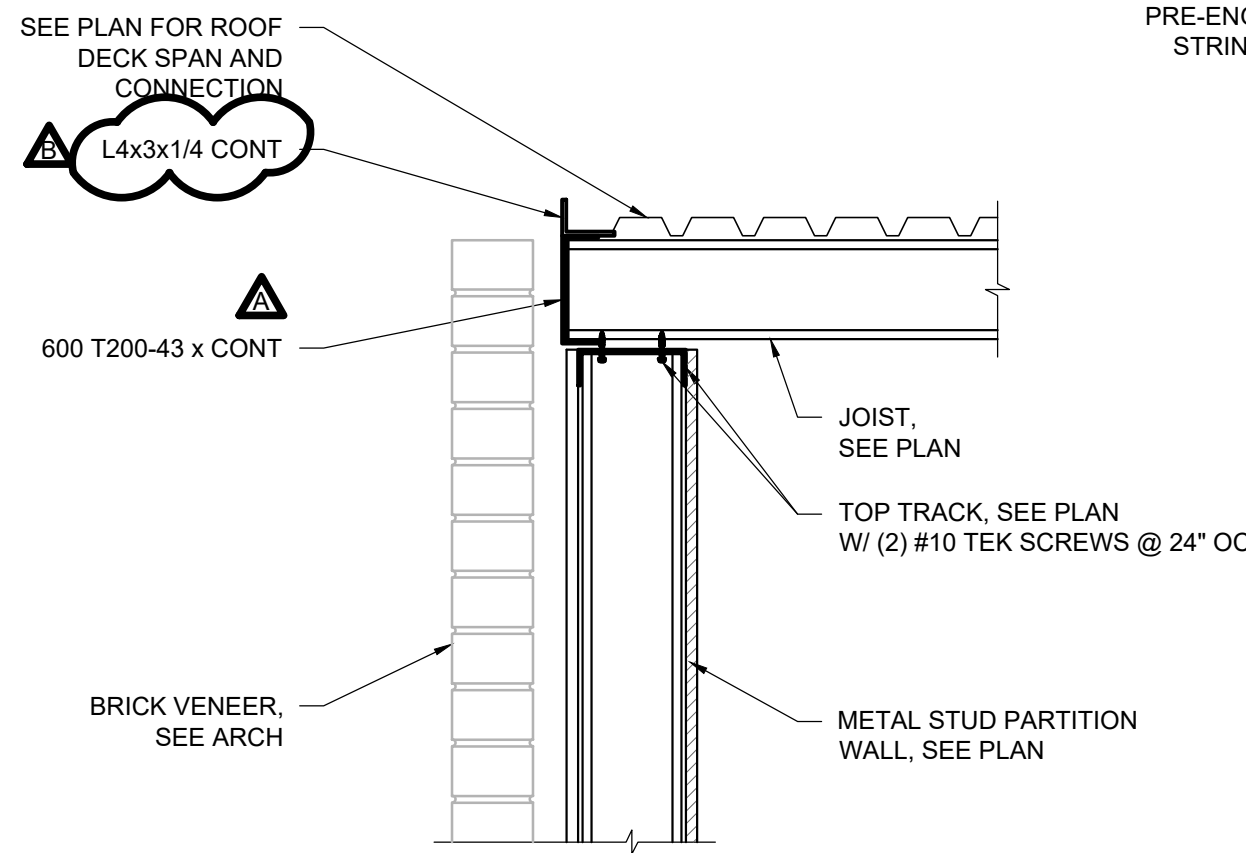


10
S501 COLD FORM JOIST TO PARTITION WALL CONNECTION
NO SCALE

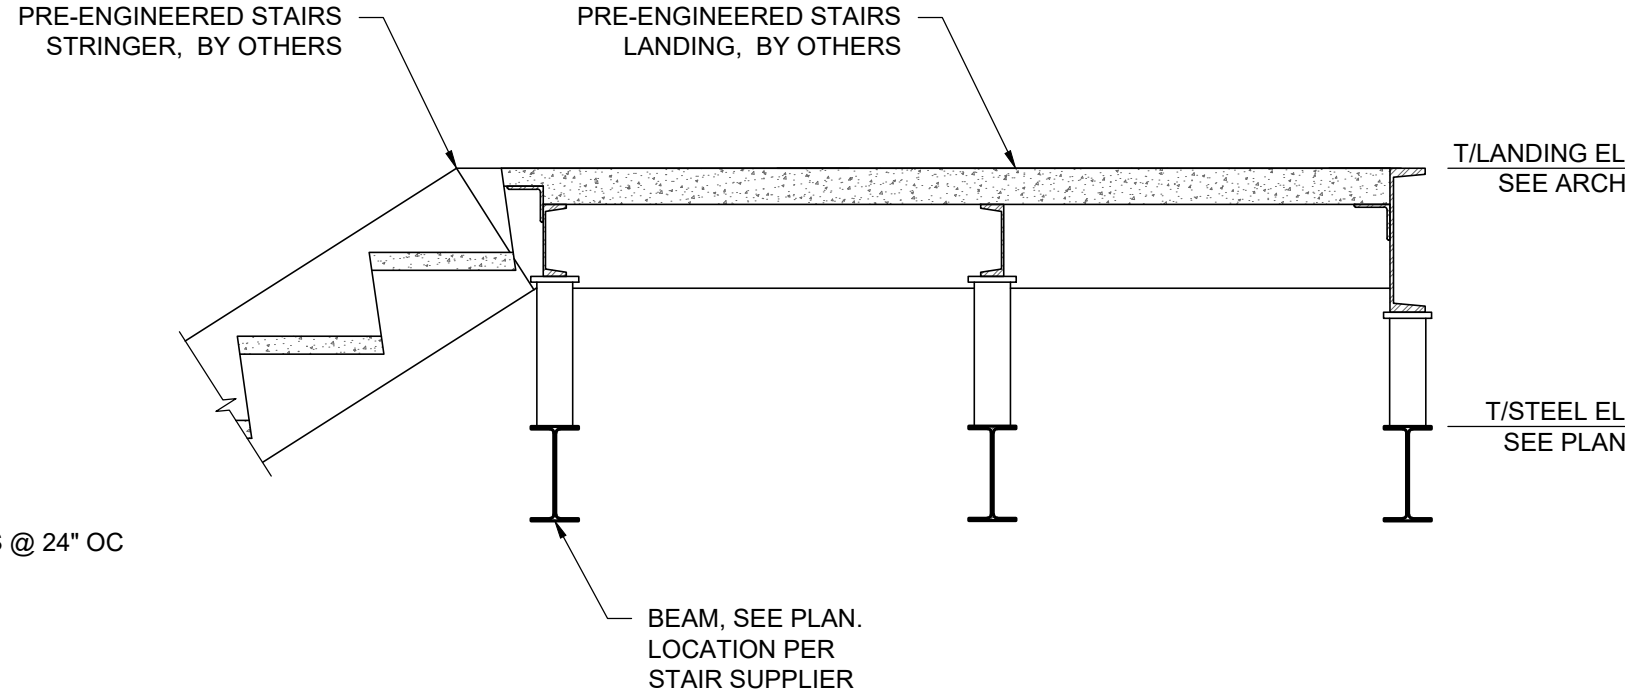

7
S501 PRE-ENGINEERED STAIR LANDING
3/4" = 1'-0"

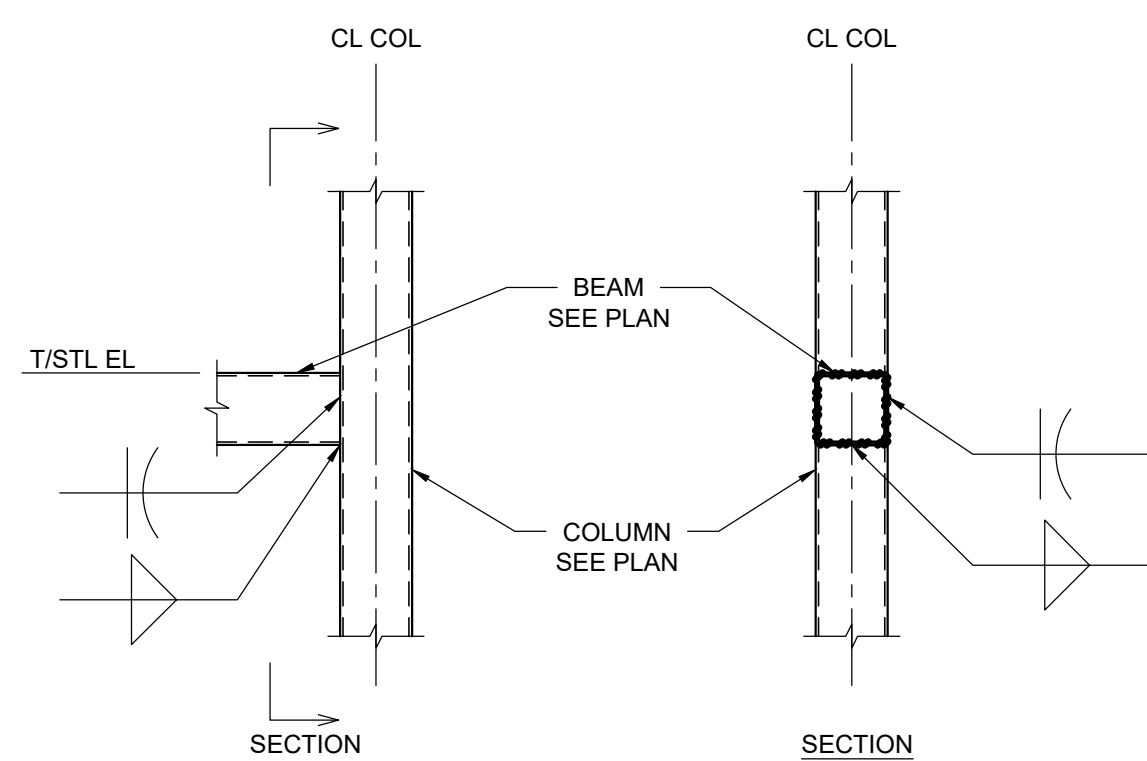

4
S501 TUBE TO TUBE
3/4" = 1'-0"

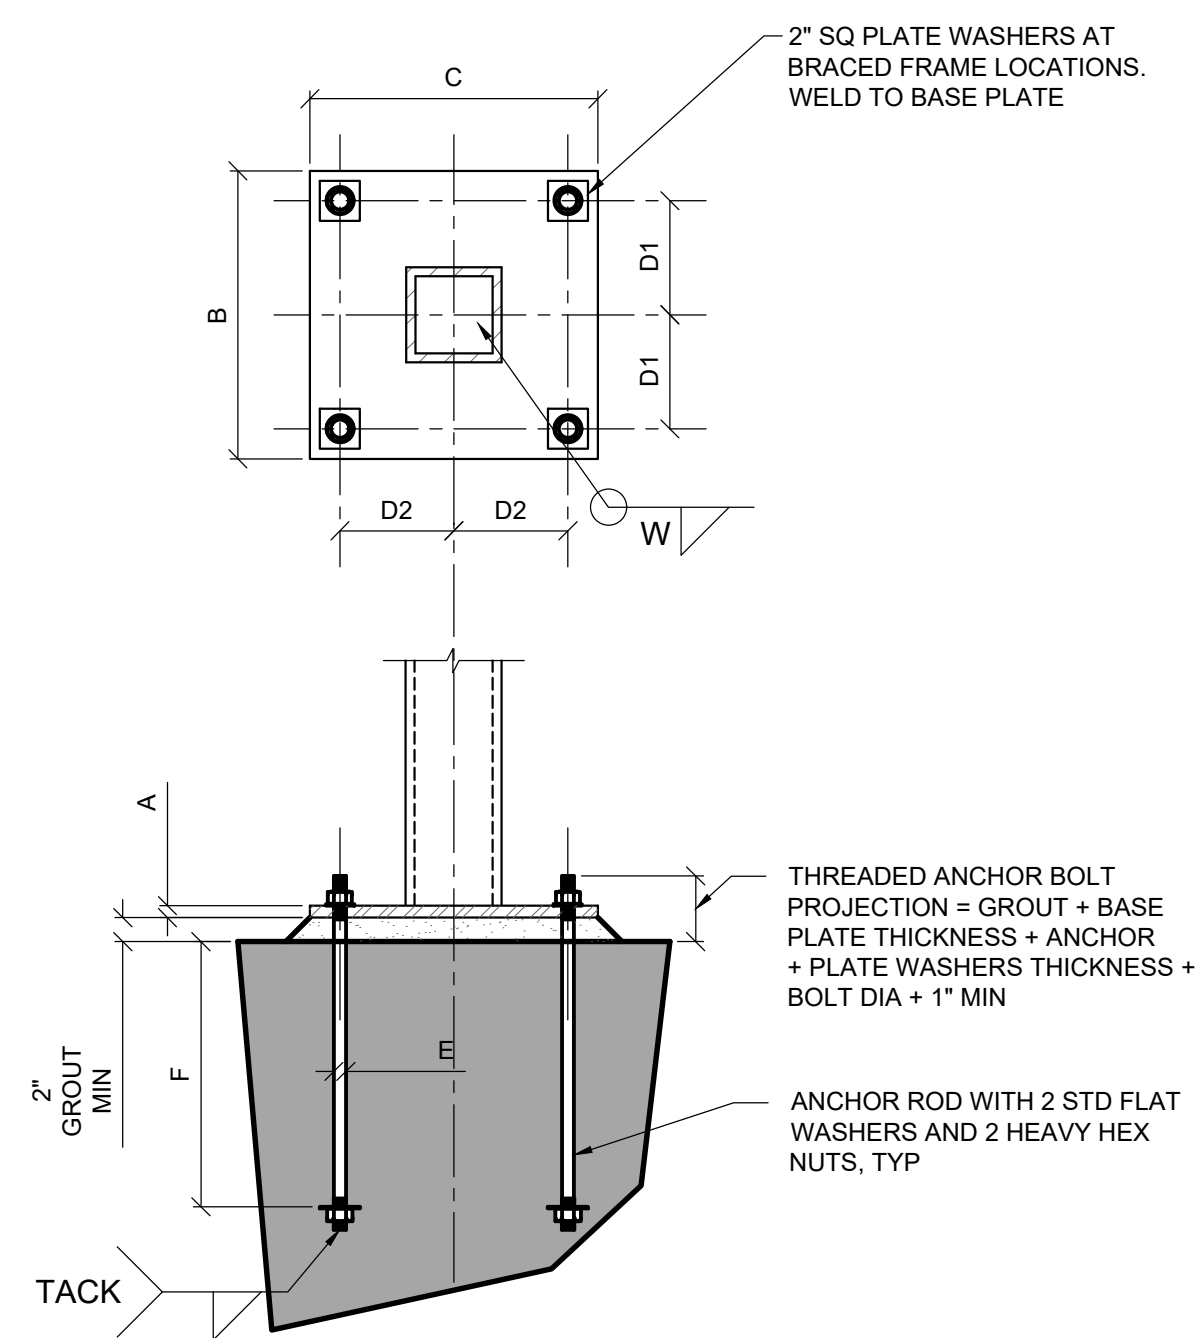

1
S501 TYPICAL BASE PLATE AND ANCHOR BOLT (TUBE)
3/4" = 1'-0"

ENGINEER:
FORESITE group
Foresite Group, Inc.
3740 Davinci Ct.
Suite 100
Peachtree Corners, GA 30092
w | www.fg-inc.net
o | 770.368.1399
f | 770.368.1944

DEVELOPER:
CDCI
CONTRACT DESIGN CONCEPTS, INCORPORATED
COMMERCIAL DESIGN AND PLANNING SERVICES
3665 SWIFTWATER PARKWAY
SUITE 307
SUWANEE, GA 30024


PROJECT:
7 TEQUILAS MEXICAN RESTAURANT
NEW CONSTRUCTION
5586 OLD HIGHWAY 5 WOODSTOCK, GA 30188

SEAL:
PRELIMINARY - NOT FOR CONSTRUCTION


REVISIONS	DATE
ARCHITECTURAL REVISION	05/21/2021
G.C. SHOP DWG. COORD. 1	02/04/2022
G.C. SHOP DWG. COORD. 2	03/15/2022

PROJECT MANAGER: JMW
DRAWING BY: BJJ
JURISDICTION:
DATE: 01/29/2019
SCALE: AS SHOWN
TITLE:


FRAMING DETAILS
SHEET NUMBER: **S501**
COMMENTS:
JOB/FILE NUMBER: 1133.006

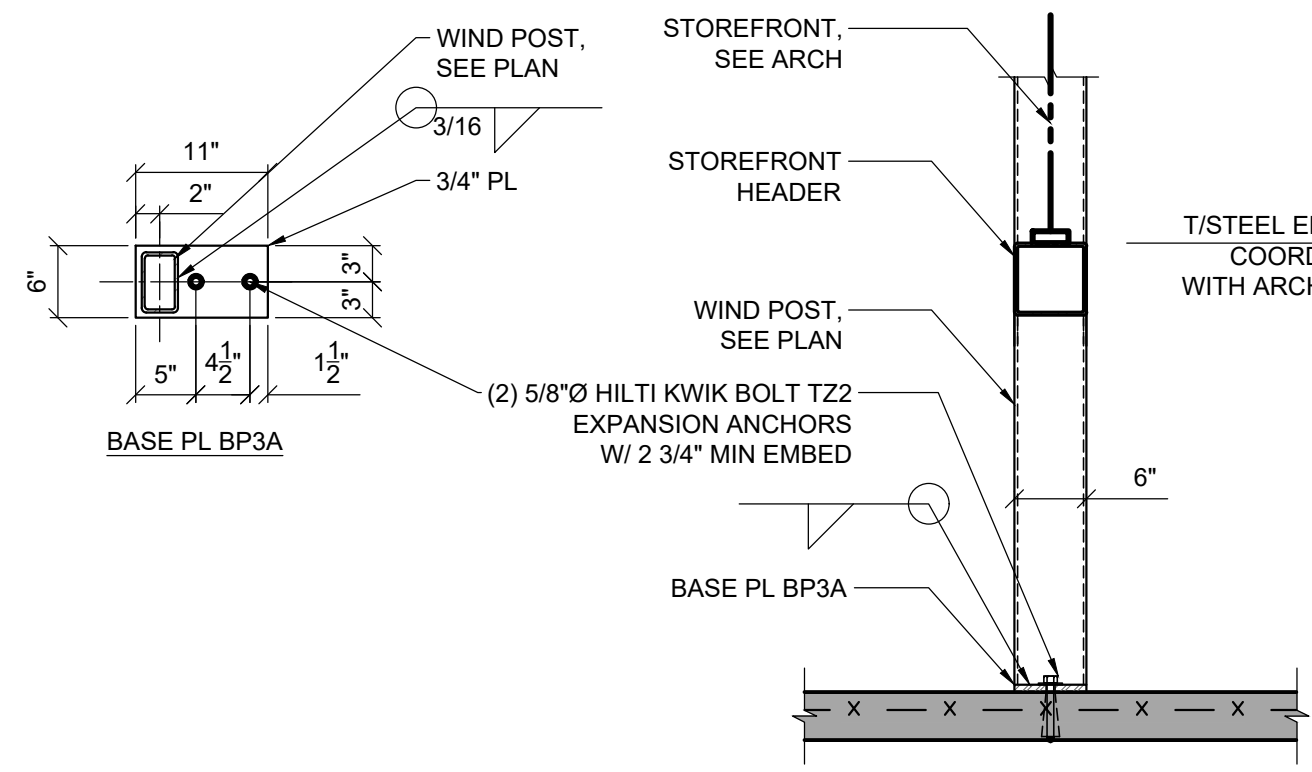


12
S502 TYPICAL WIND POST ATTACHMENT
3/4" = 1'-0"

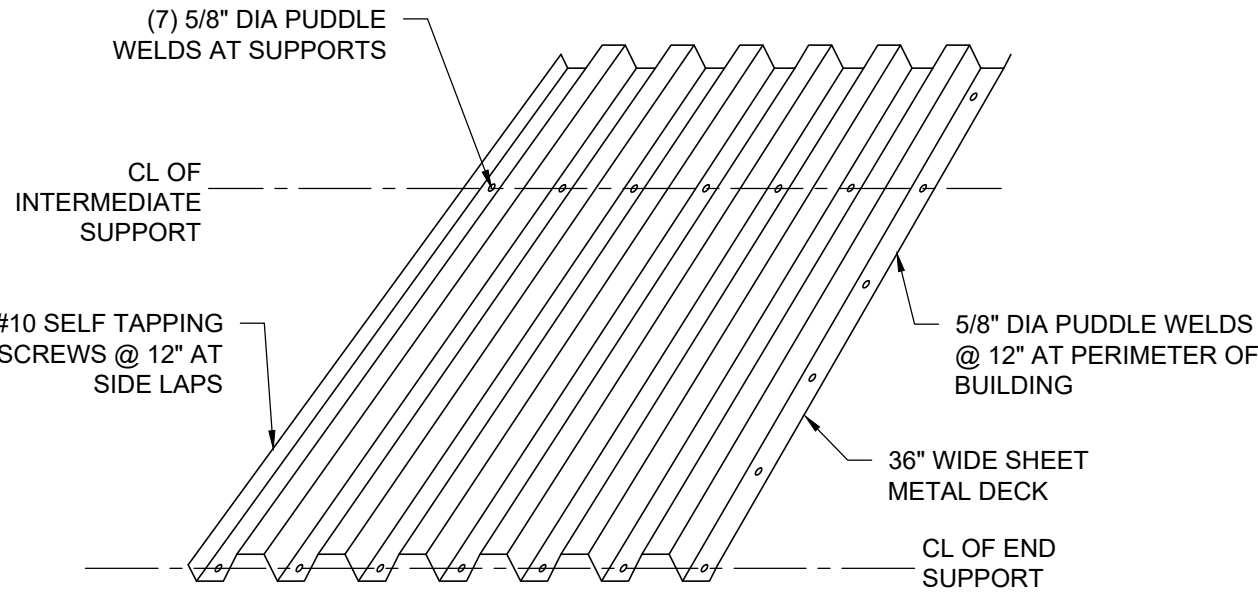


9
S502 TYPICAL DECK ATTACHMENT (36" WIDE SHEET)
3/4" = 1'-0"

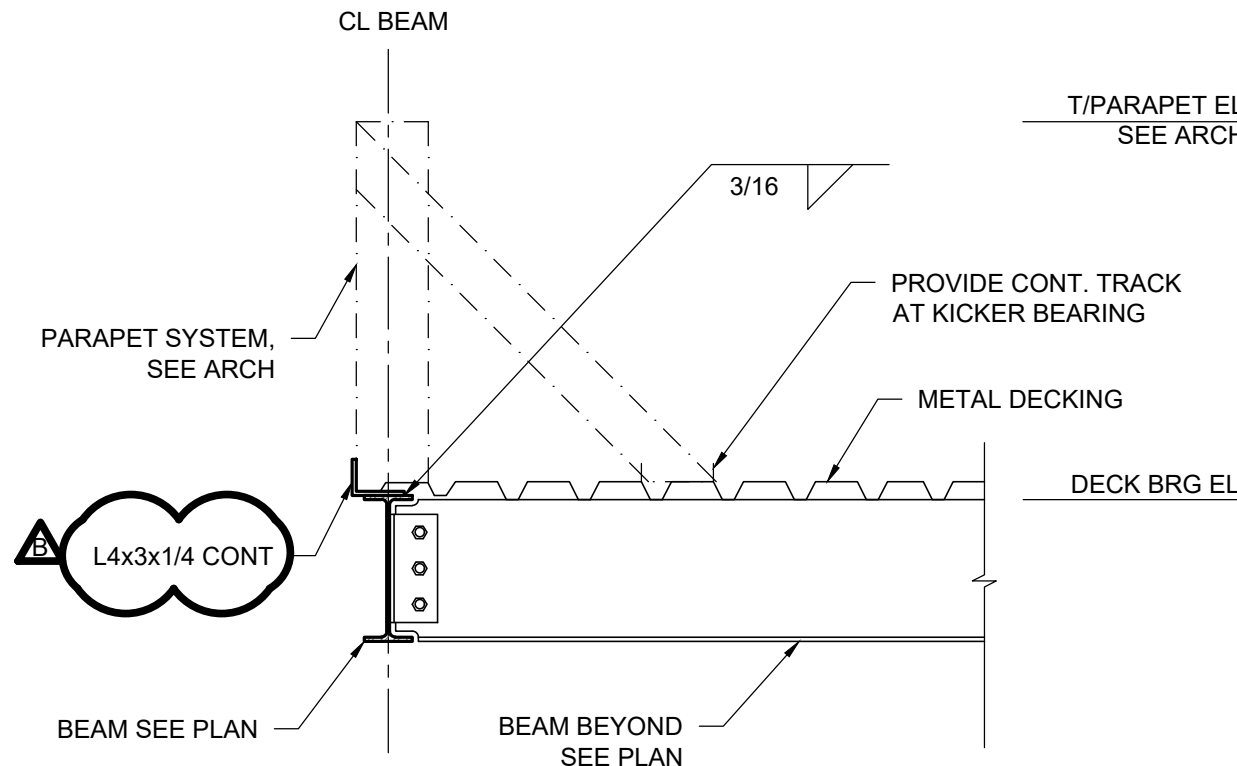


6
S502 TYPICAL PARAPET FRAMING (PERPENDICULAR)
3/4" = 1'-0"

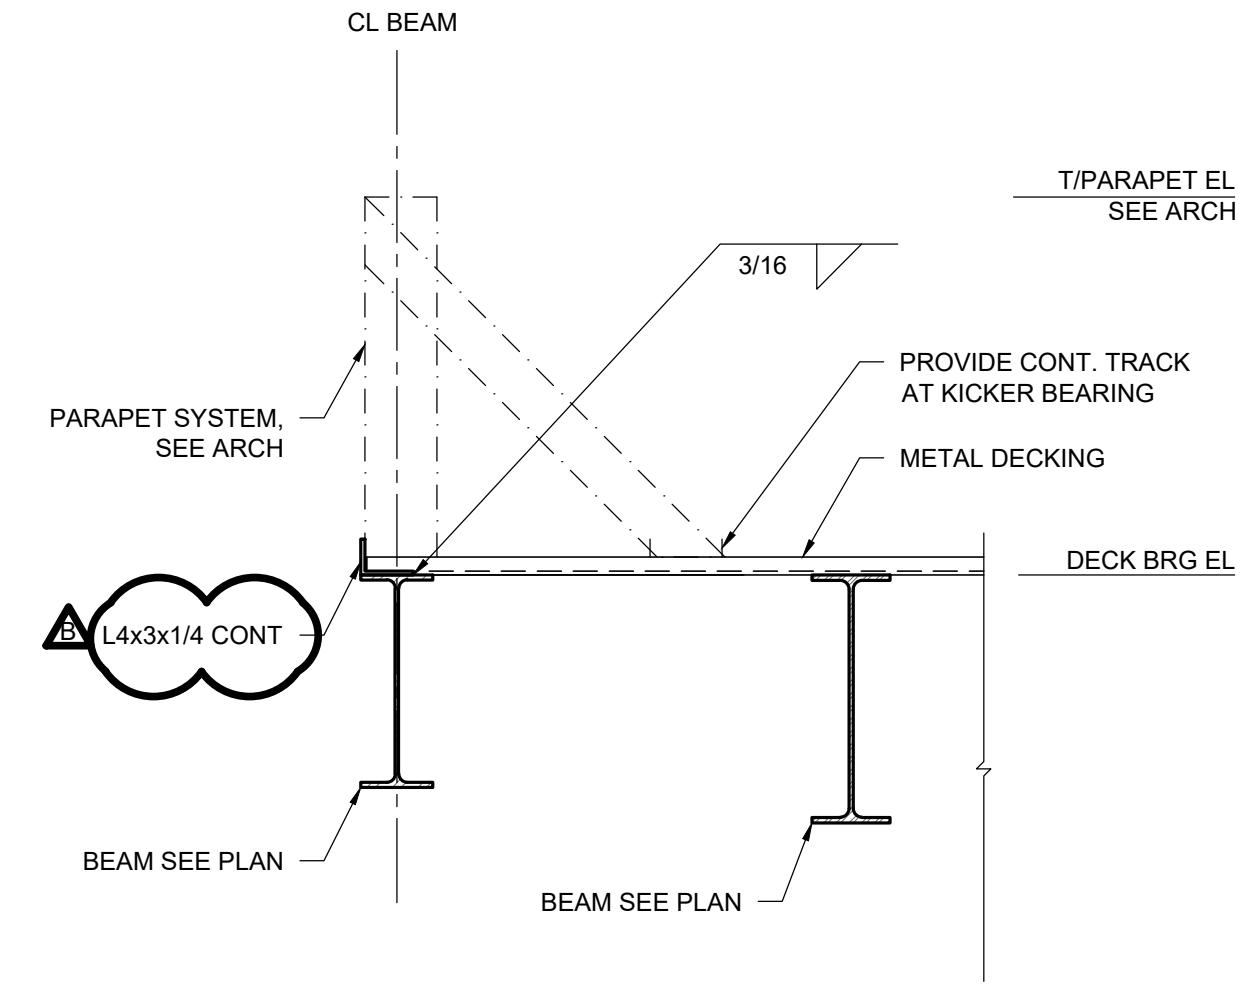


3
S502 TYPICAL PARAPET FRAMING (PARALLEL)
3/4" = 1'-0"

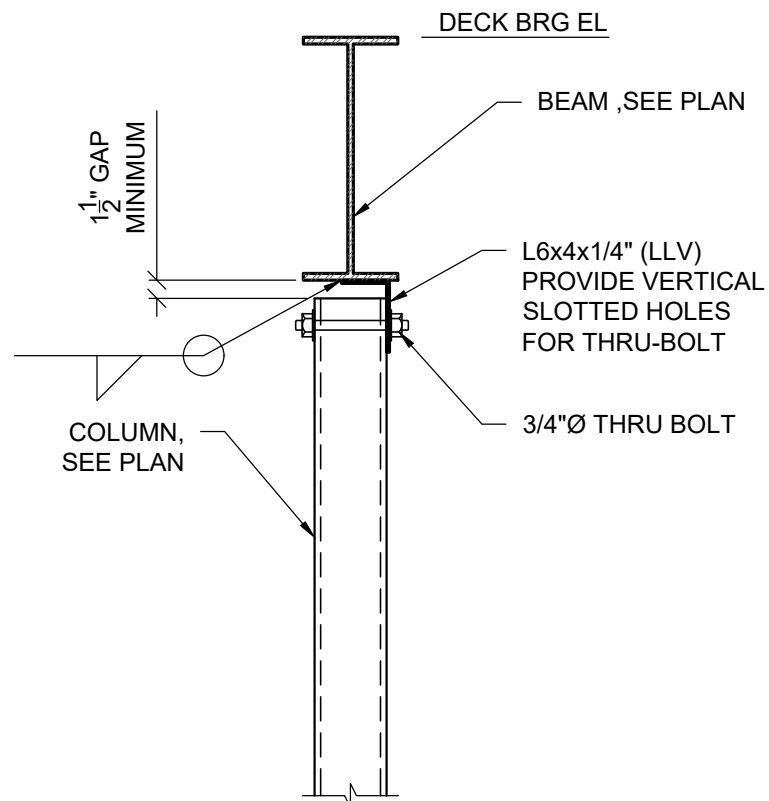


11
S502 COLUMN ATTACHMENT SECTION
3/4" = 1'-0"

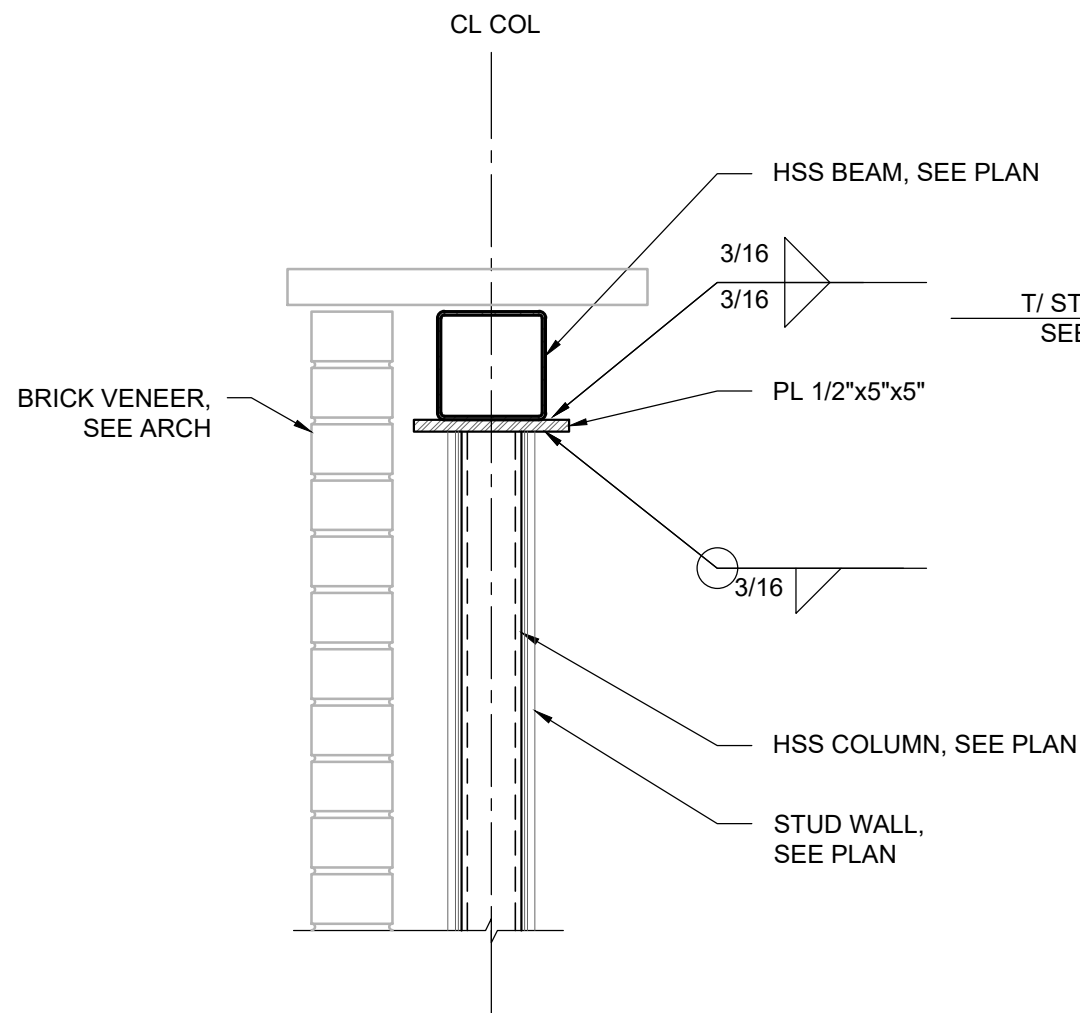


8
S502 HSS BEAM TO HSS POST CONNECTION
NO SCALE

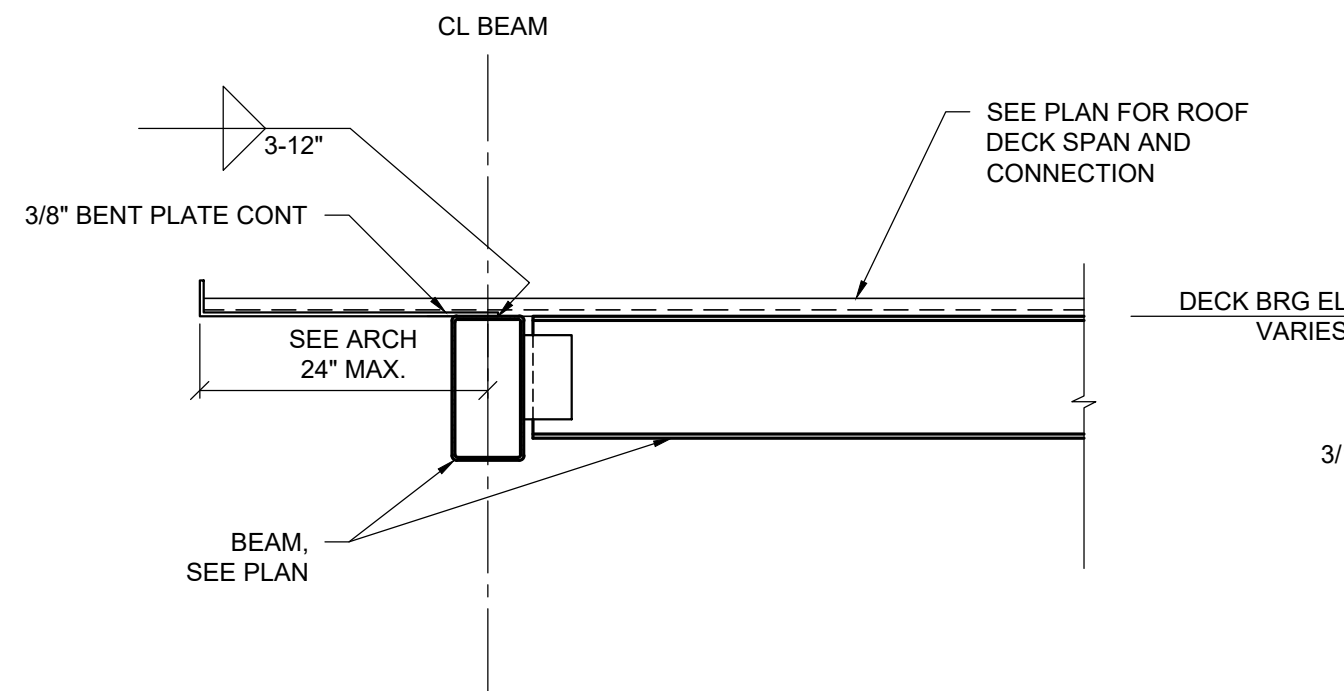


5
S502 SECTION AT ROOF DECK EDGE - PARALLEL
3/4" = 1'-0"

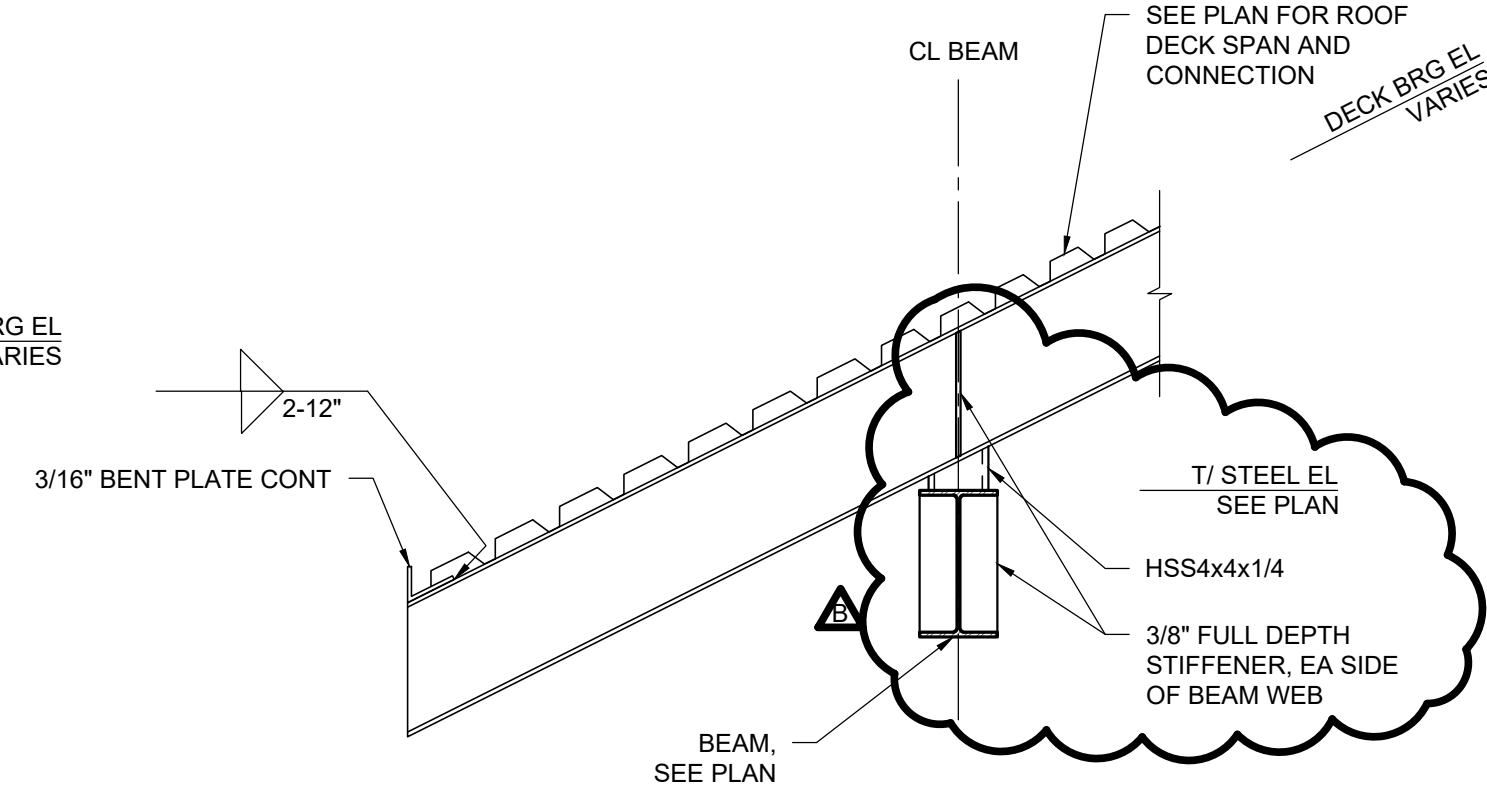


2
S502 SECTION AT ROOF DECK EDGE - PERPENDICULAR
3/4" = 1'-0"

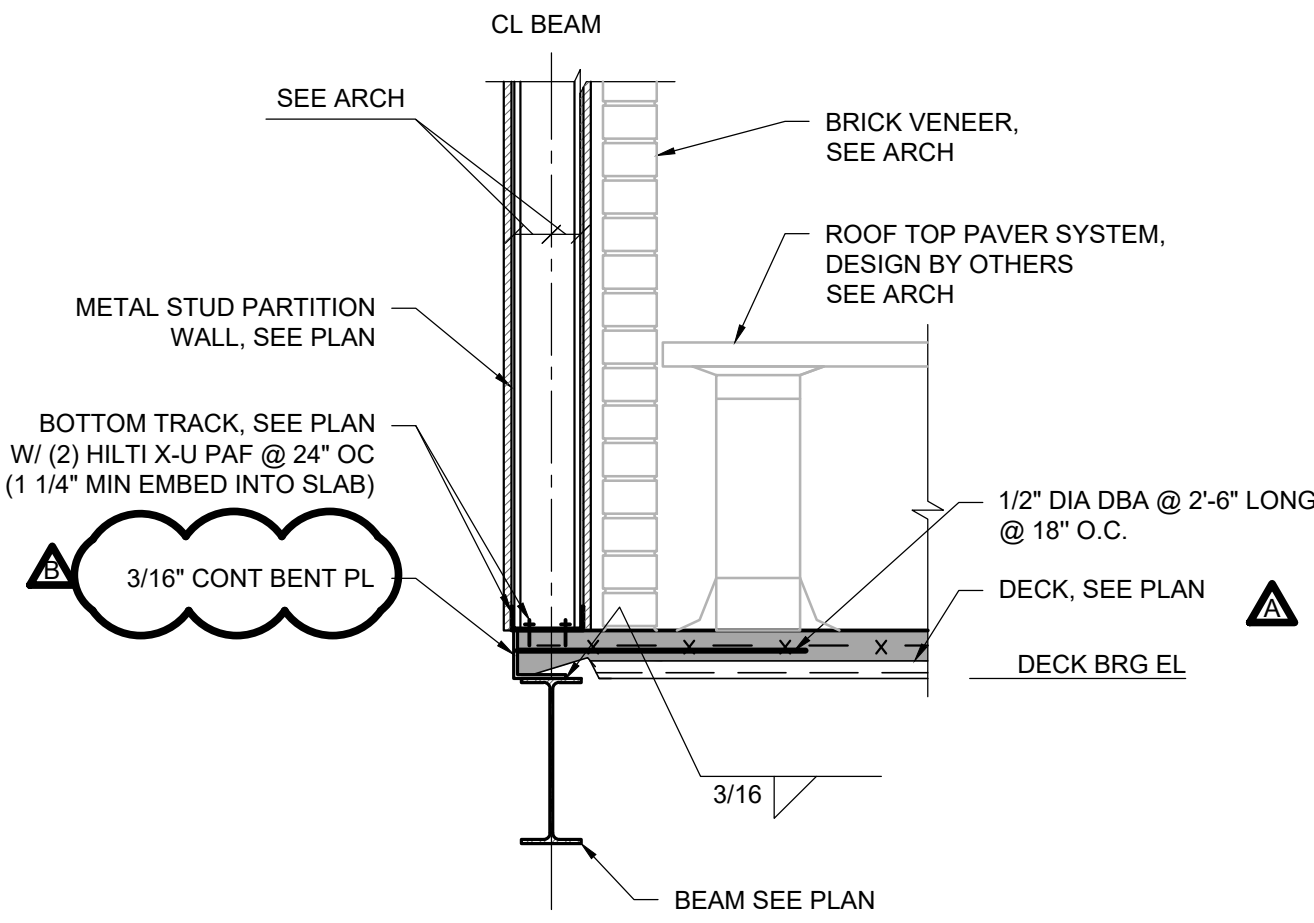


10
S502 DECK EDGE SECTION
3/4" = 1'-0"

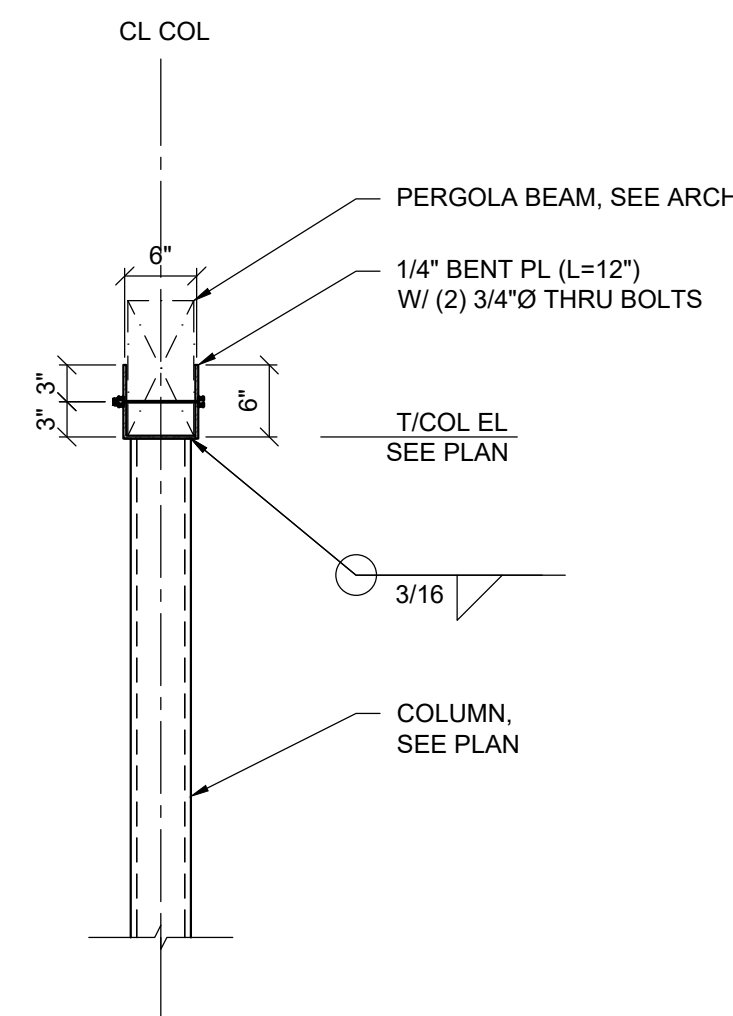

7
S502 TYPICAL ROOF PERGOLA CONNECTION DETAIL
3/4" = 1'-0"

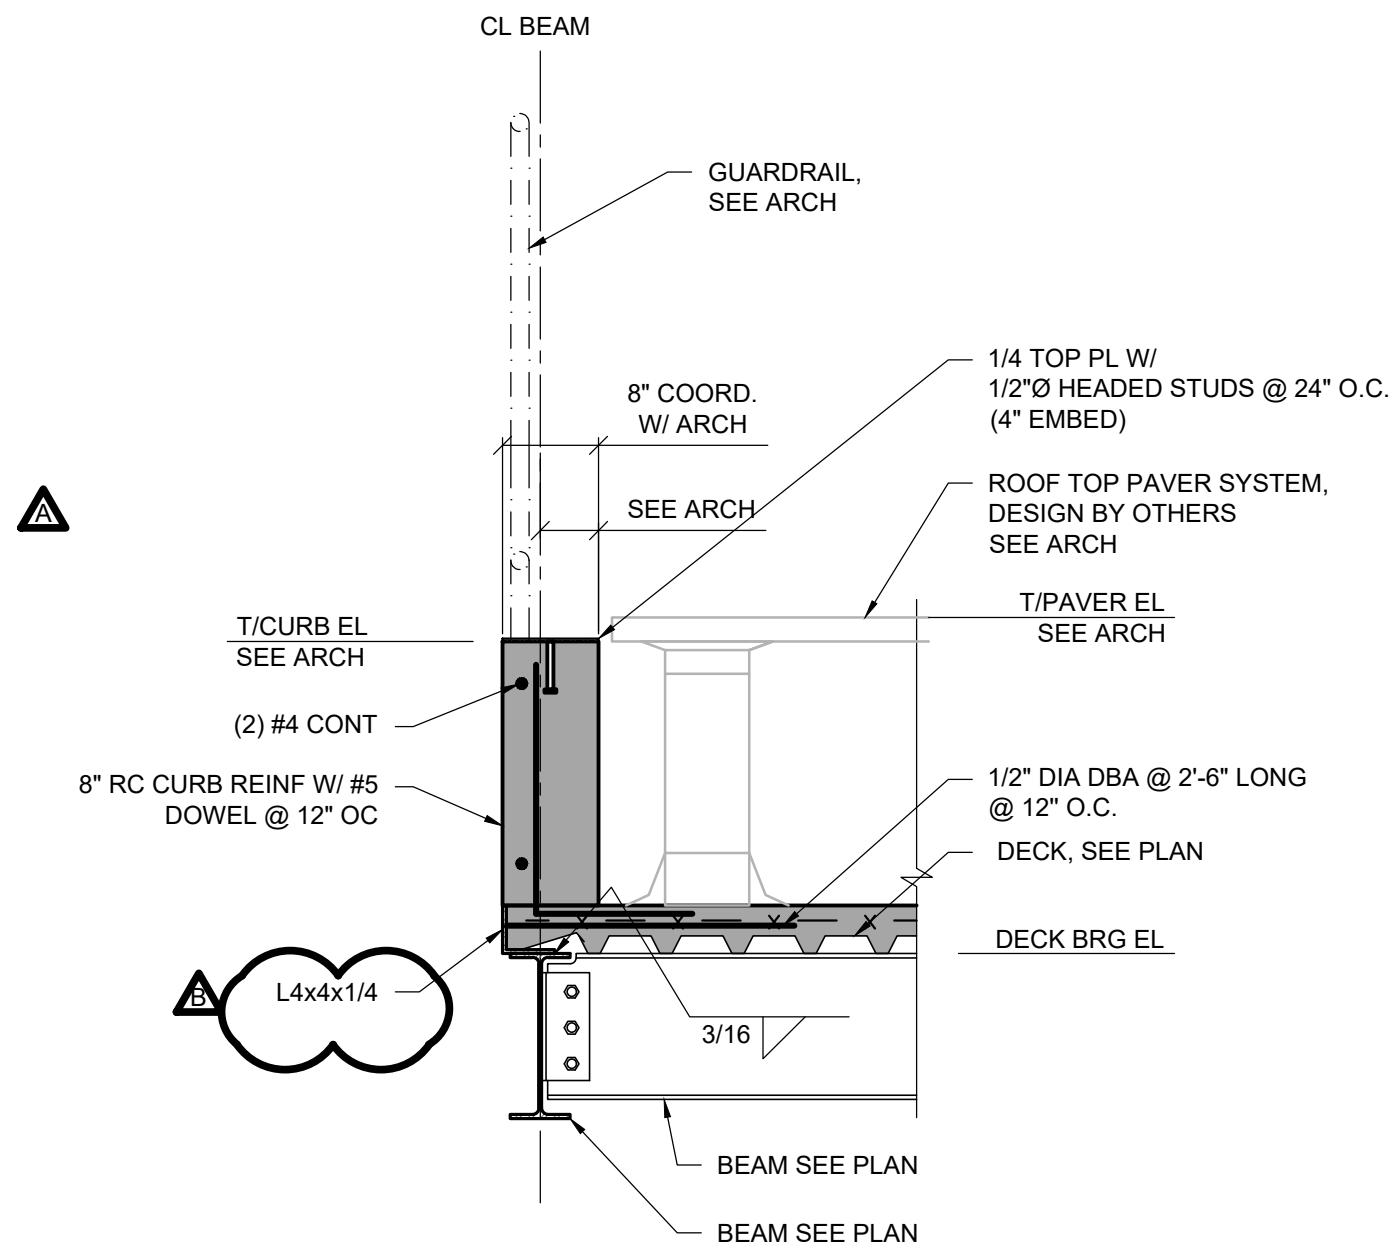

4
S502 TYPICAL CURB SECTION
3/4" = 1'-0"

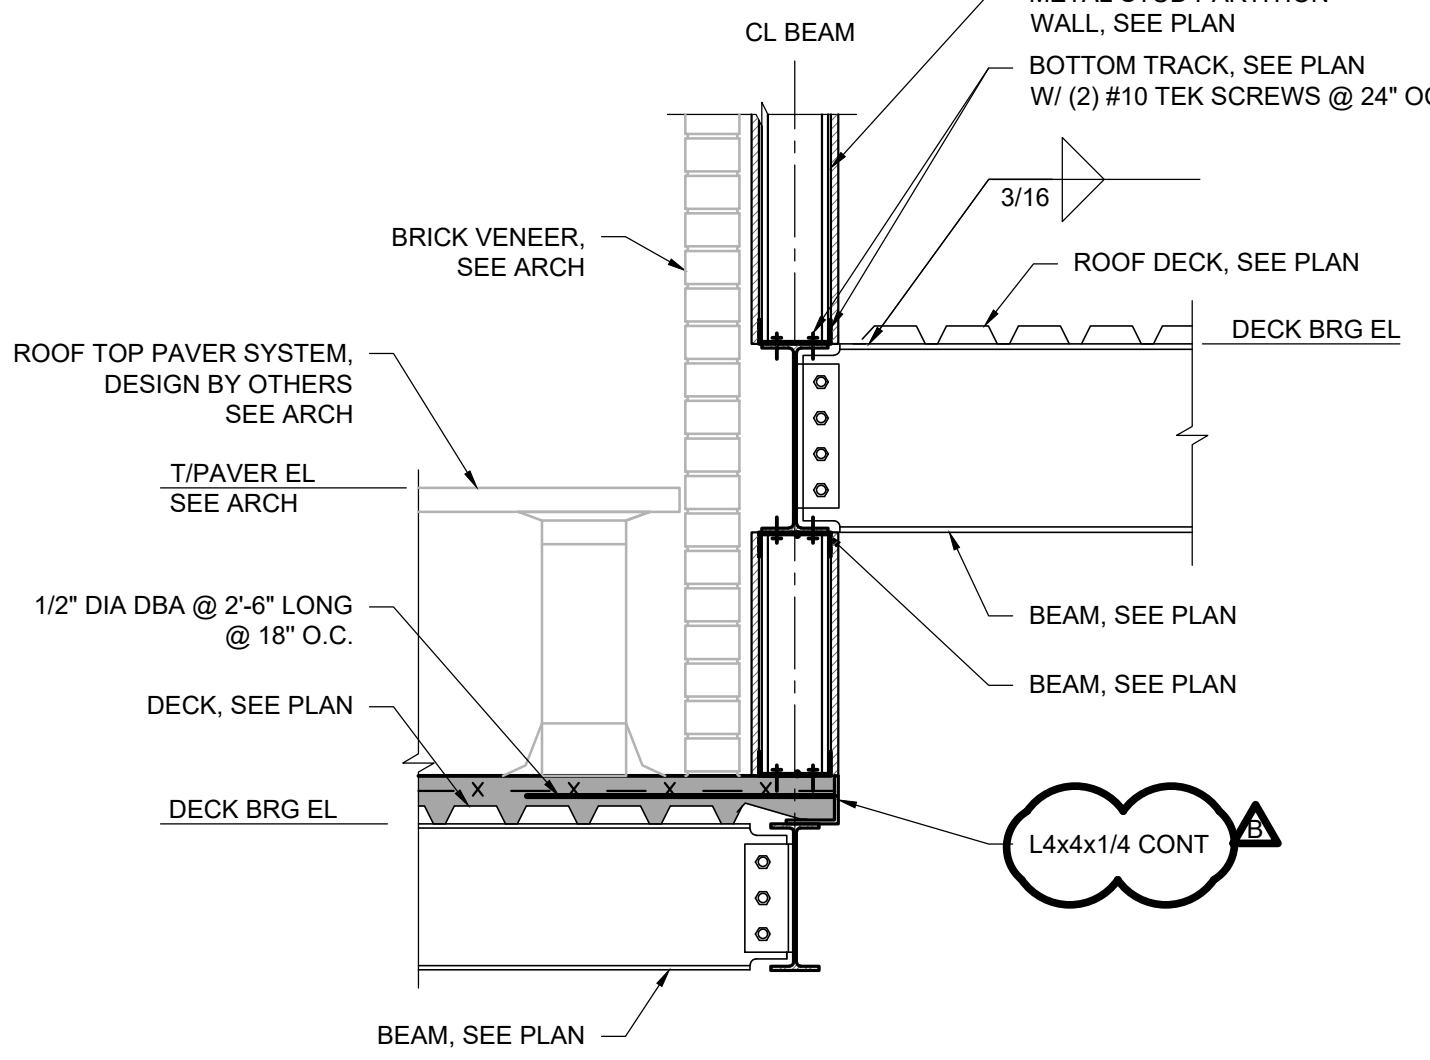

1
S502 DECK TRANSITION
3/4" = 1'-0"

ENGINEER:
FORESITE
group
Foresite Group, Inc.
3740 Davinci Ct.
Suite 100
Peachtree Corners, GA 30092
w | www.fg-inc.net
o | 770.368.1399
f | 770.368.1944

DEVELOPER:
CDCI
CONTRACT DESIGN CONCEPTS, INCORPORATED
COMMERCIAL DESIGN AND PLANNING SERVICES
3665 SWIFTWATER PARKWAY
SUITE 307
SUWANEE, GA 30024



PROJECT:
7 TEQUILAS MEXICAN RESTAURANT
NEW CONSTRUCTION
5586 OLD HIGHWAY 5 WOODSTOCK, GA 30188

SEAL:
PRELIMINARY - NOT FOR CONSTRUCTION

REVISIONS	DATE
ARCHITECTURAL REVISION	05/21/2021
G.C. SHOP DWG. COORD. 1	02/04/2022
G.C. SHOP DWG. COORD. 2	03/15/2022

PROJECT MANAGER: JMW
DRAWING BY: BJJ
JURISDICTION:
DATE: 01/29/2019
SCALE: AS SHOWN
TITLE:

FRAMING DETAILS
SHEET NUMBER: **S502**
COMMENTS:
JOB/FILE NUMBER: 1133.006

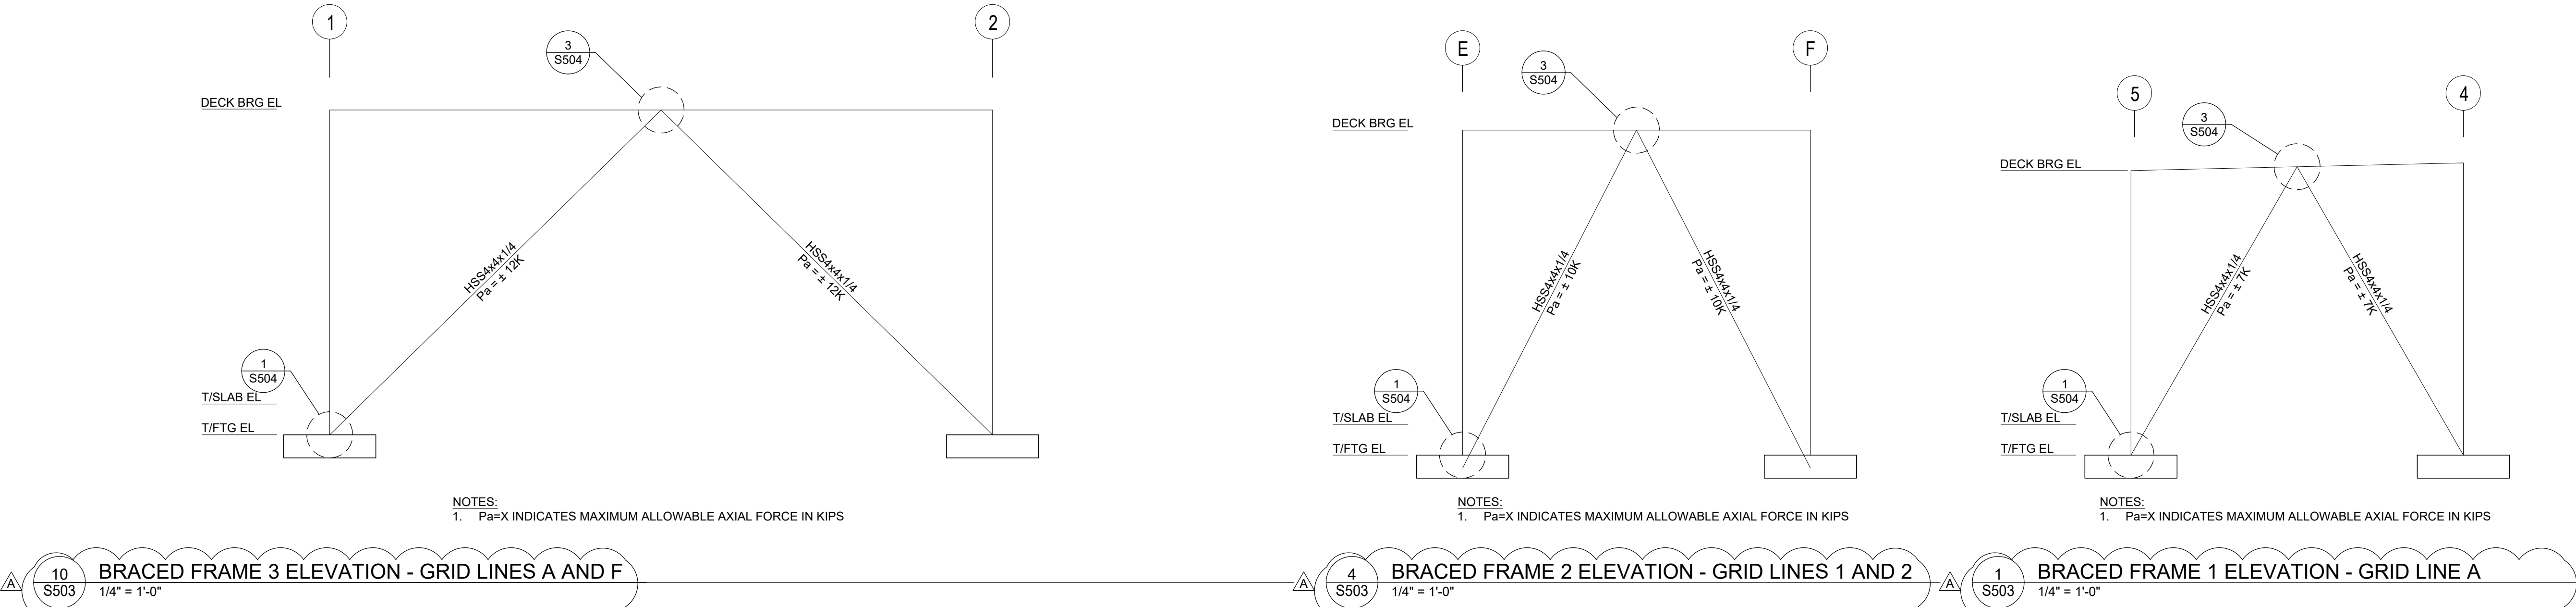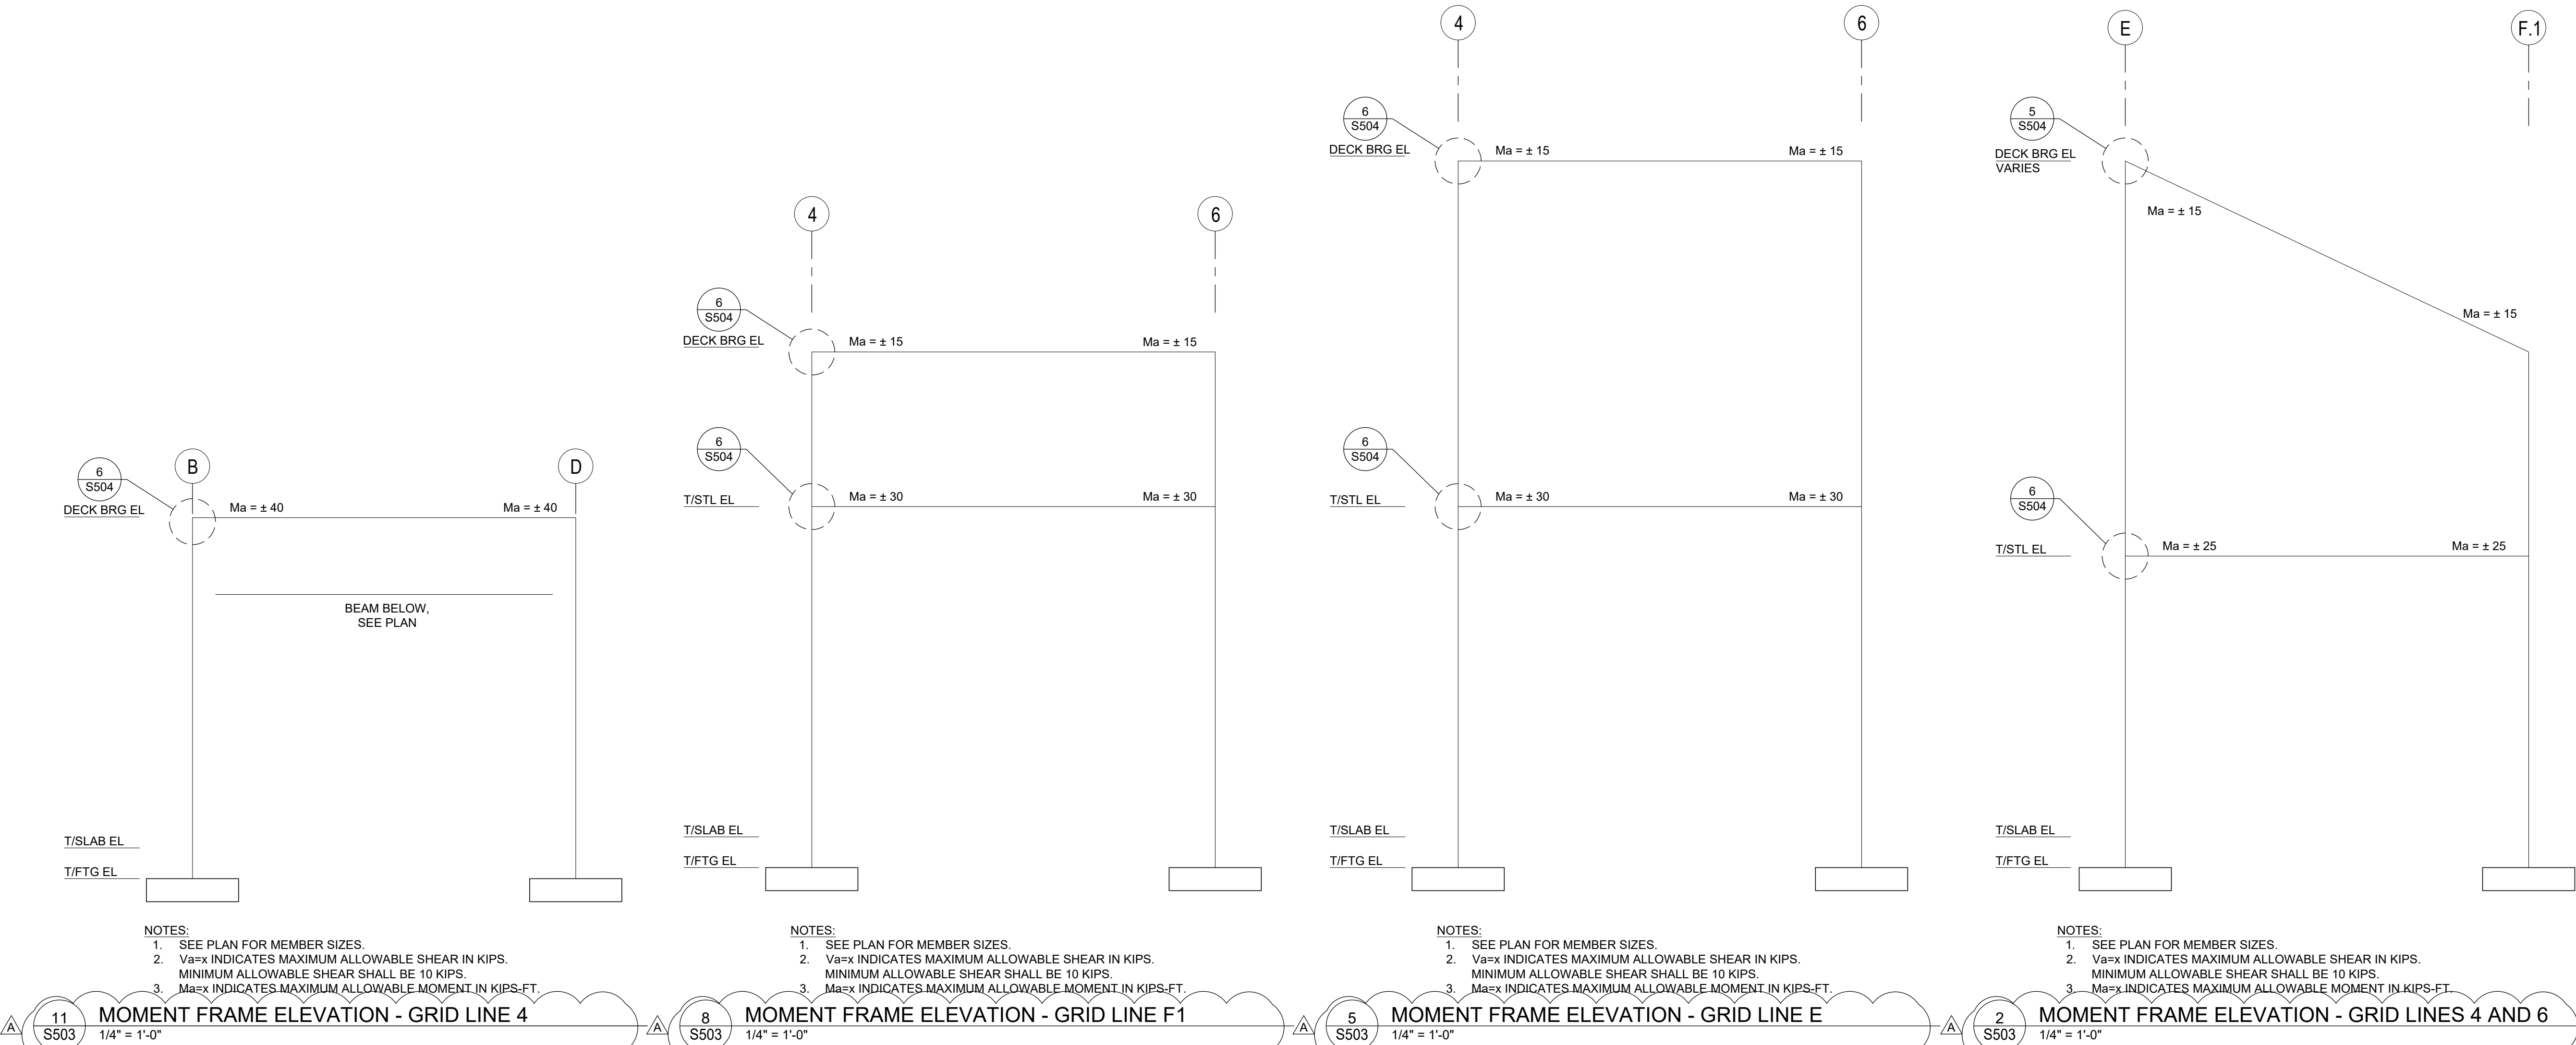

ENGINEER:

FORESITE
group

Foresite Group, Inc.
3740 Davinci Ct.
Suite 100
Peachtree Corners, GA 30092

w | www.fg-inc.net
o | 770.368.1399
f | 770.368.1944

DEVELOPER:

CDCI

CONTRACT DESIGN CONCEPTS INCORPORATED
ARCHITECT, ENGINEER AND PLANNING SERVICES

3665 SWIFTWATER PARKWAY
SUITE 307
SUWANEE, GA 30024

PROJECT:

7 TEQUILAS MEXICAN RESTAURANT
NEW CONSTRUCTION

5586 OLD HIGHWAY 5 WOODSTOCK, GA 30188

SEAL:

PRELIMINARY - NOT FOR CONSTRUCTION

REVISIONS

DATE

A G.C.SHOP DWG. COORD. 1 02/04/2022

PROJECT MANAGER: JMW

DRAWING BY: BJJ

JURISDICTION:

DATE: 01/29/2019

SCALE: AS SHOWN

TITLE:


**LATERAL FRAMING
DETAILS**

SHEET NUMBER:

S503


COMMENTS:

JOB/FILE NUMBER: 1133.006

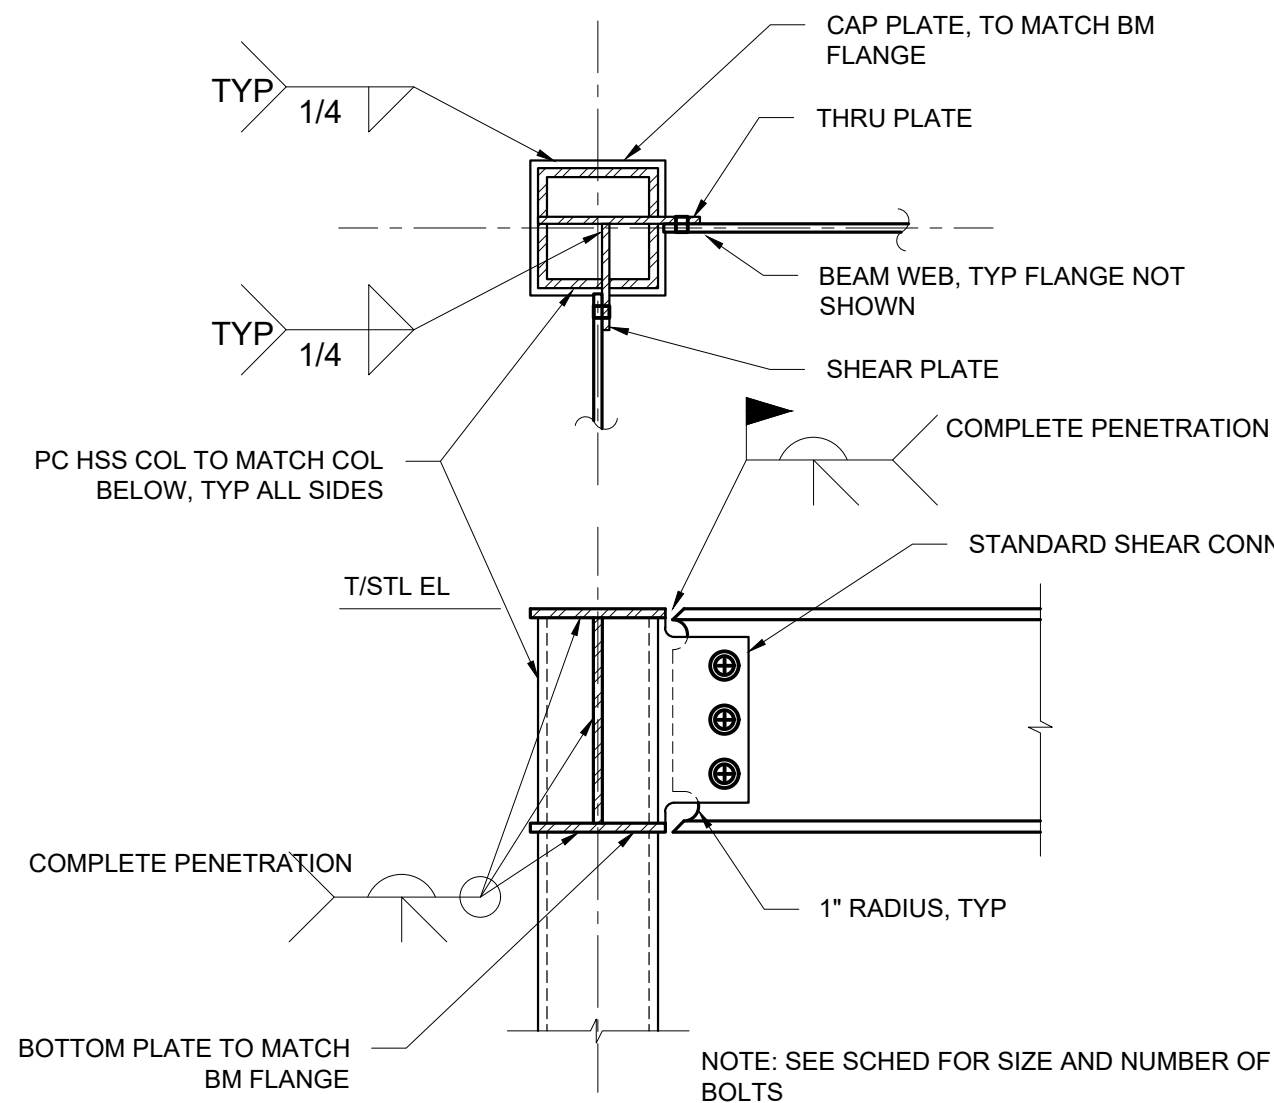

6
S504
TYPICAL TUBE COLUMN CONNECTION
(MOMENT CONNECTION)

3/4" = 1'-0"

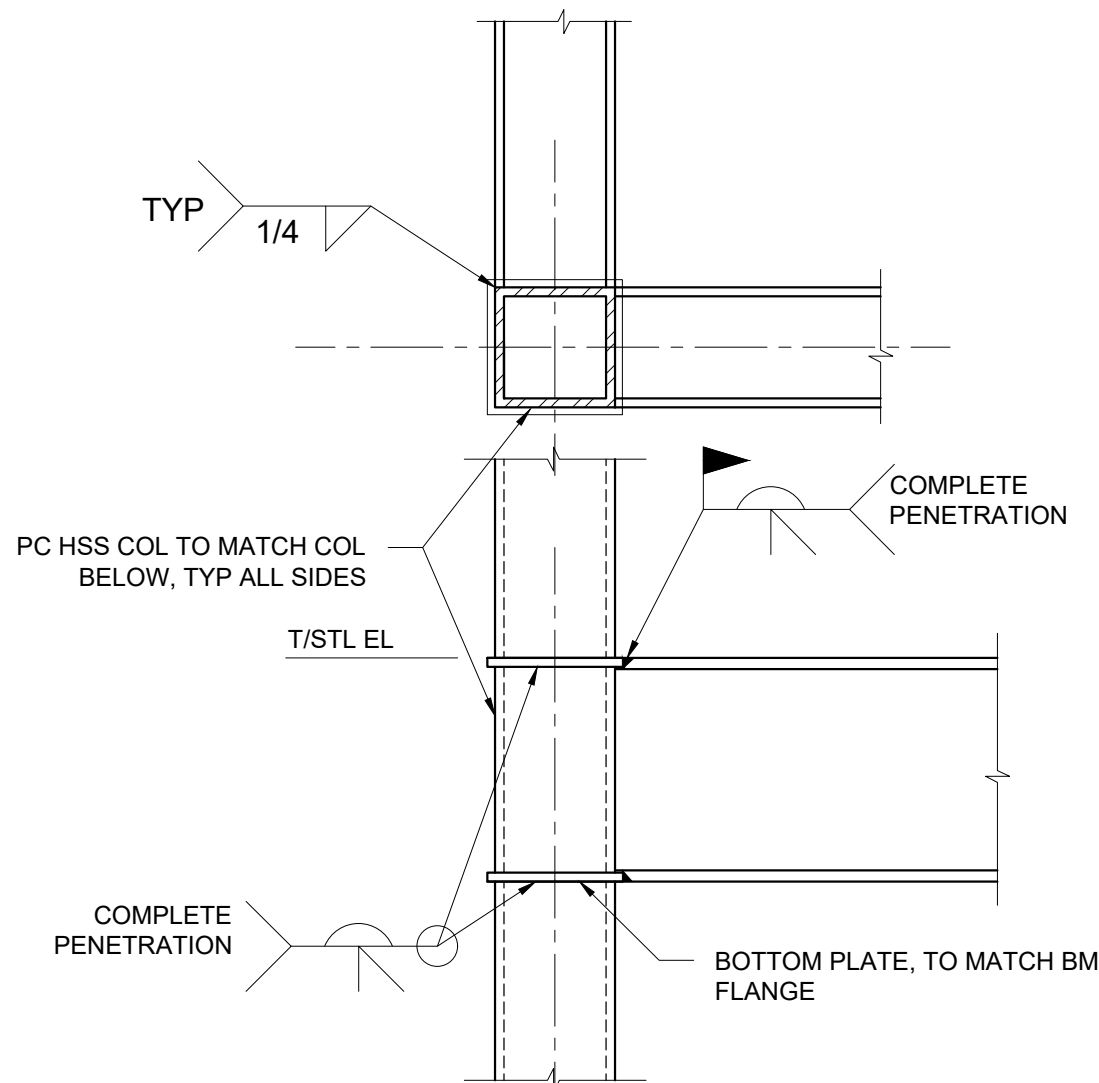


5
S504
TYPICAL TUBE COLUMN CONNECTION AT TUBE BEAM
(MOMENT CONNECTION)

3/4" = 1'-0"

STANDARD LINTEL SCHEDULE		
WALL SIZE	LINTEL TYPE	REMARKS
OPENINGS UP TO 6'-0"		
4" BRICK	L5x3 1/2x3/8", LLH	
4" BLOCK	4"x8" CONC W/ 1#4 T&B	
6" BLOCK	6"x8" CONC W/ 1#4 T&B	
8" BLOCK	8"x8" CONC W/ 2#4 T&B	
	8"x8" U-BLOCK W/ 1#5 T&B	
12" BLOCK	12"x8" CONC W/ 2#4 T&B	
	12"x8" U-BLOCK W/ 2#5 T&B	
OPENINGS 6'-0" TO 8'-0"		
4" BRICK	L5x5x3/8"	
8" BLOCK	8"x8" CONC W/ 2#4 T&B	
	8"x16" U-BLOCK W/ 1#6 T&B	
12" BLOCK	12"x8" CONC W/ 2#4 T&B	
	12"x16" U-BLOCK W/ 2#5 T&B	
OPENINGS 8'-0" TO 10'-0"		
4" BRICK	L6x6x3/8"	
6" BLOCK	6"x16" CONC W/ 2#5 T&B	#3 STIR @ 7" CONT
8" BLOCK	8"x8" CONC W/ 2#4 T&B	#3 STIR @ 7" CONT
12" BLOCK	12"x8" CONC W/ 2#4 T&B	#3 STIR @ 7" CONT


4
S504
STANDARD LINTEL SCHEDULE

3/4" = 1'-0"

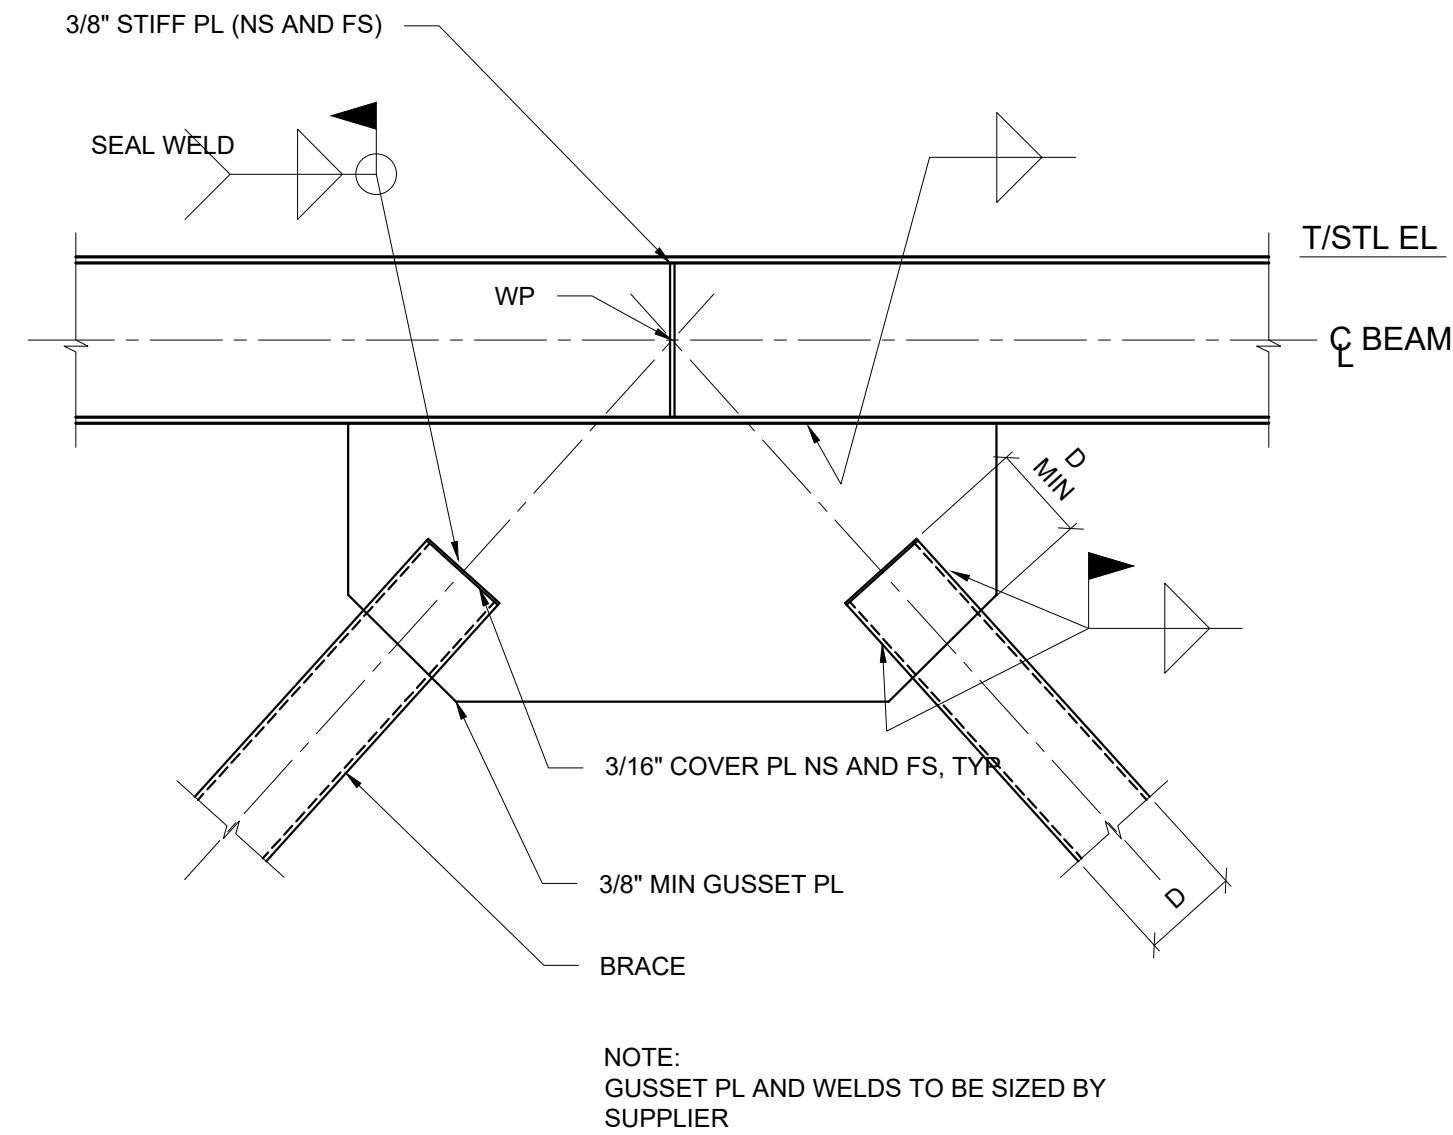

3
S504
TYPICAL VERTICAL BRACE AT BEAM (DOUBLE)

3/4" = 1'-0"

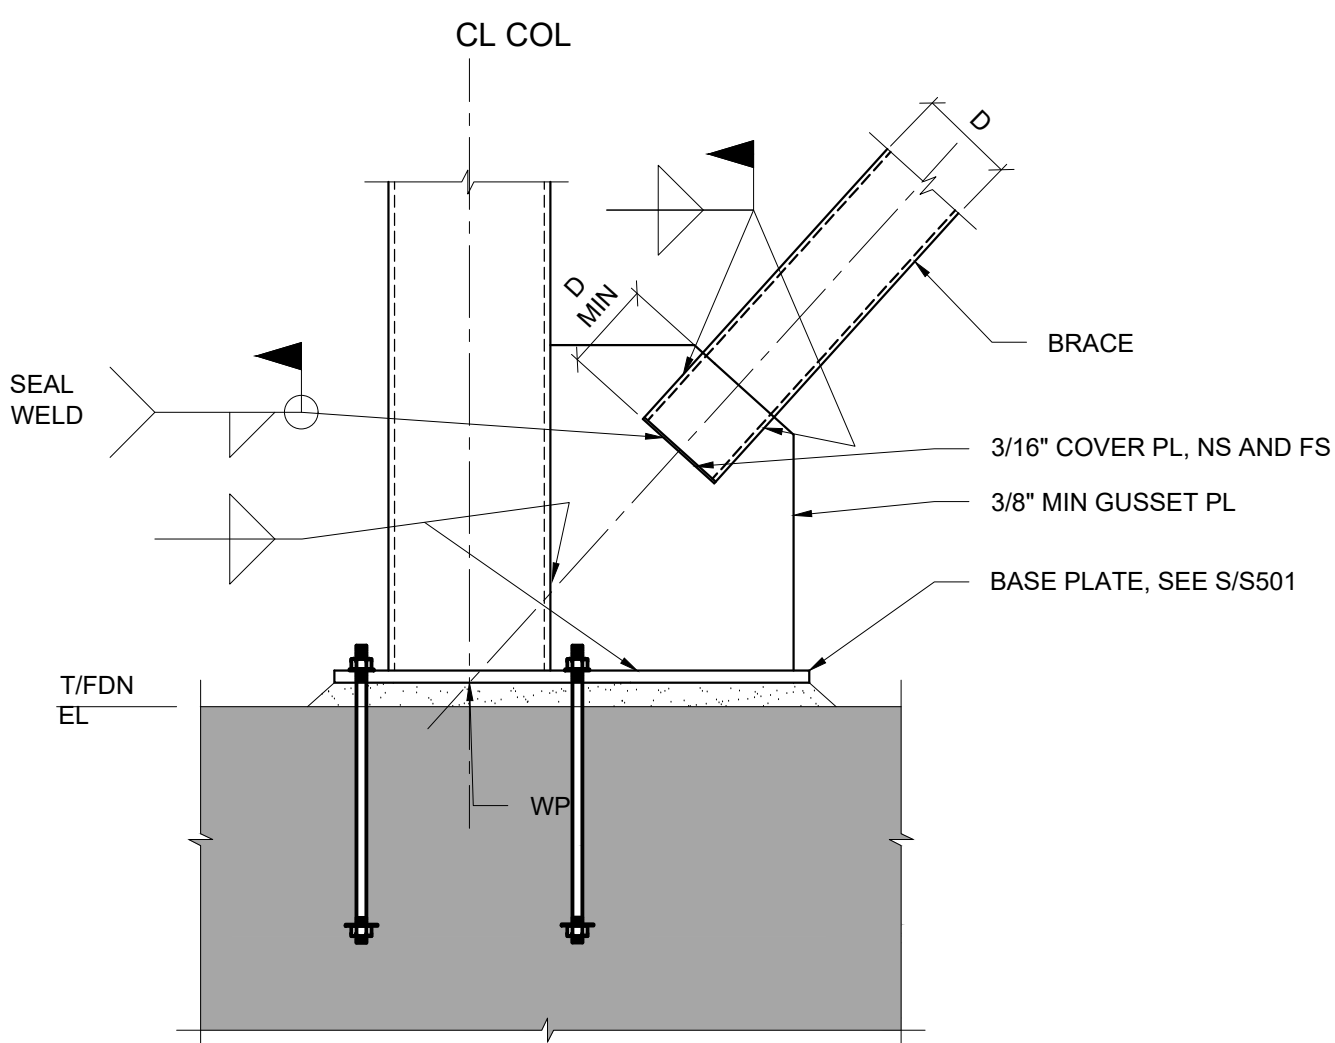

1
S504
TYPICAL VERTICAL BRACE AT FOUNDATION

3/4" = 1'-0"


ENGINEER:

FORESITE
group

Foresite Group, Inc.
3740 Davinci Ct.
Suite 100
Peachtree Corners, GA 30092

w | www.fg-inc.net
o | 770.368.1399
f | 770.368.1944

DEVELOPER:

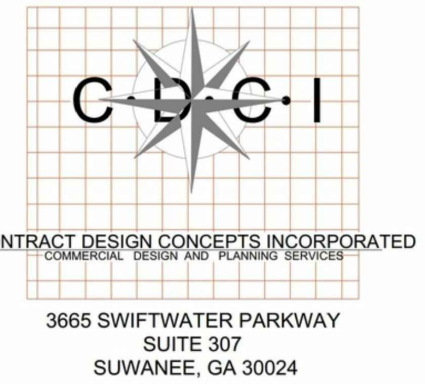

CONTRACT DESIGN CONCEPTS INCORPORATED
3665 SWIFTWATER PARKWAY
SUITE 307
SUWANEE, GA 30024

PROJECT:

7 TEQUILAS MEXICAN RESTAURANT
NEW CONSTRUCTION
5586 OLD HIGHWAY 5 WOODSTOCK, GA 30188

SEAL:

PRELIMINARY - NOT FOR CONSTRUCTION

REVISIONS

DATE

A G.C.SHOP DWG. COORD. 1 02/04/2022

PROJECT MANAGER:

JMW

DRAWING BY:

BJJ

JURISDICTION:

DATE: 01/29/2019

SCALE: AS SHOWN

TITLE:

LATERAL FRAMING
DETAILS

SHEET NUMBER:

S504

COMMENTS:

JOB/FILE NUMBER:

1133.006

HVAC LEGEND

(T)	THERMOSTAT
(S)	TEMPERATURE SENSOR
(C)	TIME CLOCK
(SD)	SMOKE DETECTOR
[X]	SUPPLY AIR REGISTER
[X] →	RETURN AIR REGISTER & EXHAUST REGISTER
A →	SIDEWALL SUPPLY AIR REGISTER
← A	SIDEWALL RETURN AIR REGISTER
A ↑	RISE IN DUCTWORK ELEVATION
A ↓	DROP IN DUCTWORK ELEVATION
—▲—	FIRE DAMPER
—●—	SMOKE DAMPER
—TSD—	COMBINATION FIRE/SMOKE DAMPER
[M] MO	MOTOR OPERATED DAMPER
[SP]	STATIC PRESSURE SENSOR IN DUCT
[BO]	BALANCING DAMPER
()	FLEXIBLE DUCTWORK
[]	FLEXIBLE CONNECTION
	LINEAR DIFFUSER
[G]	GAS COCK
G	GAS
D	CONDENSATE DRAIN
(A) NB NB	DIFFUSER TYPE SUPPLY AIR DIFFUSER AIRFLOW, CMH NECK SIZE
[A] NB	DIFFUSER TYPE RETURN AIR AIRFLOW, CMH NECK SIZE GRILLE/REGISTER

DESIGN CONDITIONS

SITE LOCATION:

WOODSTOCK, GA 30188
33.65° LAT., 84.42° LONG.
1033 FEET ELEVATION
ASHRAE 90.1-2013 CLIMATE ZONE 3A

DESIGN CONDITIONS:

18.8°F WINTER DESIGN DRY BULB (ASHRAE 99.6%)
93.9°F DRY BULB AND 74.8°F MEAN COINCIDENT WET BULB SUMMER DESIGN
(ASHRAE .4%)

70°F WINTER INDOOR DESIGN DRY BULB (HEATING)
75°F DRY BULB AND 50% RH INDOOR DESIGN (COOLING)

CALCULATIONS BASED ON ASHRAE DESIGN CRITERIA AND CALCULATION METHODOLOGY.

SHEET NUMBER	SHEET NAME	
M0.1	MECHANICAL NOTES, LEGEND, & ABBREVIATIONS	1
M0.2	MECHANICAL SCHEDULES	1
M1.1	LEVEL 1 FLOOR PLAN – MECHANICAL	1
M1.2	ROOF FLOOR PLAN – MECHANICAL	1
M3.1	MECHANICAL DETAILS	1
	TOTAL MECHANICAL SHEETS	5

ABBREVIATIONS			
AFF	ABOVE FINISHED FLOOR	HP	HORSEPOWER
BD	BALANCING DAMPER	HT	HEIGHT
CAP	CAPACITY	IH	INFRARED HEATER
CD	CEILING DIFFUSER	KW	KILOWATT
CENT	CENTRIFUGAL	L	LENGTH
CFH	CUBIC FEET PER HOUR	MAX	MAXIMUM
CFM	CUBIC FEET PER MINUTE	MBH	THOUSAND BTUH
COND	CONDENSING	MIN	MINIMUM
COP	COEFFICIENT OF PERFORMANCE	MOD	MOTOR OPERATED DAMPER
CU	CONDENSING UNIT	OA	OUTSIDE AIR
D	DRAIN	RA	RETURN AIR
DB	DRY BULB	RAR	RETURN AIR REGISTER
EAT	ENTERING AIR TEMPERATURE	RTU	ROOFTOP UNIT
EER	ENERGY EFFICIENCY RATIO	SA	SUPPLY AIR
EFF	EFFICIENCY	SAR	SUPPLY AIR REGISTER
ESP	EXTERNAL STATIC PRESSURE	SC	SENSIBLE CAPACITY
EXH	EXHAUST	SEER	SEASONAL ENERGY EFFICIENCY RATIO
F	FAHRENHEIT	SP	STATIC PRESSURE
F	FAN	SYS	SYSTEM
FCU	FAN COIL UNIT	T	THERMOSTAT
FD	FIRE DAMPER	TC	TOTAL CAPACITY
FT	FEET	TEMP	TEMPERATURE
G	GAS	TH	TYPICAL
GFU	GAS FIRED UNIT	UH	UNIT HEATER
H	HOOD	V	VOLTS
HC	HEATING CAPACITY	W	WIDTH
HP	HEAT PUMP	WB	WET BULB
		WC	WATER COLUMN

1. TOTAL SYSTEM BALANCE SHALL BE PERFORMED IN ACCORDANCE WITH THE 5TH EDITION OF THE ASRC NATIONAL STANDARDS, INCLUDING, BUT NOT LIMITED TO, THE FOLLOWING: (1) THE SCOPE OF WORK DEFINED BY THE CONTRACT DOCUMENTS.
2. TESTING AND BALANCE AGENCY AS PART OF ITS CONTRACT SHALL ACT AS AUTHORIZED INSPECTION AGENCY RESPONSIBLE TO THE OWNER, AND SHALL DURING THE TEST AND BALANCE, LIST SYSTEMS THAT ARE INSTALLED INCORRECTLY, REGARDLESS OF SYSTEM BALANCE, AND BE INSTALLED IN ACCORDANCE WITH CONTRACT DRAWINGS AND SPECIFICATIONS.
3. TESTING AND BALANCING SHALL NOT BEGIN UNTIL ALL SYSTEMS HAVE BEEN COMPLETED AND ARE IN FULL WORKING ORDER. THE MECHANICAL CONTRACTOR SHALL PUT ALL HEATING, VENTILATING, AND AIR CONDITIONING EQUIPMENT INTO FULL OPERATION AND TEST EACH SYSTEM SEPARATELY AT THE SAME DURING EACH WORKING DAY OF TESTING AND BALANCING.

1. DUCTWORK, EXCEPT WHERE OTHERWISE SPECIFIED HEREIN, AND APPARATUS CASINGS SHALL BE CONSTRUCTED OF GALVANIZED STEEL IN ACCORDANCE WITH SMACNA HVAC DUCT.

1. DUCT INSULATION SHALL BE 1" THICK, 1-1/2" LB./CUBIC FOOT DENSITY FIBER GLASS INSULATION WITH TERMOSETTING RESIN AND VAPOR BARRIER, "K" VALUE NOT TO EXCEED 0.25.
2. INSULATION AND ADHESIVE SHALL HAVE A COMPOSITE FLAME SPREAD RATING 25 AND A COMPOSITE SMOKE-DEVELOPED RATING OF NOT MORE THAN 50.
3. INSULATION SHALL COMPLY WITH ASTM C553 AND BE PROVIDED WITH FACTORY-APPLIED FSK JACKET.
4. SECURE INSULATION WITH ADHESIVE AND STICK PINS.
5. PROVIDE INSULATION ON SUPPLY AIR DUCTWORK.

1. INSULATE THE SUCTION LINE WITH RIGID 1" POLYURETHANE FOAM.

1. DUCT LINER SHALL BE 1-1/2" THICK, 1-1/2" LB./CUBIC FOOT, DENSITY FIBER GLASS INSULATION WITH NEOPRENE FACING. MINIMUM INSTALLED R-VALUE = 5.
2. LINER, FACING, AND ADHESIVE SHALL HAVE A COMPOSITE FLAME SPREAD RATING OF 25 AND A COMPOSITE SMOKE-DEVELOPED RATING OF NOT MORE THAN 50.
3. LINER SHALL MEET EROSION TEST DESCRIBED IN UL 181-1981.

1. DAMPERS SHALL BE CONSTRUCTED IN ACCORDANCE WITH SMACNA HVAC DUCT CONSTRUCTION STANDARDS, 2005 EDITION.
2. PROVIDE SINGLE-BLADE DAMPER UP TO SIX (6) INCHES IN WIDTH. PROVIDE MULTIBLADE OPPOSED BLADE DAMPER ABOVE SIX (6) INCHES IN WIDTH.
3. DAMPER AND BEARINGS SHALL BE SIMILAR TO VENTLOCK NO. 609; DIAL REGULATOR SHALL BE SIMILAR TO VENTLOCK NO. 637, 638, AND 639 WITH COLLAR TO CLEAR INSULATION THICKNESS INSTALLED ON DUCTWORK.

1. ALL SYSTEMS AND COMPONENTS SHALL BE PROVIDED WITH A ONE (1) YEAR WARRANTY FROM THE TIME OF FINAL ACCEPTANCE UNLESS OTHERWISE NOTED IN THE CONTRACT DOCUMENTS. {COORDINATE WITH THE ARCHITECT}. THE WARRANTY SHALL COVER ALL MATERIALS AND WORKMANSHIP. DURING THIS WARRANTY PERIOD, ALL DEFECTS IN MATERIALS AND WORKMANSHIP SHALL BE CORRECTED BY REPAIR OR REPLACEMENT WITHOUT INCURRING ANY ADDITIONAL COST TO THE CONTRACT.

1. EACH ITEM OF EQUIPMENT SHALL BE PERMANENTLY LABELED WITH A NAMEPLATE OF SUFFICIENT SIZE TO CLEARLY INDICATE THE IDENTIFICATION DESIGNATION (I.E., EQUIPMENT NUMBER) APPEARING ON THE CONTRACT DOCUMENT. NAMEPLATES MAY BE 1/16" THICK BAKELITE LAMINATE (ENGRAVED WITH LETTERS THROUGH BLACK), OR ALUMINUM WITH BLACK ENAMELED SURFACE, WITH ENGRAVED LETTERS. HANDWRITTEN MARKER IDENTIFICATIONS ARE NOT ACCEPTABLE.

1. PROVIDE ELECTRONIC SET OF MANUFACTURER'S DATA, O&M MANUALS, SUBMITTALS SHALL INCLUDE ELECTRICAL DATA, DIMENSIONAL DATA AND CLEARANCES AND CONNECTION DATA.
2. PROVIDE SUBMITTALS FOR ROOFTOP UNITS, FANS, AND AIR DISTRIBUTION DEVICES.
3. SHOP DRAWINGS SHALL BE SUBMITTED AND APPROVED PRIOR TO ORDERING OF EQUIPMENT. ENGINEER WILL REQUIRE 7 WORKING DAYS TO REVIEW DRAWINGS AND SUBMITTALS.

1. FAN SHALL BE CEILING MOUNTED, DIRECT DRIVE, CENTRIFUGAL EXHAUST FAN.
2. FAN SHALL BE MANUFACTURED AT AN ISO 9001 CERTIFIED FACILITY. FAN SHALL BE LISTED BY UNDERWRITERS LABORATORIES (UL 705) AS A TYPE FOR USE FOR EXHAUSTING FOR AN ALUMINUM BRACKET DAMPER WITH CONTINUOUS ALUMINUM HINGE ROD. THE INLET BOX SHALL BE:
3. THE FAN WHEEL HOUSING AND INTEGRAL OUTLET DUCT SHALL BE INJECTION MOLDED FROM A SPECIALLY ENGINEERED RESIN EXCEEDING UL REQUIREMENTS FOR SMOKE AND HEAT GENERATION. THE OUTLET ADJUST KNUCKLE SHALL BE PROVIDED FOR AN ALUMINUM BRACKET DAMPER WITH CONTINUOUS ALUMINUM HINGE ROD. THE INLET BOX SHALL BE:
4. BE BIRMINGHAM 22 GAUGE GALVANIZED STEEL. MOTOR SHALL BE ISOLATION MOUNTED TO A ONE PIECE GALVANIZED STAMPED STEEL INTEGRAL MOTOR MOUNT/INLET. A FIELD WIRING COMPARTMENT WITH DISCONNECT RECEPTACLE SHALL BE STANDARD. TO ACCOMMODATE DIFFERENT FIELD WIRING, A 1/2" DIA. NPT FEMALE ADAPTER WITH MOUNTING BRACKET SHALL BE PROVIDED. A WHITE, HIGH IMPACT STYRENE INJECTION MOLDED GRILL SHALL BE PROVIDED AS STANDARD. SHALL BE CEILING MOUNTED. PROVIDOR FOR FIELD CONNECTION FROM CEILING TO IN-LINE. UNIT SHALL BE SHIPPED IN ISIA CERTIFIED TRANSIT TESTED PACKAGING.
5. WHEEL SHALL BE CENTRIFUGAL FORWARD CURVED TYPE. INJECTION MOLDED OF POLYPROPYLENE RESIN. WHEEL SHALL BE BALANCED IN ACCORDANCE WITH ASHRAE STANDARD 204-05, BALANCE QUALITY AND VIBRATION LEVELS FOR FANS.

1. PACKAGED, AIR-COOLED, CONSTANT VOLUME DRAW-THROUGH TYPE, COMPLETE WITH HERMETIC COMPRESSORS, CYLINDER HEADS, VALVES, SIGHT GLASS, CONDENSER, MOTOR, WINDING, SPRING VIBRATION ISOLATORS, COMPRESSOR ARMOR LOCKOUT, CRANKCASE HEATERS, OIL SIGHT GLASS, REFRIGERANT SIGHT GLASS, HIGH PRESSURE, HIGH TEMPERATURE, HIGH VIBRATION PRESSURE RELIEF VALVE OR FUSIBLE PLUG, TIME DELAY BETWEEN SUCCESSIVE STARTS OF EACH COMPRESSOR, PROTECTION AGAINST OVERHEATING, HIGH TEMPERATURE, HIGH VIBRATION RESET LOW OIL PRESSURE CUTOFF FOR EACH COMPRESSOR, HIGH VIBRATION RESET LOW OIL PRESSURE CUTOFF FOR EACH CONDENSER, MOTOR OVERLOAD PROTECTOR AND WINDING THERMOSTATS, REFRIGERANT SOLENOID VALVES, AIR-COOLED CONDENSER, COILS, FANS, MOTOR, WINDING, THERMOSTATS, COMPRESSORS, EVAPORATOR COILS, FANS, MOTORS, EXTENDED FAN GRADE CONNECTIONS, FILTER SECTION, STAINLESS STEEL, HIGH VIBRATION SECTION, AND HIGH AND LOW PRESSURE SAFETY CONTROLS.

A. TESTED IN ACCORDANCE WITH ANSI/ASHRAE 51/AMCA 210-1999.

B. STATICALLY AND DYNAMICALLY BALANCED.

C. BEARINGS: PILLOW BLOCK OR FLANGE TYPE WITH L10 LIFE OF 40000 HOURS AT THE PEAK OPERATING CONDITION. EXTEND GREASE LADS TO CASING EXTERIOR TO ALLOW LUBRICATION DURING OPERATION.

D. IN DRIFT THROUGH THE CENTER OF CENTRIFUGAL FANS, FAN WHEEL ROTATION SHALL BE IN THE SAME DIRECTION AS FLOW IN ELBOWS INSTALLED WITHIN 3 DUCT DIAMETERS OF THE FAN DISCHARGE, WHERE DISCHARGE FROM THE ELBOW IS PERPENDICULAR TO THE FAN SHAFT.

E. CONSIDERS: SELECTION OF A CONDENSING TEMPERATURE NOT TO EXCEED 120°F AT 100% AMBIENT. COILS SHALL HAVE COPPER TUBES AND ALUMINUM FINS.

1. FACTORY-FABRICATED ROOF CURBS SHALL BE CONSTRUCTED OF ALUMINUM AND SHALL BE 14" HIGH. CURBS SHALL BE CANAL-INSULATED TYPE AND SHALL BE FIELD-GLAZED TO MAKE WATERTIGHT. FIELD FLASHING SHALL EXTEND UP THE SIDES OF THE CURB WITH WASHERS AND SHEET METAL SCREWS PLACED NOT MORE THAN 12" ON CENTERS BUT IN NO CASE USING LESS THAN TWO (2) SCREWS PER SIDE. CURB SHALL HAVE A 2" THICK RIGID INSULATION; INSULATION EXPOSED TO THE RETURN AIR PLENUM SHALL HAVE A SMOKE DEVELOPED RATING NOT TO EXCEED 15 AND A FLAME SPREAD RATING NOT TO EXCEED 10. TESTED AND APPROVED BY AN AIA-REGISTERED ENGINEER. STRIPS ARE REQUIRED. COORDINATE THE INSTALLATION OF ROOF CURBS WITH THE ROOF INSTALLER.

IN GENERAL, PLANS AND DIAGRAMS ARE SCHEMATIC ONLY AND SHOULD NOT BE SCALED.

INTENT OF THESE NOTES AND MECHANICAL NOTES ON DRAWINGS IS TO CLARIFY THE SCOPE OF WORK AND ALERT CONTRACTOR TO EXISTING CONDITIONS. CONTRACTOR TO VISIT SITE AND VERIFY ALL DIMENSIONS SHOWN ON DRAWINGS. CONTRACTOR TO PROVIDE ADDITIONAL OFFSET AND/OR CHANGES IN DUCT SIZE TO MEET FIELD CONDITIONS AND COORDINATE WITH ELECTRICAL, PLUMBING AND FIRE PROTECTION SUBCONTRACTOR BEFORE ANY CONSTRUCTION WORK.

THE GENERAL CONTRACTOR IS RESPONSIBLE FOR ALL TRADES INSTALLATION SCHEDULES, FIXED OR FLEXIBLE DUCTWORK, AIR DISTRIBUTION, DUCTWORK, AND ALL OTHER TRADE WORK THAT CAN BE EASILY RELOCATED OR OFFSET SUCH AS ELECTRICAL CONDUITS, SMALL WATER LINES ETC. UNLESS OTHERWISE NOTED, INSTALL DUCTWORK AS HIGH AS POSSIBLE, TIGHT TO BOTTOM OF STRUCTURE. COORDINATE DUCT ELEVATION WITH WATER PIPING, SANITARY DRAINS AND MAJOR ELECTRICAL CONDUITS.

CONTRACTOR SHALL PROVIDE ALL SUPPLEMENTARY SLIP REQUIRED TO SUSPEND MECHANICAL EQUIPMENT AND MATERIALS.

ALL MECHANICAL WORK SHALL MEET ALL THE REQUIREMENTS OF, BUT NOT LIMITED TO THE 2019 INTERNATIONAL MECHANICAL HANG CODE WITH GEORGIA AMENDMENTS.

DUCT DIMENSIONS SHOWN ON DRAWINGS ARE CLEAR INSIDE DIMENSIONS. INTERNAL INSULATION (WHERE USED) HAS NOT BEEN ACCOUNTED FOR.

DUCTWORK, DIFFUSERS, REGISTERS, GRILLES, AND OTHER ITEMS OF THE AIR HANDLING SYSTEM (INCLUDING, BUT NOT LIMITED TO, CEILING SUSPENSION SYSTEMS)

ALL WALL MOUNTED THERMOSTATS AND/OR TEMPERATURE SENSORS SHALL BE INSTALLED AT AN ELEVATION OF 48" ABOVE FINISHED FLOOR TO THE TOP UNLESS OTHERWISE NOTED ON DRAWINGS.

ELEVATION OF THE WALL MOUNTED THERMOSTAT SHALL BE COORDINATED WITH OTHER TRADES FOR COORDINATION OF LOCATIONS. CONTRACTOR SHALL BE SUBJECT TO THE APPROVAL OF THE TENANT/OWNER OR THEIR REPRESENTATIVE IN THE FIELD.

ALL SUPPLY AIR DIFFUSERS SHALL BE 4-WAY THROW UNLESS OTHERWISE NOTED.

COORDINATE AIR DEVICE LOCATIONS WITH LIGHTING FIXTURES, SPEAKERS AND FIRE SPRINKLER HEADS WHERE APPLICABLE.

CONTRACTOR SHALL VERIFY THAT THE LOCATION OF CEILING MOUNTED DIFFUSERS, GRILLES, AND REGISTERS SHOWN ON THE DRAWINGS ARE ACCEPTABLE TO THE ARCHITECT PRIOR TO INSTALLATION.

ALL NEW DUCTWORK SHALL BE "1" W.G. CONSTRUCTION, CONSTRUCTED OF LOCK FORMING GALVANIZED STEEL IN ACCORDANCE WITH THE "DUCT MANUAL AND SHEET METAL CONSTRUCTION FOR VENTILATING AND AIR CONDITIONING SYSTEMS," THIRD EDITION, 2005, PUBLISHED BY THE "SHEET METAL AND AIR CONDITIONING CONTRACTORS NATIONAL ASSOCIATION (SMACNA)," VOLUME DAMPERS shall BE PROVIDED IN ALL BRANCH TAKE OFFS, SPIN-IN'S OR OTHER CONNECTIONS TO NOISE AND AIR DISTRIBUTION. DUCTWORK SHALL BE RIGIDLY SUPPORTED BY RODS, OR RECTANGULAR WITH TURNING VANES. DUCTWORK SHALL BE HUNG AS HIGH AS POSSIBLE FROM THE BUILDING STRUCTURE WITH HANGER ASSEMBLIES IN ACCORDANCE WITH "SMACNA" REQUIREMENTS. PROVIDE ADDITIONAL RISES, DROPS, AND OFFSETS IN DUCTWORK AS REQUIRED. ALL DUCTWORK SHALL BE SEALED USING IRON GRIP (NO SUBSTITUTIONS) ALL DUCT JOINTS SHALL BE SEALED PER SMACNA CLASS "A"

NEW DUCTWORK SHALL BE EXTERNALLY INSULATED WITH 1-1/2" THICK FIBERGLASS FLEXIBLE BLANKET INSULATION (RATED FIRE=25, SMOKE=50) SECURED TO THE DUCTWORK WITH BENJAMIN FOSTER NO. 8520 ADHESIVE & PUSH PINS ON 12" CENTERS. INSULATION TO HAVE AN INSTALLED MINIMUM R-VALUE OF 6.0.

ALL EXHAUST AIR DUCTWORK SHALL BEAR THE UL 181 LABEL (CLASS 1 AIR DUCT) AND SHALL BE FACTORY INSULATED (1-1/2" MIN., 0.6 LB./F.SQA, FIRE=25, SMOKE=50) ATCO UPV #050 OR EQUAL. FLEXIBLE DUCTWORK SHALL COMPLY W/ NFPA 90A, AND NFPA 90B. ALL FLEXIBLE DUCTWORK CONNECTED TO DIFFUSERS SHALL NOT BE LESS THAN THE NECK SIZE OF THE DIFFUSER UNLESS OTHERWISE NOTED. FLEXIBLE DUCTWORK SHALL BE RIGIDLY SUPPORTED BY CURVATURE SHALL BE 3" DUCT DIAMETERS, MAXIMUM LENGTH SHALL BE 10' NO MORE THAN THE EQUIVALENT OF TWO (2) 90 DEGREE BENDS WILL BE ACCEPTABLE. TAKE OFF FITTINGS TO BE EQUAL TO FLEXIMASTER TYPE BM-R6. USE 45° THROAT AT PLENUM TAKE OFF'S.

FLEXIBLE AND RIGID ROUND DUCT TAKE-OFF'S FOR DIFFUSERS SHALL BE THE SAME SIZE AS DUCTWORK. FLEXIBLE AND RIGID ROUND DUCT TAKE-OFF'S FOR ROUND ROOF DUCTS WITH 1-1/2" FLO FACED FIBERGLASS DUCT WRAP. DUCT WRAP TO HAVE AN INSTALLED MINIMUM THERMAL RESISTANCE (R) VALUE OF 6.0.

ALL EXHAUST AIR DUCTWORK SHALL BE GALVANIZED SHEETMETAL CONSTRUCTION IN ACCORDANCE WITH LATEST SMACNA STANDARDS. PROVIDE, HUNG OR SUSPENDED IN ACCORDANCE WITH THE INTERNATIONAL MECHANICAL HANG CODE. APPROXIMATE MINIMUM 1-1/2" WIDE 22 GA. STRAPS, 10 FT. SPACING FOR MAXIMUM HALF DUCT PERIMETER UP TO 30" AND ALL ROUND FLEX DUCT. PROVIDE 1" WIDE 22 GA. STRAPS, 5 FT. SPACING FOR MAXIMUM HALF DUCT PERIMETER FROM 31" TO 72" AND 1" WIDE 20 GA. STRAPS, 5 FT. SPACING FOR MAXIMUM HALF DUCT PERIMETER TO 96"

PROVIDE A TRAP IN TOP OF CONDENSATE PIPING RUNS WITH 1/2" CLEARANCES.

PROVIDE A TRAP IN ALL CONDENSATE PIPING LOCATED AT THE ROOF TOP UNIT. CONDENSATE PIPING TO BE TYPE "L" COPPER.

VERIFY VOLTAGE WITH ELECTRICAL BEFORE ORDERING EQUIPMENT.

MECHANICAL EQUIPMENT CONTROL CIRCUITS TO BE SEPARATE FROM POWER CONDUIT.

GUARANTEE, FOR ONE YEAR AFTER DATE OF ACCEPTANCE BY THE OWNER, ALL EQUIPMENT, MATERIALS AND WORKMANSHIP TO BE FREE FROM DEFECT.

IT SHALL BE THE RESPONSIBILITY OF THIS CONTRACTOR TO INSTALL THE HEATING, VENTILATION AND AIR CONDITIONING EQUIPMENT. IT SHALL BE THE RESPONSIBILITY OF THE OWNER OR HIS AGENT TO TRANSMIT TO THE BUILDING, STRUCTURE OR OCCUPIED AREA. THE DECISION OF THE ENGINEER AS TO THE QUIETNESS OF THE SYSTEM AND EQUIPMENT SHALL BE FINAL. IT SHALL BE THIS CONTRACTOR'S RESPONSIBILITY TO CORRECT OR REPLACE ANY NOISY SYSTEM OR COMPONENT AS REQUESTED.





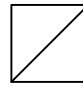

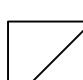
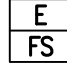
ALL MATERIAL SHALL BE OF APPROVED QUALITY AND THE WORK SHALL BE DONE IN A THOROUGH AND WORKMANLIKE MANNER. THE WORK, MATERIALS AND TESTS SHALL BE IN ACCORDANCE WITH ALL LOCAL AND STATE MECHANICAL CODES.

ALL DETECTOR LOCATIONS AND SMOKE DETECTOR LOCATIONS SHOWN ON THE DRAWINGS ARE REFERENCE LOCATIONS ONLY. THE FINAL PLACEMENT OF THE DETECTOR IN THE DUCTWORK SHALL MEET THE REQUIREMENTS OF THE MANUFACTURER'S INSTALLATION INSTRUCTIONS. PROVIDE A PRESSURE DIFFERENTIAL TEST AND THE MANUFACTURER'S TEST KIT. A COPY OF ALL TEST DATA WILL BE AVAILABLE TO THE CLIENT FOR REVIEW AND INSPECTION.

FOR INSPECTING AND SERVICING THE DETECTOR. THE ACTUATION OF A SMOKE DETECTOR SHALL ACTIVATE A VISIBLE AND AUDIBLE SUPERVISORY SIGNAL AT AN APPROVED LOCATION AND SHALL BE IDENTIFIED AS AIR DUCT DETECTOR TROUBLE. DUCT SMOKE DETECTORS ARE FURNISHED AND SHOWN ON DRAWINGS BY DIVISION 16, BUT SHALL BE INSTALLED IN DUCTWORK BY THE MECHANICAL CONTRACTOR.

1. FURNISH ALL LABOR, EQUIPMENT, MATERIALS AND INCIDENTALS REQUIRED TO REMOVE ALL EXISTING EQUIPMENT AND ALL PIPE, FITTINGS, VALVES, SUPPORTS AND APPLIANCES INDICATED AND REMOVED FOR THE FULL SCOPE OF THE RENOVATED FACILITY. DEMOLITION WILL BE CONSISTENT WITH THE FINAL CONFIGURATION OF THE NEW SYSTEMS AS INDICATED, AS SPECIFIED HEREIN, OR AS REQUIRED BY THE ARCHITECT. THE EQUIPMENT AND PIPING INDICATED SHALL BE REMOVED FROM THEIR PROPOSED LOCATIONS AND BECOME THE PROPERTY OF THE CONTRACTOR (UNLESS OTHERWISE NOTED) AND SHALL BE REMOVED FROM THE SITE AS SPECIFIED HEREINAFTER.
2. BEFORE REMOVAL OF ANY ELECTRICALLY OPERATED EQUIPMENT, COORDINATE CAREFULLY TO ASSURE THAT POWER AND CONTROL WIRING HAS BEEN DISCONNECTED AND TERMINATED PER CODE REQUIREMENTS OR REMOVED AS REQUIRED.
3. IF, DURING THE PROGRESS OF CONSTRUCTION OR DEMOLITION, ANY INSULATION SUCH AS CEMENT OR ASBESTOS IS OBSERVED, THE CONTRACTOR SHALL BE BROUGHT TO THE IMMEDIATE ATTENTION OF THE ARCHITECT. REMOVAL OF SUCH INSULATION WILL BE PERFORMED BY OTHERS. UNTIL THE REMOVAL PROCESS IS COMPLETE, WORK IN THE AREA SHALL BE SUSPENDED.
4. DO NOT PROCEED WITH THE REMOVAL OF ANY EQUIPMENT, PIPING OR APPLIANCES WITHOUT SPECIFIC APPROVAL OF THE OWNER'S REPRESENTATIVE. ANY EQUIPMENT, PIPING OR APPURTENANCES REMOVED WITHOUT PROPER AUTHORIZATION, WHICH ARE NECESSARY FOR THE RE-USE IN THE RENOVATED FACILITY, SHALL BE REJECTED AND THE CONTRACTOR SHALL BE RESPONSIBLE REPRESENTATIVE WITHOUT INCURRING ANY ADDITIONAL COST TO THE CONTRACT.

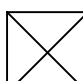All model numbers are Titus unless otherwise indicated.

 	<p>HIGH PERFORMANCE SQUARE CEILING SUPPLY DIFFUSER</p> <p>TMS-AA</p> <p>24x24 or 12x12 face as shown, neck size (NS) and CFM as noted, border type to match ceiling type in architectural reflected ceiling plan. Aluminum construction with 3-cone design. Provide face operable damper in inaccessible ceiling locations. Finish as approved by Architect.</p>
 	<p>SUPPLY DIFFUSER</p> <p>300 FL</p> <p>Face size (FS) as noted. Border type as required for mounting. Aluminum construction with aluminum blades. Individually adjustable double deflection blades spaced on 3/4" centers. Front blades shall be parallel to the short dimension. Provide face operable opposed blade volume damper. Finish as approved by architect.</p>
 	<p>EGGCRATE RETURN AIR GRILLE</p> <p>50F</p> <p>24X24 or 12X12, Face size (FS) as noted, 1/2"x1/2"x1/2" grid. Border type as required by Architectural reflected ceiling plan. Aluminum construction for border and grid. Anodized finish as approved by Architect.</p>
 	<p>TOILET EXHAUST REGISTER</p> <p>50F</p> <p>Face size (FS), as noted, 1/2"x1/2"x1/2" grid. Border type as required by Architectural reflected ceiling plan. Aluminum construction for border and grid. Provide volume damper in neck of register. Finish as approved by Architect.</p>

Energy Code: 2015 IECC
Project Title: 7 Tequilas Restaurant
Location: Woodstock, Georgia
Climate Zone: 3a
Project Type: New Construction

5586 Old Highway 5
Woodstock, GA 30188

Quantity	System Type & Description
1	RTU-1 (Single Zone): Heating: 1 each - Central Furnace, Gas, Capacity = 250 kWh Proposed Efficiency = 80.00% EER, Required Efficiency: 80.00 % EER Cooling: 1 each - Single Package DX Unit, Capacity = 150 kWh, Air-Cooled Condenser, Air Economizer Proposed Efficiency = 10.80 EER, Required Efficiency: 10.80 EER + 12.2 IEER Fan System: Unspecified
1	RTU-2 (Single Zone): Heating: 1 each - Central Furnace, Gas, Capacity = 250 kWh Proposed Efficiency = 80.00% EER, Required Efficiency: 80.00 % EER Cooling: 1 each - Single Package DX Unit, Capacity = 150 kWh, Air-Cooled Condenser, Air Economizer Proposed Efficiency = 10.80 EER, Required Efficiency: 10.80 EER + 12.2 IEER Fan System: Unspecified
1	RTU-3 (Single Zone): Heating: 1 each - Central Furnace, Gas, Capacity = 150 kWh Proposed Efficiency = 80.00% EER, Required Efficiency: 80.00 % EER or 78% AFUE Cooling: 1 each - Single Package DX Unit, Capacity = 120 kWh, Air-Cooled Condenser, Air Economizer Proposed Efficiency = 11.00 EER, Required Efficiency: 11.00 EER + 12.6 IEER Fan System: Unspecified
1	WH-1: Gas Storage Water Heater, Capacity: 100 gallons, Input Rating: 75 kWh/w or Circulation Pump Go minimum efficiency requirement applies

Compliance Statement: The proposed mechanical design represented in this document is consistent with the building plans specifications, and other calculations submitted with this permit application. The proposed mechanical systems have been designed to meet the 2015 IECC requirements in COMcheck Version 4.1.5.5 and to comply with any applicable mandatory requirements listed in the Inspection Checklist.

Darryl Bibbs		03/07/2022
Name - Title	Signature	Date

Project Title: 7 Tequilas Restaurant Report date: 03/07/22
Data filename: C:\Users\mbibb\Dropbox\Engineering\Best Engineering\7 Tequilas\HVAC\Calculations\COMcheck.cck Page 1 of 11

HOOD SCHEDULE															
HOOD NO.	MODEL	HOOD DIMENSIONS (IN.)			HOOD CONSTR.	HOOD TEMP RATING	TOTAL CFM	EXHAUST COLLAR(S)				SUPPLY MUA CFM	TOTAL WEIGHT LBS.	NOTES	
		LENGTH	WIDTH	HEIGHT				WIDTH	LENGTH	DIA.	CFM				S.P.
1	XBEW-240.00-S	240"	54	24"	430 SS WHERE EXPOSED	HEAVY	2,500	10	24	--	2,500	-0.434"	1,905	293.58	1
2	XBEW-240.00-S	240"	54	24"	430 SS WHERE EXPOSED	HEAVY	2,500	10	24	--	2,500	-0.434"	1,905	293.58	1

[illegible]

1. REFER TO ELECTRICAL DRAWINGS FOR SERVICE VOLTAGE CHARACTERISTICS.
2. PROVIDE BACK DRAFT DAMPER, SPEED CONTROLLER MOUNTED AT FAN, AND DISCONNECT SWITCH.
3. PROVIDE INTEGRAL GRILLE, BACK DRAFT DAMPER, SPEED CONTROLLER MOUNTED AT FAN, AND DISCONNECT SWITCH.
4. CONTINUOUS OPERATION.
5. INTERLOCK OPERATION OF FAN WITH KITCHEN HOOD.
6. INTERLOCK WITH LIGHT SWITCH.
7. PROVIDE 12" HIGH ROOF CURB.
8. PROVIDE 20" HIGH ROOF CURB.
9. SEE KITCHEN DRAWINGS FOR COMPLETE FAN DETAILS.

[illegible]

- COOLING CAPACITIES BASED ON 80°F DB / 67°F WB ENTERING COIL, 105°F DB ENTERING CONDENSER.
 PROVIDE SINGLE POINT CONNECTION KIT.
 PROVIDE CONDENSER COIL HAIL GUARD.
 PROVIDE 14" HIGH ROOF CURB.
 PROVIDE FACTORY INSTALLED DISCONNECT AND UNPOWERED CONVENIENCE OUTLET.
 PROVIDE THROUGH THE BASE ELECTRICAL ACCESS.
 PROVIDE 1 YEAR PARTS AND LABOR WARRANTY.
 PROVIDE 5 YEAR PARTS WARRANTY ON COMPRESSORS.
 PROVIDE SUPPLY AIR SMOKE DETECTOR.
 PROVIDE FACTORY INSTALLED DIFFERENTIAL ENTHALPHY ECONOMIZER AND BAROMETRIC RELIEF.
 PROVIDE AUTOMOTORIZED OUTSIDE AIR DAMPER.
 2. COORDINATE ELECTRICAL REQUIREMENTS WITH ELECTRICAL CONTRACTOR PRIOR TO PLACING ORDER FOR EQUIPMENT

MARK	EXHAUST AIRFLOW (CFM)	OUTSIDE AIRFLOW (CFM)	USE	NOTES
KEF-1	2,500		KITCHEN HOOD	
KEF-2	2,500		KITCHEN HOOD	
TEF-1	470		TOILET EXHAUST	
KSE-1		4,000	KITCHEN HOOD MAKEUP	
RTU-1		1,250	DINING	
RTU-2		1,250	DINING	
RTU-3		500	KITCHEN	
TOTAL EXHAUST	5,470			
TOTAL OUTSIDE AIR		7,000		
BUILDING AIR BALANCE		+1,530		

Room Number	Room Name	Area (ft²)	Occupant Density # of People/1000sf	Calculated # of People	Actual # of People	cfm/person (cfm)	cfm/sf (cfm)	Total cfm	Zone	Effective cfm	Scheduled OA (cfm)	Exhaust Airflow Rate / Exhaust Rate (cfm/sf)	Exhaust Airflow Rate (cfm/sf)	Calculated Exhaust Airflow Rate (cfm)	Scheduled Exhaust Airflow Rate (cfm)
101	ENTRY	260	10	2.6	12	5	0.06	75.6	0.8	94.5	95	-	-	-	-
102	DINING	2160	70	151.2	120	7.5	0.18	1288.8	0.8	1611	1611	-	-	-	-
103	BAR	200	0	36	36	5	0.06	192	0.8	240	240	-	-	-	-
104	CIRC	150	0	0	0	0	0.06	9	0.8	11.25	12	-	-	-	-
105	WOMEN	150	0	0	0	0	0	0	0	0	0	210	0	210	210
106	MAN	20	0	0	0	0	0	0	0	0	0	0	20	20	20
107	MEN	150	0	0	0	0	0	0	0	0	0	210	0	210	210
108	STORAGE	140	0	0	0	0	0.12	16.8	0.8	21	22	-	-	-	-
109	OFFICE	70	5	0.35	1	5	0.06	9.2	0.8	11.5	12	-	-	-	-
110	SERVICE LINE	170	70	11.9	3	7.5	0.18	53.1	0.8	66.375	66	-	-	-	-
111	KITCHEN	830	70	58.1	6	7.5	0.18	194.4	0.8	243	245	-	-	-	-
113	STORAGE	20	0	0	0	0	0.12	2.4	0.8	3	5	-	-	-	-
114	PATIO	560	70	39.2	36	7.5	0.18	370.8	0.8	463.5	464	-	-	-	-

7 TEQUILAS RESTAURANT
5586 OLD HIGHWAY 5 (OLD GEORGIA HIGHWAY 5 AND PAYNE ROAD)
WOODSTOCK, GEORGIA 30188

CONSTRUCTION COORDINATION DRAWINGS
PREPARED FOR INNOVATIVE CONTRACTING SOLUTIONS
5605 GLENDRIIDGE DR. NE
SUITE 345 ATLANTA, GEORGIA 30342


[illegible]

Sheet Name:	
MECHANICAL SCHEDULES	
Proj #:	Issue Date:
211201	03-14-2022
Sheet No.:	
M0.2	
Drawn By:	Checked By:
DMB	BGB


Best Beach Engineering Solutions Team
Mechanical, Electrical & Plumbing
Engineering
(678) 665-3280
Project Number: 19-249

Sheet No.: **M0.2**

 Drawn By: **DMB** Checked By: **BGB**




CONSTRUCTION COORDINATION DRAWINGS
PREPARED FOR INNOVATIVE CONTRACTING SOLUTIONS
5605 GLENDRIDGE DR. NE
SUITE 345 ATLANTA, GEORGIA 30342

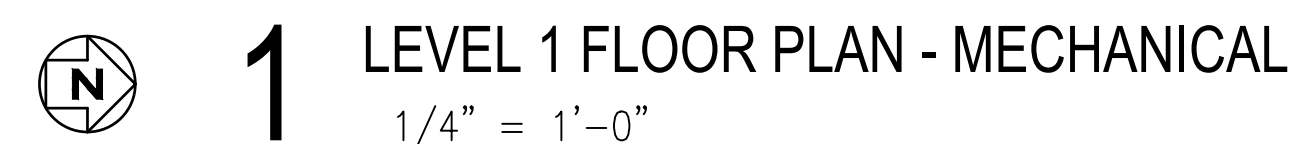

- ISSUED FOR CONSTRUCTION**
- best** Beach Engineering Solutions Team
Mechanical, Electrical & Plumbing
Engineering
(678) 665-3280
Project Number: 19-249

2	BID SET	03-14-2022
1	G.C. SHOP DWG. COORD. 2	03-14-2022
No.	Description	Date:

Sheet Name: LEVEL 1 FLOOR PLAN - MECHANICAL	
Proj #: 211201	Issue Date: 03-14-2022
Sheet No.: M1.1	
Drawn By: DMB	Checked By: RGB

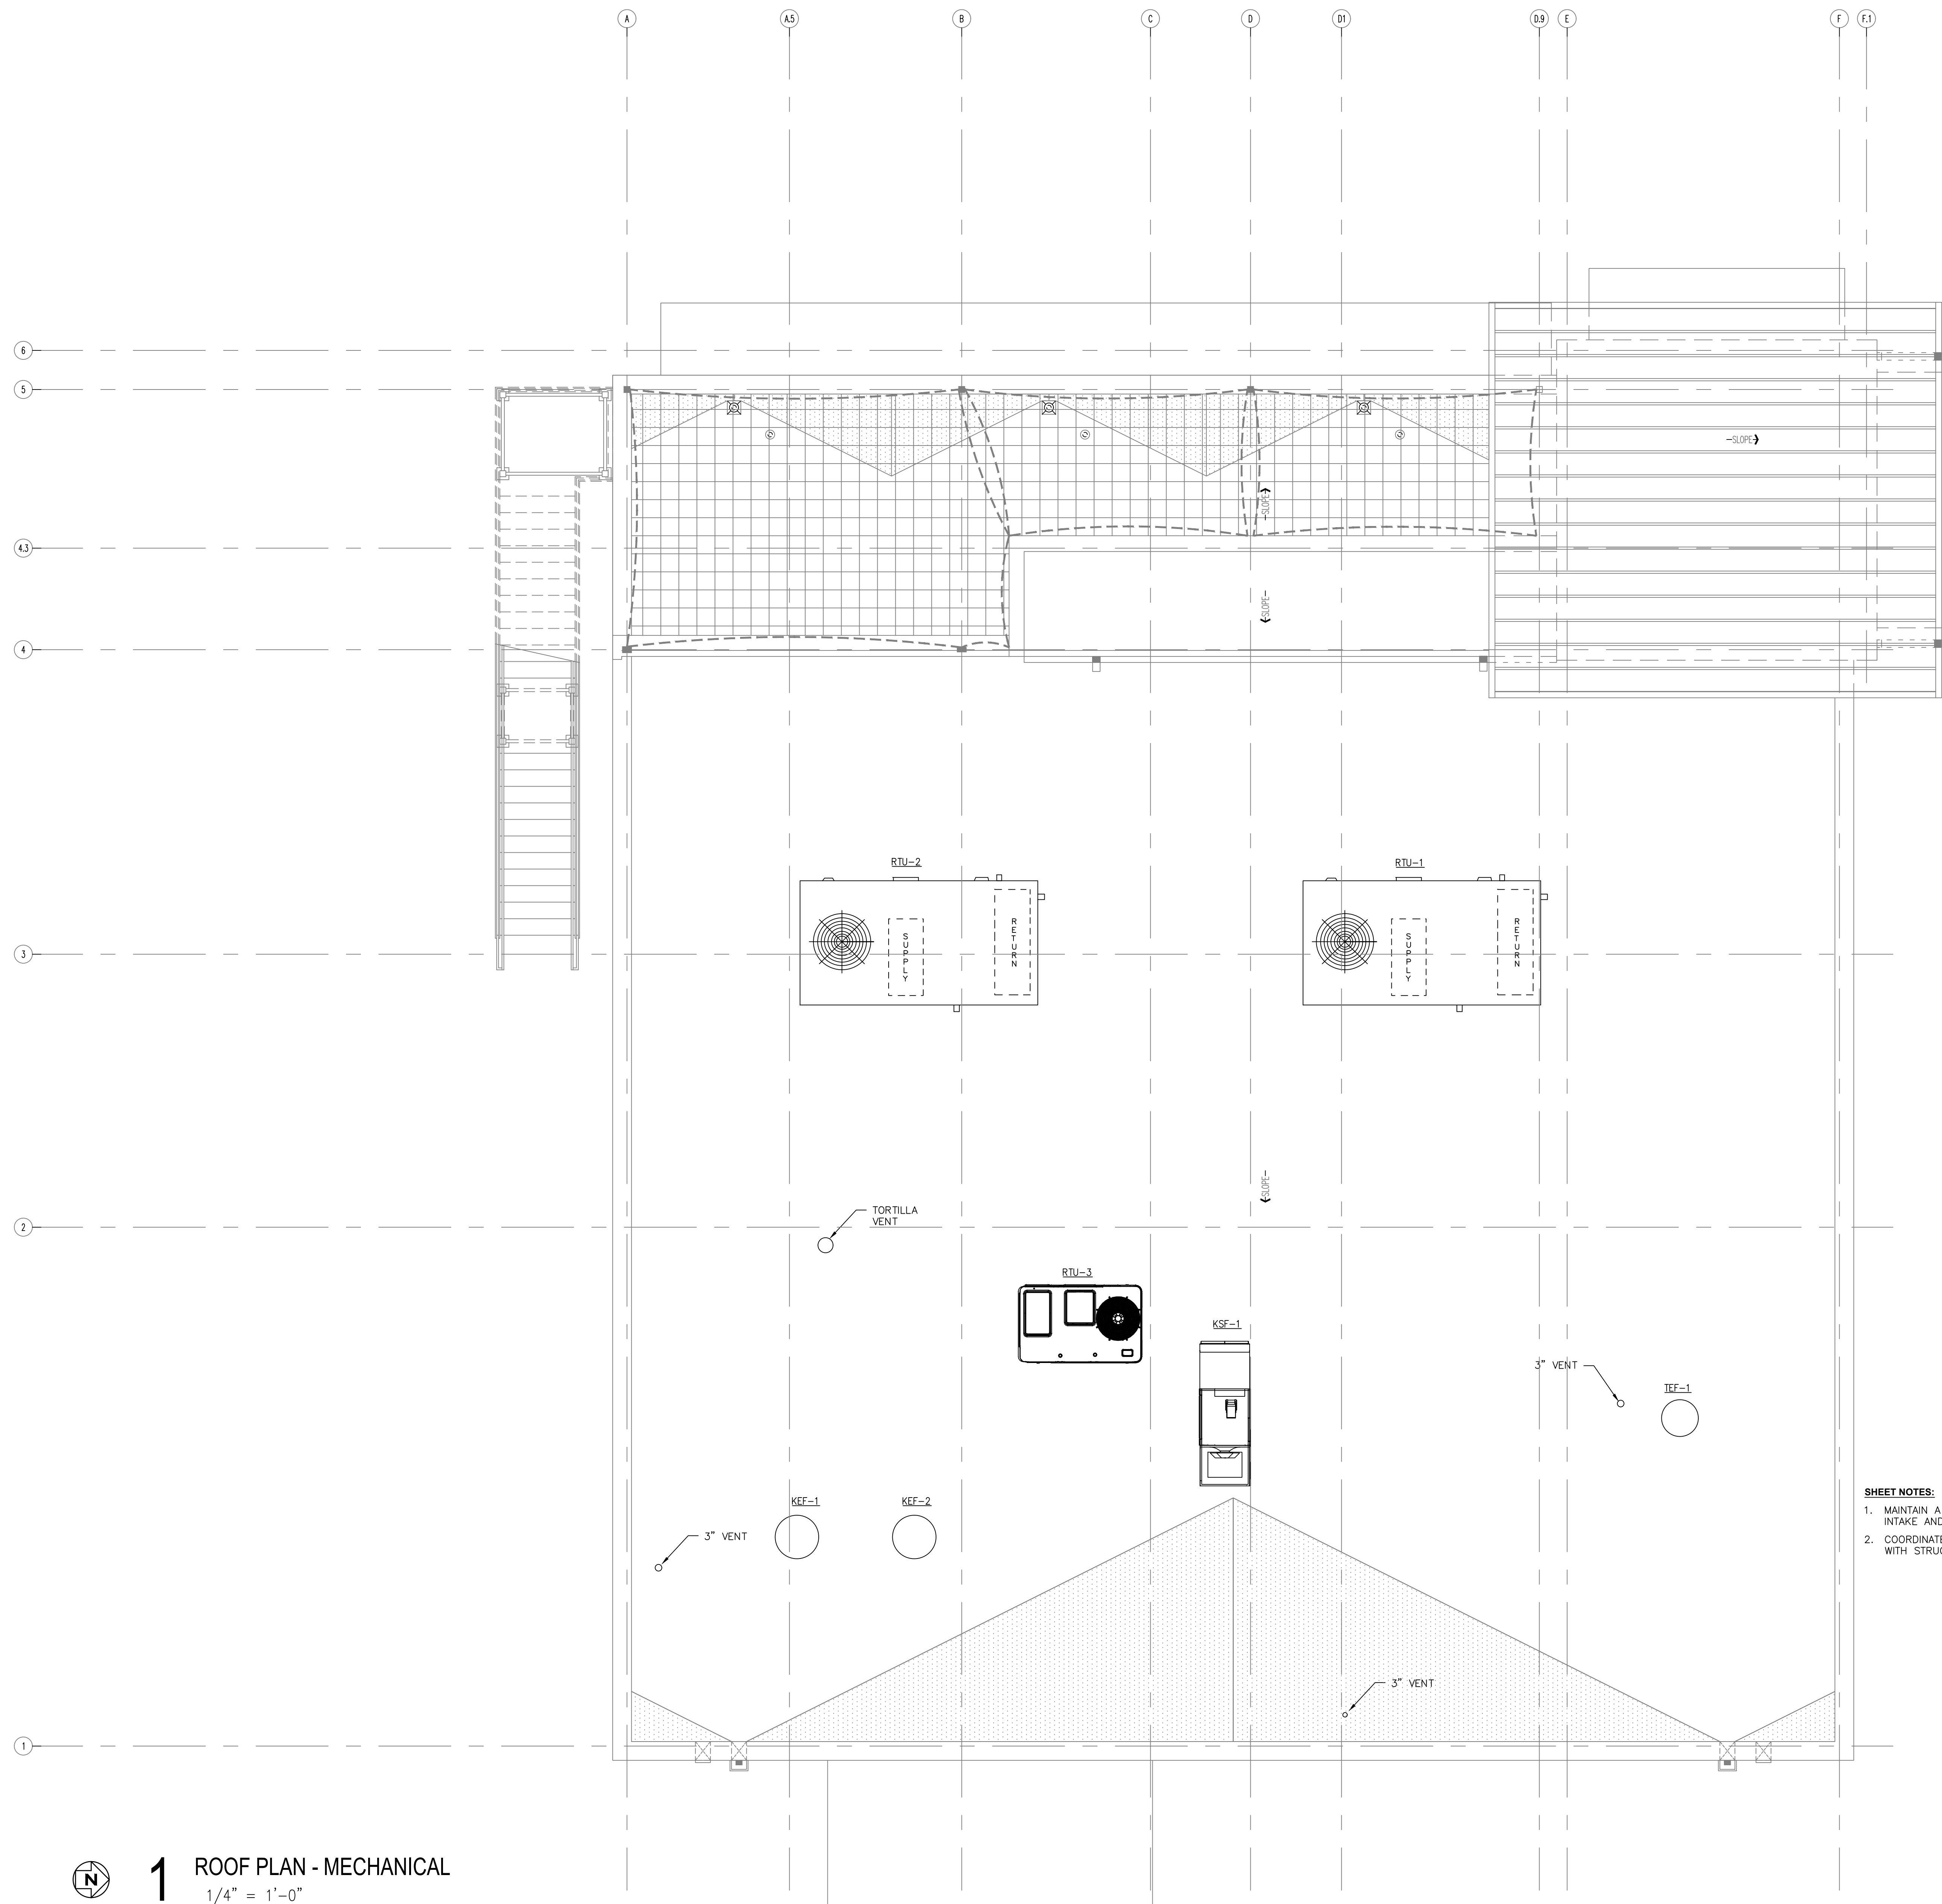


SHEET NOTES:

1. MAINTAIN A MINIMUM 10 FEET DISTANCE BETWEEN INTAKE AND EXHAUST OR VENTS.
2. COORDINATE THE EXACT LOCATION OF EQUIPMENT WITH STRUCTURE AND ARCHITECTURAL PLANS.



1 ROOF PLAN - MECHANICAL
1/4" = 1'-0"

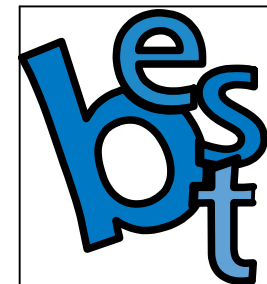

ISSUED FOR CONSTRUCTION

Beach Engineering Solutions Team
Mechanical, Electrical & Plumbing Engineering















(678) 665-3280
Project Number: 19-249

03-14-2022	03-14-2022
BID SET	G.C. SHOP DRAWING COORD. 2
No.	Description
No.	Date

Sheet Name: ROOF PLAN - MECHANICAL	
Proj #: 211201	Issue Date: 03-14-2022
Sheet No. M1.2	
Drawn By: DMB	Checked By: BGB

No.	Description	Date
02	BID SET	03-14-2022
03	G.C. SHOP DRAW COORD. 2	03-14-2022

MECHANICAL DETAILS	
Proj #:	211201
Issue Date:	03-14-2022
Sheet No.:	M3.1
Drawn By:	DMB
Checked By:	BGB

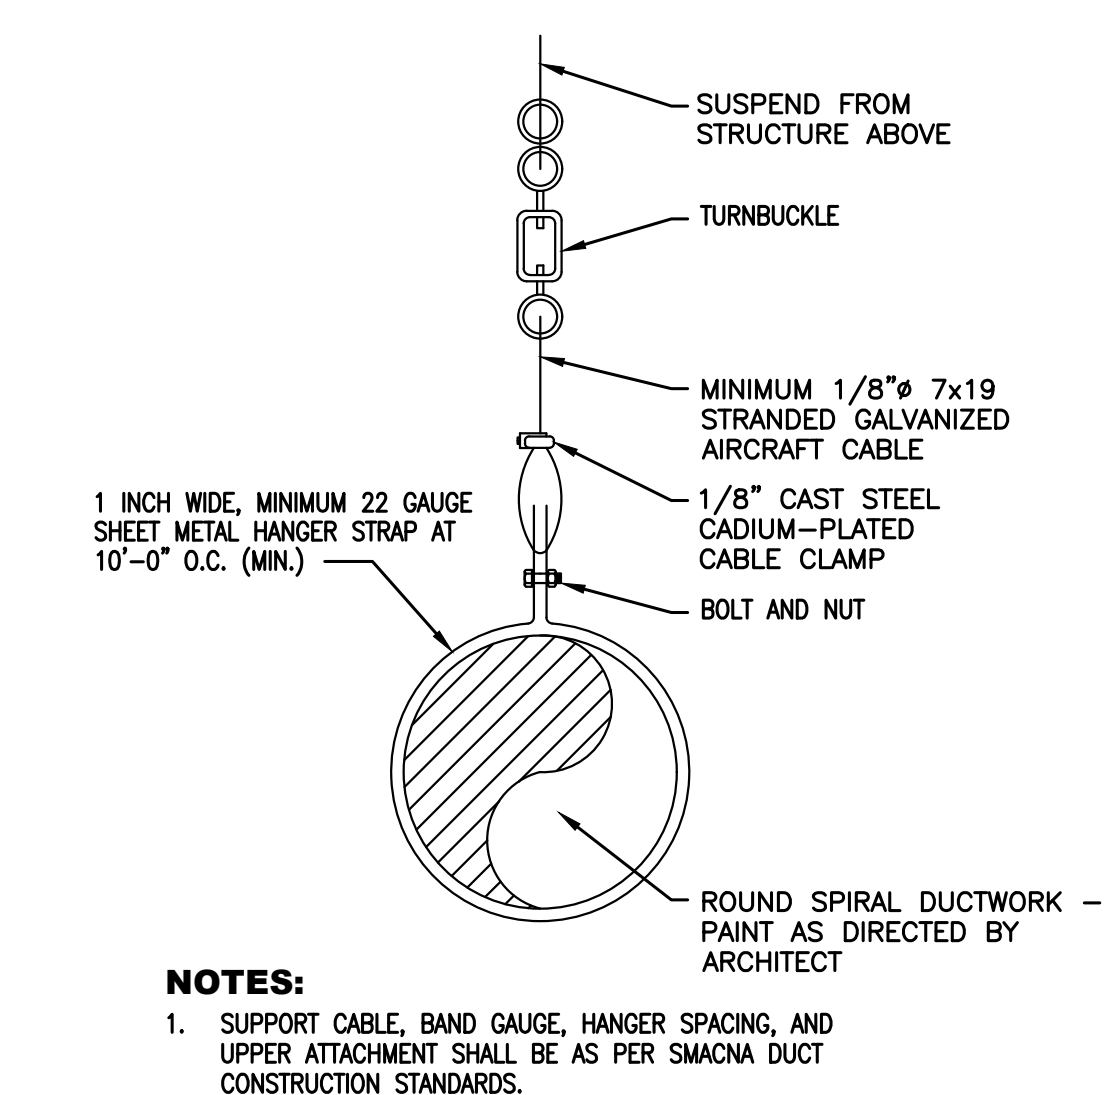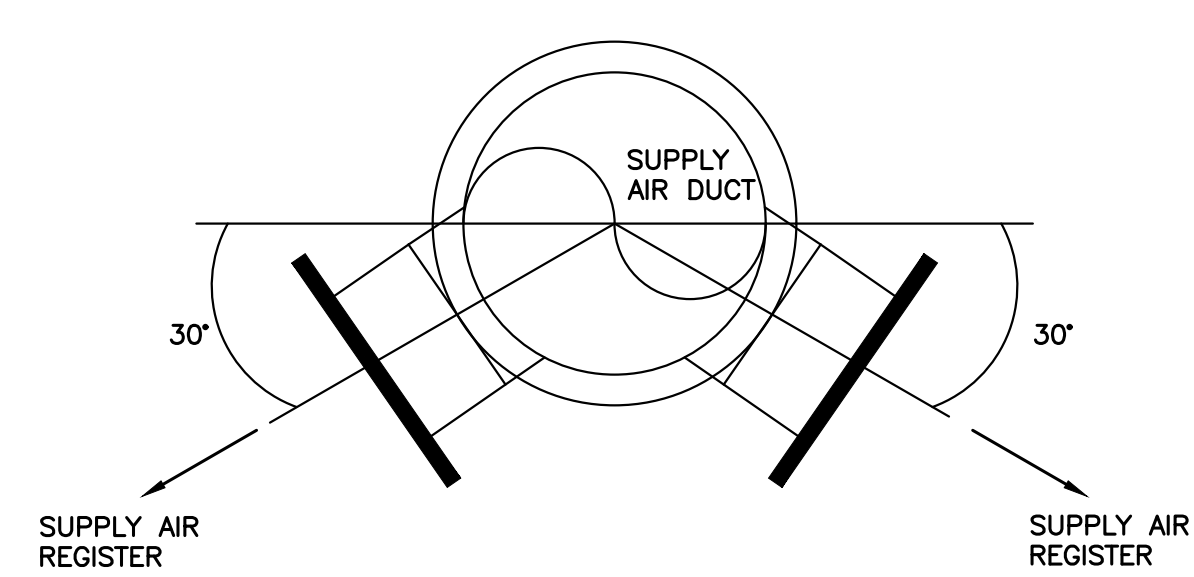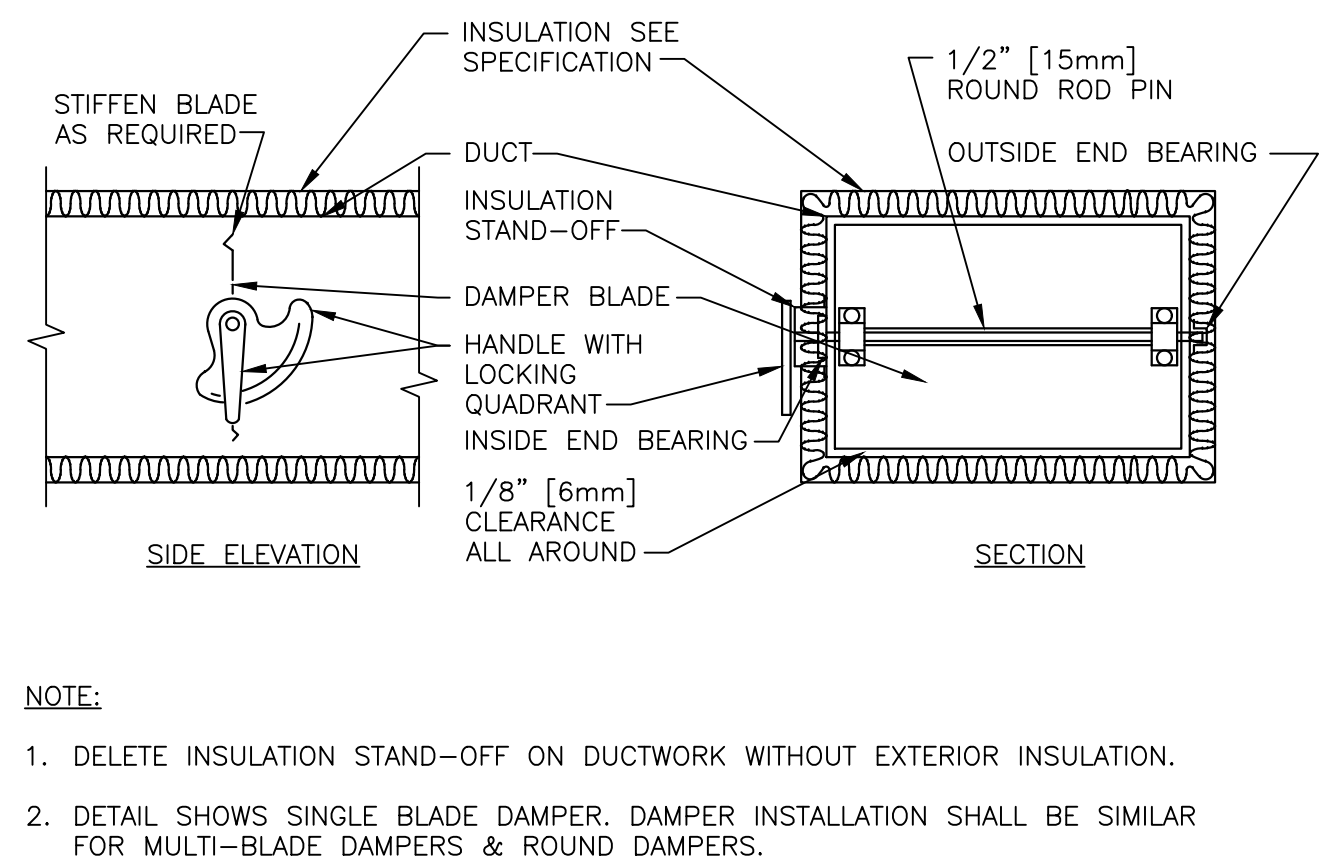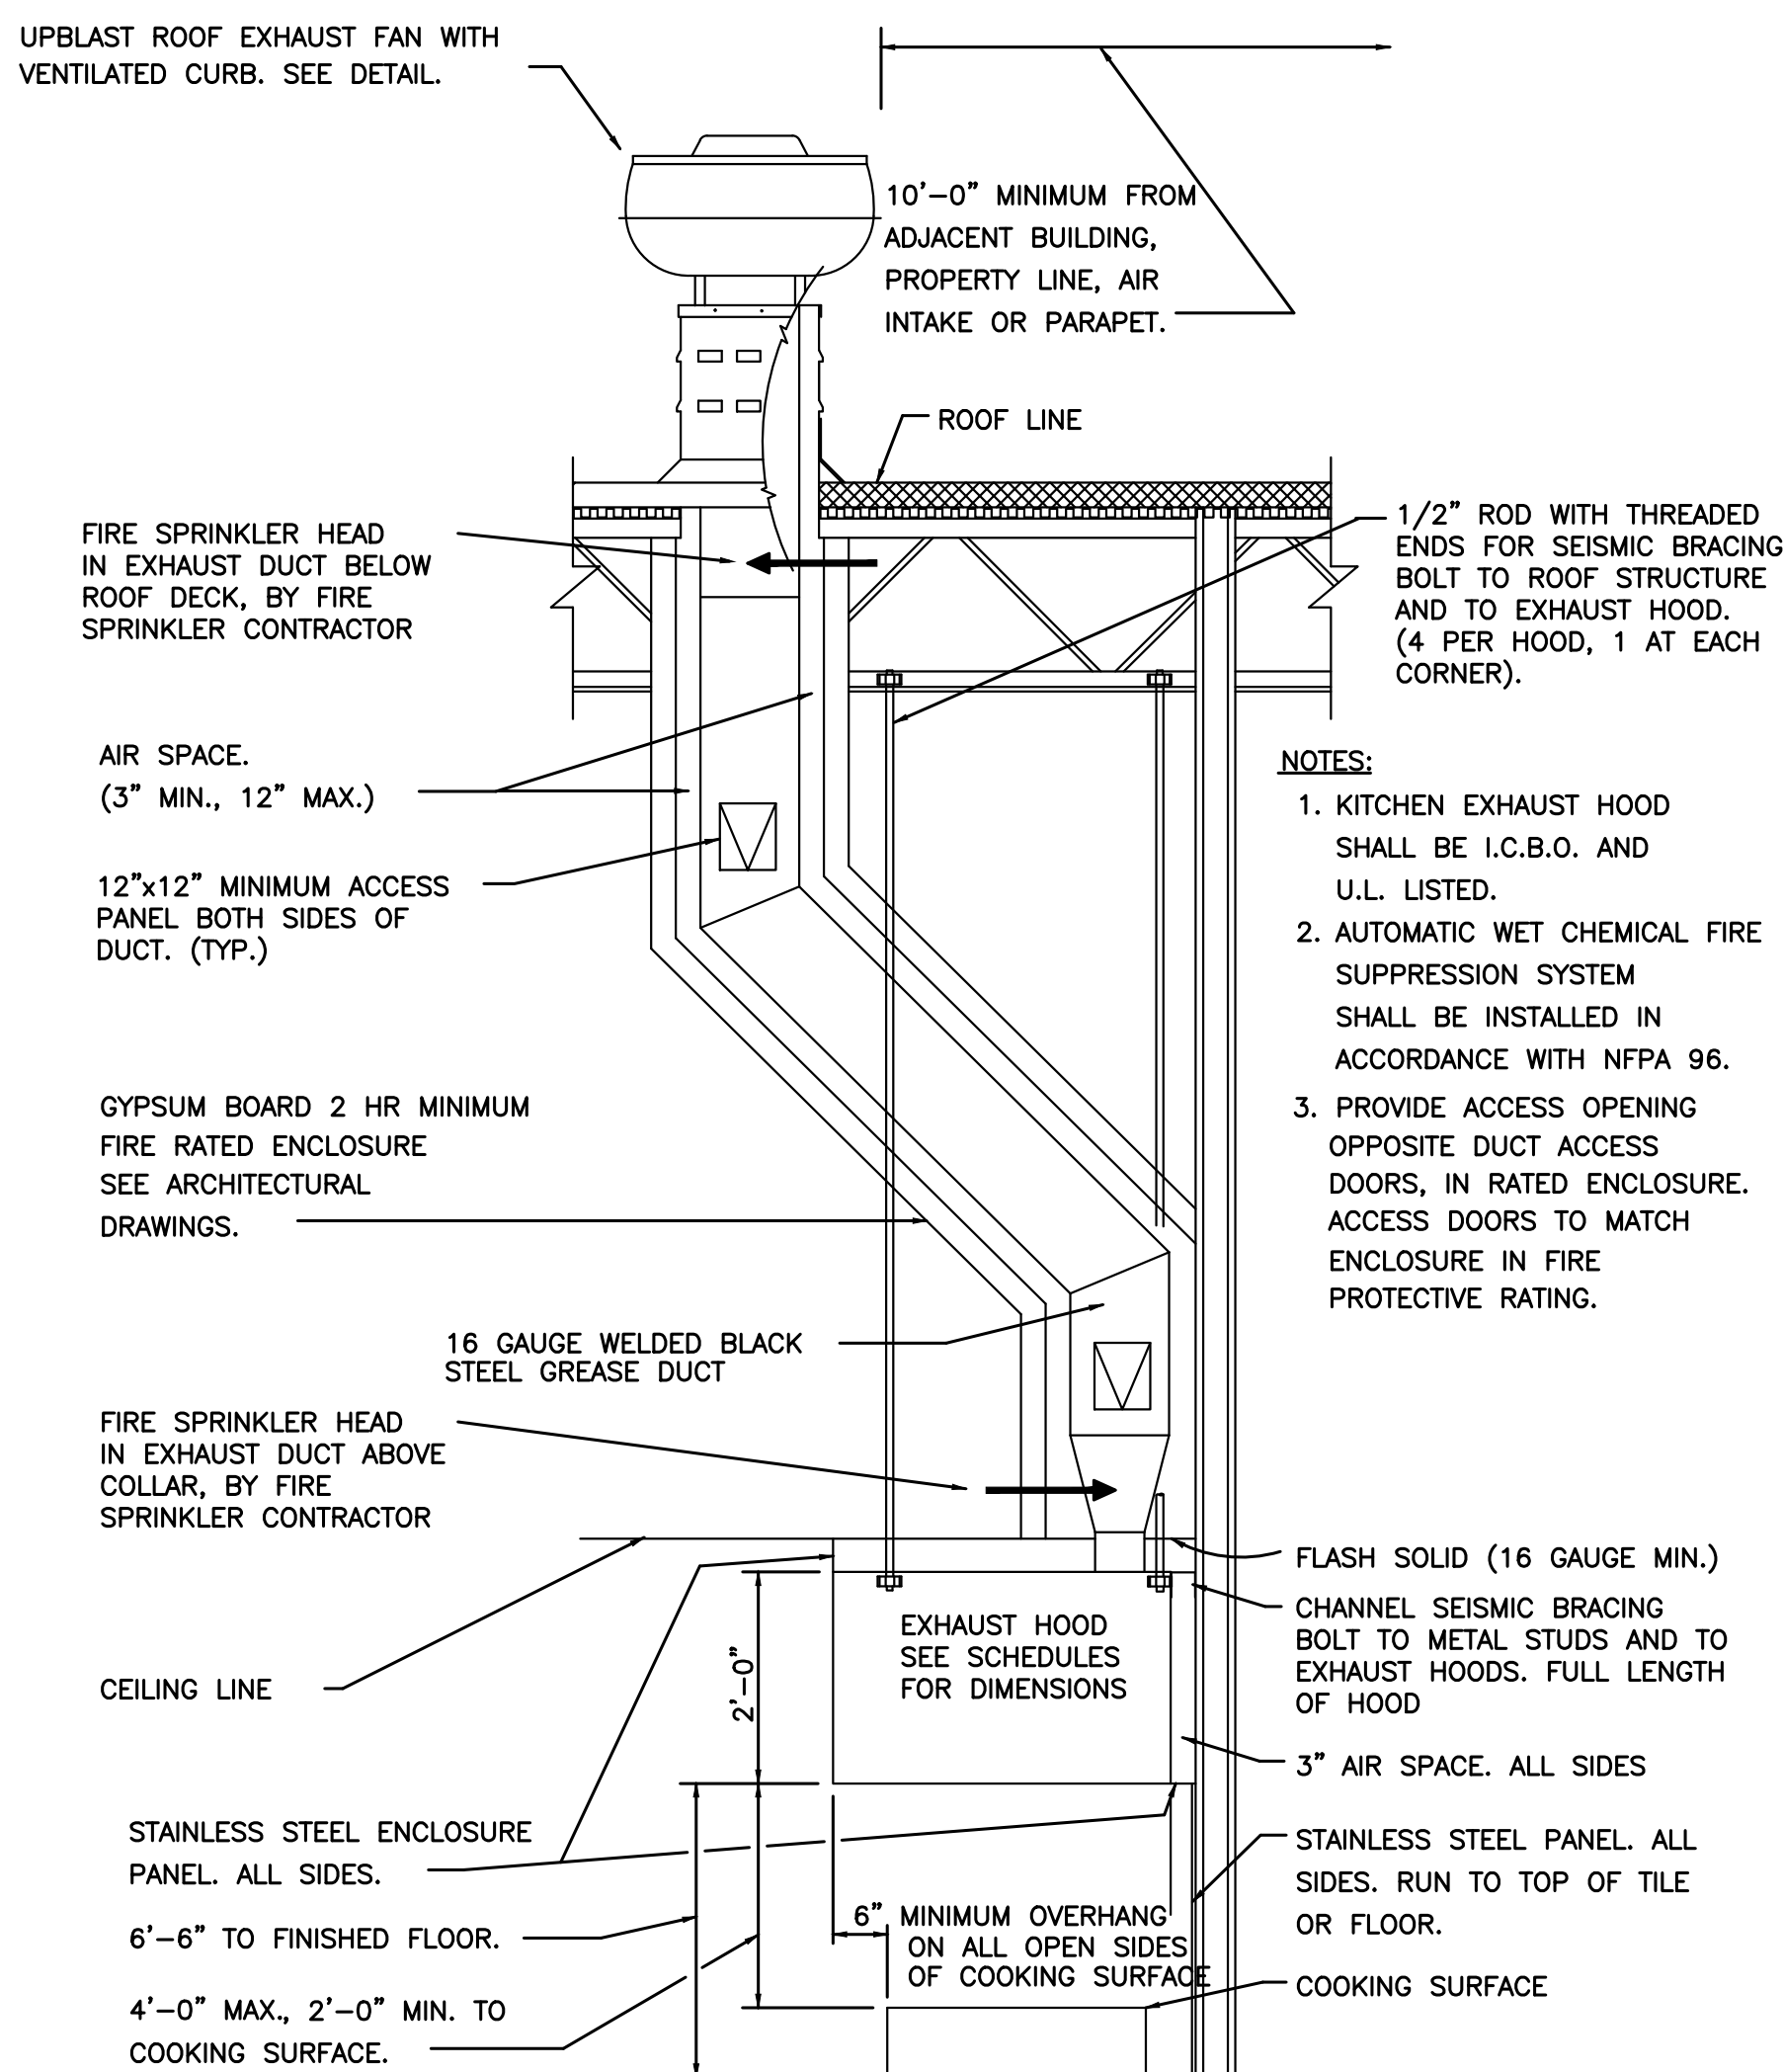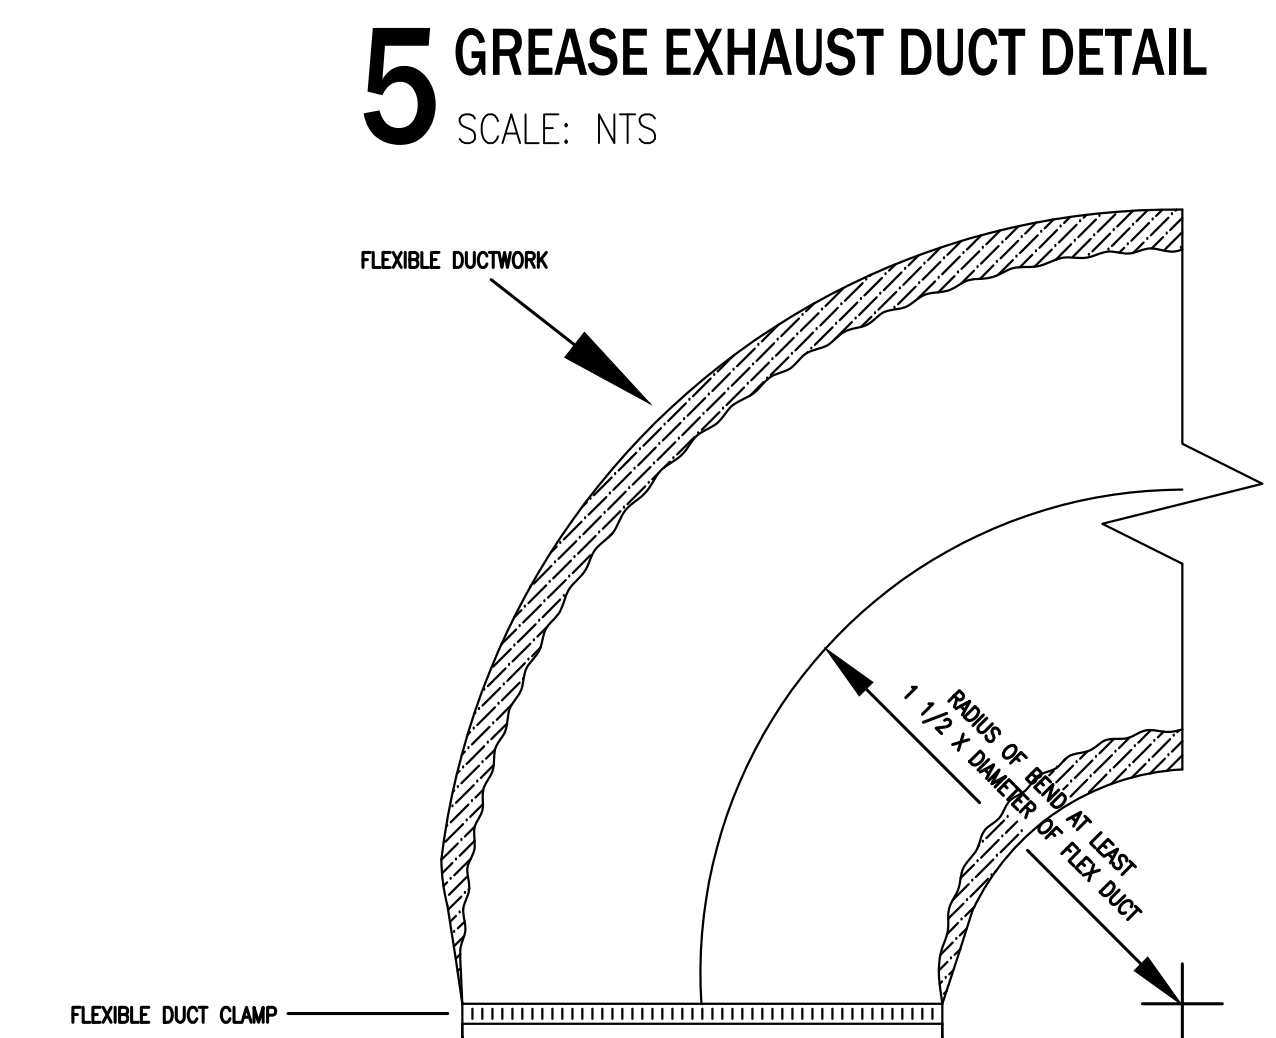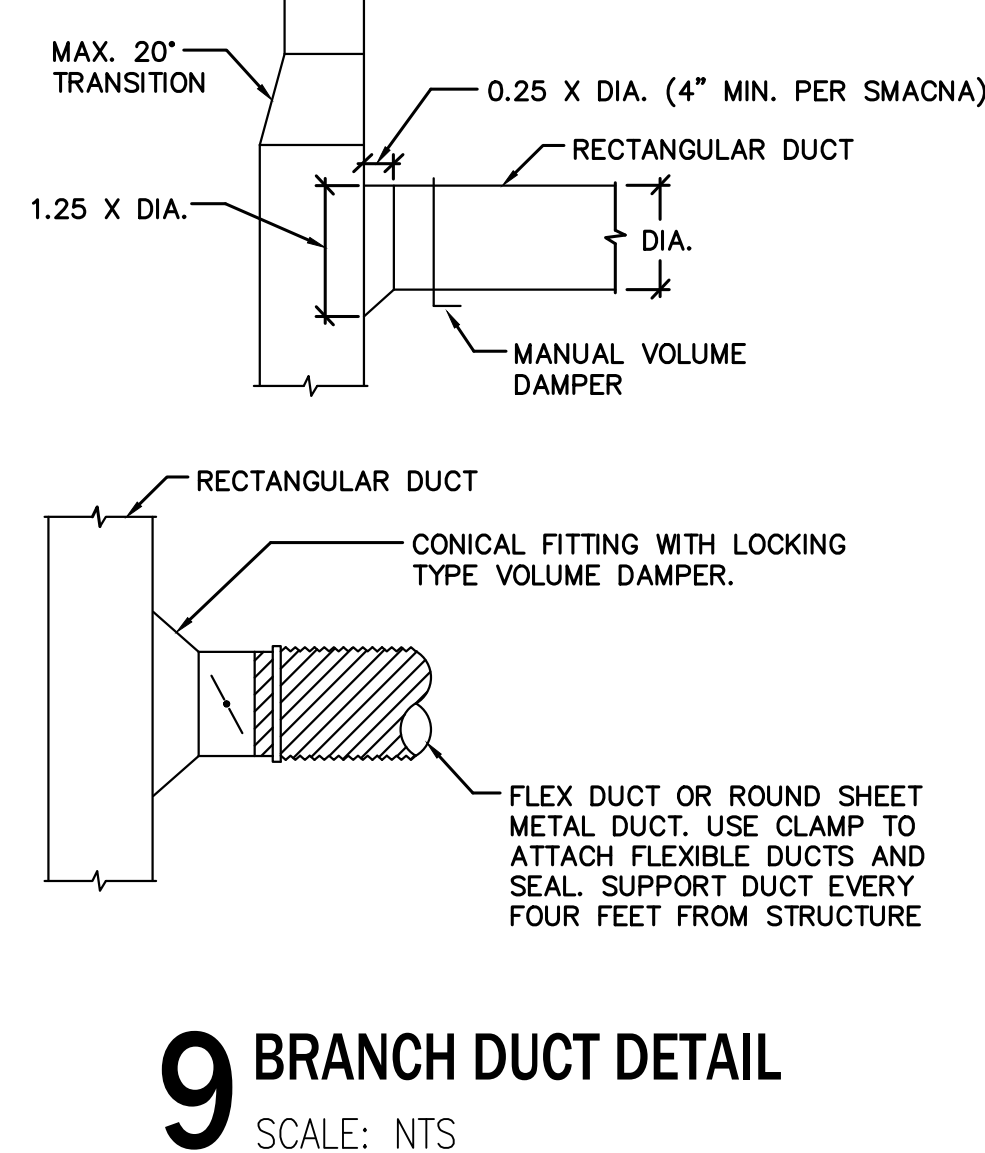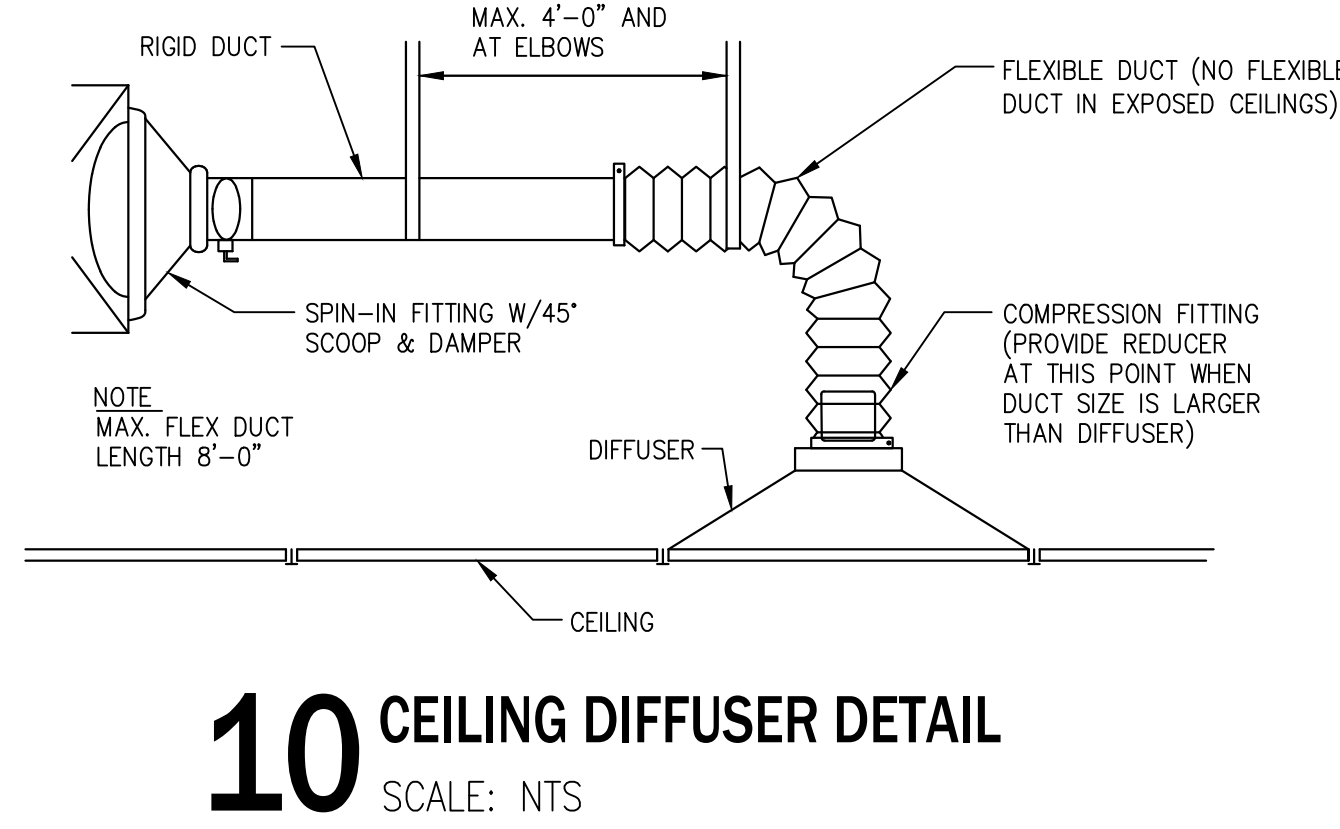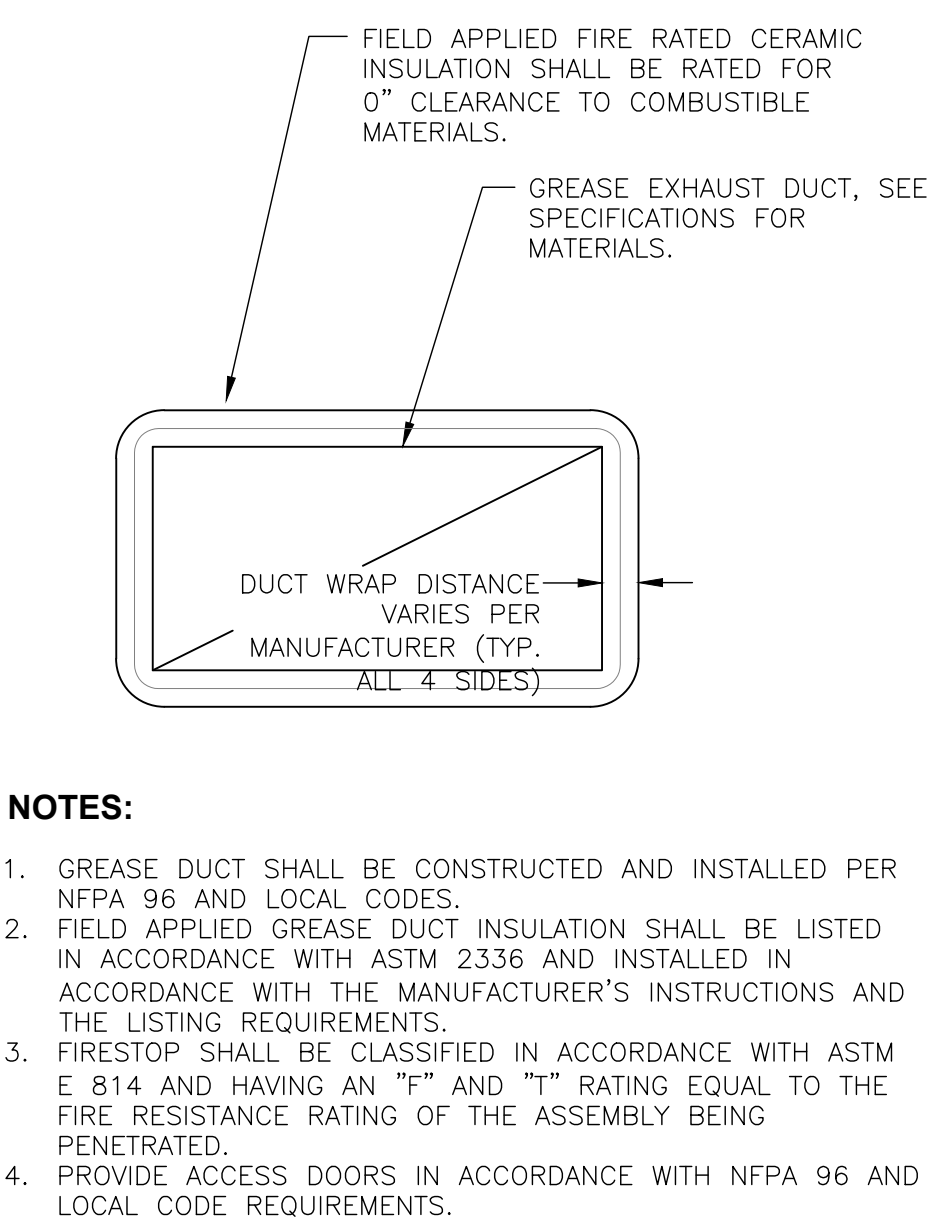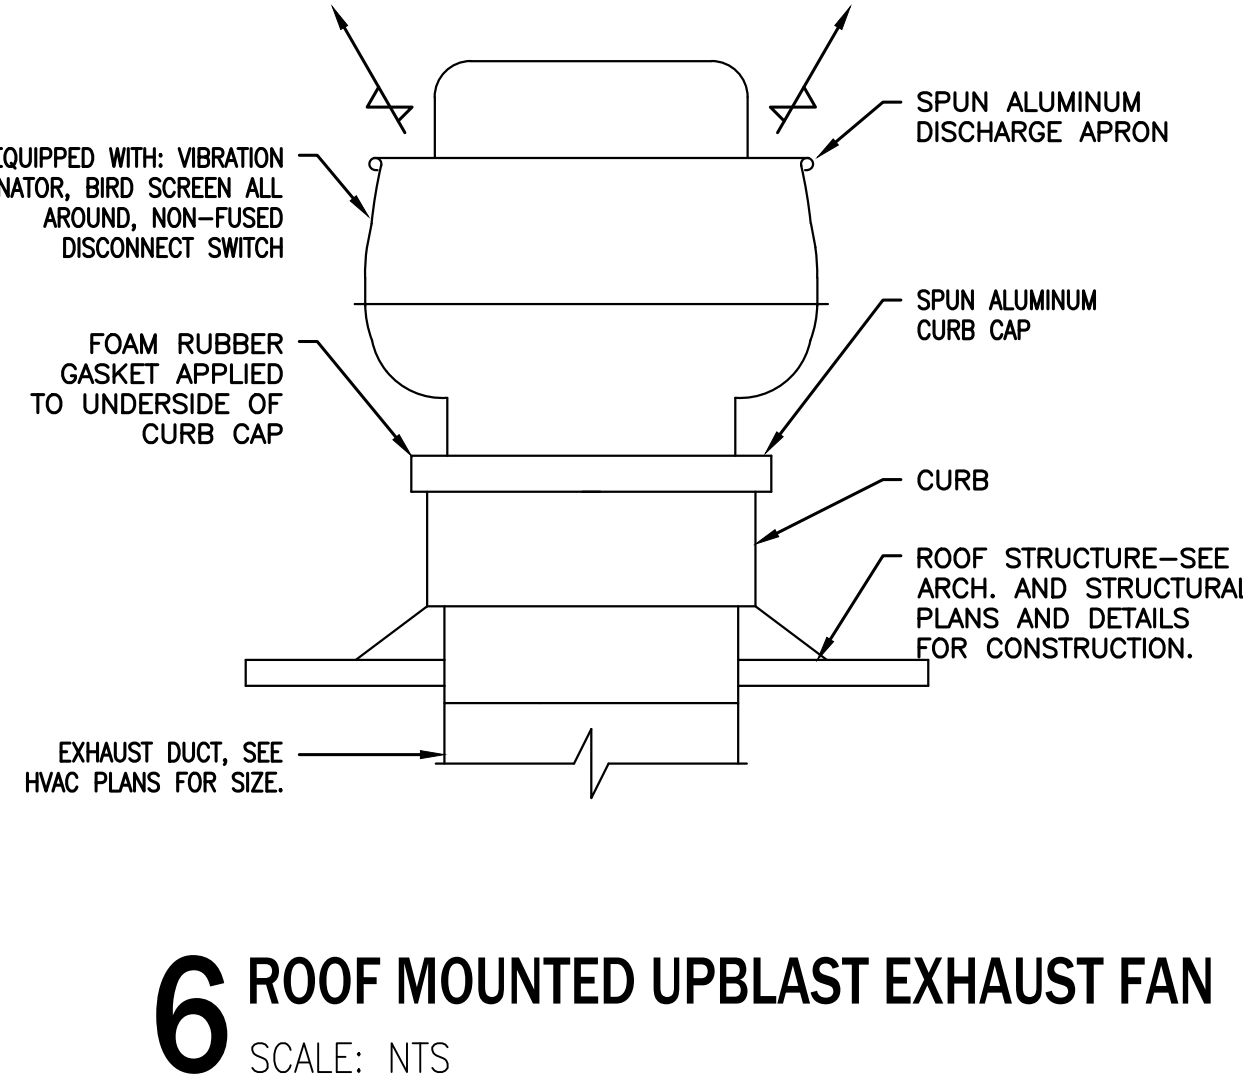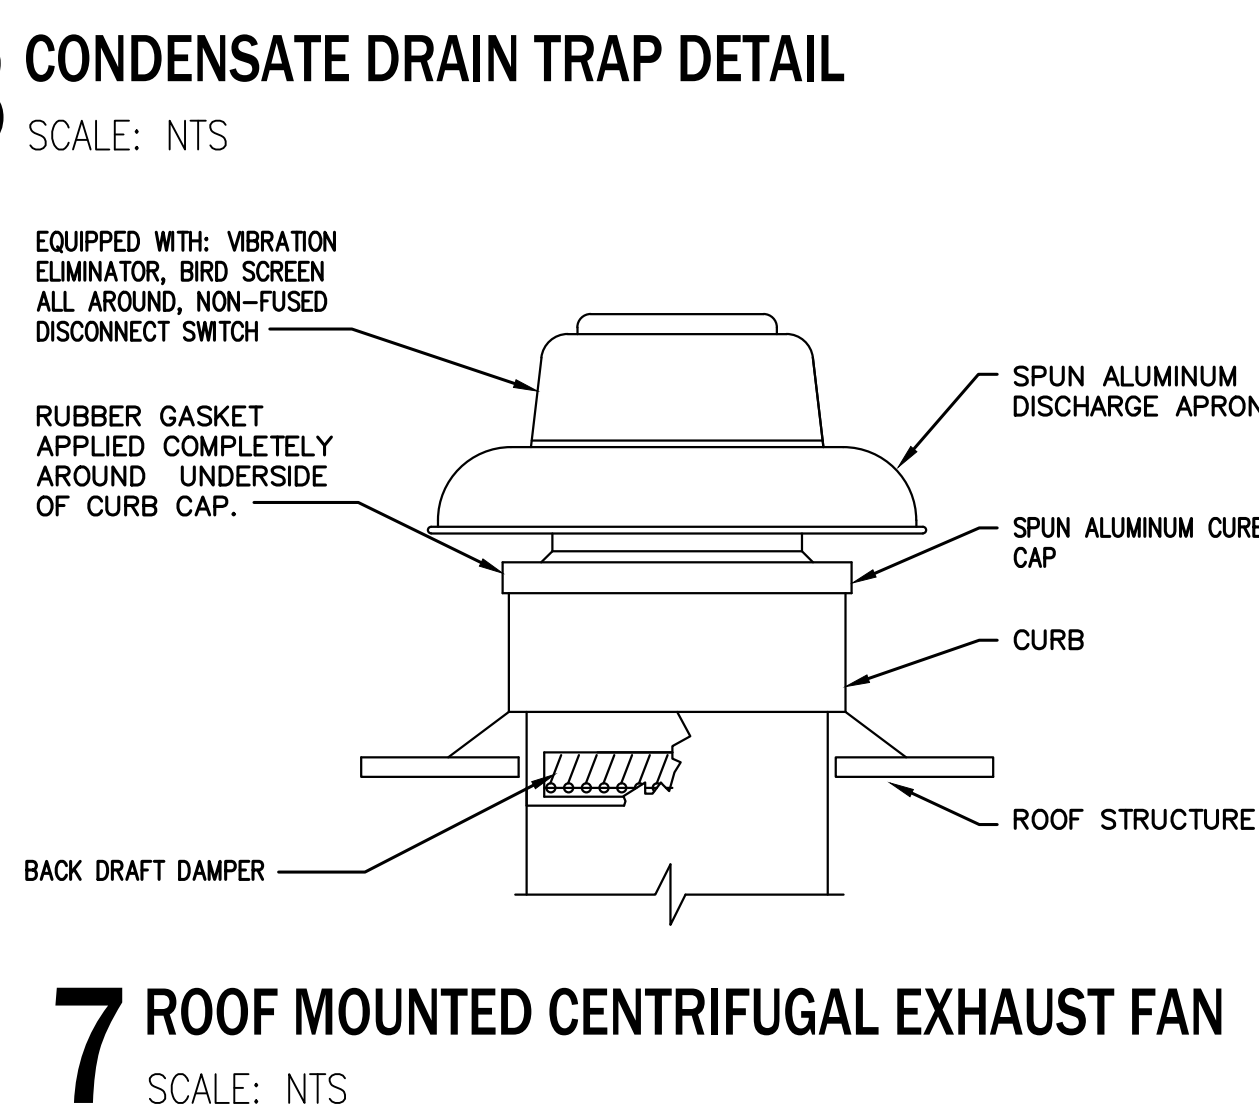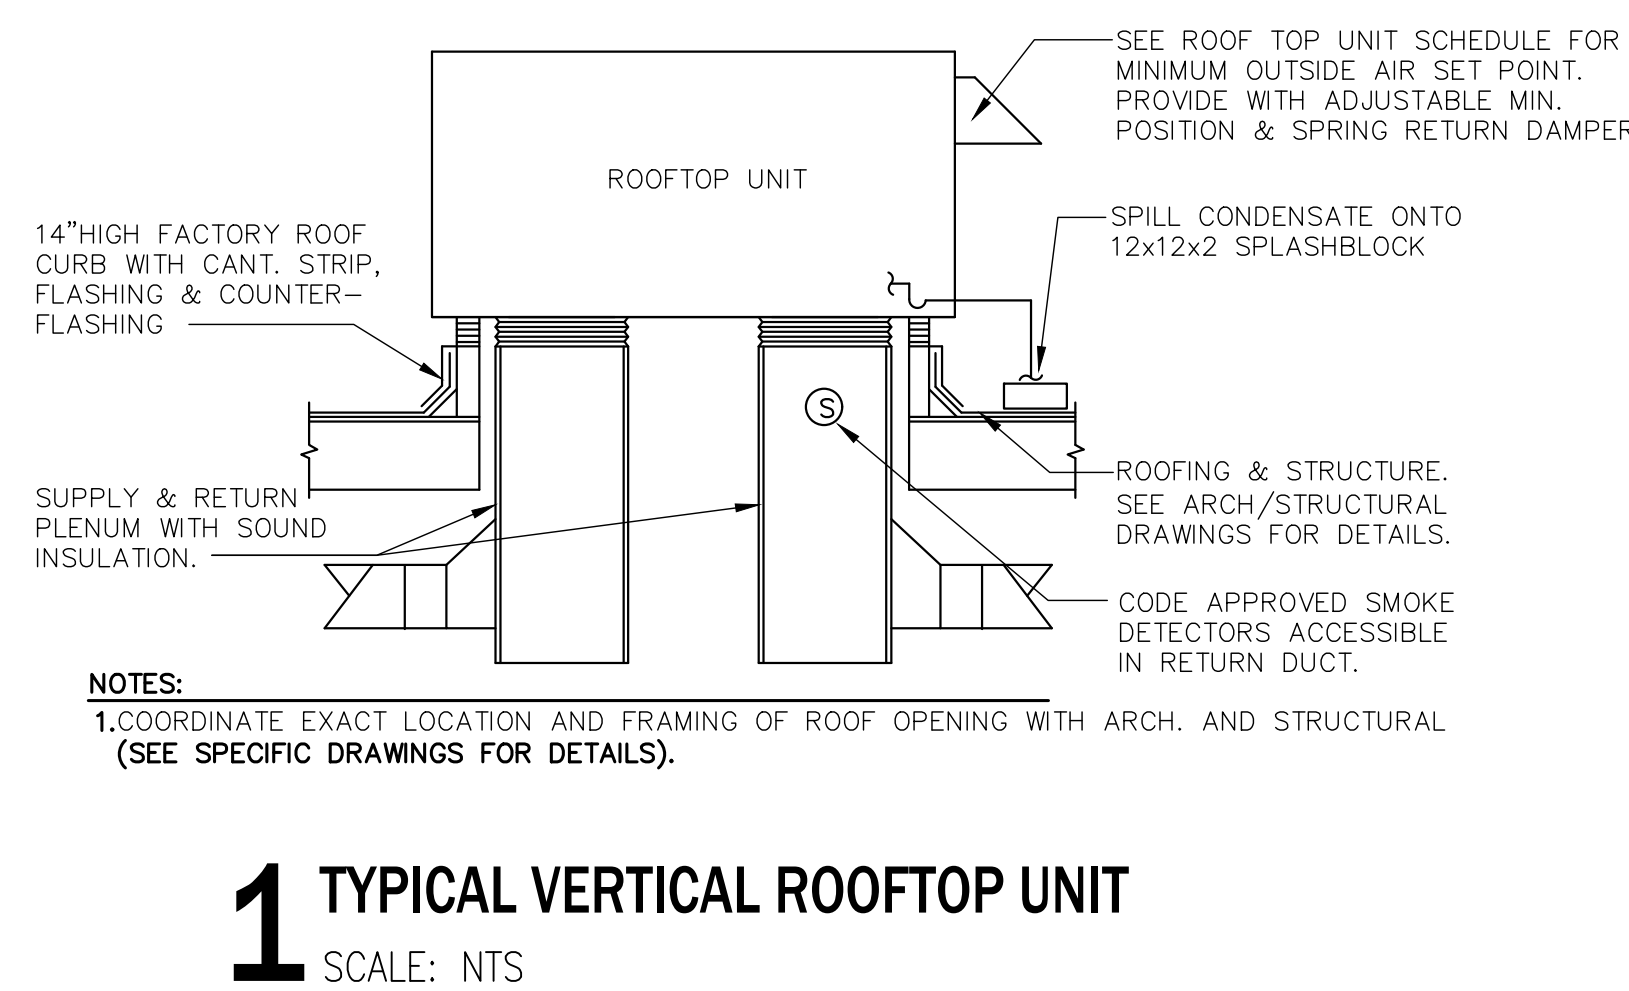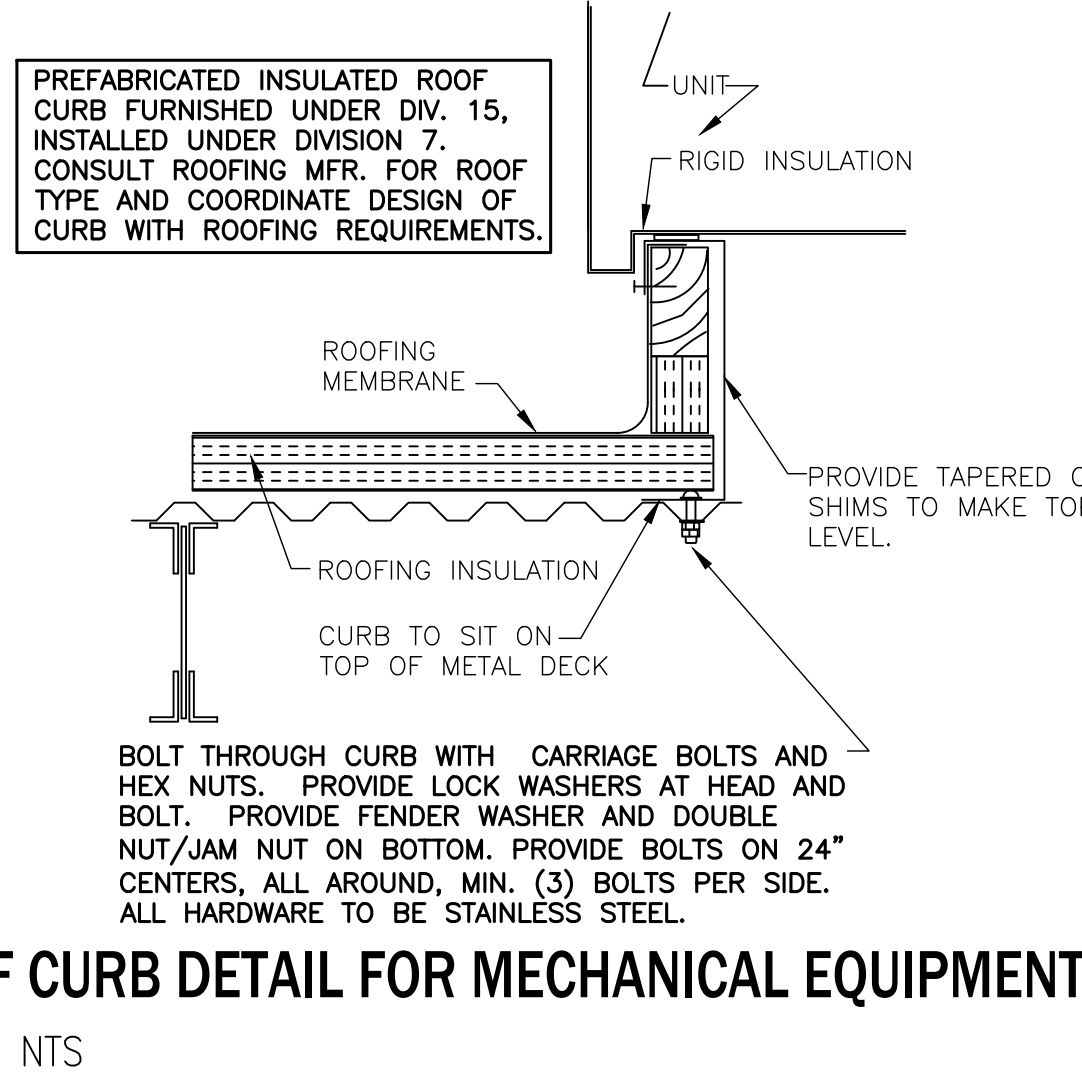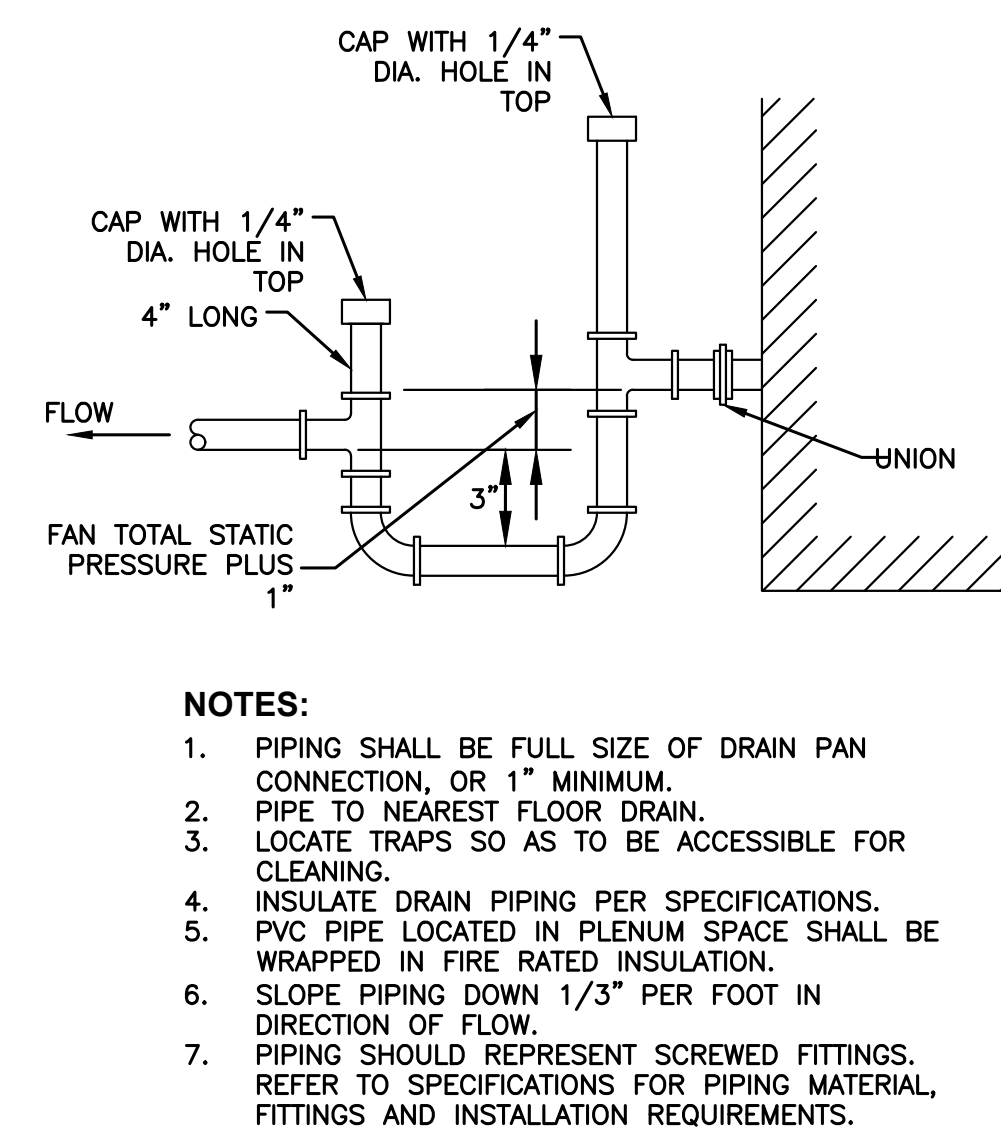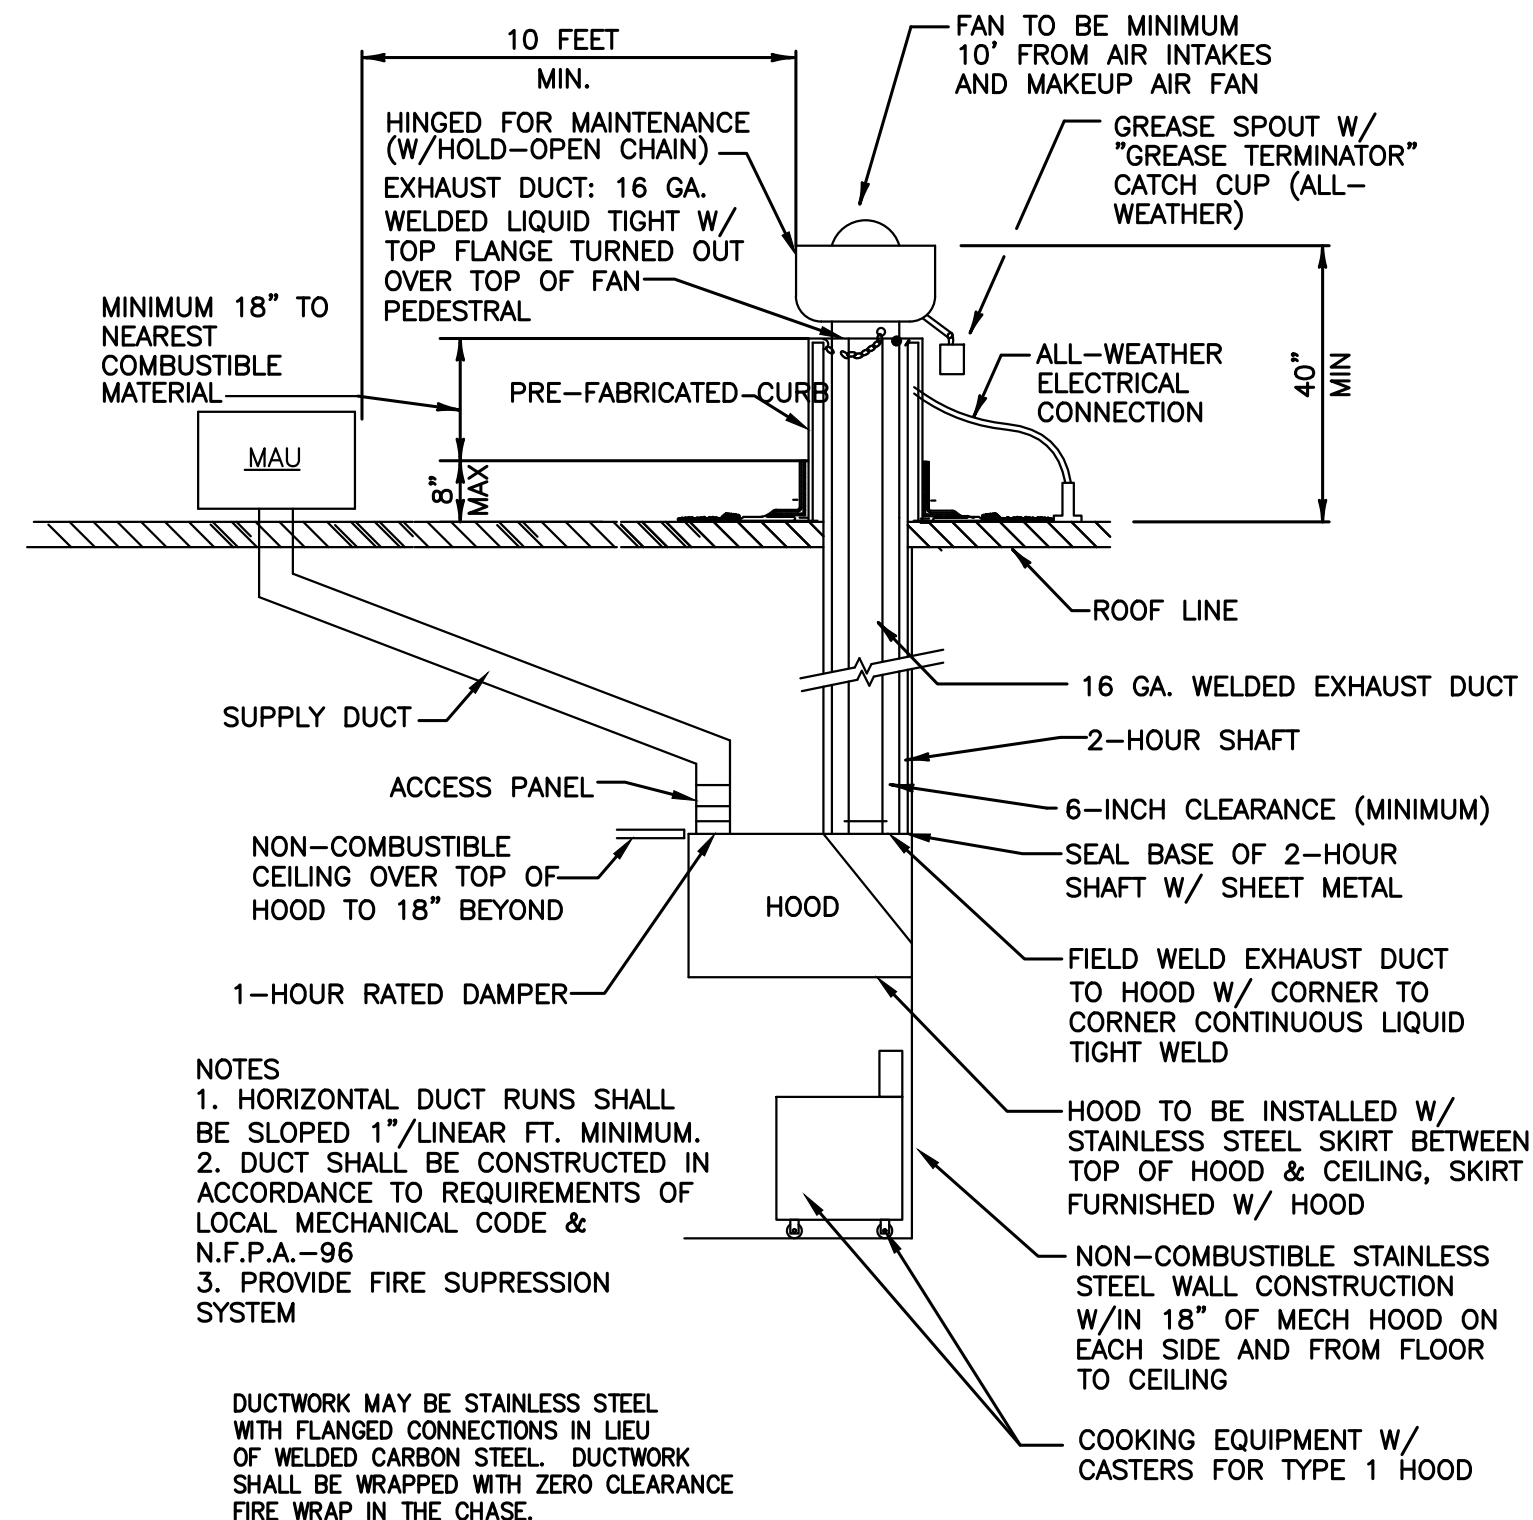

14 SUPPLY AIR DUCT AND REGISTER SECTION
SCALE: NTS

13 SPIRAL DUCT HANGER DETAIL
SCALE: NTS

ISSUED FOR CONSTRUCTION

Bach Engineering Solutions Team
Mechanical, Electrical & Plumbing Engineering
(678) 665-3280
Project Number: 19-249


ELECTRICAL LEGEND			
(NOTE: ALL SYMBOLS SHOWN MAY NOT APPEAR ON DRAWINGS AND ARE USED AS APPLICABLE TO THIS PROJECT)			
SYMBOL	DESCRIPTION	REMARKS	MOUNTING HEIGHT TO CENTERLINE UNO
POWER			
	CONDUIT CONCEALED IN WALL OR CEILING		
	CONDUIT CONCEALED IN FLOOR (OR BELOW GRADE ON SITE PLAN)		
	CONDUIT EXPOSED ON WALL OR CEILING		
	HOMERUN CONDUIT		
	TELEPHONE CONDUIT CONCEALED UNO (MIN. 3/4")		
	SURFACE METAL RACEWAY		
	FLEXIBLE CONNECTION, TYPE AS NOTED		
	OVERHEAD UTILITIES		
	UNDERGROUND POWER		
	UNDERGROUND TELCO		
	WALL MOUNTED JUNCTION BOX		
	JUNCTION BOX		
	WEATHERPROOF JUNCTION BOX		
	FLOOR MOUNTED JUNCTION BOX		
	UNFUSED DISCONNECT SWITCH, RATING/POLES/NEMA RATING (60/3/1)		
	DISCONNECT BY OTHERS		
	FUSED DISCONNECT SWITCH, RATING/POLES/NEMA RATING/FUSE SIZE (60/3/3R/40)		
	POWER POLE WITH VOICE/DATA & POWER RACEWAYS		
	WATER HEATER		
	ELECTRICAL PANEL		
	EQUIPMENT AS INDICATED		
	HAND HOLE		
	MAN HOLE (REFERENCE SPECIFICATIONS)		
	CONDUIT		
	REMOTE PUSH BUTTON		
	SINGLE RECEPT., AMP., VOLTAGE, NEMA CONFIGURATION AS REQUIRED OR AS NOTED		
	120V. DUPLEX RECEPTACLE		18"
	120V. COUNTER TOP DUPLEX RECEPTACLE		42"
	120V. DEDICATED DUPLEX RECEPTACLE		18"
	120V. QUADRUPLEX RECEPTACLE		18"
	120V. DUPLEX RECEPTACLE FOR TV POWER		SEE PLANS
	120V. GF1 RECEPTACLE		
	120V. SQUARE OR ROUND FLOOR BOX WITH (1) DUPLEX RECEPTACLE		
	SQUARE OR ROUND FLOOR BOX WITH (1) DUPLEX RECEPTACLE		
	PHOTO-ELECTRIC SWITCH		
	ON-OFF TIME CLOCK		
	LIGHTING CONTACTOR		
	COMBINATION MOTOR STARTER DISCONNECT		
	POWER POLE		
	LOW VOLTAGE COMMUNICATION CIRCUIT TRANSIENT VOLTAGE SURGE		
	CIRCUIT BREAKER		
	MOTOR		
	TRANSFORMER		
	PULL BOX		
	DENOTES CONDUIT TURNING UP IN PLAN VIEW		
	DENOTES CONDUIT TURNING DOWN IN PLAN VIEW		
	DENOTES CHANGE IN CONDUIT ELEVATION IN PLAN VIEW		
	ELECTRICAL METER		
	MOTOR RATED SWITCH		
LIGHTNG			
	SURFACE MOUNTED INCANDESCENT OR FLUORESCENT LIGHT FIXTURE		
	SURFACE MOUNTED OR PENDENT FLUORESCENT LIGHT FIXTURE		
	SURFACE MOUNTED OR PENDENT EMERGENCY FLUORESCENT LIGHT FIXTURE		
	RECESSED INCANDESCENT OR FLUORESCENT DOWN LIGHT FIXTURE		
	RECESSED INCANDESCENT OR FLUORESCENT EMERGENCY DOWN LIGHT FIXTURE		
	RECESSED EMERGENCY FLUORESCENT LIGHT FIXTURE		
	RECESSED FLUORESCENT LIGHT FIXTURE		
	SURFACE MOUNTED WALL INCANDESCENT OR HID LIGHT FIXTURE		
	RECESSED WALL INCANDESCENT OR HID LIGHT FIXTURE		
	TWO HEAD BATTERY POWERED EMERGENCY EGRESS LIGHT		
	EXIT LIGHT, WALL MOUNTED		
	EXIT LIGHT, WALL MOUNTED WITH DIRECTIONAL ARROW		
	EXIT LIGHT, CEILING MOUNTED		
	EXIT LIGHT, CEILING MOUNTED WITH DIRECTIONAL ARROW		
	AREA OR STREET LIGHT FIXTURE		
	AREA OR STREET LIGHT FIXTURE		
	SINGLE POLE SWITCH		46"
	THREE-WAY SWITCH		46"
	FOUR WAY SWITCH		46"
	SINGLE POLE DIMMER SWITCH 600 WATT		46"
	THERMAL MOTOR SWITCH-(FBD)		46"
	SINGLE POLE SWITCH WITH PILOT LIGHT		46"
	SINGLE POLE SWITCH, WEATHERPROOF		46"
SYSTEM			
	TELEPHONE OUTLET & PLATE		
	GANG DATA OUTLET & PLATE		
	COMBINATION TELEPHONE & DATA OUTLET		
	TELEPHONE BACKBOARD		
GROUNDING			
	GROUND ROD C/W INSPECTION SLEEVE		
	GROUNDING ELECTRODE		
	EXOTHERMIC WELD CONNECTION		

ABBREVIATIONS	
AFG	ABOVE FINISHED GRADE
ABV	ABOVE BOARD COUNTER
ABC	ABOVE CEILING
AFF	ABOVE FINISHED FLOOR
AIC	AMPERE INTERRUPTING CAPACITY
ATS	AUTOMATIC TRANSFER SWITCH
AWG	AMERICAN WIRE GAUGE
BFG	BELOW FINISHED GRADE
BKR	BREAKER
C	CONDUIT
C/W	COMPLETE WITH
CKT	CIRCUIT
CL	CENTER LINE
CLG	CEILING
CT	CURRENT TRANSFORMER
DF	ELECTRIC DRINKING FOUNTAIN
EC	EMPTY CONDUIT
ELEC	ELECTRICAL
EX	EXISTING
FA	FIRE ALARM
FAA	FIRE ALARM ANNUNCIATOR
FACP	FIRE ALARM CONTROL PANEL
FBE	FURNISHED & INSTALLED BY ELECTRICAL CONTRACTOR
FBO	FURNISHED BY OTHERS, INSTALLED BY ELECTRICAL CONTRACTOR
FS	FIRE SUPPRESSION
FSCP	FIRE SUPPRESSION CONTROL PANEL
G	GROUND
GND	GROUND
GEC	GROUNDING ELECTRODE CONDUCTOR
GFI	GROUND FAULT INTERRUPTER
HP	HORSEPOWER
I	IONIZATION
IMC	INTERMEDIATE METALLIC CONDUIT (GALVANIZED)
JB	JUNCTION BOX
KCMIL	THOUSAND CIRCULAR MILS
LV	LOW VOLTAGE
MCB	MAIN CIRCUIT BREAKER
MLO	MAIN LUG ONLY
MTS	MANUAL TRANSFER SWITCH
NC	NORMALLY CLOSED
NIC	NOT IN CONTRACT
NL	NIGHT LIGHT
NO	NORMALLY OPEN
NTS	NOT TO SCALE
OC	OVER COUNTER
P	PHOTOELECTRIC
PM	POWER MONITOR
RMC	RIGID METALLIC CONDUIT (GALVANIZED)
RNC	RIGID NON-METALLIC CONDUIT
S/C	SEPARATE CIRCUIT
SCH	SCHEDULE
SPST	SINGLE POLE SINGLE THROW
TB	TELEPHONE TERMINAL BOARD
THD	TOTAL HARMONIC DISTORTION
TVSS	TRANSIENT VOLTAGE SURGE SUPPRESSOR
U/G	UNDERGROUND
UL	UNDERWRITERS LABORATORIES
UNO	UNLESS NOTED OTHERWISE
W	WALL MOUNTED
WH	WATER HEATER
WP	WEATHER PROOF, NEMA 3R

1. ALL ELECTRICAL WORK SHOWN ON THESE DRAWINGS IS THE RESPONSIBILITY OF THE ELECTRICAL CONTRACTOR UNLESS NOTED OTHERWISE ON THE DRAWINGS OR IN THE SPECIFICATIONS. FABRICATION AND INSTALLATION OF THE COMPLETE ELECTRICAL SYSTEM SHALL BE DONE IN THE FIRST CLASS WORKMANSHIP BY QUALIFIED TRADES PERSONS EXPERIENCED IN SUCH WORK.
2. SUBMISSION OF BID FOR THE ELECTRICAL WORK INDICATES THAT THE ELECTRICAL CONTRACTOR IS FAMILIAR WITH THE DESIGN INTENT, THE REQUIREMENTS OF THE PROJECT, REQUIREMENTS OF THE LOCAL ELECTRICAL AND TELEPHONE UTILITIES, AND LOCAL APPLICABLE CODES AND ORDINANCES.
3. ALL ELECTRICAL WORK SHALL CONFORM TO THE EDITION OF THE NEC ACCEPTED BY THE LOCAL AUTHORITY HAVING JURISDICTION.
4. SOME ASPECTS OF ELECTRICAL DESIGN ARE COMMONLY EXPRESSED IN SCHEMATIC FORM. IT IS THE RESPONSIBILITY OF THE ELECTRICAL CONTRACTOR TO INTERPRET THEM ACCURATELY AND CARRY OUT THE CONSTRUCTION AND/OR INSTALLATION SATISFACTORY TO THE CONSULTANT AND THE OWNER. IN CASE OF ANY UNCERTAINTIES OR AMBIGUITIES PROMPTLY CONSULT WITH THE PROJECT MANAGER FOR CLARIFICATION.
5. ABBREVIATIONS AND ACRONYMS USED ON THE DRAWINGS ARE DESCRIBED IN THE APPROPRIATE SECTION OF THE SPECIFICATIONS. SOME COMMONLY USED AND INDUSTRY STANDARD ABBREVIATIONS AND ACRONYMS MAY NOT BE DESCRIBED. IF A CLARIFICATION IS REQUIRED PROMPTLY CONTACT THE PROJECT MANAGER.
6. SCHEDULE AND COORDINATE ALL WORK WITH OTHER TRADES BEFORE INSTALLATION OF EQUIPMENT TO AVOID CONFLICT DURING AND AFTER THE INSTALLATION.

(COORDINATE WITH OWNER FOR ALL LIGHT FIXTURE TYPES PRIOR TO INSTALL)

TYPE	MANUFACTURER	PRODUCT NUMBER	NUMBER & SIZE LAMPS	MOUNT	REMARKS
A	LITHONIA OR APPROVED EQUAL	EPNL2X4 5400LM-80CRI-35K-MVLT-RIO	LED INCLUDED 55 WATTS LED	RECESSED	2X4 LED LIGHT FIXTURE TRIM SHALL BE WHITE. LENS SHALL BE SATIN WHITE.
B	RAYON LIGHTING OR APPROVED EQUAL	RPA6-10L-35-ID-50-F-WW-UNV	LED INCLUDED 20 WATT	RECESSED	6" APERTURE LED DOWN LIGHTS WHITE FINISH. CONTRACTOR SHALL CONFIRM FINAL TRIM FINISH WITH OWNER PRIOR TO ORDERING.
C	RAYON LIGHTING OR APPROVED EQUAL	RPA6-10L-35-ID-50-F-BB-UNV	LED INCLUDED 20 WATT	RECESSED	6" APERTURE LED DOWN LIGHTS BLACK FINISH. CONTRACTOR SHALL CONFIRM FINAL TRIM FINISH WITH OWNER PRIOR TO ORDERING.
D	OWNER SELECTED OR APPROVED EQUAL	OWNER SELECT	LED INCLUDED	SURFACE	LED STRIP LIGHTS LED STRING LIGHTS AS SELECTED BY OWNER. FIXTURE SHALL BE EXTERIOR RATED. FIXTURE WIRE AND TRIM FINISH SHALL BE BLACK.
F	LITHONIA OR APPROVED EQUAL	CSVL48 5000LM MVOLT 40K 80CRI	LED INCLUDED 35 WATTS LED	SURFACE	4 FEET GASKETED DUMPMSTER AREA LIGHTS. TRIM SHALL BE GRAY LENS SHALL BE SATIN WHITE. CONTRACTOR SHALL PROVIDE ALL REQUIRED PRESSURE TREATED BLOCKING TO MOUNT FIXTURE NEAR BOTTOM OF ROOF JOISTS, VERIFY IN FIELD.
OA	LITHONIA OR APPROVED EQUAL	WDGE2-LED-P3-40K CRI 80 VF 30K MVOLT DBLXD	LED INCLUDE	WALL	WALL SCONCE. HOUSING FINISH SHALL BE BLACK.
OB	MODERN FORMS OR APPROVED EQUAL	TWO IF BY SEA WS-W41925-20W-B-1600LM-30K-UNV	LED INCLUDED	WALL	EXTERIOR WALL SCONCE HOUSING FINISH SHALL BE BLACK.
EM	LITHONIA OR APPROVED EQUAL	EU2L- M12-UNV-WHT	INCLUDED	WALL	EMERGENCY LIGHT WITH BATTERY BACK UP. FIELD VERIFY MOUNTING HEIGHTS. HOUSING FINISH SHALL BE WHITE WITH RED LETTERS.
EMX1	LUMINARE LED OR APPROVED EQUAL	BLD 36IN MINI 5W 30K UNV CPL BLK EMB310	LED	WALL	LED WALL PACK WITH EMERGENCY BATTERY BACK UP FOR EXTERIOR MOUNT ABOVE DOOR. WALL SHALL ONLY BE POWERED IN THE EVENT OF AN EMERGENCY OR IN A LOSS OF POWER. HOUSING FINISH SHALL BE BLACK.
EMX2	LITHONIA OR APPROVED EQUAL	WDGE2-LED-P3-40K CRI 80 VF 30K MVOLT DBLXD-E20WC	LED INCLUDE	WALL	WALL SCONCE. HOUSING FINISH SHALL BE BLACK. WITH EMERGENCY BATTERY BACK UP.
X	LITHONIA OR APPROVED EQUAL	ECC B R	LED	WALL OR CEILING MOUNTED	EXIT SIGN AND EMERGENCY LIGHTS COMBO. WALL OR CEILING MOUNTING AS INDICATED ON THE DRAWING. DIRECTIONAL ARROWS AS INDICATED IN THE DRAWING. HOUSING FINISH SHALL BE WHITE WITH RED LETTERS.
XE	LITHONIA OR APPROVED EQUAL	ECC B R	LED	WALL OR CEILING MOUNTED	EXIT SIGN AND EMERGENCY LIGHTS COMBO. WALL MOUNTED HOUSING SHALL BE BLACK WITH RED LETTERING. CONFIRM FINAL FINISHES ARE ACCEPTABLE TO THE AUTHORITY HAVING JURISDICTION PRIOR TO ORDERING.

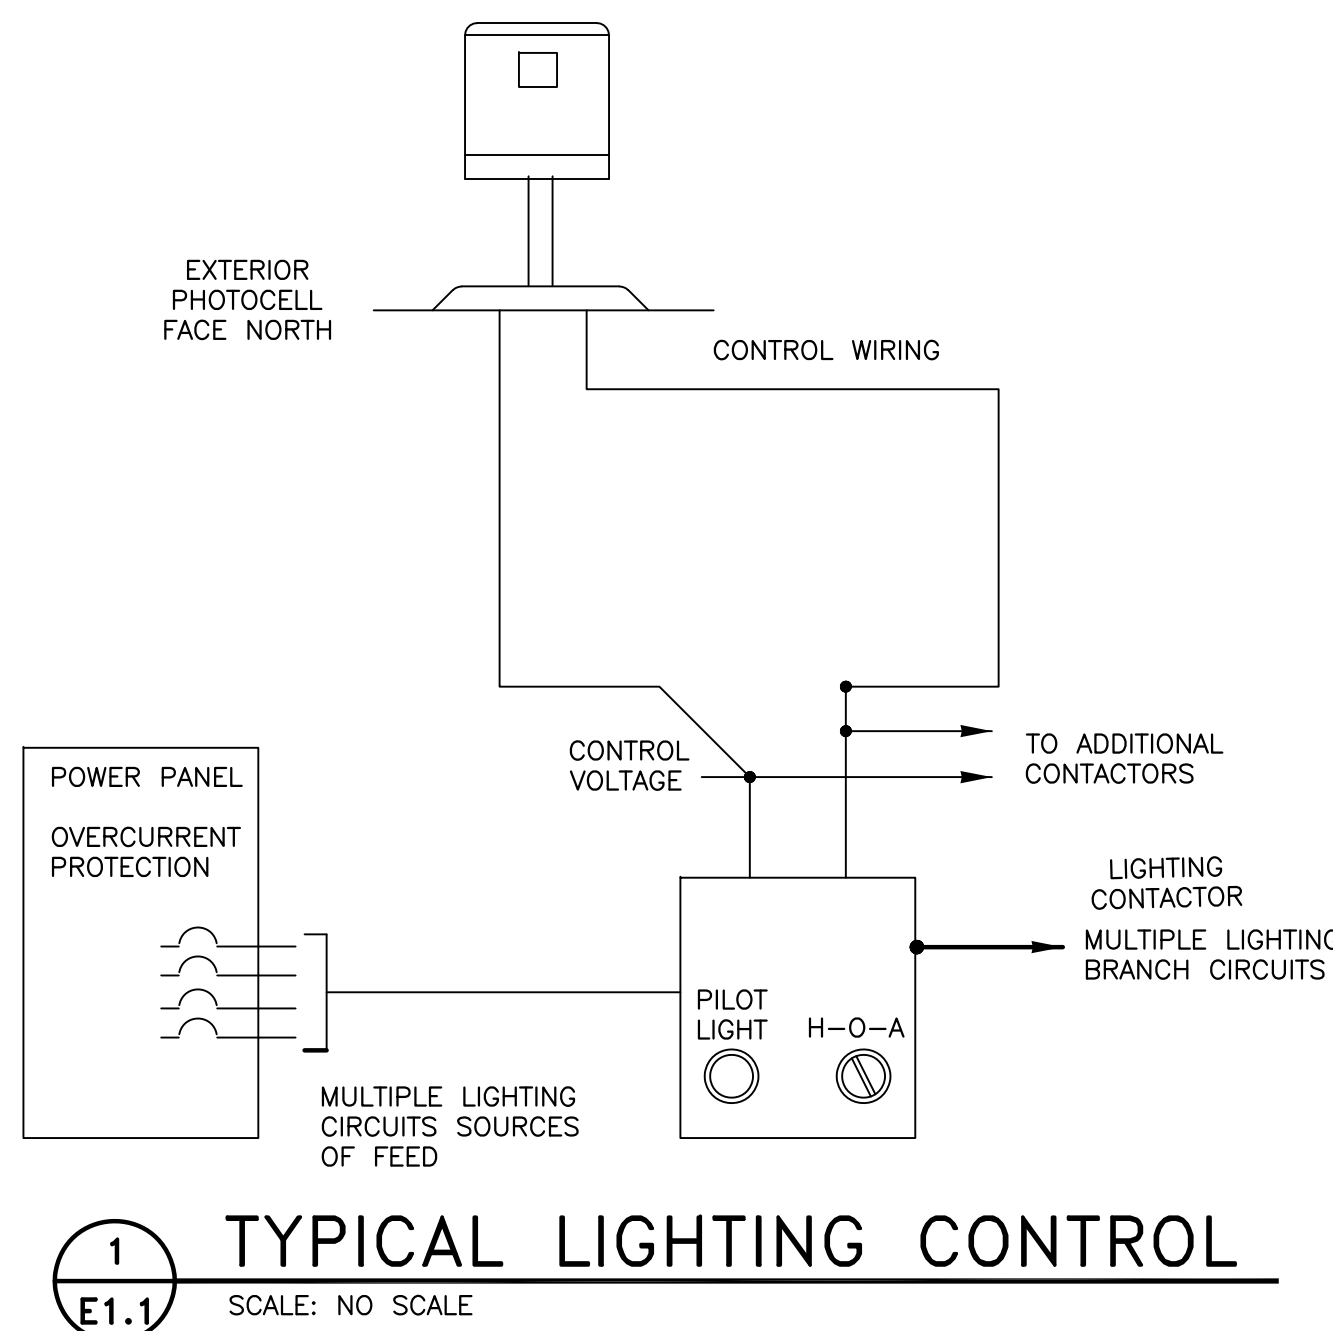

- NOTES:

1. TIME SWITCH SHALL BE SOLID STATE ELECTRONIC PERMITTING 10 ON/OFF SET POINTS DISTRIBUTED ON INDEPENDENT DAILY SCHEDULE. PROVIDE LCD DISPLAY TO SHOW DAY OF WEEK. PROVIDE REMOTE USER SET POINTS BY REMOTE BATTERY BACKUP PROGRAM PROTECTION WITH MINIMUM 2 YEAR LIFE. 60VAC, 30A CONTACT BALLAST RATED AND 20A TUNGSTEN RATED. UL LISTED 916 ENERGY MANAGEMENT EQUIPMENT. INTERMATIC OR APPROVED ALIKE.
2. LIGHTING CONTACTOR SHALL BE ELECTRICALLY HEAVY, 600VAC, 30A CONTACT BALLAST RATED AND 20A TUNGSTEN RATED. CONTACTS PER CONTROLLED CIRCUIT PLUS 2 SPARE PER CONTACTOR. UL 508 STANDARD FOR INDUSTRIAL CONTROL EQUIPMENT LISTED.
3. COILS VOLTAGES SHALL MATCH CONTACT VOLTAGE. PROVIDE CPT OR ALTERNATE 120V SOURCE FOR SYSTEMS OF 277V OR 480V. PROVIDE 12 HOUR TIME DELAY FOR CONTACTOR AND NEMA 3R-OUTDOOR WITH HINGED LOCKABLE COVERS.

A. GENERAL

- EXAMINE THE SITE CONDITIONS VERY CAREFULLY AND THE SCOPE OF PROPOSED WORK TOGETHER WITH THE WORK OF ALL OTHER TRADES AND INCLUDE IN THE BID PRICE ALL COSTS FOR WORK SUCH AS EQUIPMENT AND WIRING MADE NECESSARY TO ACCOMMODATE THE ELECTRICAL SYSTEMS SHOWN AND SYSTEMS OF OTHER TRADES.
- SUBMITTAL OF BID INDICATES CONTRACTOR IS COGNIZANT OF ALL JOB SITE CONDITIONS AND WORK TO BE PERFORMED UNDER THIS CONTRACT.
- PERFORM DETAILED VERIFICATION OF WORK PRIOR TO ORDERING THE ELECTRICAL EQUIPMENT AND COMMENCING CONSTRUCTION. ISSUE A WRITTEN NOTICE TO THE CONSULTANT OF ANY DISCREPANCIES.
- OBTAIN ALL PERMITS, PAY ASSOCIATED FEES AND SCHEDULE INSPECTION.
- SUBMIT SHOP DRAWINGS, PRODUCT DATA AND SAMPLES. INDICATE DETAILS OF CONSTRUCTION, DIMENSIONS, CAPACITIES, WEIGHTS AND ELECTRICAL PERFORMANCE CHARACTERISTICS OF EQUIPMENT OR MATERIAL. WHERE APPLICABLE, INCLUDE WIRING AND SINGLE LINE DIAGRAMS. ADVERTISING OR SALES LITERATURE SHALL NOT BE ACCEPTABLE AS SHOP DRAWINGS.
- PROVIDE ALL LABOR, MATERIAL, EQUIPMENT, INSURANCE AND SERVICES TO COMPLETE THIS PROJECT IN ACCORDANCE WITH THE CONTRACT DOCUMENTS AND PRESENT IT AS FULLY OPERATIONAL TO THE SATISFACTION OF THE OWNER.
- CARRY OUT WORK IN ACCORDANCE WITH ALL GOVERNING STATE, COUNTY AND LOCAL CODES AND O.S.H.A.
- PRIOR TO BEGINNING WORK COORDINATE ALL POWER AND TELCO WORK WITH THE LOCAL UTILITY COMPANIES AS IT MAY APPLY TO THIS SITE. ALL WORK TO COMPLY WITH THE RULES AND REGULATIONS OF THE UTILITIES INVOLVED.
- PROVIDE ALL CUTTING AND PATCHING NECESSARY FOR THE INSTALLATION OF THE ELECTRICAL WORK. ANY DAMAGE DONE TO THE WORK ALREADY IN PLACE BY REASON OF THIS WORK SHALL BE REPAIRED AT THE CONTRACTOR'S EXPENSE BY A QUALIFIED MECHANIC EXPERIENCED IN SUCH WORK. PATCHING SHALL BE UNIFORM IN APPEARANCE AND SHALL MATCH THE SURROUNDING SURFACE. DO NOT CUT STRUCTURAL MEMBERS WITHOUT APPROVAL OF THE CONSULTANT.
- CORE DRILLING THROUGH WALLS AND FLOORS FOR CONDUIT AND CABLE INSTALLATION IS TO BE PROVIDED BY THE GENERAL CONTRACTOR AT LOCATIONS DETERMINED BY THE STRUCTURAL ENGINEER. REFER TO STRUCTURAL DRAWINGS AND COORDINATE WITH GENERAL CONTRACTOR FOR INSTALLATION OF CONDUITS AND CABLES THROUGH WALLS AND FLOORS.
- WHERE CABLE OR CONDUITS PASS THROUGH FLOORS AND FIRE RATED WALLS, SEAL CORE DRILLED OPENINGS AROUND CONDUITS OR CABLES USING UL APPROVED FIRE-STOPPING SYSTEM AND UL LISTED SEALANT.
- ENSURE THAT ALL LIGHT, POWER, HEAT, TELEPHONE AND OTHER ELECTRICAL AND MECHANICAL SYSTEMS AND SERVICES IN THE BUILDING REMAIN OPERATIONAL DURING THE COURSE OF THIS PROJECT. PROVIDE TEMPORARY SERVICES AS REQUIRED. INCLUDE ALL COSTS FOR TEMPORARY SERVICES IN THE BID PRICE. REMOVE ALL EXISTING EQUIPMENT, WIRING ETC. NOT BEING RE-USED UNDER NEW SCHEMES, WHETHER SHOWN ON DRAWINGS OR NOT.
- FABRICATION AND INSTALLATION OF THE COMPLETE ELECTRICAL SYSTEM SHALL BE DONE IN A FIRST-CLASS WORKMANSHIP MANNER PER NECA STANDARD 1-2000 BY QUALIFIED PERSONNEL EXPERIENCED IN SUCH WORK. WORK SHALL BE SCHEDULED IN AN ORDERLY MANNER SO AS NOT TO IMPEDE PROGRESS OF THE PROJECT.
- DURING PROGRESS OF THE WORK, MAINTAIN AN ACCURATE RECORD OF THE INSTALLATION OF THE ELECTRICAL SYSTEMS, LOCATING EACH CIRCUIT PRECISELY AND DIMENSIONING EQUIPMENT, CONDUIT AND CABLE LOCATIONS. UPON COMPLETION OF THE INSTALLATION, TRANSFER ALL RECORD DATA TO BLACK LINE PRINTS OF THE ORIGINAL DRAWINGS IN RED AND SUBMIT THESE DRAWINGS AS RECORD DRAWINGS TO THE CONSULTANT.
- AT THE COMPLETION OF THE PROJECT PROVIDE THREE SETS OF OPERATION AND MAINTENANCE MANUALS, BOUND IN 3-RING BINDERS, DULY LABELED, AND CONTAINING COMPLETE LIST OF REPLACEMENT PARTS, SHOP DRAWINGS AND CATALOG INFORMATION OF ALL MAJOR EQUIPMENT, SUCH AS TRANSFORMERS, LUMINAIRES, PANEL BOARDS, TRANSFER SWITCH, PANEL SCHEDULE, A/C SYSTEMS, TVSS, SECURITY SYSTEM, ETC.
- THE COMPLETE JOB SHALL BE GUARANTEED FOR A PERIOD OF TIME OF ONE (1) YEAR AFTER THE DATE OF JOB ACCEPTANCE BY OWNER. ANY WORK, MATERIAL OR EQUIPMENT FOUND TO BE FAULTY DURING THAT PERIOD SHALL BE CORRECTED AT ONCE UPON WRITTEN NOTIFICATION AT THE EXPENSE OF THE CONTRACTOR.

B. SERVICE AND DISTRIBUTION

- CONTRACTOR TO COORDINATE WITH LANDLORD AND/OR UTILITIES FOR CONNECTION OF TEMPORARY AND PERMANENT POWER TO THE SITE. THE TEMPORARY POWER AND ALL HOOK UP COSTS TO BE PAID BY CONTRACTOR. CONTRACTOR TO OBTAIN NECESSARY PERMITS, PAY ALL ASSOCIATED FEES AND SCHEDULE INSPECTIONS OF SERVICE WITH LOCAL AUTHORITIES HAVING JURISDICTION.
- MAIN DISTRIBUTION CONFIGURATION SHALL BE BASED ON THE DESIGN INTENT.
- VERIFY ALL DIMENSIONS AND CLEARANCES BY FIELD MEASUREMENTS PRIOR TO INSTALLATION.
- BRANCH CIRCUIT PANEL BOARDS SHALL BE OF THE TYPE AND RATINGS AS SHOWN ON DRAWINGS. PANEL BOARDS SHALL BE CUTLER-HAMMER TYPE PRL2A OR APPROVED EQUAL. DISTRIBUTION BOARD SHALL BE CUTLER-HAMMER TYPE POW-R-LINE 4B OR APPROVED EQUAL.
- PANEL BOARDS AND SPLITTERS SHALL HAVE COPPER MAINS AND SHALL BE OF THE CHARACTERISTICS AS NOTED ON THE DRAWINGS. AFTER COMPLETION OF WIRING, PROVIDE A TYPED DIRECTORY SHOWING A CLEAR DESCRIPTION OF EACH CIRCUIT BEING FED FROM PANEL AND PLACE IN METAL FRAME INSIDE DOOR.

C. BASIC MATERIALS AND METHODS

- INSTALLATION, MATERIALS, EQUIPMENT AND WORKMANSHIP SHALL CONFORM TO THE APPLICABLE PROVISIONS OF THE NATIONAL ELECTRICAL SAFETY CODE (NEC), APPLICABLE STATE ELECTRICAL CODES, THE NATIONAL ELECTRICAL SAFETY CODE (NESC) AND THE TERMS, CONDITIONS AND REGULATIONS OF THE AUTHORITY HAVING LAWFUL JURISDICTION PERTAINING TO THE WORK REQUIRED. ALL MATERIAL, EQUIPMENT AND DEVICES SHALL CONFORM TO THE APPLICABLE STANDARDS OF THE UNDERWRITERS LABORATORIES INC. (UL), THE LABEL OF AND LISTING BY UL IS MANDATORY.
- ALL MATERIALS AND EQUIPMENT SHALL BE NEW. MATERIALS AND EQUIPMENT SHALL BE THE STANDARD PRODUCTS OF MANUFACTURER'S CURRENT DESIGN. ANY FIRST-CLASS PRODUCT MADE BY A REPUTABLE MANUFACTURER MAY BE USED PROVIDED IT CONFORMS TO THE CONTRACT REQUIREMENTS AND MEETS THE APPROVAL OF THE CONSULTANT AND THE OWNER. APPROVALS SHALL BE OBTAINED PRIOR TO INSTALLATION.

- ARRANGE CONDUIT, WIRING, EQUIPMENT, AND OTHER WORK GENERALLY AS SHOWN, PROVIDING PROPER CLEARANCES AND ACCESS. CAREFULLY EXAMINE ALL CONTRACT DRAWINGS AND FIT THE WORK IN EACH LOCATION WITHOUT SUBSTANTIAL ALTERATION, WHERE DEPARTURES ARE PROPOSED BECAUSE OF FIELD CONDITIONS OR OTHER CAUSES, PREPARE AND SUBMIT DETAILED DRAWINGS FOR ACCEPTANCE. THE RIGHT IS RESERVED TO MAKE REASONABLE CHANGES IN LOCATION OF EQUIPMENT, CONDUIT, AND WIRING UP TO THE TIME OF ROUGH-IN OR FABRICATION.
- THE CONTRACT DRAWINGS ARE GENERALLY DIAGRAMMATIC AND ALL OFFSETS, BENDS, FITTINGS, PULL BOXES AND ACCESSORIES ARE NOT NECESSARILY SHOWN. PROVIDE ALL SUCH ITEMS AS MAY BE REQUIRED TO FIT THE WORK TO THE CONDITIONS.
- MOUNTING HEIGHTS OF ALL WIRING DEVICES SHALL BE VERIFIED WITH THE CONSULTANT PRIOR TO INSTALLATION.
- ALL OUTDOOR ELECTRICAL EQUIPMENT SHALL BE NEMA 3R RATED UNLESS NOTED OTHERWISE.
- MAINTAIN ALL CLEARANCES AS REQUIRED BY NEC.
- SEAL AROUND CONDUITS AND AROUND CONDUCTORS WITHIN CONDUITS ENTERING THE MODULAR CABINETS WHERE PENETRATION OCCURS WITH A SILICONE SEALANT TO PREVENT MOISTURE PENETRATION INTO BUILDING.
- SILICONE SEAL AROUND ALL BOLTS AND SCREWS USED TO SECURE EQUIPMENT TO EXTERIOR OF BUILDING.
- MAKE NECESSARY CONNECTIONS FOR BATTERY IN EMERGENCY LIGHT FIXTURE. CONNECT EXTERIOR LIGHT FIXTURE (PROVIDED BY SHELTER MANUFACTURER) TO EXTERNAL JUNCTION BOX.

D. RACEWAYS AND BOXES

- ALL WIRING FOR POWER AND SYSTEMS SHALL BE IN CONDUIT UNLESS DIRECTED OTHERWISE. ALL CONDUIT SHALL BE UL LABELED. MINIMUM SIZE CONDUIT SHALL BE 1/2" INCH TRADE SIZE UNLESS NOTED OTHERWISE.
- UNLESS NOTED OTHERWISE, CONDUIT INSTALLED OUTDOORS SHALL BE GALVANIZED IMC OR GALVANIZED RMC WITH LIQUID TIGHT FITTINGS. ALL EXTERIOR HARDWARE SHALL BE GALVANIZED STEEL.
- CONDUIT INSIDE BUILDING IN AREAS WHERE CONDUIT IS SAFE FROM MECHANICAL DAMAGE AND WHERE CONCEALED IN DRYWALL, METAL FLASHING ETC. SHALL BE EMT WITH COMPRESSION FITTINGS. CONDUIT IN HIGH TRAFFIC AREA, IN AREAS OF RISK OF PHYSICAL DAMAGE AND IN STAIRWELLS SHALL BE GALVANIZED RMC.
- FINAL CONNECTIONS TO MOTORS AND VIBRATING EQUIPMENT SHALL BE INSTALLED IN LIQUID-TIGHT FLEXIBLE METAL CONDUIT.
- CONDUIT WORK IN HAZARDOUS AREAS, OR AREAS WITH LARGE TEMPERATURE DIFFERENTIAL: USE RIGID STEEL OR IMC CONDUIT WITH CONDUIT SEAL FITTINGS, POURED WITH HARDENING COMPOUND AFTER CONDUCTORS ARE FILLED IN CONDUIT. SEALS SHALL BE INSTALLED PER NEC.
 - ACCEPTABLE MANUFACTURERS OF SEALS:
 - CROUSE-HINDS
 - APPLETON
 - KILLARK
 - O-Z/GEDNEY

E. CONDUCTORS AND CONNECTORS

- UNLESS NOTED OTHERWISE, ALL CONDUCTORS SHALL BE COPPER, MINIMUM SIZE #12 AWG, WITH THERMOPLASTIC INSULATION (TYPES THHN OR THWN) CONFORMING TO NEMA WC5 OR CROSS-LINKED POLYETHYLENE INSULATION (TYPE XHHW) CONFORMING TO NEMA WC7. INSULATION SHALL BE RATED FOR 90°C. CONDUCTORS SHALL BE SOLID FOR #10 AND SMALLER, STRANDED FOR #8 AND LARGER.
- CONDUCTORS SHALL BE COLOR CODED AS FOLLOWS: 208/120V – BLACK (PHASE A), RED (PHASE B), BLUE (PHASE C), WHITE (NEUTRAL), GREEN (GROUND); 480/277V – BROWN (PHASE A), ORANGE (PHASE B), YELLOW (PHASE C), GRAY (NEUTRAL), GREEN (GROUND).
- FOR COPPER CONDUCTORS #6 AWG AND SMALLER USE 3M SCOTCH-LOK OR T&B STA-KON COMPRESSION TYPE CONNECTORS WITH INTEGRAL OR SEPARATE INSULATION CAPS. FOR COPPER CONDUCTORS LARGER THAN #6 AWG USE SOLDERLESS, IDENT HEX SCREW OR BOLT TYPE PRESSURE CONNECTORS OR DOUBLE COMPRESSION C-CLAMP CONNECTORS, UNLESS SPECIFIED OTHERWISE ON DRAWINGS.
- UNLESS NOTED OTHERWISE ALL LUGS SHALL BE TIN PLATED COPPER, TWO-HOLE, LONG BARREL, COMPRESSION TYPE. CONDUCTOR LENGTHS SHALL BE CONTINUOUS FROM TERMINATION TO TERMINATION WITHOUT SPLICES. SPLICES ARE NOT ACCEPTABLE. IF SPLICES ARE UNAVOIDABLE PRIOR APPROVAL FROM THE CONSULTANT MUST BE OBTAINED.
- ALL UNDERGROUND CONDUIT SHALL BE PVC SCHEDULE 80 UNLESS NOTED OTHERWISE.
- ALL EMPTY CONDUIT INSTALLED FOR FUTURE INSTALLATION OF WIRES AND CABLES SHALL HAVE A PULL CORD.
- PROVIDE CONDUIT EXPANSION/DEFLECTION FITTINGS WHERE CONDUITS CROSS EXPANSION JOINTS, FLOATING SLABS, OR ISOLATED SLABS. PROVIDE CONDUIT THRU-WALL SEALS WHERE CONDUITS CROSS BETWEEN INTERIOR AND EXTERIOR OR DAMP LOCATIONS. PROVIDE CONDUIT FIRE SEALS WHERE CONDUITS PASS THRU FIRE-RATED CONSTRUCTION.
- WIREWAYS SHALL BE SHEET METAL SIZED AND SHAPED AS INDICATED. INCLUDE COUPLING, OFFSETS, ELBOWS, EXPANSION JOINTS, ADAPTERS, HOLDOWN STRAPS, END CAPS AND OTHER FITTINGS TO MATCH AND MATE WITH WIRE WAYS AS REQUIRED FOR COMPLETE SYSTEM. MANUFACTURERS: HOFFMAN, SQUARE-D OR APPROVED EQUAL.
- HINGED COVER ENCLOSURES CONFORMING TO NEMA 250, TYPE 1, WITH CONTINUOUS HINGE COVER AND FLUSH LATCH, SIZED AS INDICATED. CABINETS TO CONFORM TO NEMA 250, TYPE 1, GALVANIZED STEEL BOX WITH REMOVABLE INTERIOR PANEL AND REMOVABLE FRONT, FINISHED INSIDE AND OUT WITH MANUFACTURER'S STANDARD ENAMEL. HINGED DOOR IN FRONT COVER WITH FLUSH LATCH AND CONCEALED HINGE. MANUFACTURERS: HOFFMAN, O-Z/GEDNEY, T&B OR APPROVED EQUAL.
- PROVIDE BOXES FOR ALL OUTLETS, DEVICES, CONNECTIONS, ETC. PROVIDE JUNCTION AND PULL BOXES AS REQUIRED. PROVIDE CAST METAL BOXES FOR SURFACE MOUNTED LOCATIONS AND STAMPED STEEL BOXES FOR INTERIOR DRY FLUSH-MOUNTED LOCATIONS. SHEET METAL BOXES SHALL CONFORM TO NEMA OS1. CAST-METAL BOXES SHALL CONFORM TO NEMA S1 AND SHALL BE SIZED IN ACCORDANCE WITH NEC UNLESS NOTED OTHERWISE.
- PULL BOXES USED FOR FIBER OPTIC CABLES SHALL BE SIZED IN ACCORDANCE WITH THE CABLE MANUFACTURER'S INSTRUCTIONS SUCH THAT PROPER BENDING RADI OF THE FIBER OPTIC CABLE ARE MAINTAINED.

F. WIRING DEVICES

- SWITCHES SHALL BE TOGGLE-TYPE, HORSEPOWER RATED, 120/277V, 20 AMP SPECIFICATION GRADE. DUPLEX RECEPTACLES SHALL BE RATED 20 AMPS, 125 VOLTS, NEMAS-20R, SPECIFICATION GRADE. MOUNTING HEIGHTS OF ALL WIRING DEVICES SHALL BE VERIFIED WITH THE OWNER PRIOR TO INSTALLATION.

G. PANELBOARDS

- PANELBOARDS SHALL CONFORM TO NEMA PB 1, NEMA 250 TYPE 1, UL 50 AND 67, AND THE NEC. PANELBOARDS SHALL BE OF THE TYPE AND RATINGS AS SHOWN ON DRAWINGS. SERIES RATED PANELBOARDS ARE NOT ACCEPTABLE.
- PANELBOARDS SHALL BE FACTORY ASSEMBLED WITH DOUBLE ROW CONSTRUCTION. PROVIDE FRONT COVER HINGED TO BOX ON ALL PANELBOARDS. PROVIDE TIN PLATED COPPER BUSSING, FULL-AMPACITY PHASE AND 100% AMPACITY NEUTRAL BUSES, 50% GROUND BUS.
- PROVIDE CIRCUIT NUMBERING AND TYPEWRITTEN PANELBOARD SCHEDULE FOR EACH PANELBOARD.
- ACCEPTABLE MANUFACTURERS: SQUARE D, GENERAL ELECTRIC, CUTLER-HAMMER.

H. SAFETY SWITCHES AND OVERCURRENT PROTECTION DEVICES

- ENCLOSED, NON-FUSIBLE AND FUSIBLE SAFETY (DISCONNECT) SWITCHES SHALL CONFORM TO NEMA KS1 TYPE HD, SIZED AS INDICATED ON DRAWINGS. ENCLOSURE TO BE RATED NEMA TYPE 3R FOR OUTDOOR USE, AND TYPE 1 FOR INDOOR USE UNLESS OTHERWISE NOTED. OPERATING MECHANISMS SHALL BE DESIGNED SO THAT THE SWITCHES MAY BE LOCATED IN THE OFF POSITION.
- ACCEPTABLE MANUFACTURERS: SQUARE D, GENERAL ELECTRIC, CUTLER HAMMER, SIEMENS.
- UNLESS NOTED OTHERWISE, PROVIDE CLASS J TIME DELAY FUSES FOR MAIN FEEDERS, CLASS RK1 TIME DELAY FUSES FOR MOTOR CIRCUITS, AND CLASS RK5 NON-TIME-DELAY FOR OTHER BRANCH CIRCUITS. INSTALL FUSES SO THAT THE LABELS SHOWING THEIR RATINGS CAN BE READ WITHOUT REQUIRING FUSE REMOVAL. PROVIDE SIX (6) SETS OF FUSES AND A FUSE CABINET FOR EACH LOCATION WHERE FUSES ARE INSTALLED.
- IN GENERAL, PROVIDE MOLDED CASE, BOLT-ON TYPE, AND THERMAL MAGNETIC TRIP CIRCUIT BREAKERS AS SHOWN AND AS REQUIRED FOR THIS PROJECT. MULTIPLE POLE BREAKERS SHALL BE SINGLE HANDLE, COMMON TRIP. PROVIDE HANDLE LOCKING DEVICES WHERE INDICATED. INTERRUPTING RATING AS INDICATED OR AS REQUIRED FOR AVAILABLE FAULT CURRENT.
- FOR NEW OVERCURRENT DEVICES IN EXISTING EQUIPMENT, DEVICE VOLTAGE AND INTERRUPTING RATINGS SHALL MATCH EXISTING DEVICE RATINGS UNLESS NOTED OTHERWISE. BUS BARS, DRAWOUT AND PLUG-IN ASSEMBLIES, CONNECTORS, ADAPTERS, LUGS, AND OTHER HARDWARE SHALL BE OF THE SAME TYPE AND MANUFACTURE AS EXISTING EQUIPMENT. WHERE A DEVICE IS OBSOLETE AND THE MANUFACTURER DOES NOT OFFER AN EQUIVALENT REPLACEMENT DEVICE, PROVIDE WRITTEN NOTICE TO THE ENGINEER.
- PROVIDE LABELS, CIRCUIT NUMBERING, AND UPDATED TYPEWRITTEN PANELBOARD SCHEDULES FOR ALL PANELS AFFECTED BY THIS WORK.

I. GROUNDING

- ALL SAFETY GROUNDING OF THE ELECTRICAL EQUIPMENT SHALL BE CARRIED OUT IN ACCORDANCE WITH NEC.
- GROUND LUGS ARE SPECIFIED UNDER "CONDUCTORS AND CONNECTORS".
- ALL GROUND LUG AND COMPRESSION CONNECTIONS SHALL BE COATED WITH ANTI-OXIDANT AGENT, SUCH AS NO-OX, NOALOX, PENETROX OR KOPRSHIELD.
- GROUND ALL EXPOSED METALLIC OBJECTS ON BUILDING EXTERIOR INCLUDING BUILDING TIE DOWN BRACKETS.
- PROVIDE LOCK WASHERS FOR ALL MECHANICAL CONNECTIONS FOR GROUND CONDUCTORS. USE STAINLESS STEEL HARDWARE THROUGHOUT.
- DO NOT INSTALL GROUND RODS AND CONDUCTORS OUTSIDE OF PROPERTY LINE.
- REMOVE ALL PAINT AND CLEAN ALL DIRT FROM SURFACES REQUIRING GROUND CONNECTIONS.
- MAKE ALL GROUND CONNECTIONS AS SHORT AND DIRECT AS POSSIBLE. AVOID SHARP BENDS. ALL BENDS TO BE A MINIMUM OF 8" RADIUS.
- REPAIR ALL GALVANIZED SURFACES THAT HAVE BEEN DAMAGED BY EXOTHERMIC-WELDING. USE ERICO T-319 GALVANIZING BAR.
- ALL GROUND CONNECTIONS TO BE APPROVED FOR THE METALS BEING CONNECTED.
- EXOTHERMIC WELDS TO BURIED GROUNDING SYSTEM SHALL BE PARALLEL TYPE, EXCEPT FOR BONDS TO GROUND RODS WHICH ARE TEE CONNECTIONS.
- FOR MECHANICAL CONNECTIONS TO HATCHPLATE GROUND BARS USE A TWO-HOLE NEMA DRILLED CONNECTOR SUCH AS T&B 32007 OR APPROVED EQUAL.

J. DATA AND TELEPHONE WIRING

- PROVIDE DATA OUTLETS WHERE SHOWN. EXACT TYPE OF DATA OUTLETS SHALL BE COORDINATED WITH THE OWNER. PROVIDE ALL ROUGH-IN AND EMPTY CONDUIT SYSTEM WHERE REQUIRED.
- PROVIDE TELEPHONE OUTLETS WHERE SHOWN. TELEPHONE OUTLETS SHALL BE BUILDING STANDARD WITH WHITE FACEPLATE. PROVIDE ALL TELEPHONE WIRING AND CONDUIT. TERMINATE TELEPHONE WIRING AT A DEMARCATION POINT DETERMINED BY THE OWNER.

K. LIGHTING

- PROVIDE ALL FLUORESCENT FIXTURES WITH T5 LAMPS, AND ELECTRONIC ENERGY SAVING BALLASTS.
- LIGHTING SWITCHES SHALL BE TOGGLE-TYPE, 277V 20 AMP SPECIFICATION GRADE WITH SINGLE AND THREE WAY AS SPECIFIED ON THE DRAWING.

L. IDENTIFICATION

- ALL EQUIPMENT SHALL BE IDENTIFIED USING NAMEPLATES AND LABELS.
- NAMEPLATES SHALL BE 1/8" THICK PLASTIC ENGRAVING SHEET, WHITE FACE, BLACK CORE, ENGRAVED WITH EQUIPMENT IDENTIFICATION AND ATTACHED TO EQUIPMENT WITH SELF-TAPPING SCREWS. CHEMICAL ADHESION PLATES ARE NOT ACCEPTABLE. LETTERS SHALL BE MINIMUM 1/4" HIGH.
- LABELS SHALL BE EMOSSUED PLASTIC WITH MINIMUM 1/4" HIGH LETTERS. LABELS SHALL BE USED FOR IDENTIFYING CONDUIT, CABLES, JUNCTION BOXES, RECEPTACLES ETC.
- WORDING ON NAMEPLATES AND LABELS MUST BE APPROVED BY THE ENGINEER PRIOR TO MANUFACTURING.

EACH GROUND CONDUCTOR TERMINATING ON ANY GROUND BAR INSIDE THE LEASE SPACE SHALL HAVE AN ENGRAVED TAG ATTACHED AT EACH END IDENTIFYING THE ORIGINATING AND TERMINATING POINT.

M. DRY TYPE TRANSFORMERS

DRY TYPE TRANSFORMERS SHALL BE FACTORY ASSEMBLED, FACTORY TESTED, ENCLOSED, SELF-COOLED, VENTILATED TYPE, DEAD-FRONT DRIP PROOF, COMPLYING WITH NEMA ST20, UL 1561, AND IEEE C57.12.91. CORES SHALL BE GRAIN ORIENTED, NON-AGING SILICON STEEL. COILS SHALL BE COPPER. CONTINUOUS WINDINGS WITHOUT SPLICES EXCEPT FOR TAPS. TAPS SHALL BE TWO AT 2.5% ABOVE AND TWO AT 2.5 % BELOW NORMAL FULL CAPACITY. PRIMARY AND SECONDARY TAPS SHALL BE ACCESSIBLE FROM THE FRONT. INSULATION CLASS SHALL BE 220 DEG. C, AND RATED TEMPERATURE RISE SHALL BE 115 DEG. C.

N. TESTING AND COMMISSIONING

- CONDUCT INSULATION RESISTANCE, RESISTANCE MEASUREMENTS THROUGH ALL NEW BOLTED CONNECTIONS, AND CONTINUITY TESTS OF ALL NEW FEEDERS TO INSURE CORRECT CABLE CONNECTION PER NETA ACCEPTANCE TESTING SPECIFICATIONS FOR ELECTRIC POWER DISTRIBUTION EQUIPMENT AND SYSTEMS STANDARDS. SUBMIT TEST REPORTS TO ENGINEER AND INCLUDE IN PROJECT CLOSE-OUT DOCUMENTATION PROVIDED TO OWNER.
- CARRY OUT TESTING AND COMMISSIONING OF ALL MAJOR ELECTRICAL EQUIPMENT SUCH AS SWITCHBOARDS, DISTRIBUTION BOARDS, GENERATOR, AUTOMATIC TRANSFER SWITCH, MOTOR STARTERS, ETC. ENGAGE THE SERVICES OF SUPPLIERS OF EQUIPMENT IN FACILITATING TESTING AND COMMISSIONING.
- TESTING AND COMMISSIONING OF GENERATOR SET, AUTOMATIC TRANSFER SWITCH, AND SOLID-STATE CIRCUIT BREAKERS SHALL BE CARRIED OUT IN THE PRESENCE OF THE ENGINEER. NOTIFY THE ENGINEER SEVEN WORKING DAYS IN ADVANCE OF THE TEST DATE.

O. FINAL SITE CLEAN UP


- UPON COMPLETION OF THE INSTALLATION, THE ELECTRICAL CONTRACTOR SHALL REVIEW AND CHECK THE ENTIRE INTALLATION, CLEAN EQUIPMENT AND DEVICES, AND REMOVE SURPLUS MATERIALS AND TRASH FROM THE OWNER'S PROPERTY, LEAVING THE WORK IN NEAT, CLEAN ORDER AND IN COMPLETE WORKING CONDITION.
- THE ELECTRICAL CONTRACTOR SHALL BE RESPONSIBLE FOR THE REMOVAL OF ANY CARTONS, DEBRIS, AND TRASH FOR EQUIPMENT INSTALLED BY THE ELECTRICAL CONTRACTOR, INCLUDING EQUIPMENT FURNISHED BY THE OWNER OR OTHERS AND REMOVED FROM PACKAGING BY THE ELECTRICAL CONTRACTOR.

22	REV SET	03-14-2022
02	REV SET	03-14-2022
03	REV SET	03-14-2022
04	REV SET	03-14-2022
Sheet Name:	
ELECTRICAL SPECIFICATION	
Proj #:	Issue Date:
211201	03-14-2022
Sheet No.:	
E2.1	
Drawn By:	Checked By:
RNP	BK

7 TEQUILAS RESTAURANT
5586 OLD HIGHWAY 5 (OLD GEORGIA HIGHWAY 5 AND PAYNE ROAD)
WOODSTOCK, GEORGIA 30188

CONSTRUCTION COORDINATION DRAWINGS
PREPARED FOR INNOVATIVE CONTRACTING SOLUTIONS
5605 GLENDRIDGE DR. NE
SUITE 345 ATLANTA, GEORGIA 30342

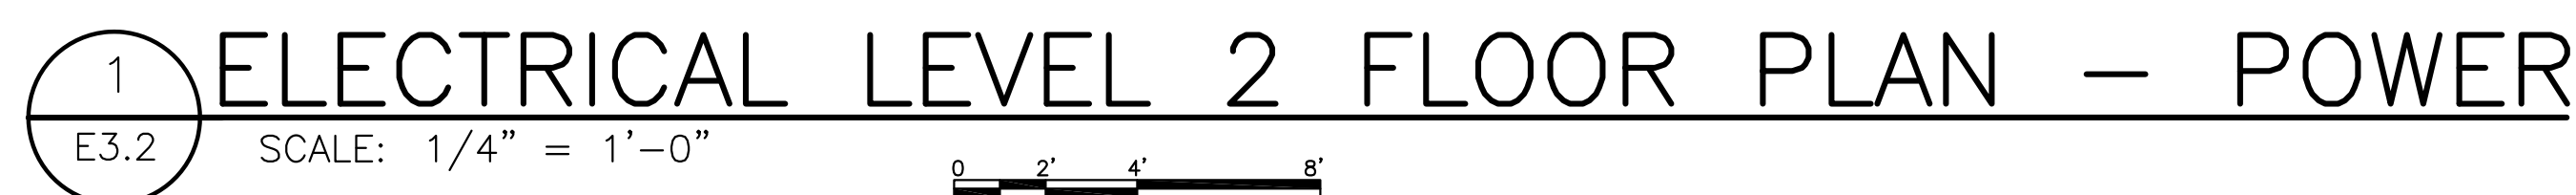

- A THE ELECTRICAL CONTRACTOR SHALL REFER TO THE CIVIL, ARCHITECTURAL, STRUCTURAL, MECHANICAL AND PLUMBING DRAWING FOR THE EXIST BUILDINGS AND ROOMS LAYOUTS. ALL DIMENSIONS, SECTIONS AND CONNECTIONS, VOLTAGE REQUIREMENTS AND PHYSICAL SIZE OF ALL EQUIPMENT FURNISHED BY OTHER TRADES, COORDINATE AND ADJUST ALL ELECTRICAL INSTALLATIONS ACCORDINGLY.
- B ELECTRICAL CONTRACTOR SHALL COORDINATE FULLY WITH OTHER CONTRACTORS ASSOCIATED WITH THIS PROJECT TO VERIFY ALL EQUIPMENT LOCATIONS, CONNECTION REQUIREMENTS, ELEVATIONS AND LOCATIONS OF PIPES, CONDUTES AND DUCTS TO PREVENT CONFLICTS DURING CONSTRUCTION. ANY REVISION OR REROUTING OF EQUIPMENT, PIPES, CONDUTES, DUCTS OR MATERIALS RESULTING FROM A LACK OF COORDINATION BETWEEN CONTRACTORS WILL BE AT THE CONTRACTORS EXPENSE.
- C ALL PENETRATIONS THRU FIRE RATED WALLS AND CEILINGS SHALL BE SEALED IN ACCORDANCE WITH THE NATIONAL ELECTRICAL CODE ARTICLE 300-21.
- D TELEPHONE/COMPUTER OUTLET MOUNT DOUBLE GANG 3/4" CONDUIT WITH SINGLE PLASTER RING 18" ABOVE FINISHED FLOOR (UNLESS NOTED OTHERWISE, STUB-UP 3/4" CONDUIT TO ABOVE NEAREST ACCESSIBLE CEILING SPACE.
- E INSTALL A FULL SIZE NEUTRAL FOR EACH CIRCUIT, GROUP, HOME RUN CIRCUITS PER NEC 310, TABLE 310.15 (b) (2) a
- F BRANCH CIRCUIT CONDUCTORS SHALL BE #12 AWG CU. UNLESS OTHERWISE SHOWN, BRANCH CIRCUITS HOMERUN CONDUCTORS SHALL BE #10 AWG CU. WHEN LENGTH EXCEEDS 80 FT.
- G ALL OUTLETS AND DEVICE LOCATIONS AND MOUNTING HEIGHTS SHALL BE VERIFIED WITH THE OWNER AND ARCHITECT PRIOR TO ROUGH-IN. COORDINATE THE INSTALLATIONS WITH EQUIPMENT AND SYSTEMS SUPPLIERS AND OTHER TRADES.
- H ELECTRICAL OUTLET BOXES LOCATED ON OPPOSITE SIDES OF FIRE RATED WALLS SHALL BE SEPARATED BY HORIZONTAL DISTANCE OF 24" MINIMUM.
- I ELECTRICAL CONTRACTOR TO COORDINATE THE PHYSICAL LOCATION AND ELECTRICAL REQUIREMENT FOR ALL HVAC EQUIPMENT WITH MECHANICAL CONTRACTOR AND/OR OWNER. VERIFY THE MINIMUM CIRCUIT AMPERE RATING AND MAXIMUM OVER CURRENT PROTECTION DEVICE RATING OF THE ACTUAL UNIT BEING INSTALLED. ADJUST THE CIRCUIT ACCORDINGLY.
- J ELECTRICAL CONTRACTOR TO COORDINATE WITH ALL THE EQUIPMENT MANUFACTURER POWER REQUIREMENTS PRIOR TO INSTALL.

- ① JUNCTION BOX FOR SIGN. VERIFY AND COORDINATE THE LOCATION IN THE FIELD PRIOR TO ROUGH-IN.
- ② PROVIDE POWER TO WALL MOUNTED DUPLEX RECEPTACLE FOR COMPUTERS. PROVIDE EMPTY J-BOX AND CONDUIT WITH PULLS FOR DATA BY OTHERS. CONFIRM MOUNTING HEIGHTS AND LOCATIONS IN FIELD WITH OWNER. RECEPTACLE MUST BE GFI, FULLY WEATHERIZED, WITH COVERS.
- ③ RECEPTACLE MUST BE GFI, FULLY WEATHERIZED, WITH COVERS.

02	BID SET	03-14-2022
03	G.C. SHOP DWG. COORD. 2	03-14-2022
No.	Description	Date:

Sheet Name:	
ELECTRICAL LEVEL 1 FLOOR PLAN - POWER	
Proj #:	Issue Date:
211201	03-14-2022
Sheet No.:	
E3.2	
Drawn By:	Checked By:
RNP	BK

- C. THE ELECTRICAL CONTRACTOR SHALL REFER TO THE CIVIL, ARCHITECTURAL, STRUCTURAL, MECHANICAL AND PLUMBING DRAWING FOR THE EXIST BUILDINGS AND ROOMS LAYOUTS. ALL DIMENSIONS, SECTIONS AND CONNECTIONS, VOLTAGE REQUIREMENTS AND PHYSICAL SIZE OF ALL EQUIPMENT FURNISHED BY OTHER TRADES, COORDINATE AND ADJUST ALL ELECTRICAL INSTALLATIONS ACCORDINGLY.
- B. ELECTRICAL CONTRACTOR SHALL COORDINATE FULLY WITH OTHER CONTRACTORS ASSOCIATED WITH THIS PROJECT TO VERIFY ALL EQUIPMENT LOCATIONS, CONNECTION REQUIREMENTS, ELEVATIONS AND LOCATIONS OF PIPES, CONDUITS AND DUCTS TO PREVENT CONFLICTS DURING CONSTRUCTION. ANY REDUCTION OR REDROUTING OF EQUIPMENT, PIPES, CONDUITS, DUCTS OR MATERIALS RESULTING FROM A LACK OF COORDINATION BETWEEN CONTRACTORS WILL BE AT THE CONTRACTORS EXPENSE.
- C. ALL PENETRATIONS THRU FIRE RATED WALLS AND CEILINGS SHALL BE SEALED IN ACCORDANCE WITH THE NATIONAL ELECTRICAL CODE 300-21.
- D. TELEPHONE/COMPUTER OUTLET MOUNT DOUBLE GANG BOX WITH SINGLE PLEASTER RING 18" ABOVE FINISHED FLOOR (UNLESS NOTED OTHERWISE, STUB-UP 3/4" CONDUIT TO ABOVE NEAREST ACCESSIBLE CEILING SPACE).
- E. INSTALL A FULL SIZE NEUTRAL FOR EACH CIRCUIT, GROUP, HOME RUN CIRCUITS PER NEC 310, TABLE 310.15 (D) (2) (a)
- F. ALL BRANCH CIRCUIT CONDUCTORS SHALL BE #12 AWG CU, UNLESS OTHERWISE SHOWN. BRANCH CIRCUITS HOMERUN CONDUCTORS SHALL BE #10 AWG CU, WHEN LENGTH EXCEEDS 80 FT.
- G. ALL OUTLETS AND DEVICE LOCATIONS AND MOUNTING HEIGHTS SHALL BE VERIFIED WITH THE OWNER AND ARCHITECT PRIOR TO ROUGH IN. COORDINATE THE INSTALLATIONS WITH EQUIPMENT AND SYSTEMS SUPPLIERS AND OTHER TRADES.
- H. ELECTRICAL OUTLET BOXES LOCATED ON OPPOSITE SIDES OF FIRE RATED WALLS SHALL BE SEPARATED BY HORIZONTAL DISTANCE OF 24" MINIMUM.
- I. ELECTRICAL CONTRACTOR TO COORDINATE THE PHYSICAL LOCATION AND ELECTRICAL REQUIREMENT FOR ALL HVAC EQUIPMENT WITH MECHANICAL CONTRACTOR AND/OR OWNER. VERIFY THE MINIMUM CIRCUIT AMPERAGE RATING AND MAXIMUM OVER CURRENT PROTECTION DEVICE RATING OF THE ACTUAL UNIT BEING INSTALLED AND ADJUST THE FEEDER CIRCUIT ACCORDINGLY.
- J. ELECTRICAL CONTRACTOR TO COORDINATE WITH ALL THE EQUIPMENT MANUFACTURER POWER REQUIREMENTS PRIOR TO INSTALL.

1 SUPPLY AND INSTALL FUSIBLE DISCONNECT SWITCH. REFER TO MECHANICAL EQUIPMENT MANUFACTURER SHOP DRAWING FOR EXACT DISCONNECT SIZE, VOLTAGE, PHASE AND TYPE. ADJUST DISCONNECT SIZE AND TYPE ACCORDINGLY. DISCONNECT SHALL BE FUSED AS PER MANUFACTURER REQUIREMENTS.



7 TEQUILAS RESTAURANT
5586 OLD HIGHWAY 5 (OLD GEORGIA HIGHWAY 5 AND PAYNE ROAD)
WOODSTOCK, GEORGIA 30188

CONSTRUCTION COORDINATION DRAWINGS
PREPARED FOR INNOVATIVE CONTRACTING SOLUTIONS
5605 GLENDRIDGE DR. NE
SUITE 345 ATLANTA, GEORGIA 30342

[illegible]


Sheet Name:	
ELECTRICAL ROOF PLAN - POWER	
Proj #:	Issue Date:
211201	03-14-2022
Sheet No.:	
E3.3	
Drawn By:	Checked By:
RNP	BK

KEY NOTES:

- 1 ALL EXHAUST FAN IN REST ROOM SHALL BE INTERLOCK WITH LIGHTING SWITCH. PROVIDE MOTOR RATED SWITCH.
- 2 ROUTE EXTERIOR LIGHTS THRU LIGHTING CONTACTOR. CONTROL VIA TIME CLOCK AND PHOTO ELECTRICAL CELL.
- 3 CONNECT LIGHTS IN 2ND LEVEL.
- 4 COORDINATE WITH OWNER FOR SWITCHING LOCATION AND REQUIREMENTS.
- 5 OWNER SELECTED LIGHTS. 60W MAX.
- 6 J-BOX FOR LARGE PENDANT LIGHTS. VERIFY CIRCUIT CAPACITY PRIOR TO INSTALLED.

LIGHTING GENERAL NOTES:


- A THE ELECTRICAL CONTRACTOR SHALL REFER TO CIVIL, ARCHITECTURAL, STRUCTURAL, MECHANICAL AND PLUMBING DRAWING FOR THE EXACT BUILDING AND ROOM LAYOUTS. ALL DIMENSIONS, SECTIONS, DETAILS, AND ELEVATIONS. LIGHTING AND VOLTAGE REQUIREMENTS AND PHYSICAL SIZE OF ALL EQUIPMENT FURNISHED BY OTHER TRADES. COORDINATE AND ADJUST ELECTRICAL INSTALLATION ACCORDINGLY.
- B REFER TO DRAWING E1.0 FOR LIGHTING FIXTURE SCHEDULE.
- C UPPER CASE ALPHA CHARACTER INSIDE/ADJACENT TO LIGHT FIXTURE INDICATES LUMINAIRE TYPE.
- D CONNECT ALL EMERGENCY BALLAST AND EXIT LIGHTS TO UNSWITCHED "HOT-LEG" OF RESPECTIVE LIGHTING CIRCUIT.
- E FIXTURES SHOWN WITH DESIGNATION 'NL' ARE TO BE USED AS NIGHT LIGHT. CONNECT TO UNSWITCHED "HOT-LEG" OF RESPECTIVE LIGHTING CIRCUIT.
- F ALL PENETRATION THRU FIRE RATED WALL AND CEILING SHALL BE SEALED IN ACCORDANCE WITH NATIONAL ELECTRICAL CODE ARTICLE 300-21.
- G INSTALL A FULL SIZE NEUTRAL FOR EACH CIRCUIT GROUP.
- H HOMERUN CONDUCTOR SHALL BE #10 AWG CU. WHEN LENGTH EXCEEDS 80 FT.
- I COORDINATE WITH OWNER FOR APPROVAL OF LIGHTING FIXTURE PRIOR TO INSTALL.
- J REFER TO ARCHITECTURAL ELEVATION DRAWINGS FOR EXTERIOR LIGHTS MOUNTING HEIGHT AND LOCATION.

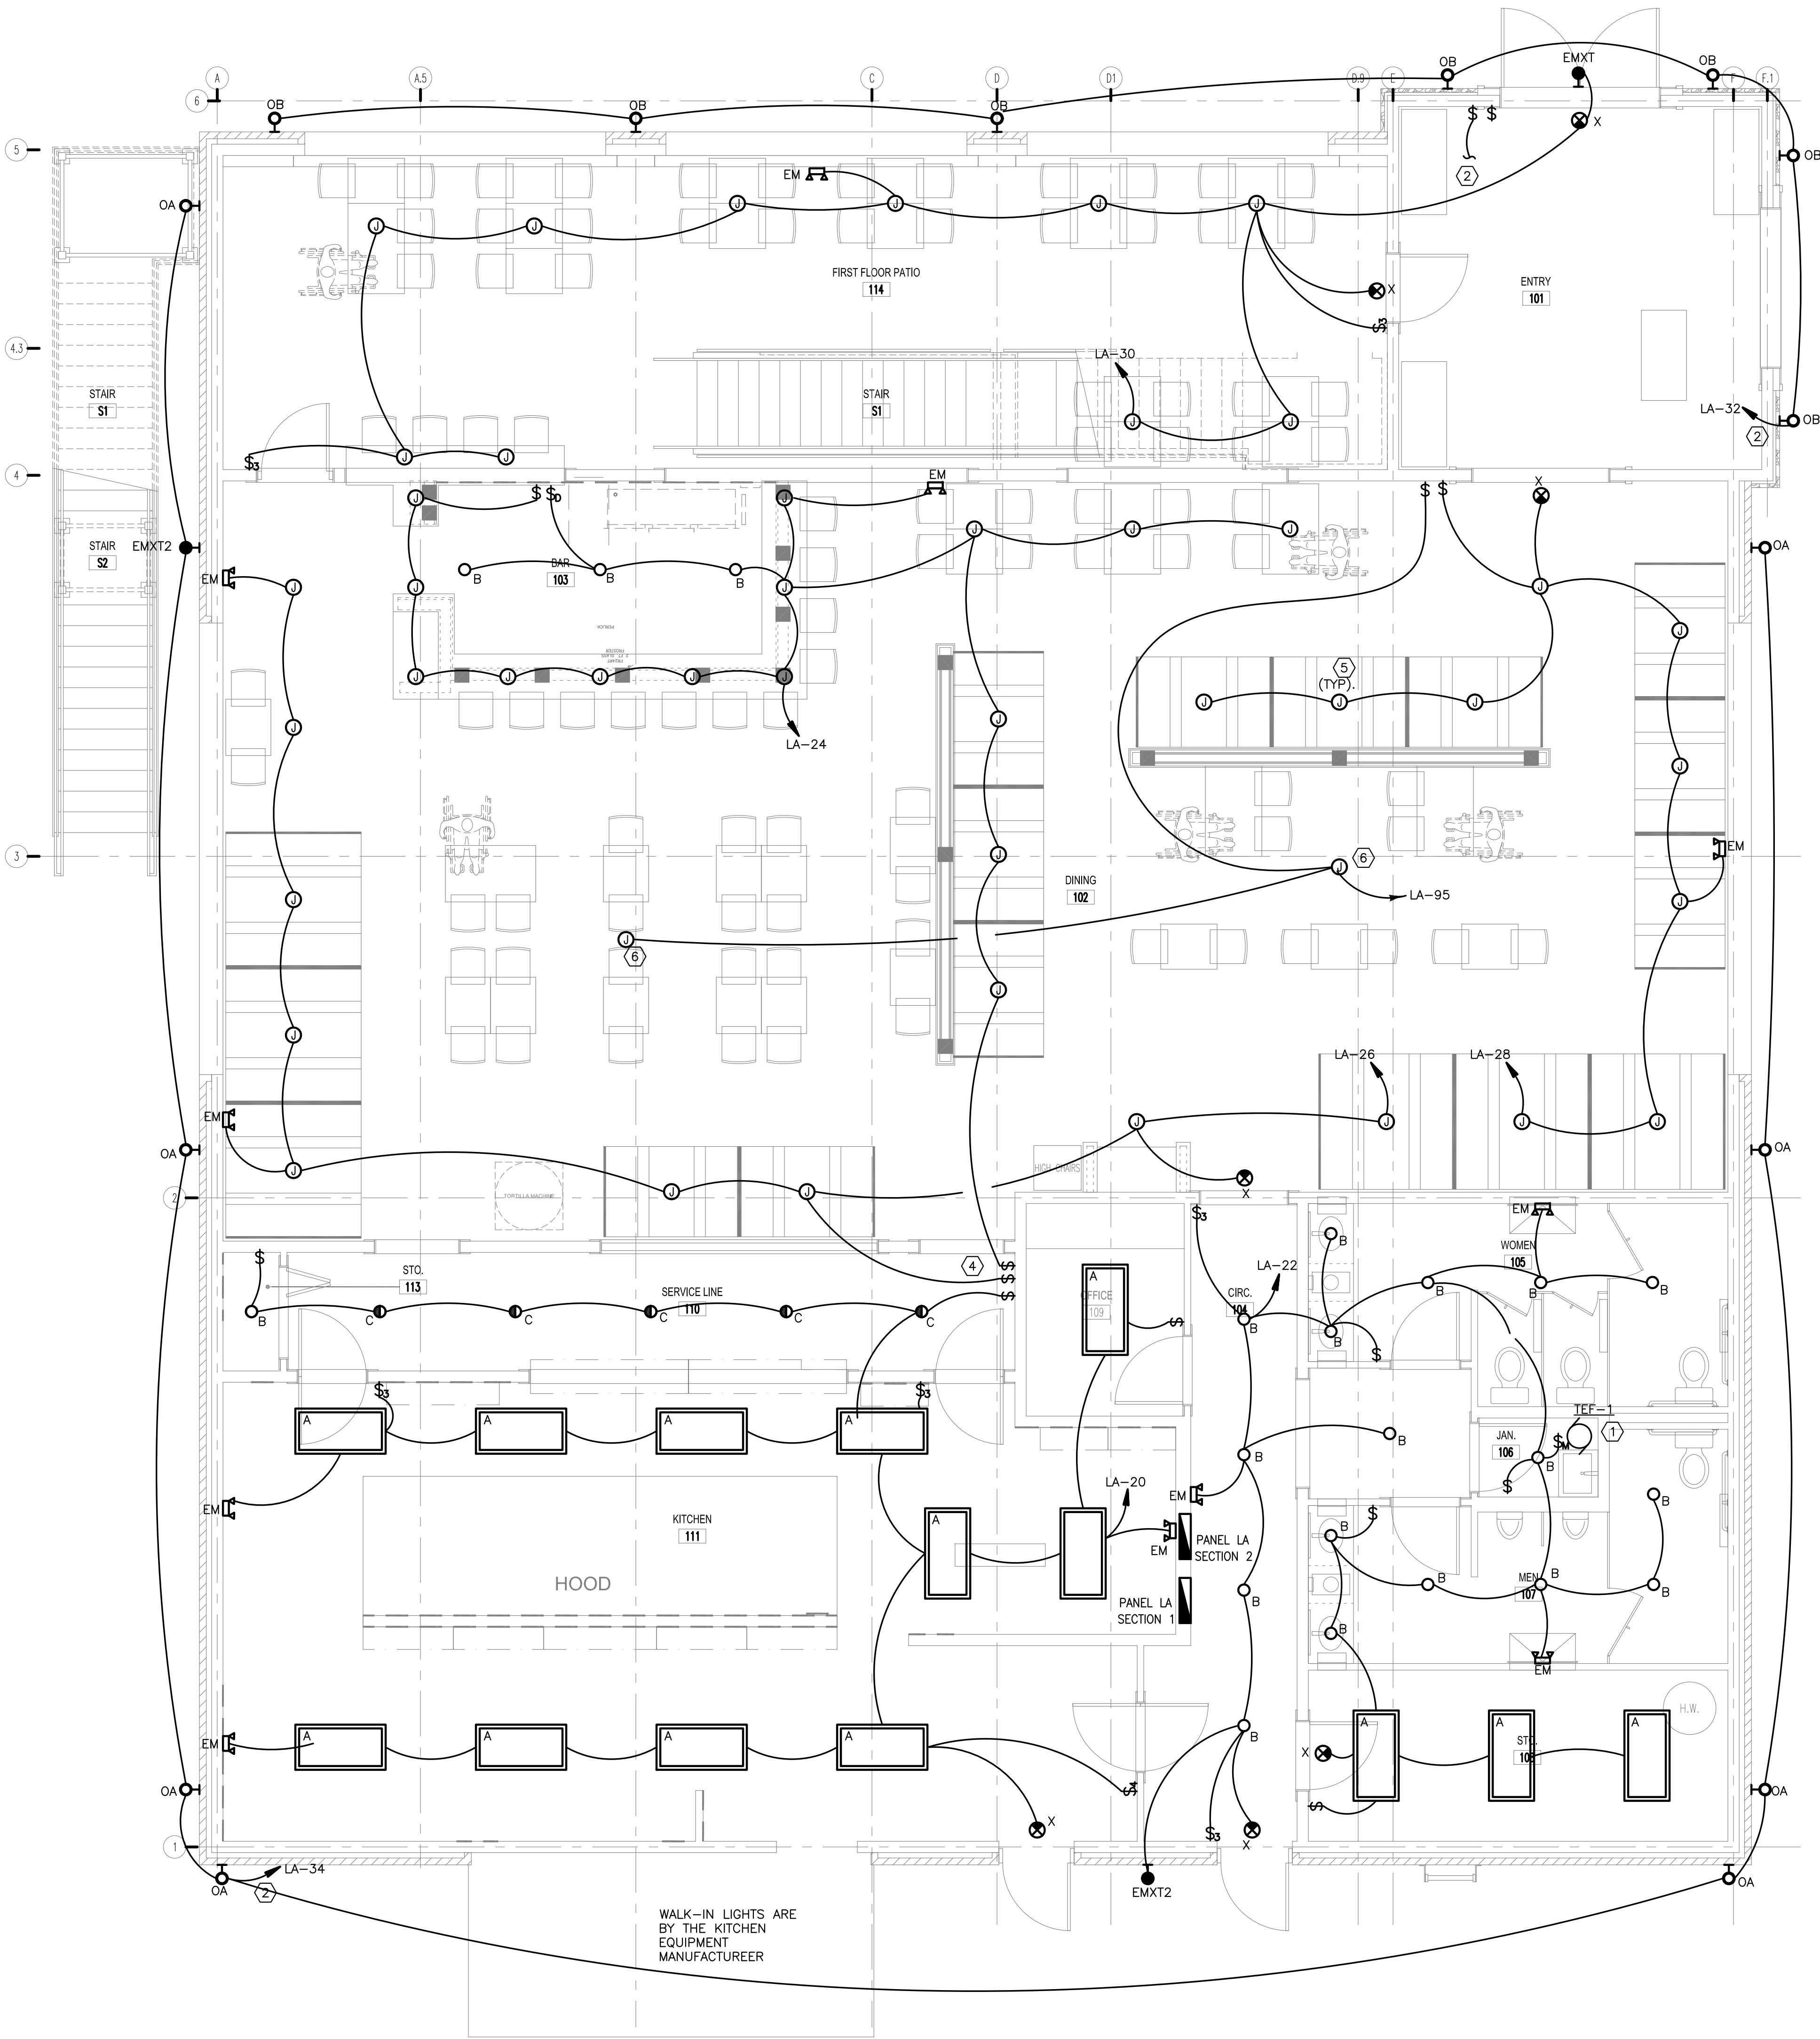

1 ELECTRICAL LEVEL 1 FLOOR PLAN - LIGHTING
E4.1 SCALE: 1/4" = 1'-0" 0 2' 4' 8'

22	REVISED	03-14-2022
21	REVISED	03-14-2022
20	REVISED	03-14-2022
Sheet Name:	
ELECTRICAL LEVEL 1 FLOOR PLAN - LIGHTING	
Proj #:	Issue Date:
211201	03-14-2022
Sheet No.:	
E4.1	
Drawn By:	Checked By:
RNP	BK

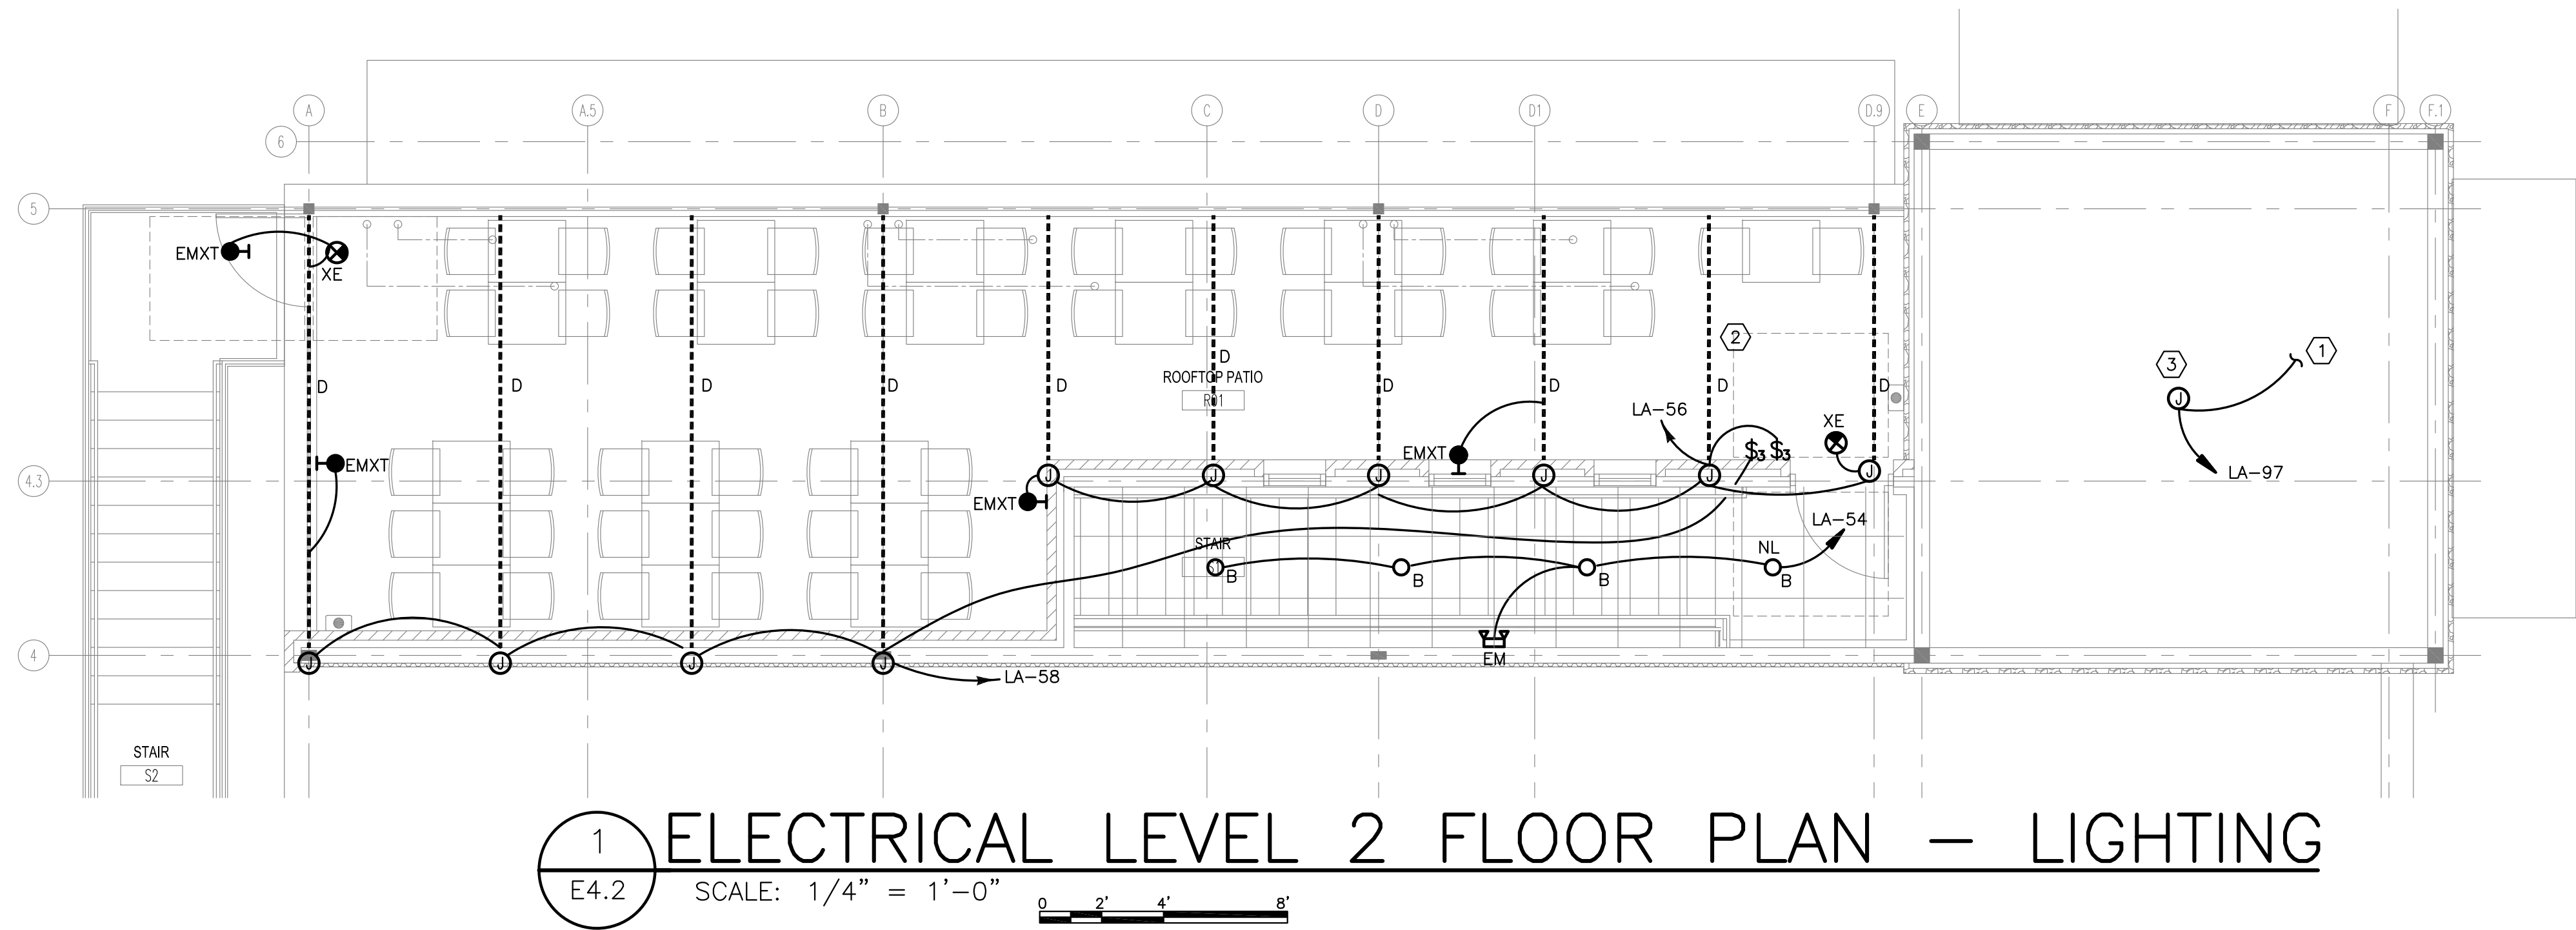

KEY NOTES:	LIGHTING GENERAL NOTES:
<div>1 CONNECT SWITCH TO LIGHTS IN FIRST LEVEL.</div> <div>2 COORDINATE OWNER FOR LED STRING LIGHTS.</div> <div>3 J-BOX FOR LARGE PENDANT LIGHTS. VERIFY CIRCUIT CAPACITY PRIOR TO INSTALLED.</div>	<div>A THE ELECTRICAL CONTRACTOR SHALL REFER TO CIVIL, ARCHITECTURAL, STRUCTURAL, MECHANICAL AND PLUMBING DRAWING FOR THE EXACT BUILDING AND ROOM LAYOUTS, ALL DIMENSIONS, SECTIONS, DETAILS, AND ELEVATIONS. LIGHTING AND VOLTAGE REQUIREMENTS AND PHYSICAL SIZE OF ALL EQUIPMENT FURNISHED BY OTHER TRADES. COORDINATE AND ADJUST ELECTRICAL INSTALLATION ACCORDINGLY.</div> <div>B REFER TO DRAWING E1.0 FOR LIGHTING FIXTURE SCHEDULE.</div> <div>C UPPER CASE ALPHA CHARACTER INSIDE/ADJACENT TO LIGHT FIXTURE INDICATES LUMINAIRE TYPE.</div> <div>D CONNECT ALL EMERGENCY BALLAST AND EXIT LIGHTS TO UNSWITCHED "HOT-LEG" OF RESPECTIVE LIGHTING CIRCUIT.</div> <div>E FIXTURES SHOWN WITH DESIGNATION 'NL' ARE TO BE USED AS NIGHT LIGHT. CONNECT TO UNSWITCHED "HOT-LEG" OF RESPECTIVE LIGHTING CIRCUIT.</div> <div>F ALL PENETRATION THRU FIRE RATED WALL AND CEILING SHALL BE SEALED IN ACCORDANCE WITH NATIONAL ELECTRICAL CODE ARTICLE 300-21.</div> <div>F INSTALL A FULL SIZE NEUTRAL FOR EACH CIRCUIT GROUP.</div> <div>G HOMERUN CONDUCTOR SHALL BE #10 AWG CU. WHEN LENGTH EXCEEDS 80 FT.</div> <div>H COORDINATE WITH OWNER FOR APPROVAL OF LIGHTING FIXTURE PRIOR TO INSTALL.</div> <div>I REFER TO ARCHITECTURAL ELEVATION DRAWINGS FOR EXTERIOR LIGHTS MOUNTING HEIGHT AND LOCATION.</div>

Innovative Contracting Solutions

ICS

COPYRIGHT 2022/2022

7 TEQUILAS RESTAURANT
5586 OLD HIGHWAY 5 (OLD GEORGIA HIGHWAY 5 AND PAYNE ROAD)
WOODSTOCK, GEORGIA 30188

CONSTRUCTION COORDINATION DRAWINGS
PREPARED FOR INNOVATIVE CONTRACTING SOLUTIONS
5605 GLENBRIDGE DR. NE
SUITE 345 ATLANTA, GEORGIA 30342

02 000 SEE
03 000 SEE
04 000 SEE
Sheet Name:
ELECTRICAL LEVEL 1
FLOOR PLAN - LIGHTING

Proj #: 211201
Issue Date: 02-14-2022

Sheet No.:
E4.2

Drawn By: RNP
Checked By: BK




SPECIAL FEEDER NOTES:

- ALL THE MAIN FEEDERS ARE ALUMINUM.
- ALL THE BRACH CIRCUITS ARE COOPER.



1. NEW UTILITY TRANSFORMER PAD MOUNTED. COORDINATE WITH UTILITY COMPANY FOR LOCATION, PAD REQUIREMENTS, PRIMARY FEEDER CONDUIT, SERVICE TAP, AND ADDITIONAL REQUIREMENTS.
2. UTILITY CT SECTION AND METER. CONTRACTOR TO FIELD COORDINATE FOR MOUNTING LOCATION. COORDINATE WITH UTILITY COMPANY FOR METERING REQUIREMENTS.
3. PROVIDE (2) 5/8" x 10"-OD LONG COOPER CLAD GROUND ROD SPACED 10 FEET CENTER. BOND WITH 3/0 COPPER CONDUCTOR WITH EXOTHERMIC WELD.
4. PROVIDE SERVICE ENTRANCE RATED DISCONNECT SWITCH WITH RFI FUSES. PROVIDE ONE SETS OF SPARE FUSE TO THE OWNER.
5. EXPLANT AND INSTALL NEW UNDERGROUND SERVICE LATERAL. FIELD SURVEY AND COORDINATE CONDUIT ROUTING. SUPPLY AND INSTALL FEEDER 24" BRS DIRECT BURIED AND UPON COMPLETION OF RIG AND RMC UNDERGROUND. CONTRACTOR TO ARRANGE AND PAY FOR UNDERGROUND UTILITY LOCATION SURVEYS FOR ALL TRENCING. INSTALL 6" WIDE METALLIC LINED RED PLASTIC MARKER TAPE 8" ABOVE ALL BURIED CONDUIT.
6. SUPPLY AND INSTALLED LIGHTING CONTRACTOR. LIGHTING CONTRACTOR TO BE CONTROLLED BY TIME CLOCK AND PHOTOCELL. FIELD COORDINATE FOR PHOTOCELL LOCATION.

PLUMBING SYMBOLS AND ABBREVIATIONS:

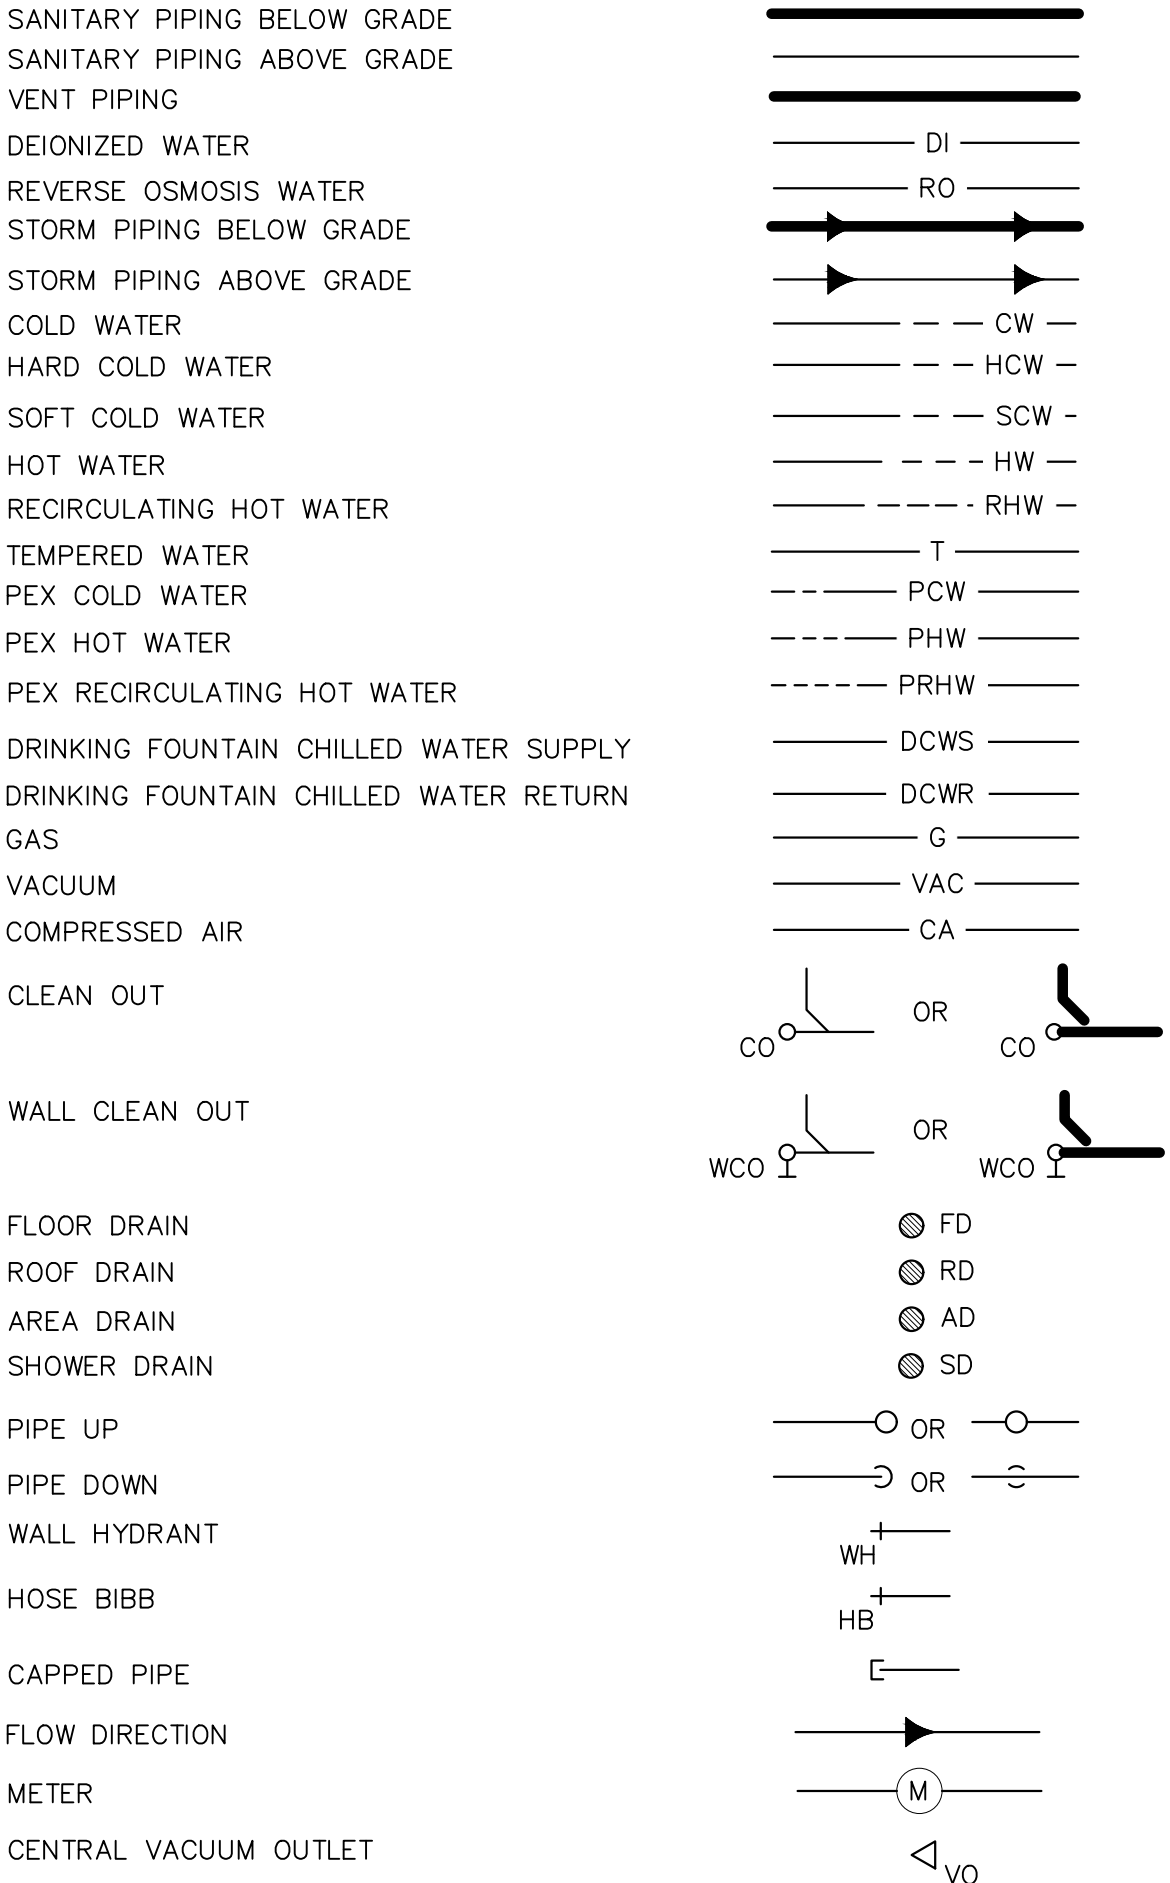

PLUMBING DRAWING INDEX		
SHEET NUMBER	SHEET NAME	
P0.1	PLUMBING NOTES AND SCHEDULES	1
P1.1A	FLOOR PLAN – PLUMBING – WASTE	1
P1.1B	FLOOR PLAN – PLUMBING – WATER	1
P1.1C	FLOOR PLAN – PLUMBING – GAS	1
P1.2	ROOF PLAN – PLUMBING	1
P2.1	PLUMBING RISERS	1
P3.1	PLUMBING DETAILS	1
P3.2	PLUMBING DETAILS	1
TOTAL PLUMBING SHEETS		8

GAS TANKLESS WATER HEATER SCHEDULE							
EQUIP. NO.	MIN. STOR. CAP. (GAL.)	MIN. REC. (GPH)	DISC. TEMP. (°F)	FLOW RATE (GPM)	GAS INPUT (MBH)	BASIS OF DESIGN	REMARKS
GWH-1	—	—	120	10	199	AO SMITH – ACT-1991-N	

GAS WATER HEATER SCHEDULE							
EQUIP. NO.	MIN. STOR. CAP. (GAL.)	MIN. REC. (GPH)	DISC. TEMP. (°F)	FLOW RATE (GPM)	GAS INPUT (MBH)	BASIS OF DESIGN	REMARKS
GWH-2	30	55	110	12	32	AO SMITH – G6-S3032NVR	

ELECTRIC TANKLESS WATER HEATER SCHEDULE							
EQUIP. NO.	MIN. STOR. CAP. (GAL.)	MIN. REC. (GPH)	DISC. TEMP. (°F)	FLOW RATE (GPM)	TOTAL KW	BASIS OF DESIGN	REMARKS
EWH-1	—	—	120	3	13.3	EEMAX – HAO18240	

PLUMBING PIPING SCHEDULE			
SERVICE	MATERIAL	JOINTS	FITTINGS
SANITARY SEWER PIPES AND VENTS	CAST IRON	LEAD AND OAKUM	NO HUB
DOMESTIC HOT & COLD WATER INTERIOR	TYPE "L" HARD DRAWN COPPER	SOLDER 95/5	WROUGHT COPPER
DOMESTIC COLD WATER EXTERIOR	TYPE "K" HARD DRAWN COPPER	SOLDER 95/5	WROUGHT COPPER
CONDENSATE DRAIN	SCHEDULE 40 PVC	PVC SOLVENT	PVC SOLVENT
DOMESTIC WATER BENEATH FLOOR	TYPE "M" SOFT DRAWN COPPER	SOLDER 95/5	WROUGHT COPPER

- FOR SANITARY SEWER PIPES AND VENTS: PVC MAY BE USED IF APPROVED BY LOCAL AUTHORITIES.
- FOR DOMESTIC WATER PIPING: PVC MAY BE USED IF APPROVED BY LOCAL AUTHORITIES.
- PVC MAY NOT BE USED IN RETURN AIR PLENUMS.
- PEX PIPING IS NOT ACCEPTABLE.

MATERIAL SPECIFICATIONS:

- ALL DOMESTIC WATER PIPING SHALL BE TYPE "L" HARD COPPER TUBING WITH WROUGHT COPPER FITTINGS. ALL HW AND CW PIPING SHALL BE INSULATED.
- BELOW GRADE SANITARY SHALL BE HUB-AND-SPIGOT CAST IRON PIPING, NEOPRENE RUBBER GASKETS AND COMPRESSION JOINTS. ABOVE GRADE SANITARY AND VENT PIPING SHALL BE HUBLESS CAST IRON PIPE, NEOPRENE GASKETS AND STAINLESS STEEL CLAMP-AND-SHED ASSEMBLES JOINTS.
- INSULATION SHALL BE FLEXIBLE UNICELLULAR-SELF-SEAL ARMAFLEX 2000 1/2" THICK FOR HOT WATER PIPING UP TO 2" SIZE – PROVIDE SHEET METAL SADDLES AT EACH HANGER.

THERMAL INSULATION:

- INSULATE ALL DOMESTIC COLD AND HOT WATER PIPING WITH PREFORMED FIBERGLASS INSULATION WITH ALL SERVICE JACKET. INSULATE ALL PIPE AND FITTINGS. SEAL ALL LONGITUDINAL AND BUTT JOINTS WITH MINIMUM 1" OVERLAP OF JACKET OR TAPE GLUED IN PLACE. JACKET MUST BE CONTINUOUS OVER ALL ENDS TO MAKE A UNIFORM VAPOR BARRIER.
- INSULATION AND PIPE COVERING SHALL HAVE A PERMANENT COMPOSITE FIRE AND SMOKE HAZARD RATING NOT EXCEEDING A FLAME SPREAD OF 25 AND SMOKE DEVELOPED OF 50.
- INSULATE ALL HORIZONTAL RAIN LEADERS AND ROOF DRAIN BODIES WITH 1-1/2" THICK, 1 LB./SQ. FT. DENSITY BLANKET TYPE FIBERGLASS WITH VAPOR BARRIER JACKET. WIRE INSULATION IN PLACE AND SEAL ALL LAPS AND JOINTS.
- INSULATED PIPING LOCATED IN MECHANICAL ROOMS AND IN OTHER AREAS SUBJECT TO DAMAGE SHALL BE PROVIDED WITH A 10 MIL PVC JACKET.
- FIRE PROOF ALL WALL PENETRATIONS IN FIRE RATED WALLS.

HANGERS AND SUPPORTS:

CLEVIS TYPE HANGERS EQUAL TO GRINNELL FIGURE 260 WITH THREADED ROD AND ADJUSTABLE INSERTS EQUAL TO GRINNELL FIGURE 282. (GALVANIZED)

IDENTIFICATION

PROVIDE SNAP ON PIPE MARKERS WITH WHITE LETTERING FOR THE FOLLOWING SERVICES:

SERVICE	ABBREVIATION	BAND COLOR
POTABLE COLD WATER	CW	BLUE
POTABLE HOT WATER	HW	YELLOW
SANITARY DRAIN	SD	GREEN

LOCATE ON EACH SIDE WHERE PASSING THROUGH WALLS AND FLOORS AND EVERY TWENTY FEET ALONG HORIZONTAL RUN.

PLUMBING GENERAL NOTES:

- THESE DRAWINGS ARE SCHEMATIC IN NATURE AND ARE NOT INTENDED TO SHOW ALL POSSIBLE CONDITIONS. IT IS INTENDED THAT A COMPLETE PLUMBING AND FIRE PROTECTION SYSTEM BE PROVIDED WITH ALL NECESSARY EQUIPMENT, APPURTENANCES AND CONTROLS COMPLETELY COORDINATED WITH ALL DISCIPLINES. ALL PARAMETERS GIVEN IN THESE DOCUMENTS SHALL BE STRICTLY CONFORMED TO. ANY ITEMS AND LABOR REQUIRED FOR A COMPLETE PLUMBING SYSTEM IN ACCORDANCE WITH ALL APPLICABLE CODES, STANDARDS, LOCAL AUTHORITIES AND THESE CONTRACT DOCUMENTS SHALL BE FURNISHED WITHOUT INCURRING ANY ADDITIONAL COST TO THE OWNER. CAREFULLY REVIEW ALL CONTRACT DOCUMENTS AND THE DESIGN OF OTHER TRADES BEFORE PREPARING SHOP DRAWINGS.
- ALL WORK SHALL BE DONE IN ACCORDANCE WITH THE 2018 INTERNATIONAL CODE WITH GEORGIA AMENDMENTS.
- REVIEW PLANS OF ALL TRADES PRIOR TO BIDDING AND INSTALLATION TO INCLUDE ALL PLUMBING FOR COMPLETE SYSTEMS SHOWN ON THE PLANS AND AS REQUIRED.
- COORDINATE WITH OTHER TRADES TO PREVENT INTERFERENCE WITH HVAC DUCTS, STRUCTURE, ELECTRICAL LIGHTING, AND OTHER PIPING IN THE CEILING SPACE. VENT PIPING AND WATER PIPING SHALL BE HELD EITHER ABOVE OR BELOW HVAC DUCTWORK AS COORDINATED WITH THE HVAC CONTRACTOR.
- PROVIDE 12"x12" ACCESS PANELS FOR SHOCK ABSORBERS, TRAP PRIMERS AND ALL VALVES LOCATED ABOVE NON ACCESSIBLE CEILINGS AND INSIDE PIPE CHASES. EXACT LOCATION MUST BE COORDINATED WITH ARCHITECTURAL DRAWINGS AND APPROVED BY ARCHITECT PRIOR TO INSTALLATION. ALL ACCESS PANELS SHALL BE LOCATED SO THAT THEY ARE NOT VISIBLE TO PUBLIC VIEW. ALL VALVES AND ACCESSORIES SHALL BE LOCATED WITHIN 12" OF ACCESS THROUGH EITHER WALLS OR CEILING.
- ALL DRAINAGE PIPING AND POTABLE WATER PIPING SHALL BE CONCEALED INSIDE WALLS AND PIPE CHASES OR ABOVE CEILINGS. HOLD ALL PIPING ABOVE CEILING AS HIGH AS POSSIBLE.
- ALL DRAINAGE PIPING, POTABLE, AND SANITARY WATER PIPING SHALL SLOPE AT 1/8" INCH PER FOOT UNLESS OTHERWISE NOTED.
- CONTRACTOR SHALL MAKE FINAL CONNECTION TO ALL DOMESTIC WATER, SANITARY SEWERS, STORM DRAINS AND NATURAL GAS SERVICE AT APPROXIMATELY 5'-0" FROM BUILDING STRUCTURE UNLESS OTHERWISE NOTED.
- COORDINATE ALL UNDERGROUND PIPING WITH GRADE BEAMS, WALL FOOTINGS, COLUMN FOUNDATIONS AND OTHER STRUCTURAL CONDITIONS.
- REFER TO ARCHITECTURAL PLANS AND ELEVATIONS FOR LOCATION OF ALL PLUMBING FIXTURES. EXACT LOCATION OF ALL PLUMBING FIXTURES MUST BE VERIFIED IN FIELD PRIOR TO INSTALLATION, FINAL LOCATION SHALL BE AS DIRECTED BY ARCHITECT.
- FLOORS WHERE INDICATED ON ARCHITECTURAL AND/OR STRUCTURAL DRAWINGS SHALL SLOPE TO FLOOR DRAINS. MAXIMUM SLOPE IN ANY DIRECTION SHALL NOT EXCEED 1/8" INCH PER FOOT. EXACT LOCATION OF ALL FLOOR DRAINS AND HUB DRAINS FOR EQUIPMENT MUST BE VERIFIED IN FIELD PRIOR TO INSTALLATION. FINAL LOCATION SHALL BE AS DIRECTED BY ARCHITECT.
- PLUMBING CONTRACTOR SHALL MAKE FINAL CONNECTION TO ALL EQUIPMENT INDICATED ON DRAWINGS. FINAL CONNECTION SHALL INCLUDE ANY ADAPTERS, NIPPLES, SHUTOFF VALVES, PRESSURE REGULATING VALVES, SHOCK ABSORBERS, BACKFLOW PREVENTION DEVICES, AND ALL OTHER ACCESSORIES.
- ALL CHANGES SHALL BE APPROVED BY THE ARCHITECT AND/OR OWNER.
- COORDINATE WITH ARCHITECTURAL DRAWINGS BEFORE ROUGHING-IN PLUMBING FIXTURES AND EQUIPMENT SUPPLIES.
- THE PLUMBING SUBCONTRACTOR SHALL FURNISH AND INSTALL ALL PLUMBING FIXTURES, AS IDENTIFIED ON PLUMBING FIXTURE SCHEDULE.
- VERIFY MOUNTING HEIGHT AND WATER CONNECTION SIZES TO ALL PLUMBING FIXTURES PRIOR TO ROUGH-IN. FURNISH CUT-OUT TEMPLATES, FOR PLUMBING FIXTURES TO BE INSTALLED IN MILLWORK, BY THE GENERAL CONTRACTOR.
- VERIFY LOCATION OF EXISTING WATER SERVICE AND THE LOCATION/INVERTS OF SANITARY PIPING PRIOR TO INSTALLATION.
- INSTALL WATER HAMMER ARRESTERS WHERE WATER PRESSURES ARE EXCESSIVE OR WHERE REQUIRED TO ELIMINATE WATER HAMMER OR WHEN DEEMED NECESSARY BY LOCAL AUTHORITIES. LOCATE AND SIZE AS RECOMMENDED BY THE AMERICAN SOCIETY OF PLUMBING ENGINEERS.
- PIPING ABOVE SUSPENDED CEILINGS SHALL BE HELD AS HIGH AS POSSIBLE IN THE AVAILABLE SPACE AND IN ALL CASES SHALL BE ABOVE THE TOP OF THE LIGHT FIXTURES. THIS PIPING NORMALLY RUNS BELOW THE DUCTWORK.
- ALL PIPING SHALL RUN CONCEALED ABOVE CEILING OR IN WALL CHASES UNLESS OTHERWISE INDICATED. EXPOSED PIPING SHALL BE 3/4" MINIMUM FROM ANY WALL SURFACE.
- PROVIDE STOP VALVES AT ALL FIXTURES AND EQUIPMENT SUPPLIES. ALL EXPOSED FIXTURE CONNECTIONS SHALL BE CHROME PLATED. PROVIDE VACUUM BREAKERS WHERE REQUIRED BY CODE.
- IT IS IN THE INTENT OF THESE DRAWINGS TO COVER ALL WORK AND MATERIAL FOR A FIRST CLASS INSTALLATION. ANY EQUIPMENT, PLUMBING FIXTURE, TRIM HARDWARE AND/OR DEVICES USUALLY UTILIZED IN THE CLASS OF WORK, THOUGH NOT SPECIFICALLY MENTIONED OR SHOWN ON THESE DRAWINGS, BUT WHICH MAY BE NECESSARY FOR THE SATISFACTORY COMPLETION OF THE WORK (AS DETERMINED BY THE ARCHITECT) SHALL BE FURNISHED AND INSTALLED BY THE CONTRACTOR AS PART OF HIS TOTAL WORK.
- ALL STRUCTURAL PENETRATIONS (SLEEVES, BLOCKOUTS, AND ANCHORS) ARE TO BE LOCATED AND COORDINATED IN THE FIELD BY THE CONTRACTOR IN RELATION TO THE REQUIREMENTS OF FINAL EQUIPMENT AND FIXTURES SELECTED.
- PROVIDE AN EXPANSION JOINT OR FABRICATED EXPANSION LOOP ON ALL PIPING SYSTEMS THAT CROSS BUILDING EXPANSION JOINTS.

PLUMBING FIXTURE SCHEDULE

FIXTURE NO.	FIXTURE DESCRIPTION	MANUFACTURER AND CAT. NO.	FLUSH VALVE	TOILET SEAT	FAUCET MODEL AND CAT. NO.	PIPING CONNECTIONS-INCHES				REMARKS	NOTES
						SD	VENT	C.W.	H.W.		
P1A	WATERCLOSET – ADA	KOHLER # K-3493-TR	----	KOHLER # K-4650	----	4"	2"	1"	----	WATER CLOSET – COMBINATION BOWL AND TANK, FLOOR MOUNTED, FLOOR OUTLET, ELONGATED FRONT, WHITE VITREOUS CHINA, GRAVITY FLUSH, 1.60 GALLONS PER FLUSH – MOUNTED FOR ADA 18" WITH SEAT. (12" ROUGH-IN)	
P1B	WATERCLOSET	KOHLER # K-4325-L	----	KOHLER # K-4650	----	4"	2"	1"	----	WATER CLOSET – COMBINATION BOWL AND TANK, FLOOR MOUNTED, FLOOR OUTLET, ELONGATED FRONT, WHITE VITREOUS CHINA, GRAVITY FLUSH, 1.60 GALLONS PER FLUSH – (12" ROUGH-IN)	
P2	URNAL	KOHLER # K-5016-ET	AMERICAN STANDARD 6045.051.002	----	----	2"	2"	3/4"	----	WALL HUNG, VITREOUS CHINA, WASHOUT FLUSH OUTLET, 3/4" TOP SPUD, 0.5 GPF, MANUAL FLUSH VALVE,	
P3	LAVATORY UNDER COUNTER MOUNT – ADA	KOHLER # KATHRYN K-2330	----	----	PURIST # K-1440-6-4-CP	1 1/4"	1 1/4"	1/2"	1/2"	17" X 13" BOWL, ADA, UNDERMOUNT, VITREOUS CHINA LAVATORY, AC POWERED FAUCET, 0.5 GPM PRESSURE COMPENSATING, VANDAL RESISTANT NON AERATED SPRAY 1 1/4" P TRAP AND DRAIN ASSEMBLY. INSTALL INSULATION ON TRAP AND SUPPLIES OF ADA FIXTURES.	
P4	MOP SINK	TABCO # 9-QP-20	----	----	REGENCY #609M566	3"	2"	3/4"	3/4"	SERVICE SINK, STAINLESS STEEL, SINGLE COMPARTMENT CORNER UNIT, 25"x20"x10" DEEP FLOOR MOUNTED WITH WALL MOUNTED FAUCET FOR MOP SINK WITH BUCKET HOOK AND HOSE CONNECTION.	
P5	DROP IN SINK	SERV-WARE DIS-101014-CMP	----	----	----	1 1/2"	1 1/2"	1/2"	1/2"	SEAMLESS TYPE 304 16 GAUGE STAINLESS STEEL, SINGLE COMPARTMENT, SIDE SPLASH GUARDS, SINK COMPARTMENT.	3
P6	ONE COMPARTMENT SINK	TRIMARK KES101824S-218	----	----	----	1 1/2"	1 1/2"	1/2"	1/2"	SEAMLESS TYPE 304 16 GAUGE STAINLESS STEEL, SINGLE COMPARTMENT, SIDE SPLASH GUARDS, SINK COMPARTMENT.	3
P7	MOP SINK	ADVANCE TABCO 9-QP-480F	----	----	----	1 1/2"	1 1/2"	1/2"	1/2"	SEAMLESS TYPE 304 16 GAUGE STAINLESS STEEL, SINGLE COMPARTMENT, SIDE SPLASH GUARDS, SINK COMPARTMENT.	3
P8	HAND SINK	KINTERA KHS9	----	----	----	1 1/2"	1 1/2"	1/2"	1/2"	SEAMLESS TYPE 304 16 GAUGE STAINLESS STEEL, SINGLE COMPARTMENT, SIDE SPLASH GUARDS, SINK COMPARTMENT.	3
P9	TRIPLE COMPARTMENT SINK	ADVANCE TABCO FC-3-2424-24R	----	----	KOHLER # K-15172-F-CP	1 1/2"	1 1/2"	1/2"	1/2"	SEAMLESS TYPE 304 18 GAUGE STAINLESS STEEL THREE COMPARTMENT COUNTERTOP SINK 33"x22"x8" DEEP WITH FOUR HOLE PUNCH 4" ON CENTER AND CENTER DRAIN. SINGLE LEVER DECK MOUNTED FAUCET WITH SPRAY HOSE.	3
P10	EXTERIOR WALL HYDRANT	ZURN # Z-1335	----	----	----	---	---	3/4"	----	NON-FREEZE CONCEALED VANDAL RESISTANT HOSE BIB WITH STAINLESS STEEL BOX AND LOCKING DOOR AND INTEGRAL VACUUM BREAKER. (18" AFF)	
P11	EXTERIOR WALL HYDRANT	ZURN # Z-1348-BFP	----	----	----	---	---	1/2"	1/2"	EXPOSED NON-FREEZE ANTI-SIPHON DUAL HOT/COLD WALL FAUCET COMPLETE WITH AUTOMATIC DRAINING HOSE CONNECTION BACK FLOW PREVENTER, EXTERIOR CHROME FINISH, BRASS CASING, ALL BRONZE INTERIOR PARTS, OPERATING ROD WITH SPRING-LOADED COMPRESSION CLOSURE VALVE, REPLACEABLE SEAT WASHER, 3/4" MALE HOSE CONNECTION.	
FD	FLOOR DRAIN	ZURN # Z-415	----	----	----	3"	---	---	---	FLOOR DRAIN CAST IRON BODY BOTTOM OUTLET MEDIUM DUTY 6" MINIMUM DIAMETER POLISHED NICKEL BRONZE TYPE "B" STRAINER.	
FS	FLOOR SINK	ZURN # FD2370	----	----	----	3"	---	---	---	PVC BODY, BOTTOM OUTLET, DOME STRAINER, 14" X 14" 1/2" OPEN GRATE.	
HD	HUB DRAIN	ZURN # Z-211-S-P	----	----	----	3"	---	---	---	CAST IRON BODY, BOTTOM OUTLET, MEDIUM DUTY 6" MINIMUM DIAMETER POLISHED NICKEL BRONZE TYPE "B" STRAINER.	

- NOTES:
- COORDINATE WITH ARCHITECTURAL PLANS.
 - FIXTURES SHALL BE AS SCHEDULED OR APPROVED EQUAL.
 - ITEM IS PROVIDED BY KITCHEN EQUIPMENT VENDOR AND IS SHOWN FOR REFERENCE ONLY. COORDINATE ALL FINAL UTILITIES AND EQUIPMENT WITH KITCHEN EQUIPMENT VENDOR.

ISSUED FOR CONSTRUCTION

Beach Engineering Solutions Team
Mechanical, Electrical & Plumbing Engineering

(678) 665-3280
Project Number: 19-249

Sheet Name: **PLUMBING NOTES, & LEGENDS**

Proj #: 211201
Issue Date: 03-14-2022

Sheet No. **P0.1**


Drawn By: DMB
Checked By: BGB

7 TEQUILAS RESTAURANT
5586 OLD HIGHWAY 5 (OLD GEORGIA HIGHWAY 5 AND PAYNE ROAD)
WOODSTOCK, GEORGIA 30188

CONSTRUCTION COORDINATION DRAWINGS
PREPARED FOR INNOVATIVE CONTRACTING SOLUTIONS
5605 GLENDBRIDGE DR. NE
SUITE 345 ATLANTA, GEORGIA 30342



No.	Description	Date
02	BID SET	03-14-2022
03	C.C. SHOP DRAWING COORD. 2	03-14-2022

 

CONSTRUCTION COORDINATION DRAWINGS
PREPARED FOR INNOVATIVE CONTRACTING SOLUTIONS
5605 GLENDRIE DR. NE
SUITE 345 ATLANTA, GEORGIA 30342

[illegible]

Sheet Name: LEVEL 1 FLOOR PLAN - PLUMBING - WASTE	
Proj #: 121201	Issue Date: 03-14-2022
Sheet No.: P1.1A	
Drawn By: DMB	Checked By: RGB


No.	Description	Date
02	BID SET	03-14-2022
03	C.C. SHOP DWG. COORD. 2	03-14-2022

LEVEL 1 FLOOR PLAN - PLUMBING - WATER	
Proj #:	211201
Issue Date:	03-14-2022
Sheet No.:	
Drawn By:	DMB
Checked By:	BGB

ISSUED FOR CONSTRUCTION

Beach Engineering Solutions Team
Mechanical, Electrical & Plumbing
Engineering

(678) 665-3280
Project Number: 19-249

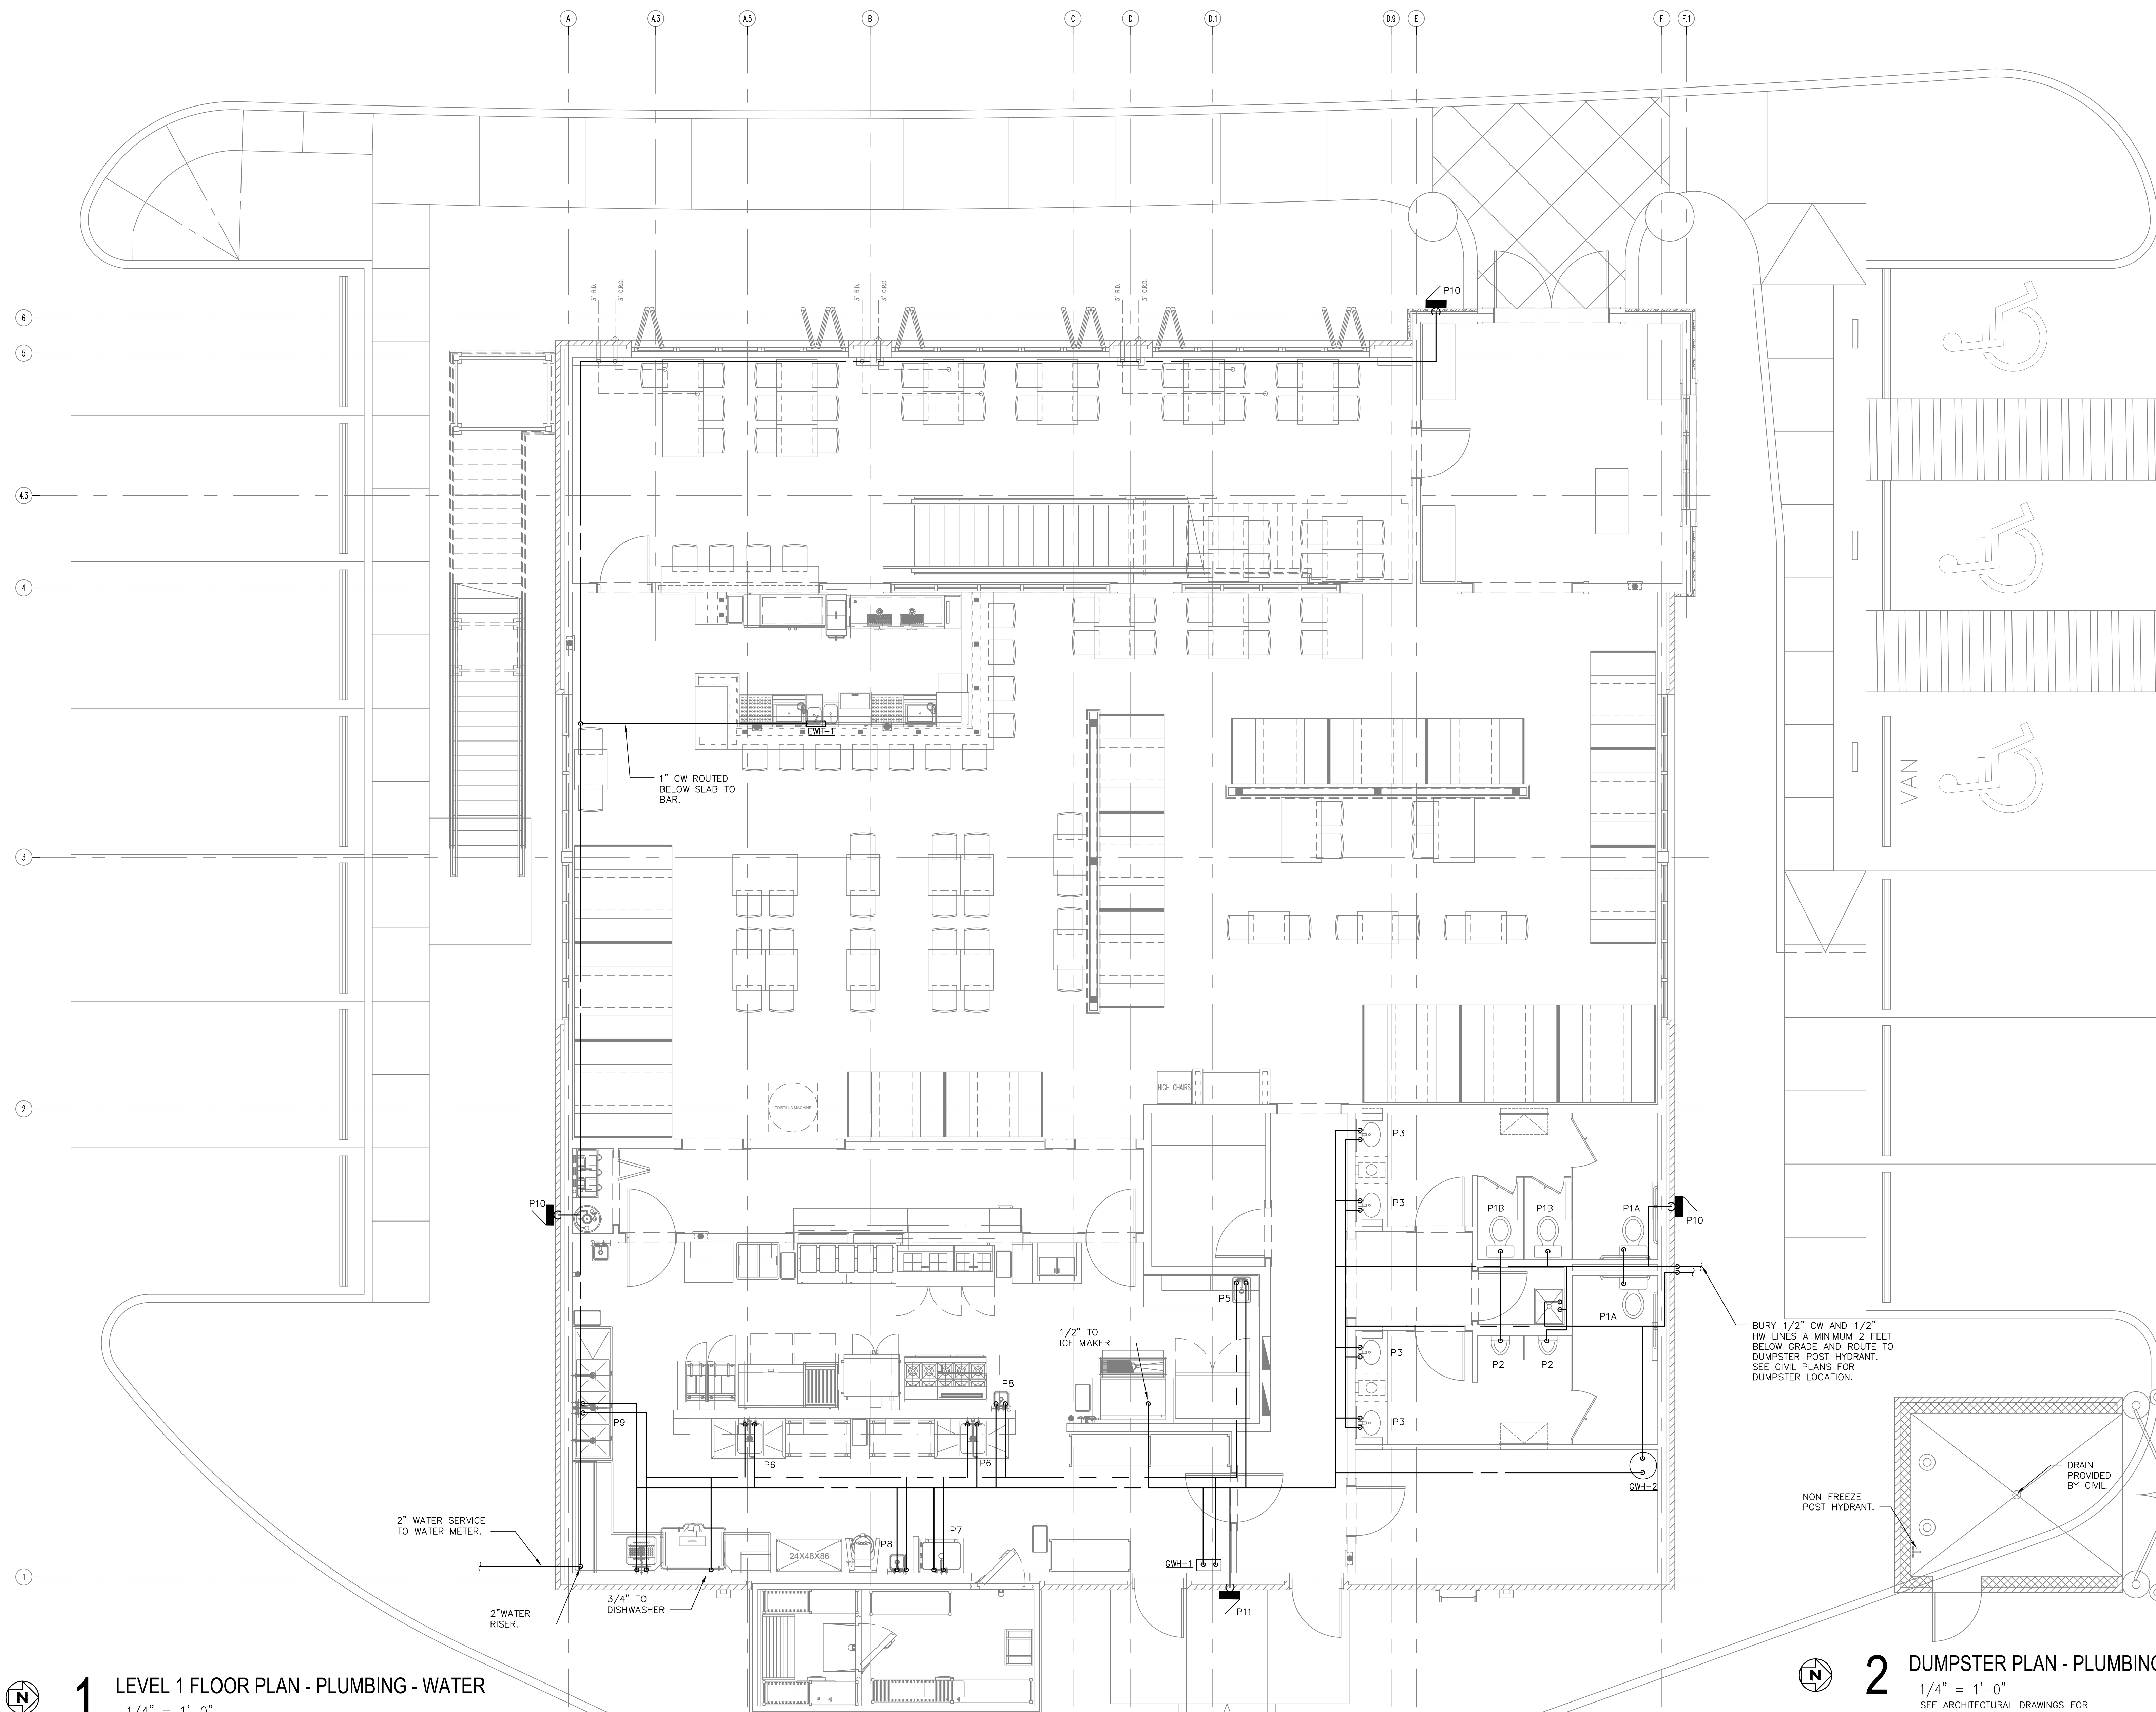


1 LEVEL 1 FLOOR PLAN - PLUMBING - WATER
1/4" = 1'-0"

2 DUMPSTER PLAN - PLUMBING - WATER
1/4" = 1'-0"
SEE ARCHITECTURAL DRAWINGS FOR
DUMPSTER ENCLOSURE DETAILS. SEE
CIVIL DRAWINGS FOR DUMPSTER
ENCLOSURE LOCATION.

No.	Description	Date
02	BID SET	03-14-2022
03	G.C. SHOP DRAW COORD. 2	03-14-2022

LEVEL 1 FLOOR PLAN - PLUMBING - GAS	
Proj #:	211201
Issue Date:	03-14-2022
Sheet No.:	P1.1C
Drawn By:	DMB
Checked By:	BGB

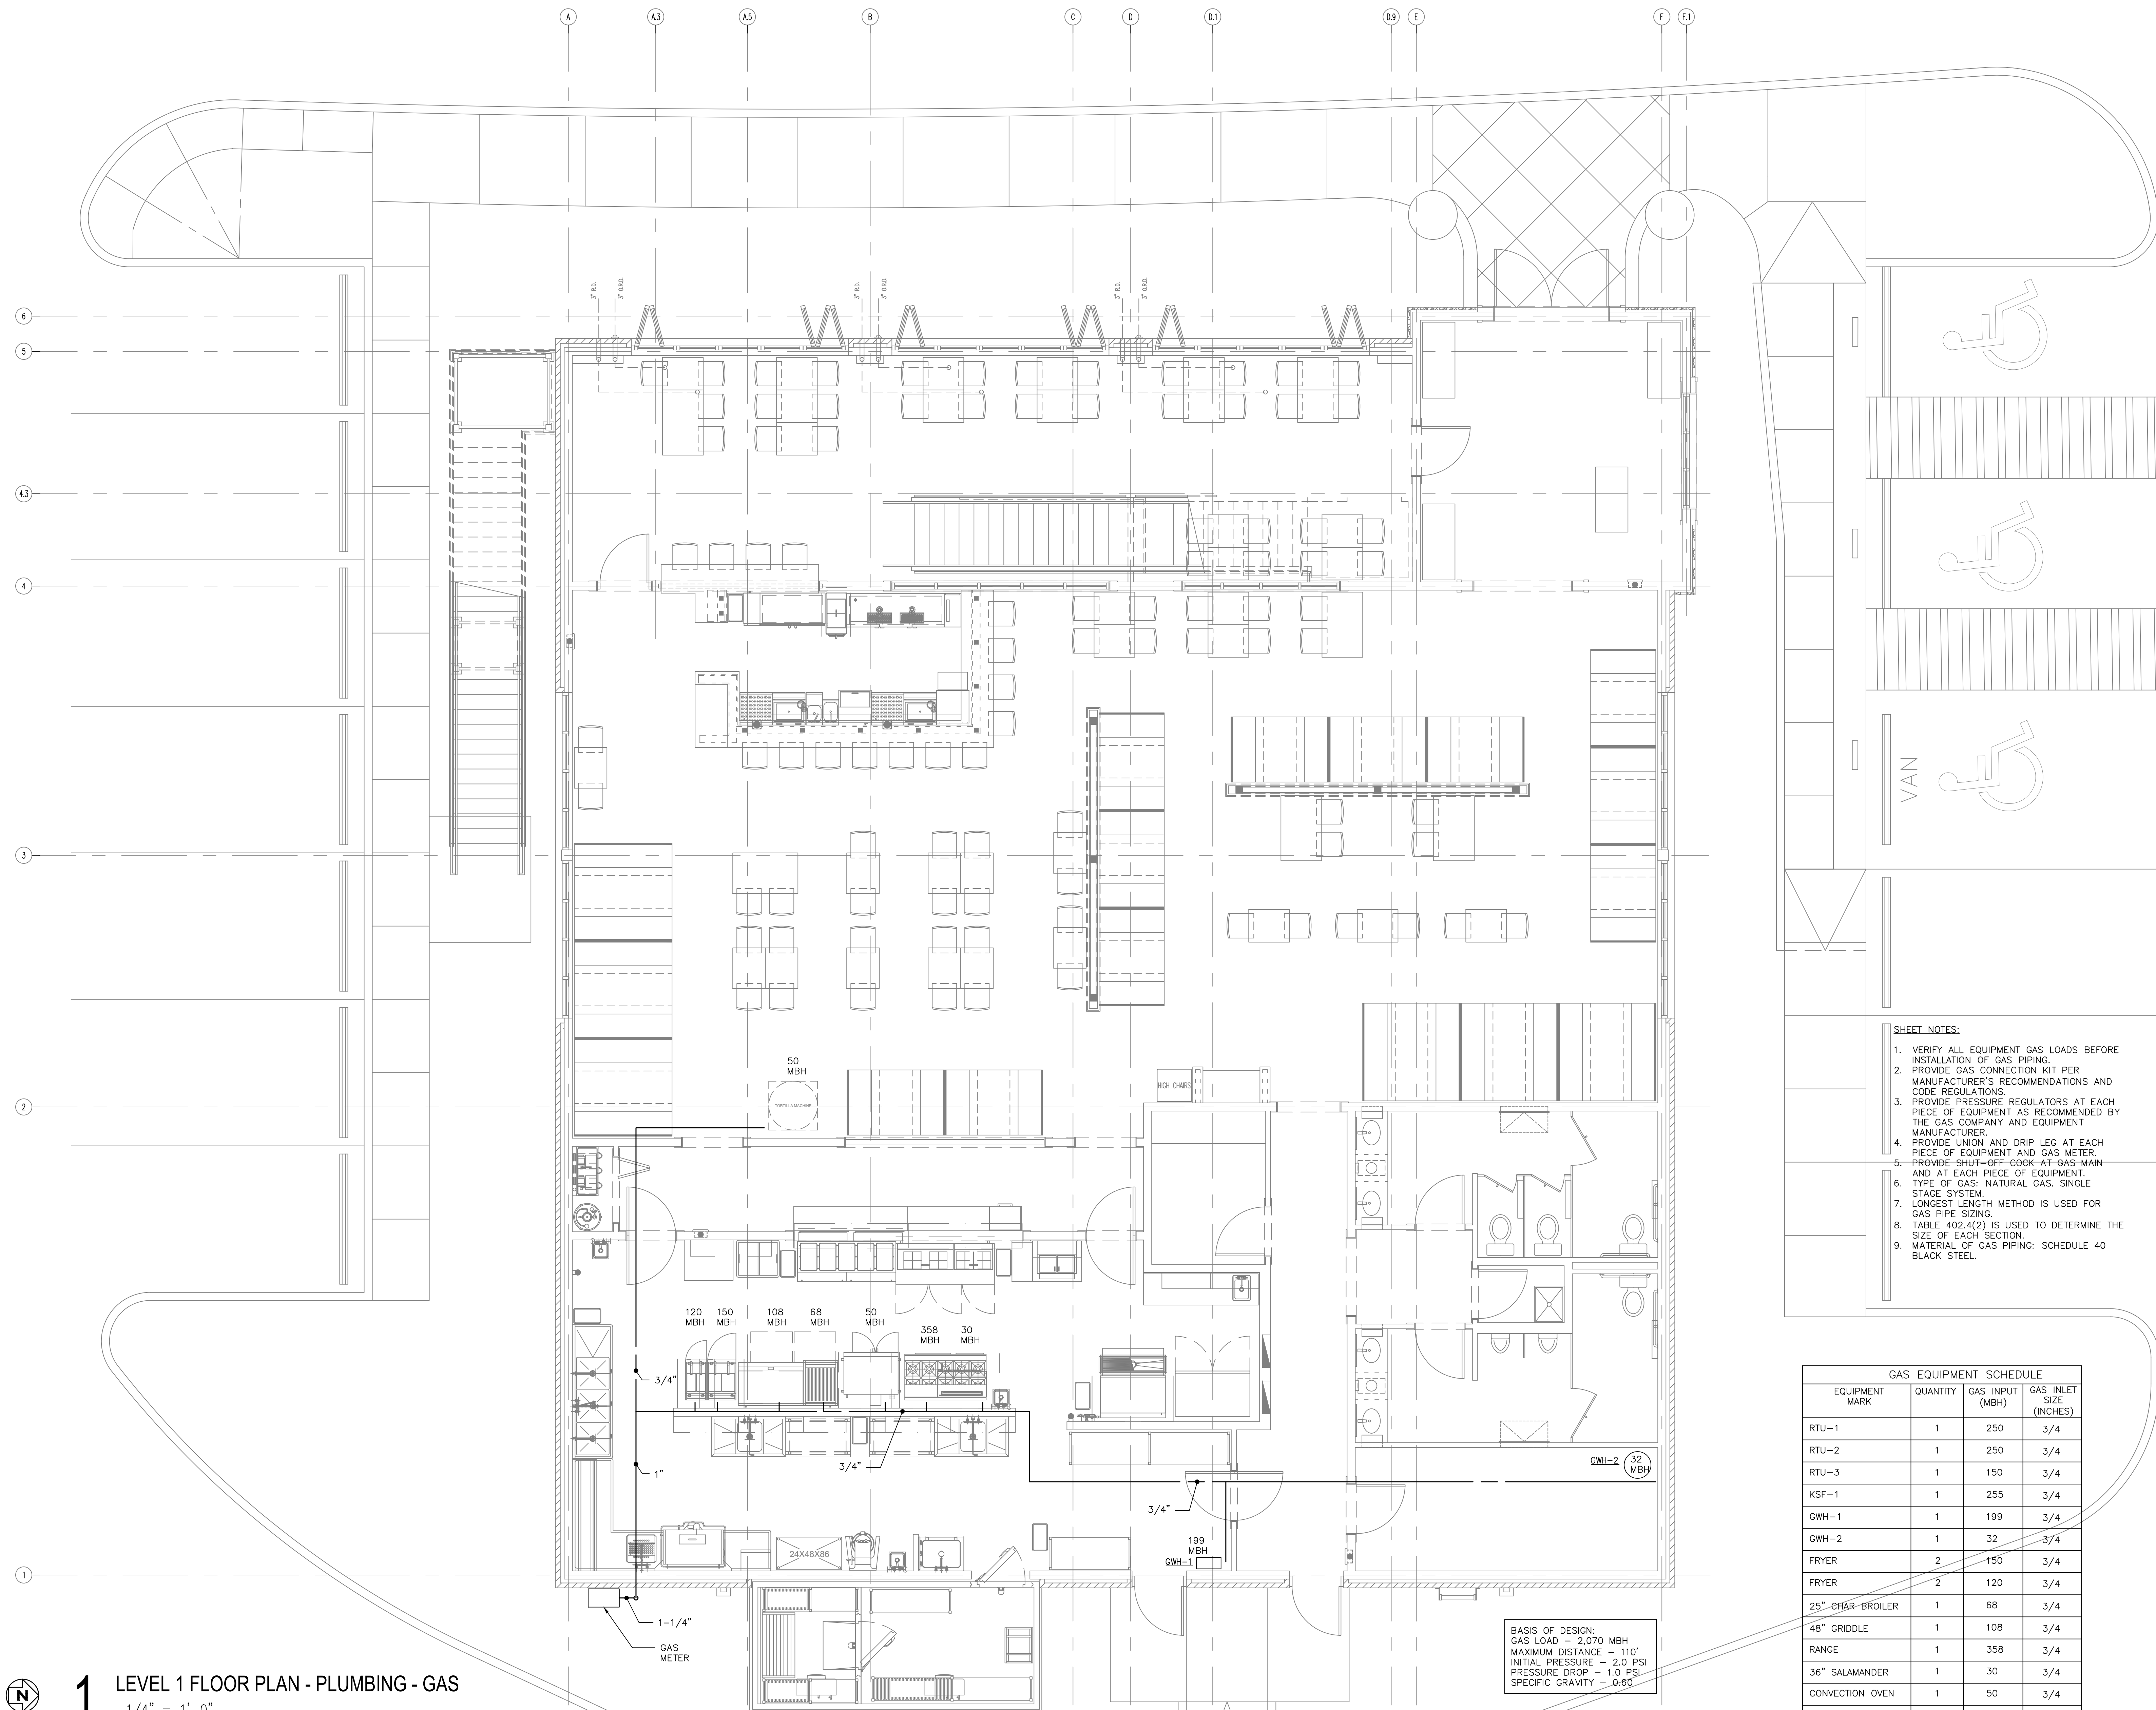

- SHEET NOTES:**
1. VERIFY ALL EQUIPMENT GAS LOADS BEFORE INSTALLATION OF GAS PIPING.
 2. PROVIDE GAS CONNECTION KIT PER MANUFACTURER'S RECOMMENDATIONS AND CODE REGULATIONS.
 3. PROVIDE PRESSURE REGULATORS AT EACH PIECE OF EQUIPMENT AS RECOMMENDED BY THE GAS COMPANY AND EQUIPMENT MANUFACTURER.
 4. PROVIDE UNION AND DRIP LEG AT EACH PIECE OF EQUIPMENT AND GAS METER.
 5. PROVIDE SHUT-OFF-COOK-AT-GAS-MAIN AND AT EACH PIECE OF EQUIPMENT.
 6. TYPE OF GAS: NATURAL GAS. SINGLE STAGE SYSTEM.
 7. LONGEST LENGTH METHOD IS USED FOR GAS PIPE SIZING.
 8. TABLE 402.4(2) IS USED TO DETERMINE THE SIZE OF EACH SECTION.
 9. MATERIAL OF GAS PIPING: SCHEDULE 40 BLACK STEEL.

GAS EQUIPMENT SCHEDULE			
EQUIPMENT MARK	QUANTITY	GAS INPUT (MBH)	GAS INLET SIZE (INCHES)
RTU-1	1	250	3/4
RTU-2	1	250	3/4
RTU-3	1	150	3/4
KSF-1	1	255	3/4
GWH-1	1	199	3/4
GWH-2	1	32	3/4
FRYER	2	150	3/4
FRYER	2	120	3/4
25" CHAR-BROILER	1	68	3/4
48" GRIDDLE	1	108	3/4
RANGE	1	358	3/4
36" SALAMANDER	1	30	3/4
CONVECTION OVEN	1	50	3/4
TORTILLA MACHINE	1	50	3/4

BASIS OF DESIGN:
GAS LOAD = 2,070 MBH
MAXIMUM DISTANCE = 110'
INITIAL PRESSURE = 2.0 PSI
PRESSURE DROP = 1.0 PSI
SPECIFIC GRAVITY = 0.60

1 LEVEL 1 FLOOR PLAN - PLUMBING - GAS
1/4" = 1'-0"



1

$$1/4'' = 1'-0''$$

ISSUED FOR CONSTRUCTION

Beach Engineering Solutions Team
Mechanical, Electrical & Plumbing
Engineering


(678) 665-3280
Project Number: 19-249

Q	BID SET	03-14-2022
A	G.C. SHOP DWG. COORD. 2	03-14-2022


Sheet Name: ROOF PLAN - PLUMBING	
Proj #: 211201	Issue Date: 03-14-2022
Sheet No.: P1.2	
Drawn By: DMB	Checked By: BGB

7 TEQUILAS RESTAURANT
5586 OLD HIGHWAY 5 (OLD GEORGIA HIGHWAY 5 AND PAYNE ROAD)
WOODSTOCK, GEORGIA 30188


CONSTRUCTION COORDINATION DRAWINGS
PREPARED FOR INNOVATIVE CONTRACTING SOLUTIONS
5605 GLENDRIDGE DR. NE
SUITE 345 ATLANTA, GEORGIA 30342

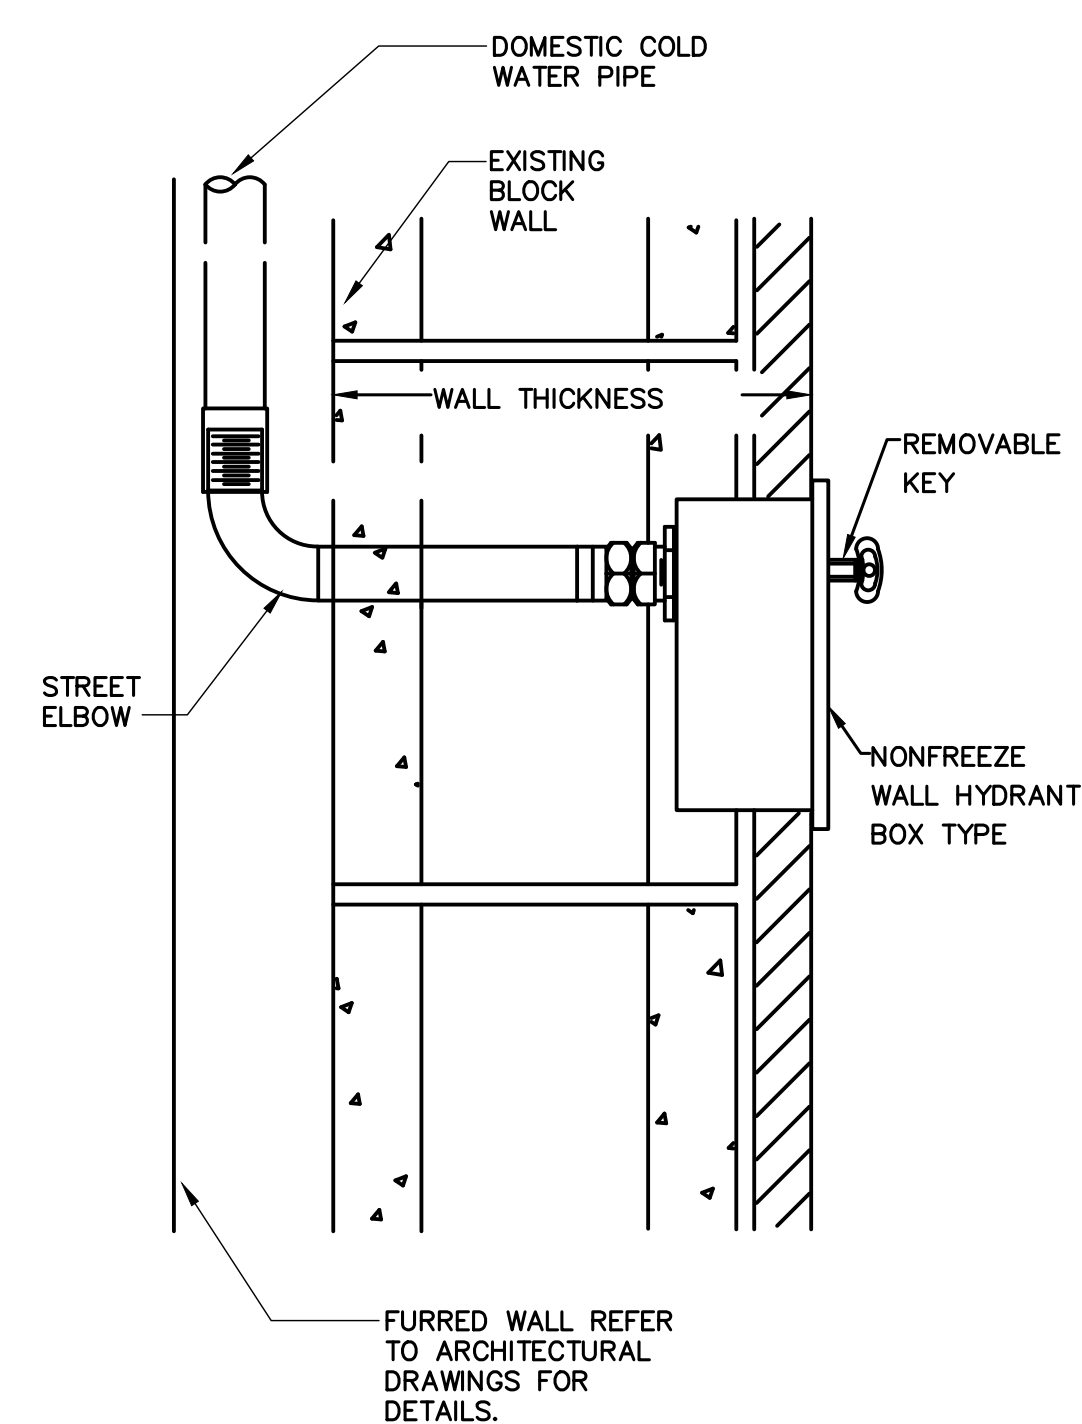


5 NONFREEZE WALL HYDRANT DETAIL

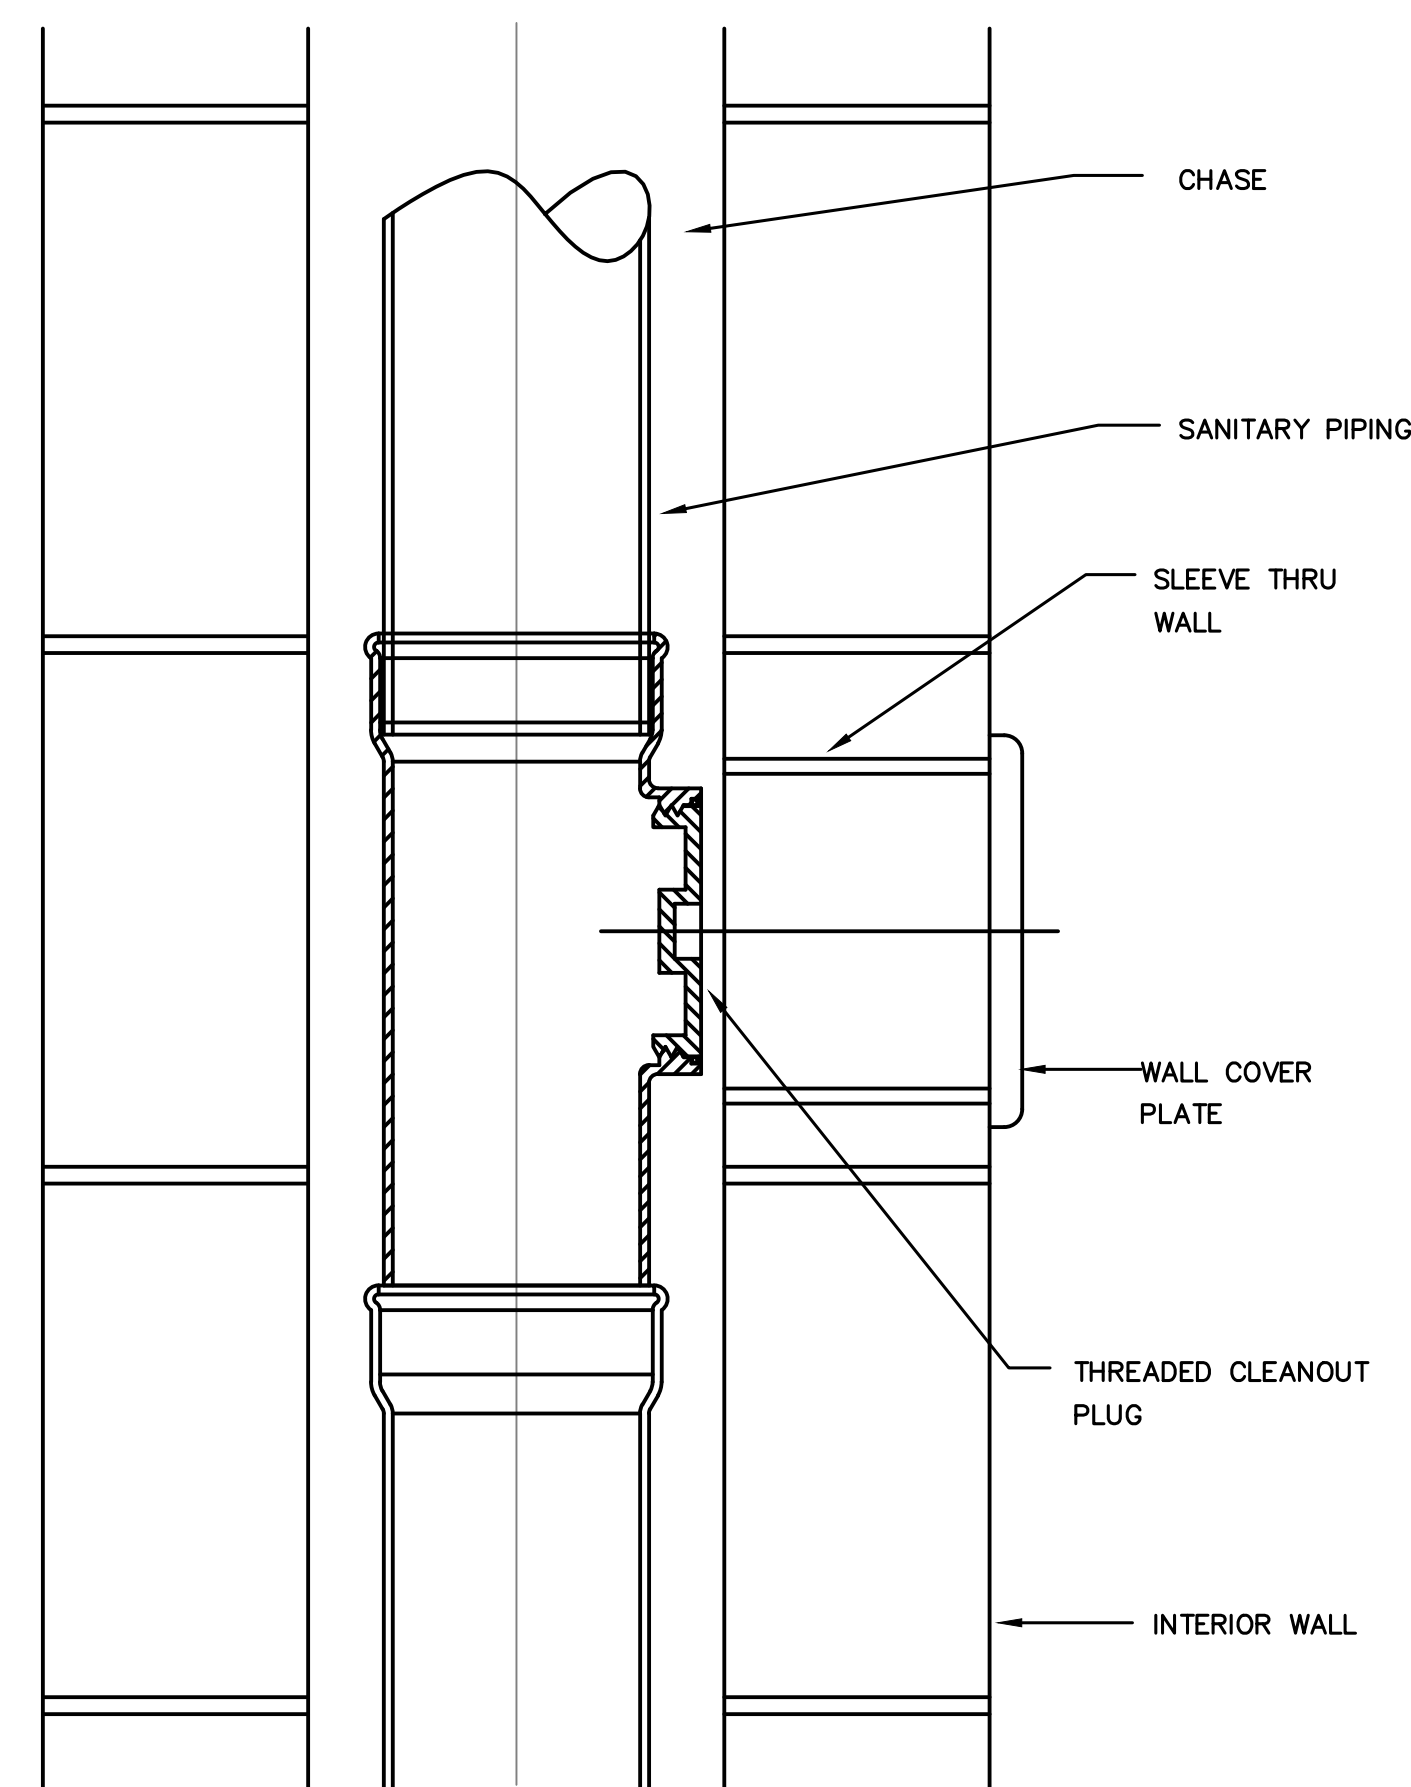


4 WALL CLEANOUT DETAIL

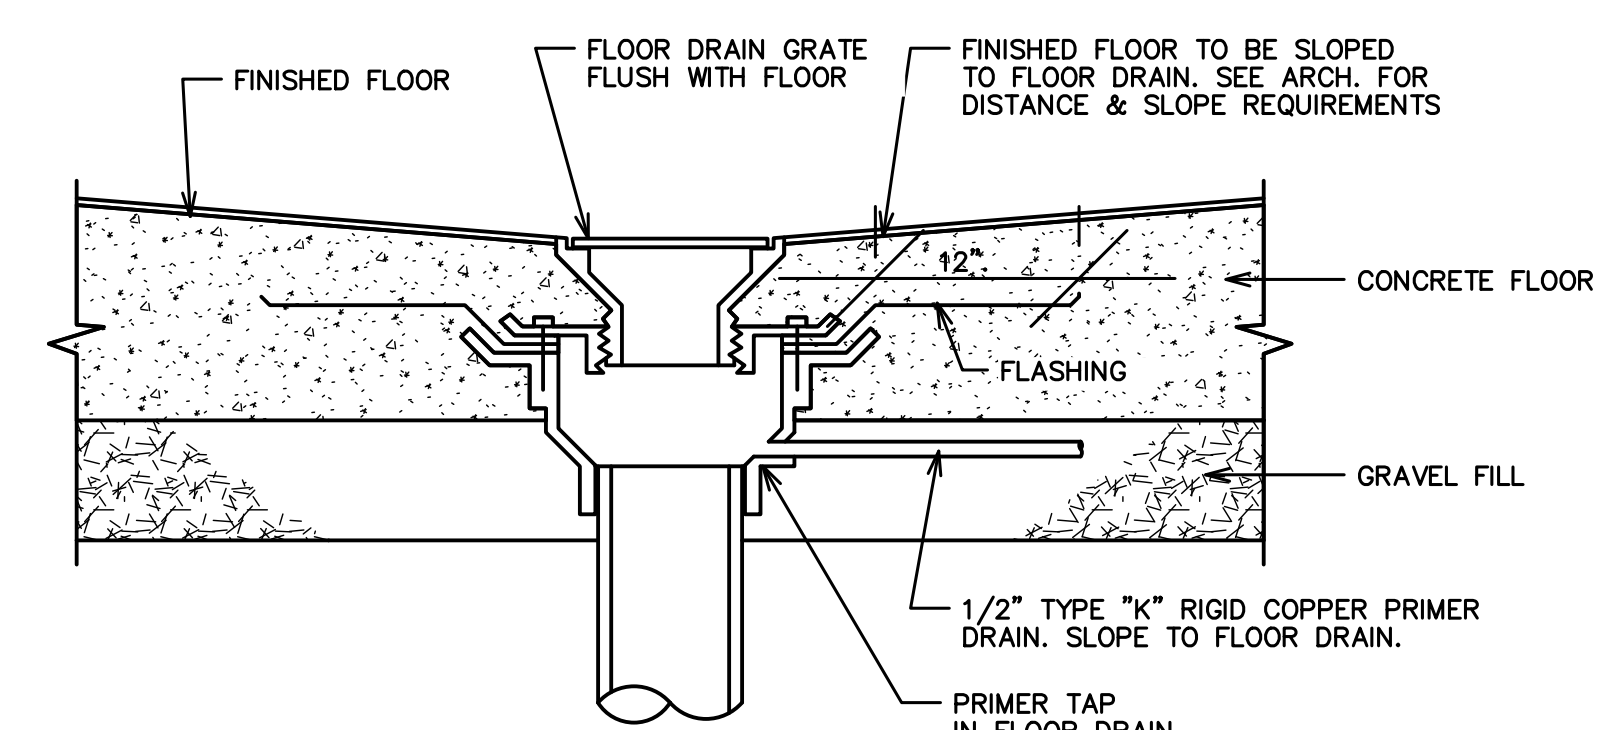

2 TYPICAL FLOOR DRAIN DETAIL @ CONC. FLOOR ON GRADE

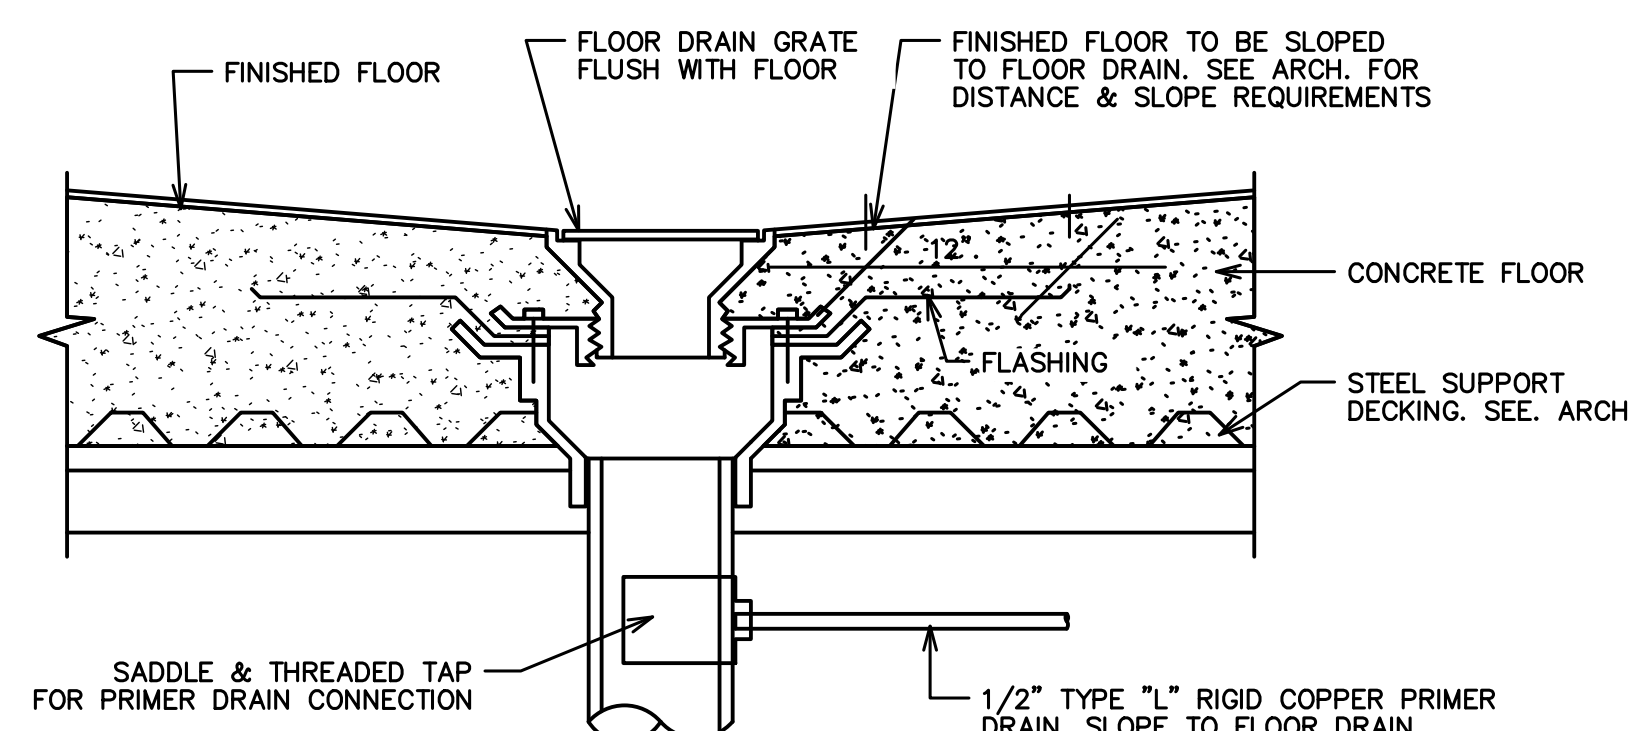


3 TYPICAL FLOOR DRAIN DETAIL @ CONC. FLOOR W/ STEEL SUPPORT

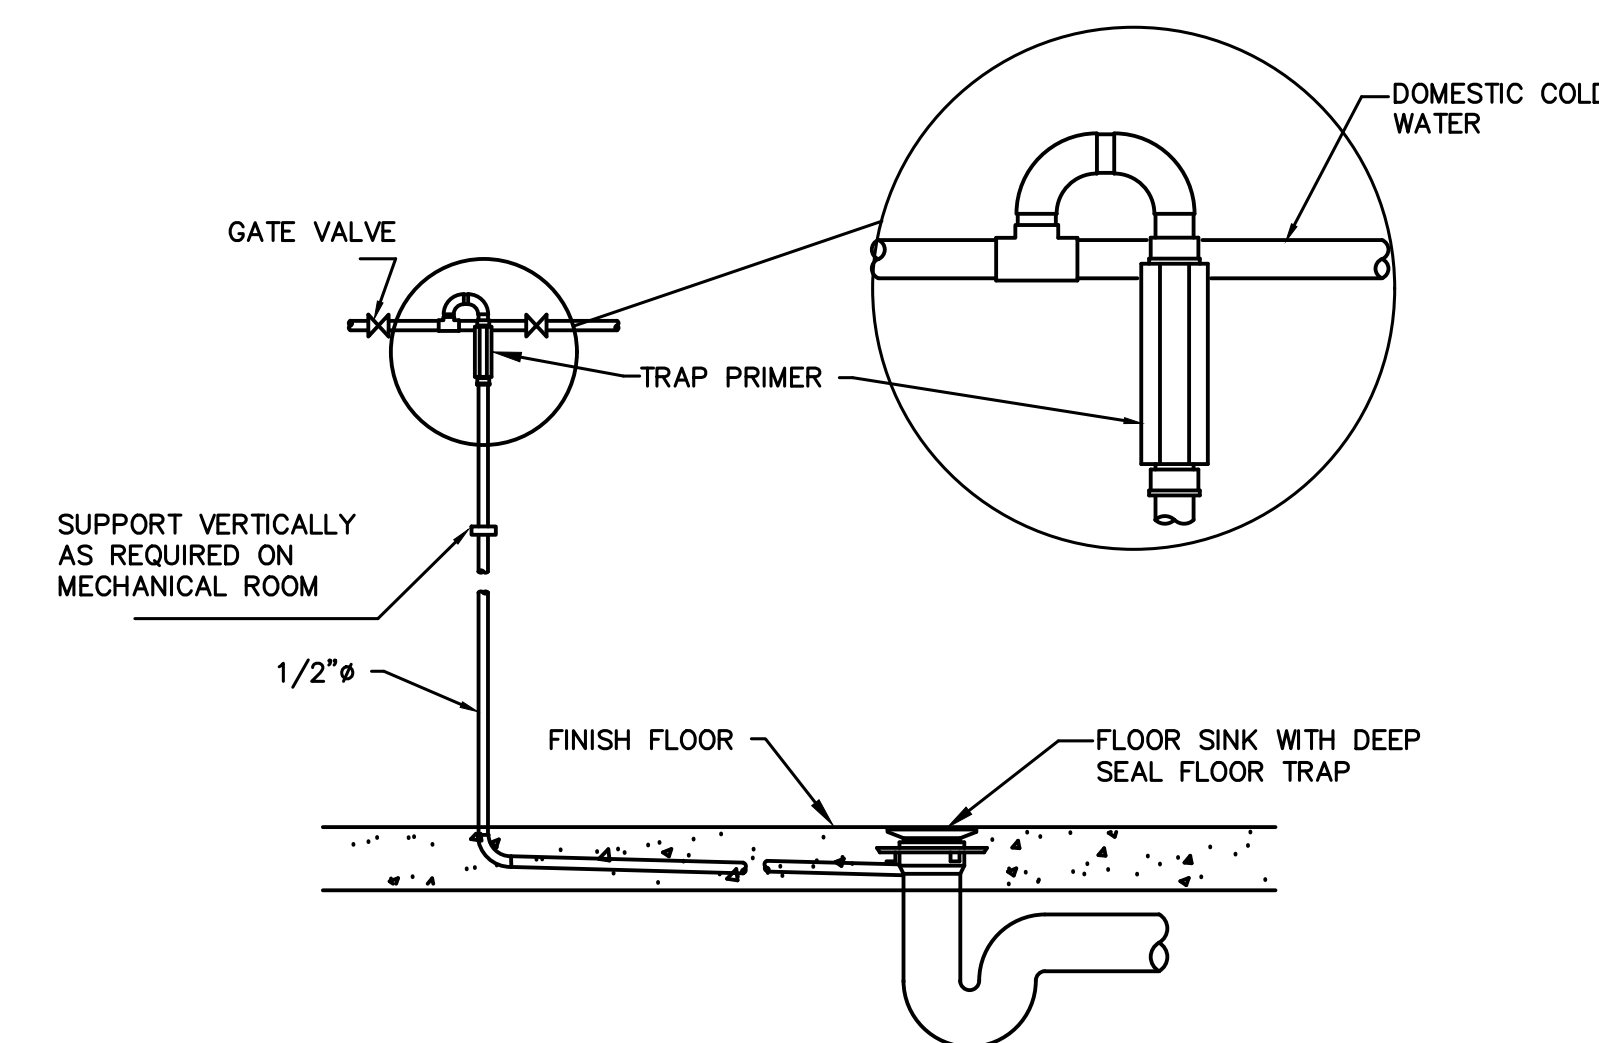


1 TRAP PRIMER DETAIL

- NOTES:
1. PLACE IN $\frac{3}{4}$ " OR $\frac{1}{2}$ " SIZE LINE ONLY.
 2. PROVIDE DISTRIBUTION UNIT WHERE MORE THAN ONE TRAP PRIMER LINE IS REQUIRED
 3. ALL TRAP PRIMERS LOCATED IN FINISHED ROOMS SHALL BE RECESSED INSIDE PARTITION AND PROVIDED WITH ACCESS PANELS.
 4. TRAP PRIMERS LOCATED IN MECHANICAL ROOMS SHALL BE EXPOSED.

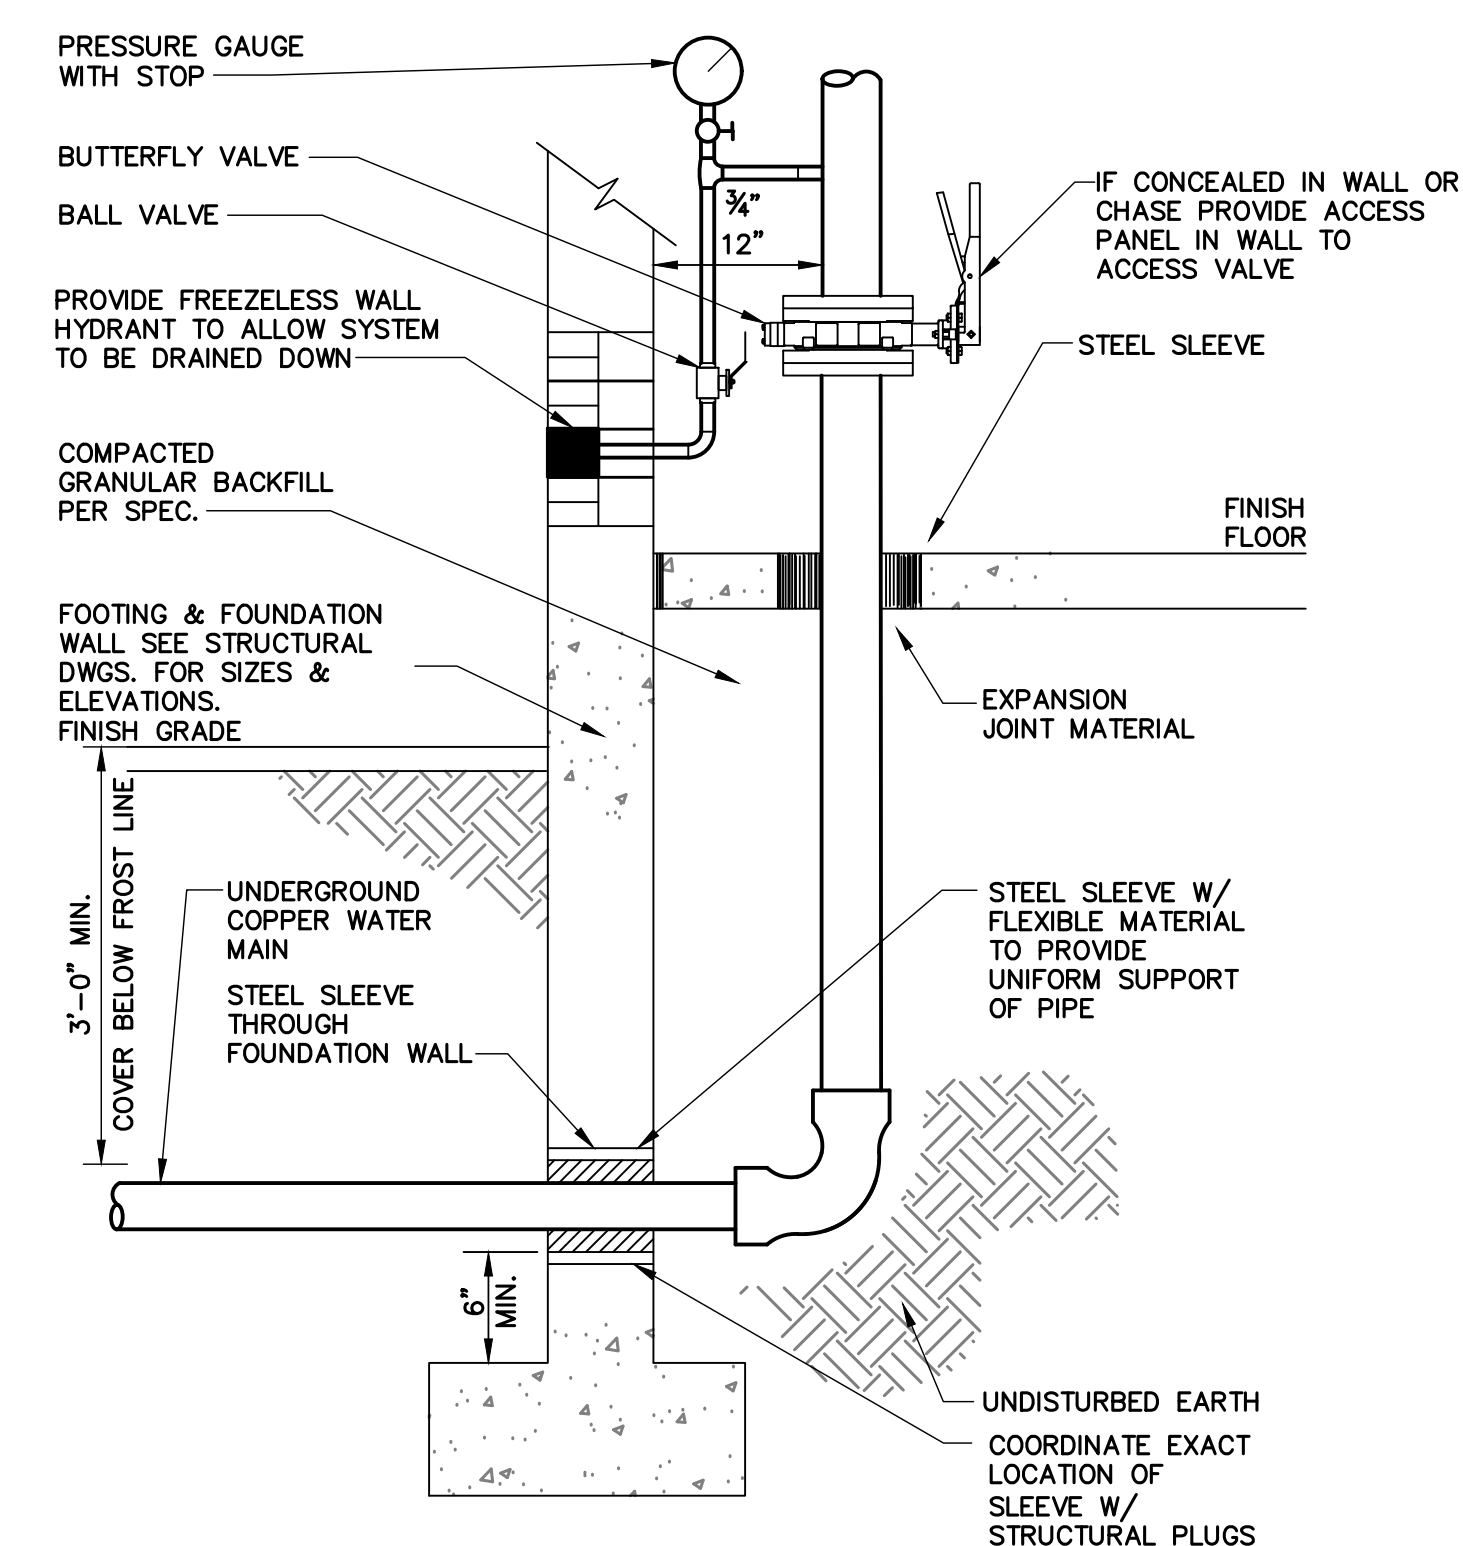


9 WATER RISER DETAIL

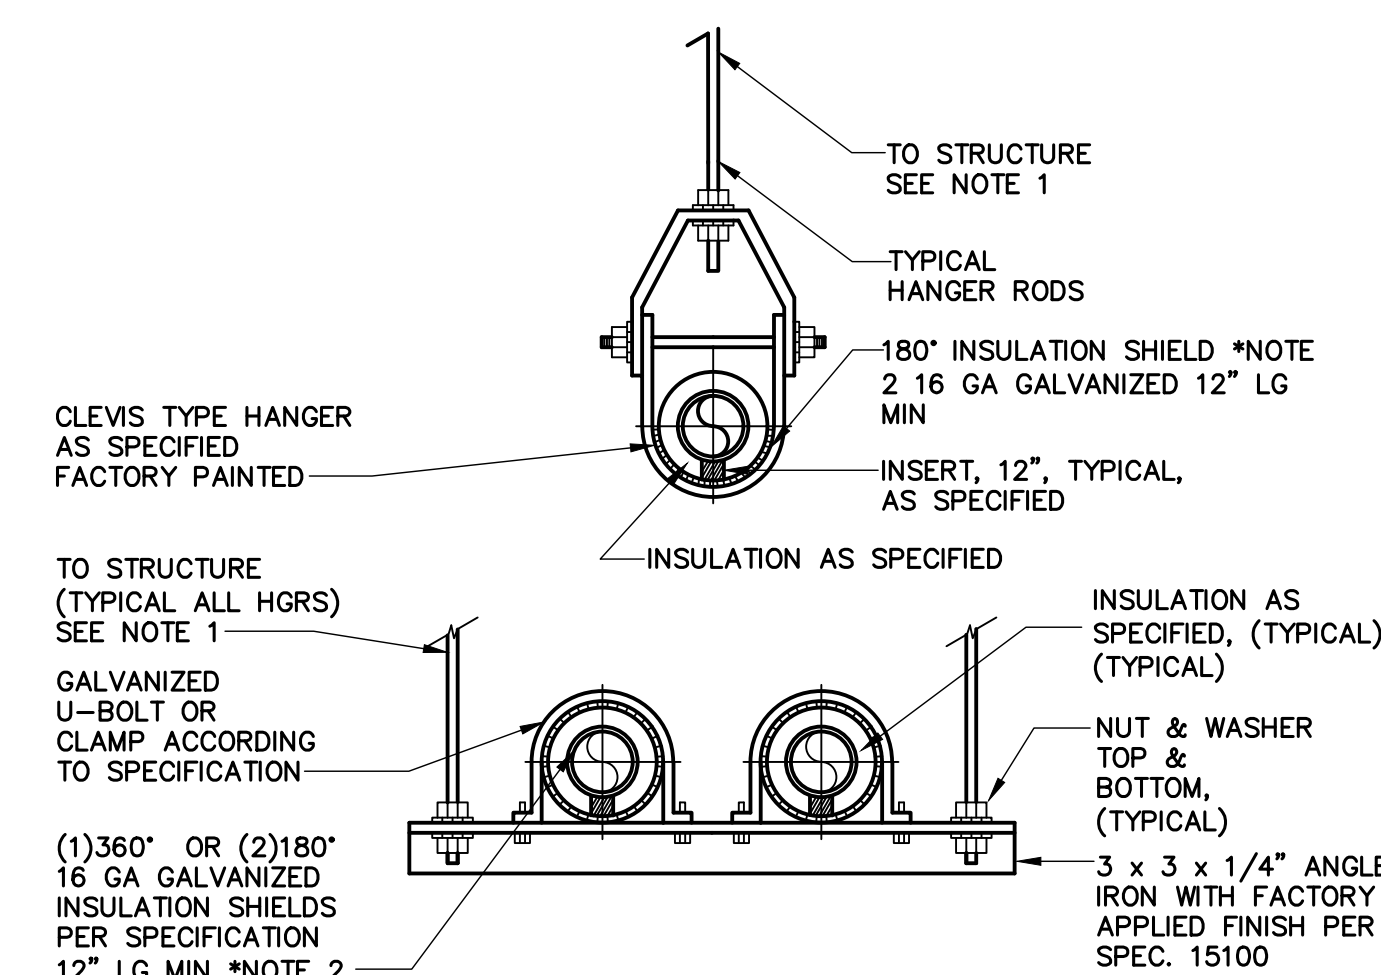


8 DETAIL - PIPE HANGER


- NOTES:
1. SUBMIT ANCHORING METHOD TO STRUCTURAL ENGINEER FOR APPROVAL.
 2. 180° INSULATION SHIELDS MUST BE BANNED. USE SS OR NYLON. 2 PCS EACH.
 3. PIPE HANGERS, SUPPORTS AND RODS SHALL HAVE A FACTORY CADMIUM OR GALVANIZED FINISH. SEE SPEC. 15100

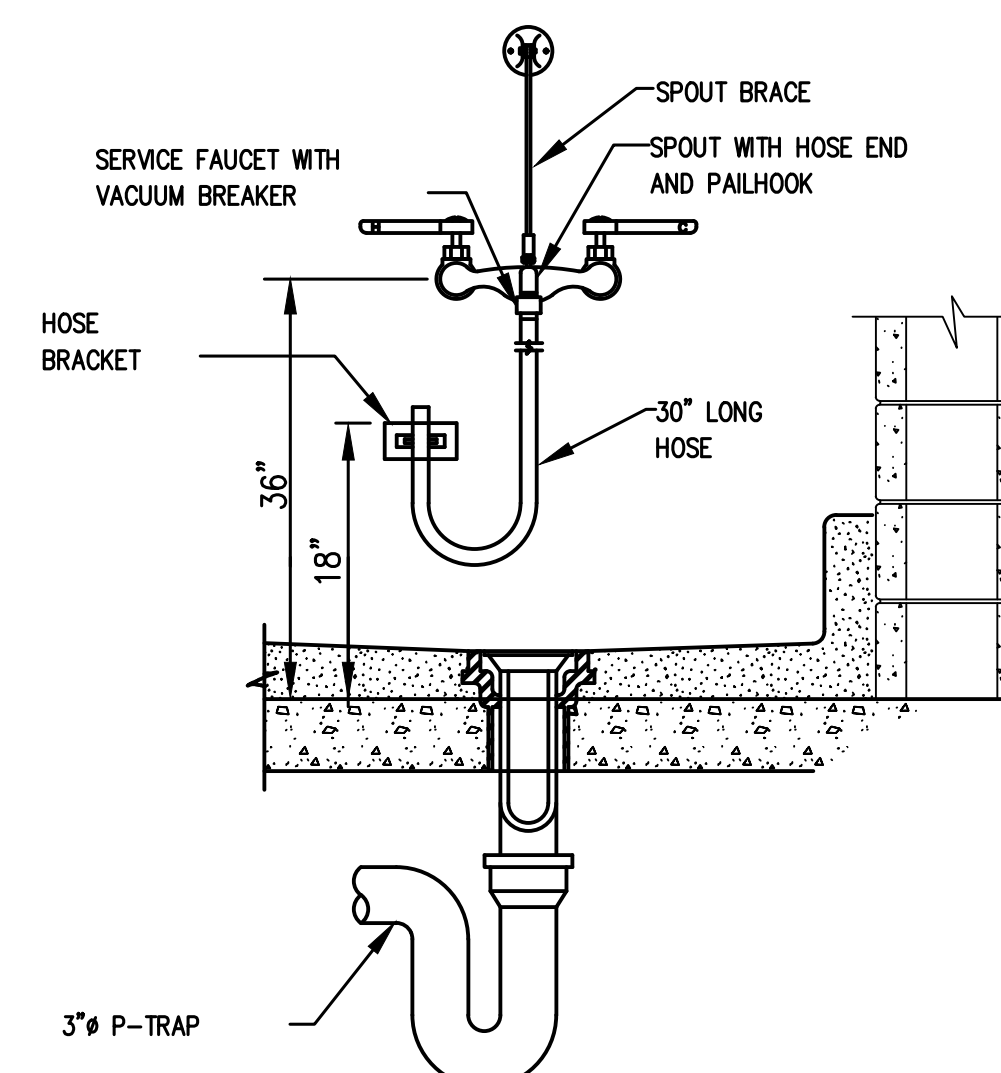


7 MOP SINK DETAIL

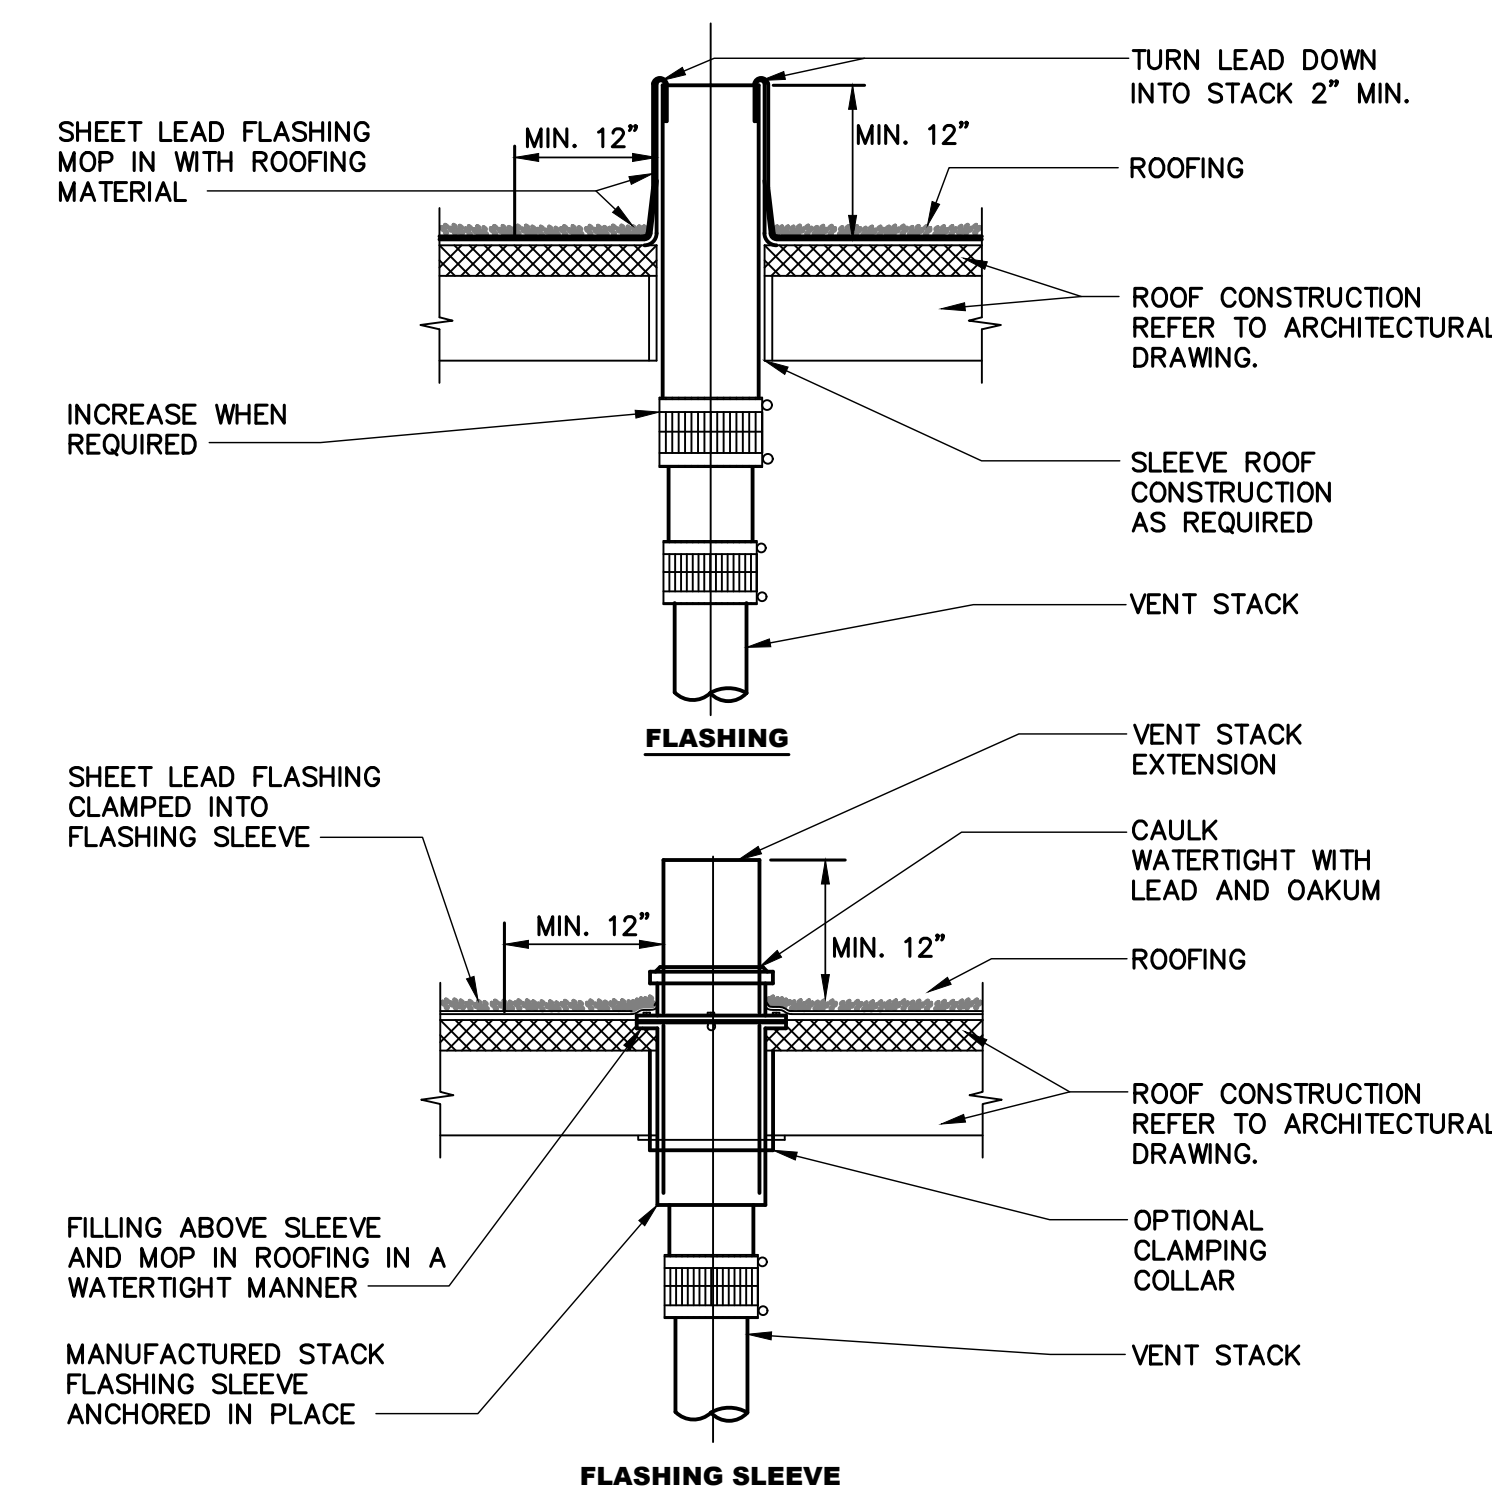


6 DETAIL - VENT THROUGH ROOF (VTR)

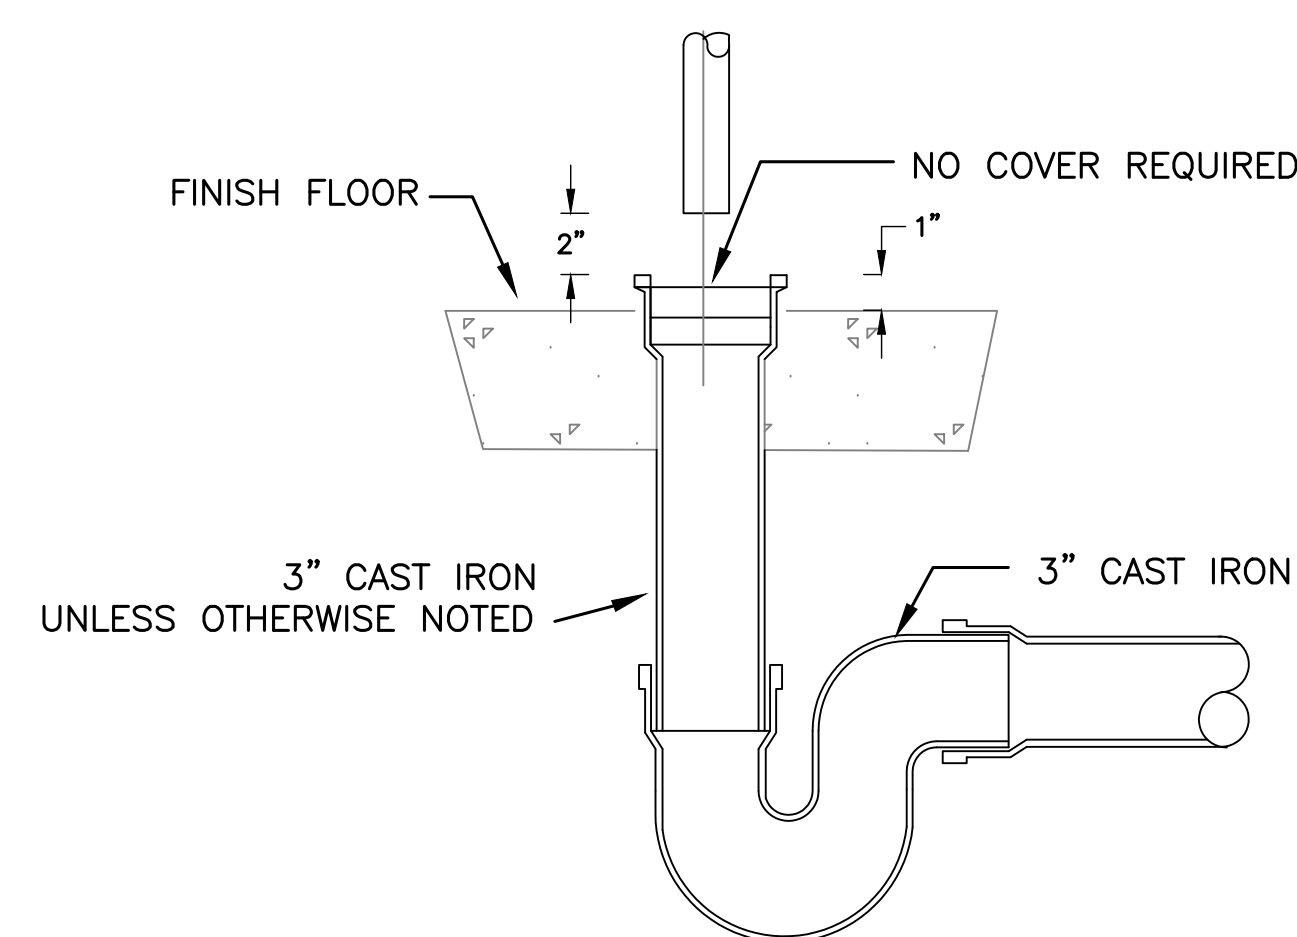


13 HUB DRAIN DETAIL

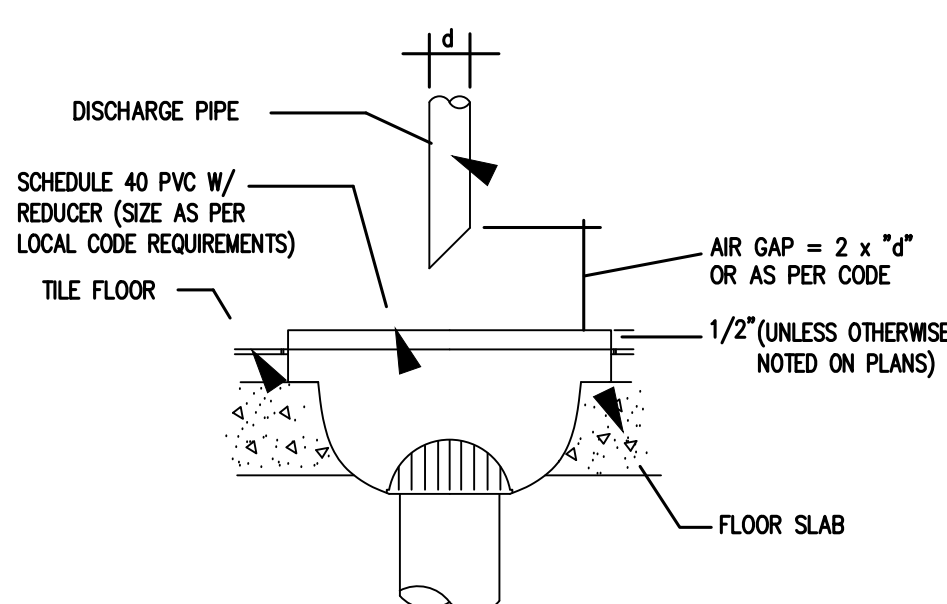


12 FLOOR SINK DETAIL W/ AIR GAP
SCALE: NTS

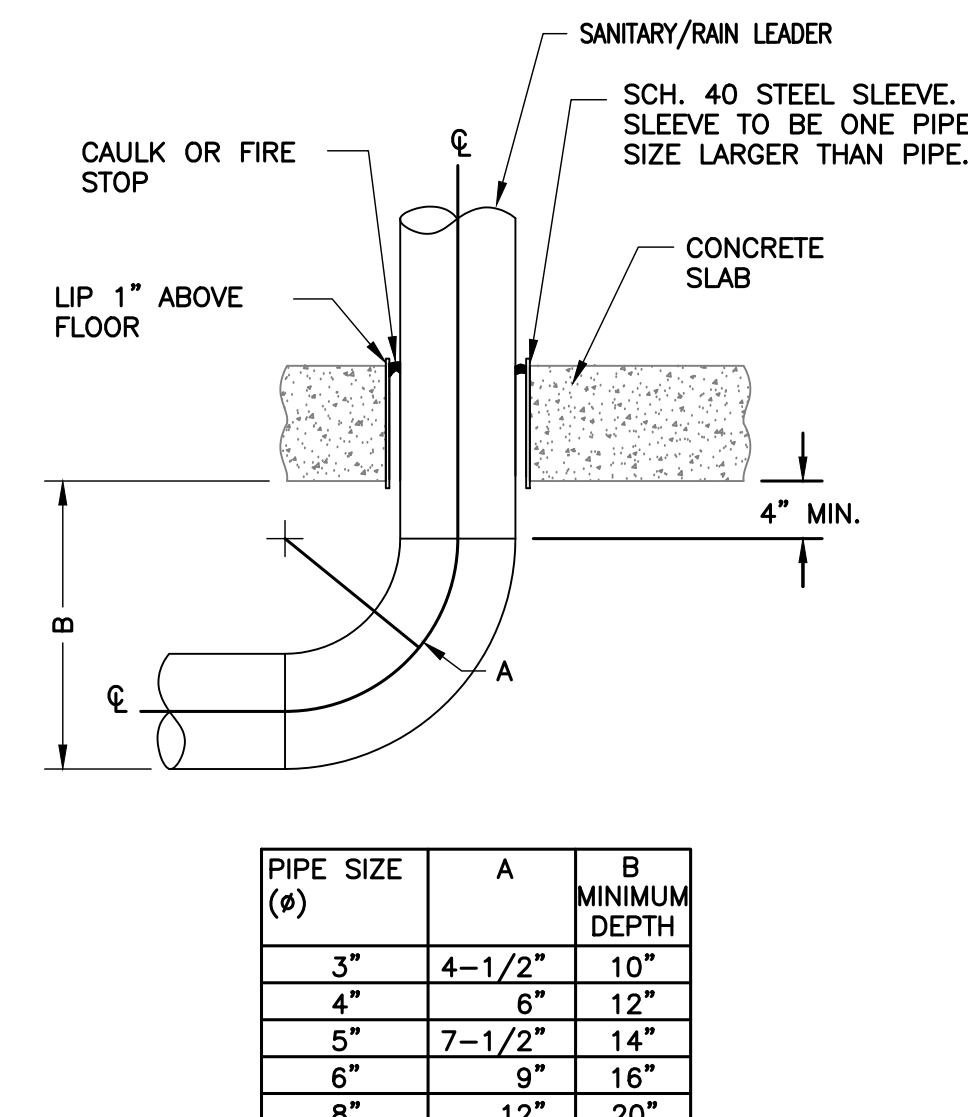

11 FLOOR PENETRATION DETAIL

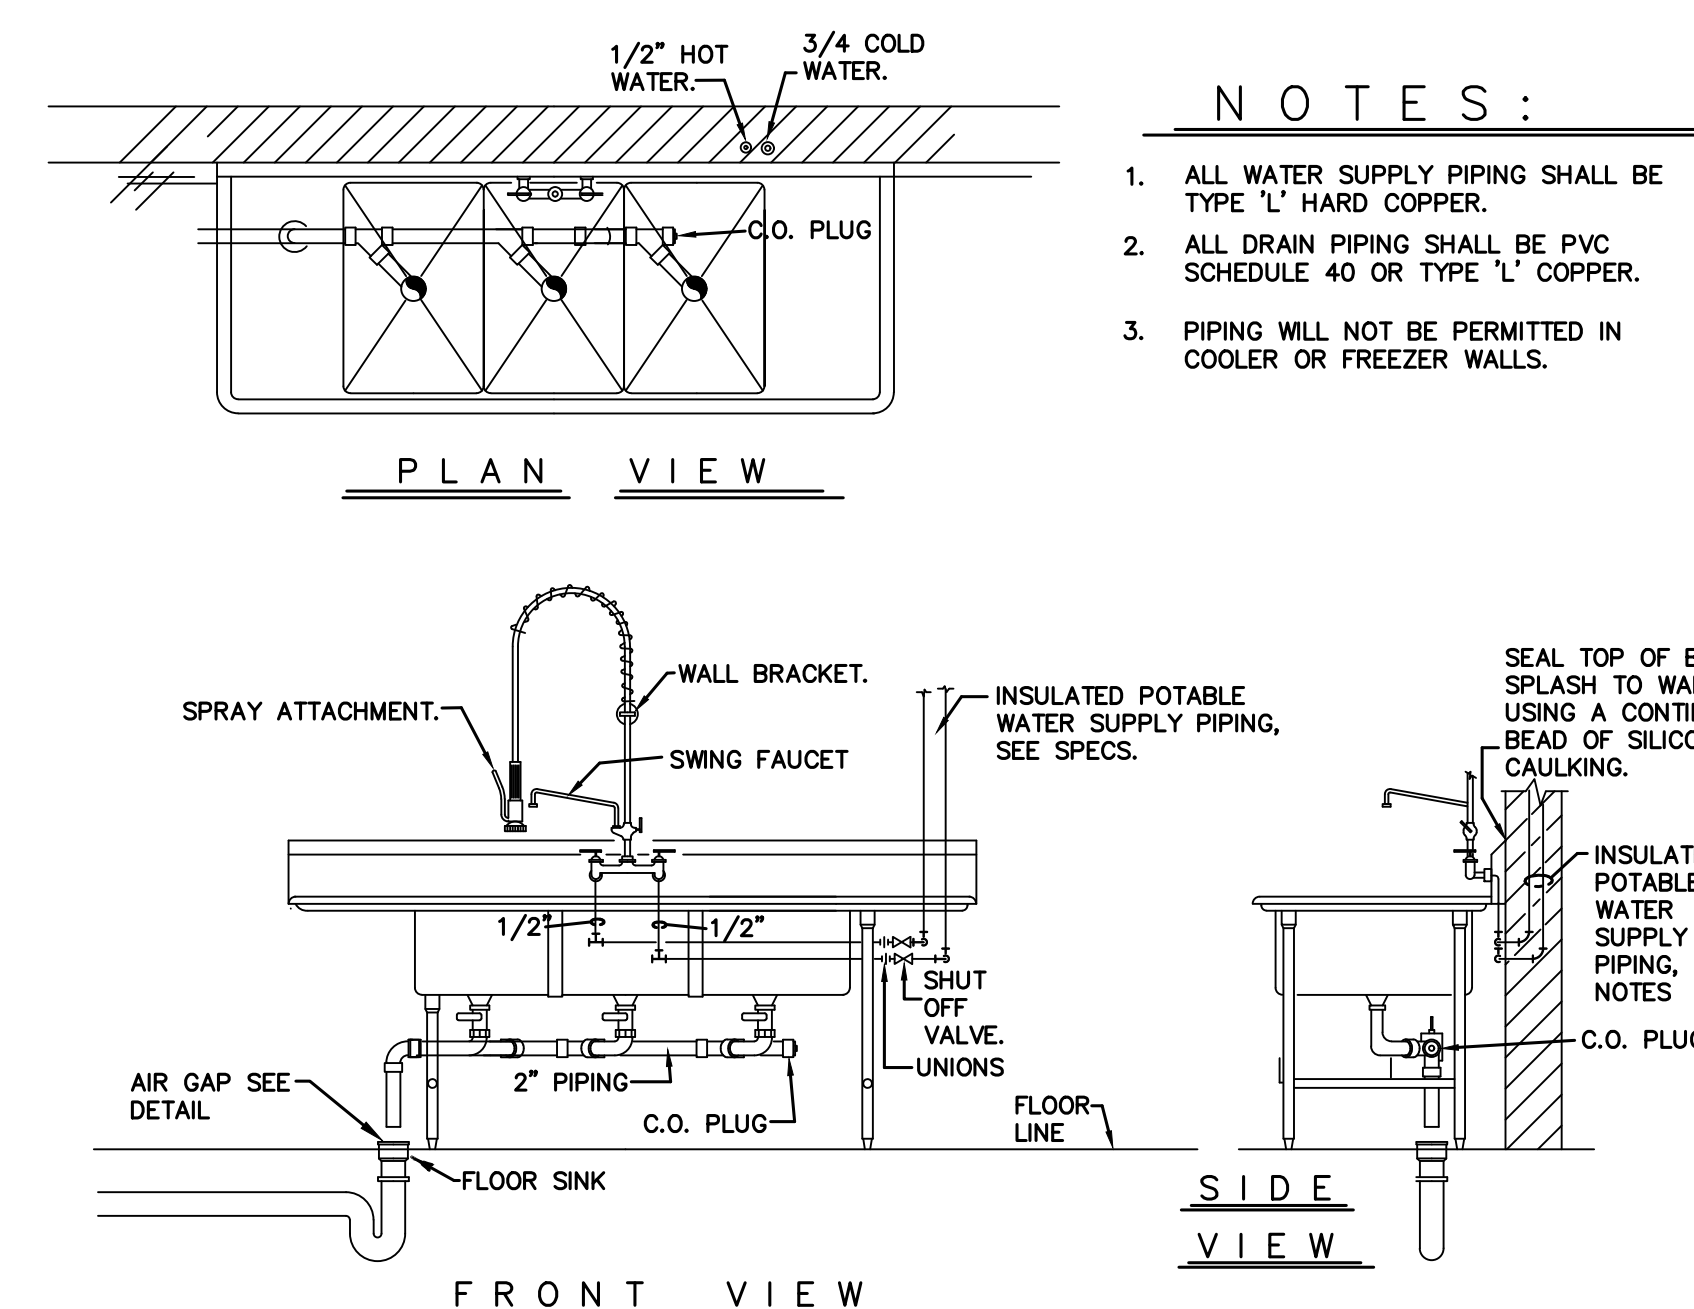


10 MULTIPLE COMPARTMENT SINK DETAIL

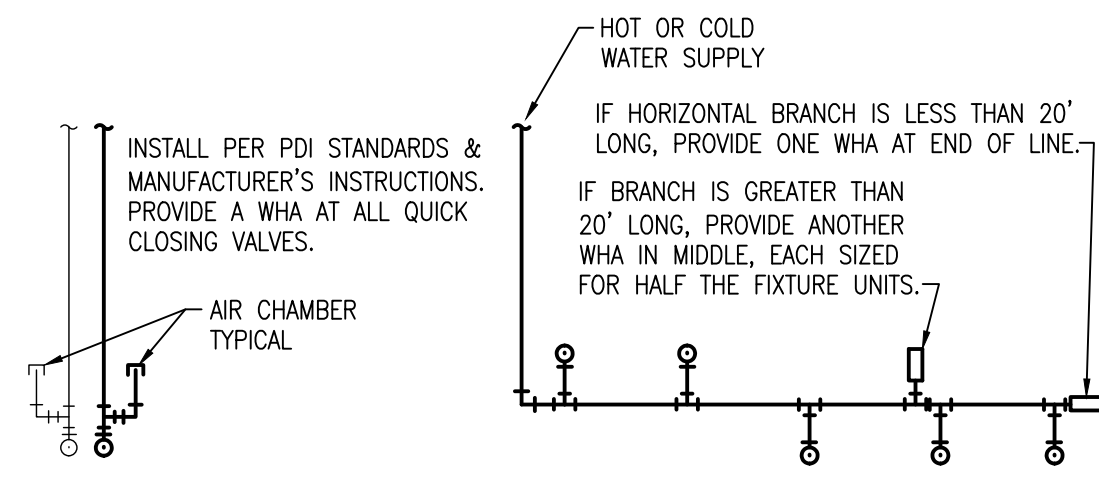


SINGLE/DOUBLE FIXTURE			MULTIPLE FIXTURES		
PDI SIZE	PIPE SIZE	FIXTURE UNIT LOAD	FIXTURE UNIT TABULATION		
			FIXTURE	COLD	HOT
A	1/2"	1-11	VALVE WATER CLOSET	10	--
B	3/4"	12-32	TANK WATER CLOSET	5	--
C	1"	33-60	URINAL	5	--
D	1-1/4"	61-113	LAVATORY/SINK	1.5	1.5
E	1-1/2"	114-154	JANITOR'S SINK	3	3
F	2"	154-330	SHOWER/BATHTUB	2	2

FOR BATTERIES OF FIXTURES, PROVIDE WATER HAMMER ARRESTERS BY SIOUX CHIEF, PRECISION PLUMBING PRODUCTS, WATTS OR APPROVED EQUIVALENT WITH PISTON & O-RING CONSTRUCTION, HAVING PDI #WH-201, ASSE #1010 & ANSI #A12.25.1M CERTIFICATION. INSTALL IN HORIZONTAL OR VERTICAL POSITION, BUT NEVER UPSIDE DOWN. INSTALL IN LINE WITH WATER FLOW DIRECTION IF POSSIBLE. SIZE THE UNITS AS SHOWN ON THE DRAWINGS AND/OR PER THE TABLES SHOWN ABOVE. PROVIDE ACCESSIBILITY TO "WHA" WHERE REQUIRED BY LOCAL CODE.


6 WATER HAMMER DETAIL
SCALE: NTS

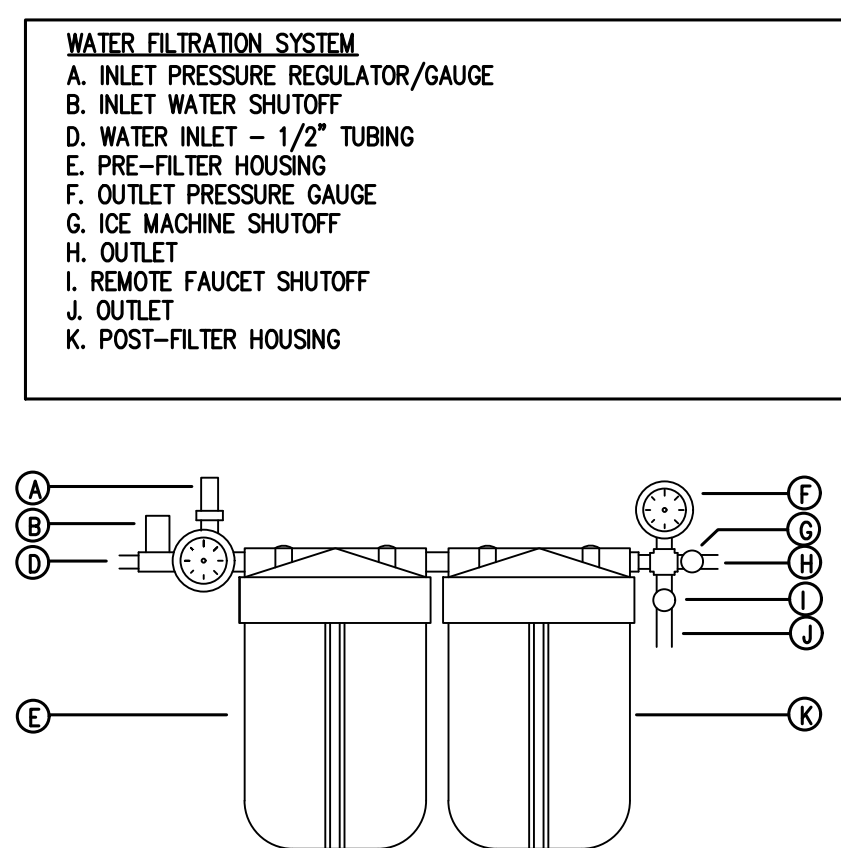


5 FILTER DETAIL
SCALE: NTS

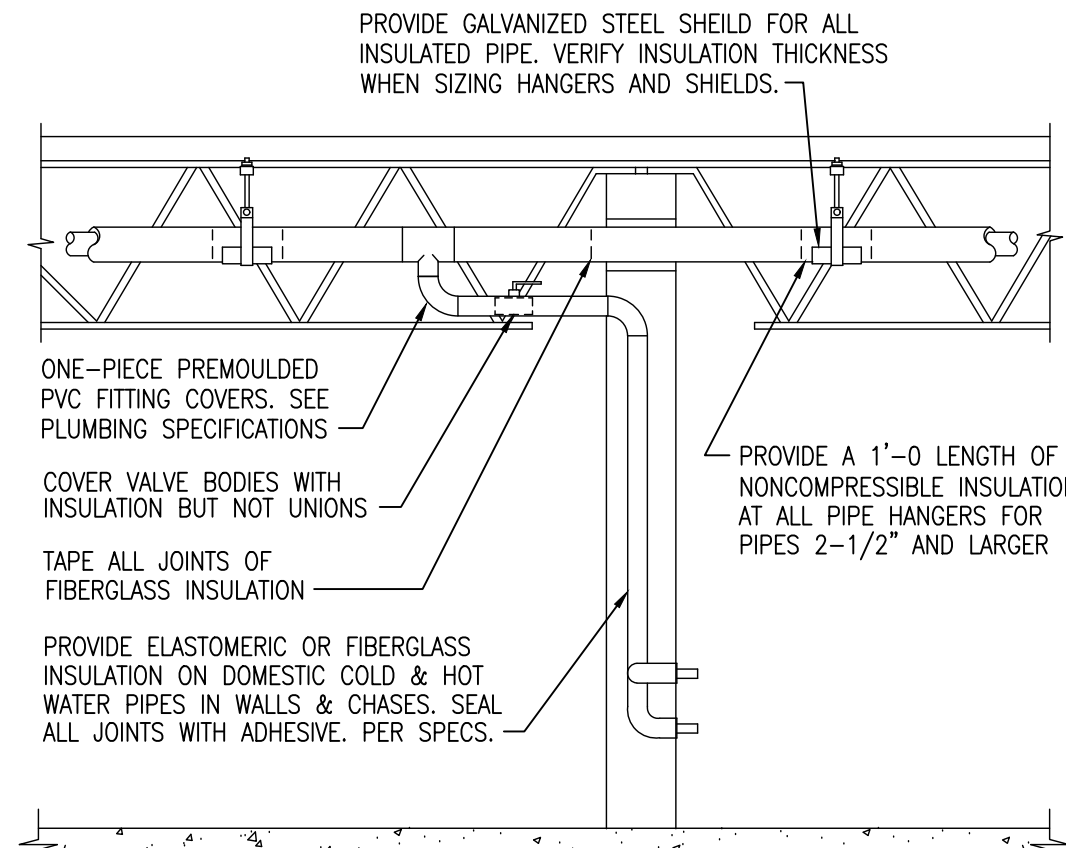


4 PIPE INSULATION DETAIL
SCALE: NTS

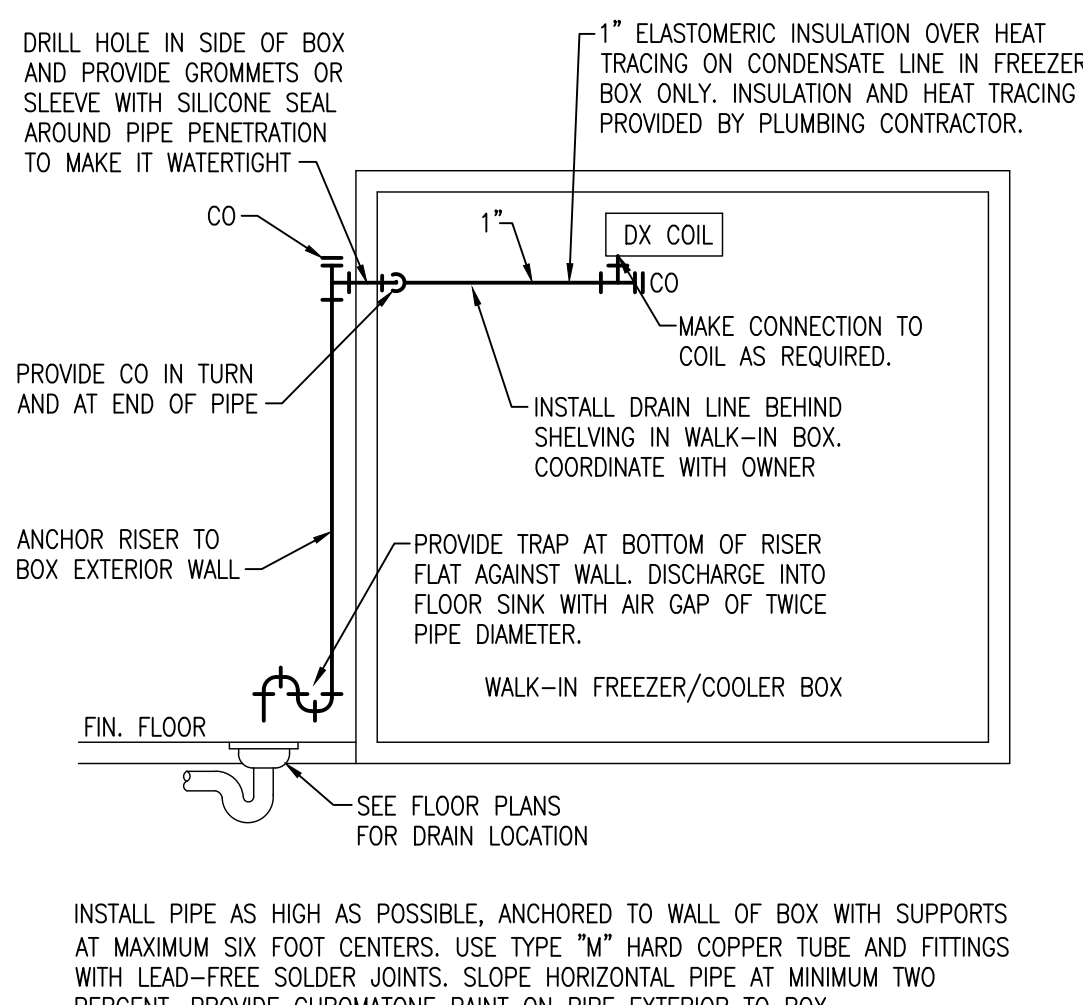


3 CONDENSER DRAIN FREEZER/COOLER
SCALE: NTS

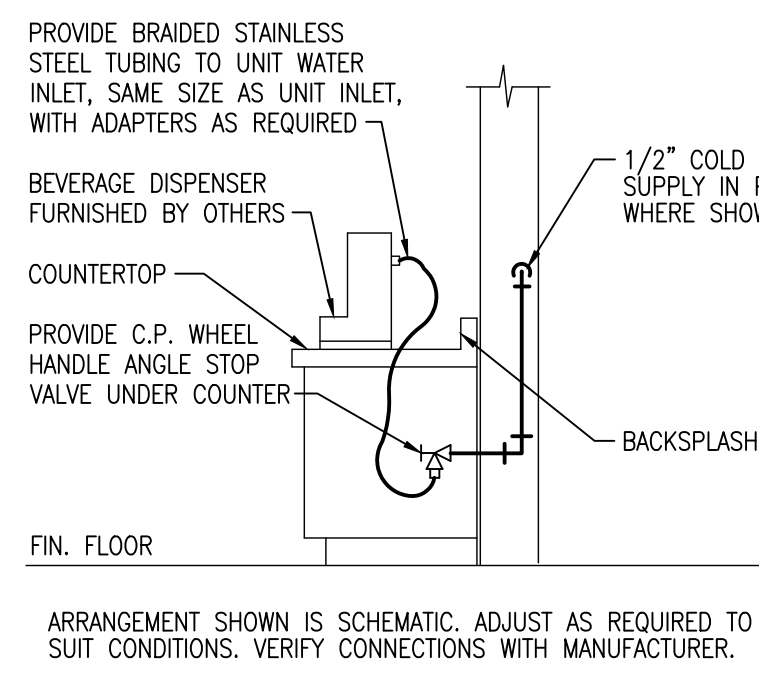


2 BEVERAGE DISPENSER
SCALE: NTS

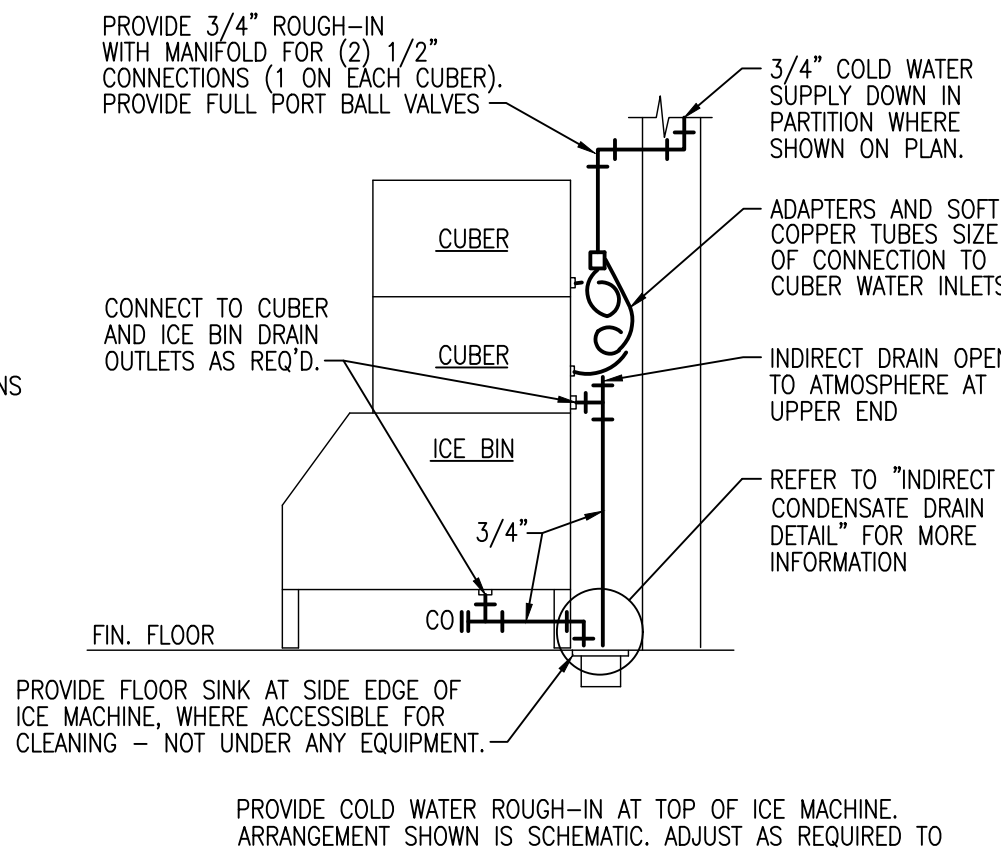


1 ICE MACHINE DETAIL
SCALE: NTS

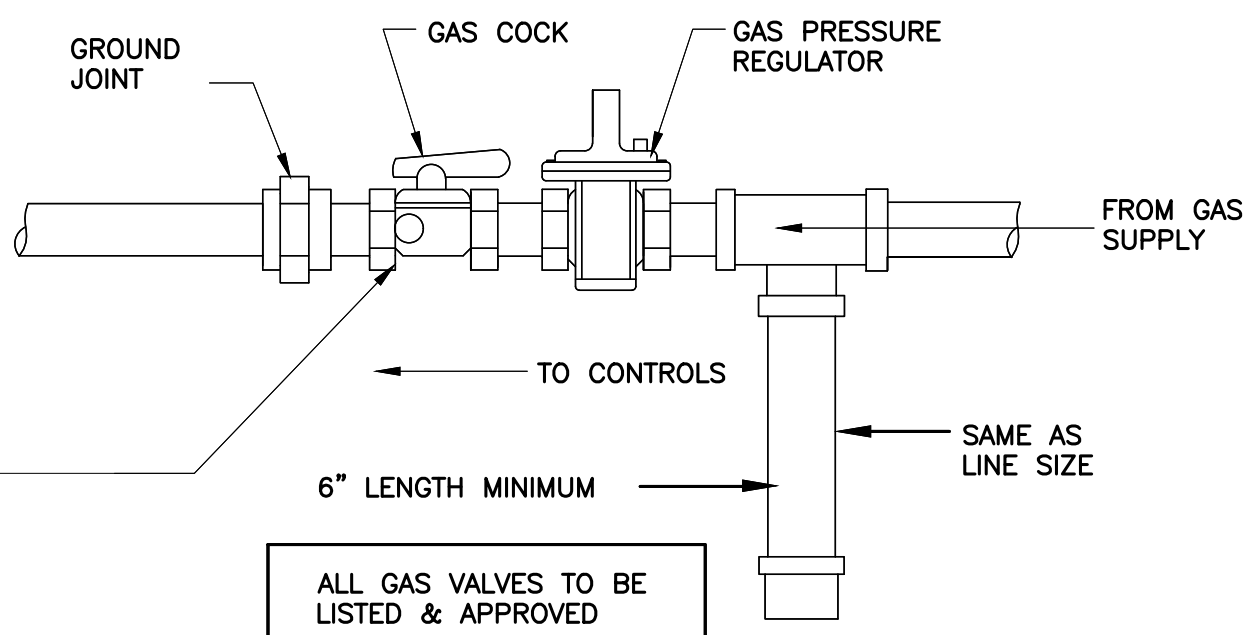


10 GAS PIPING CONNECTION DETAIL
SCALE: NTS

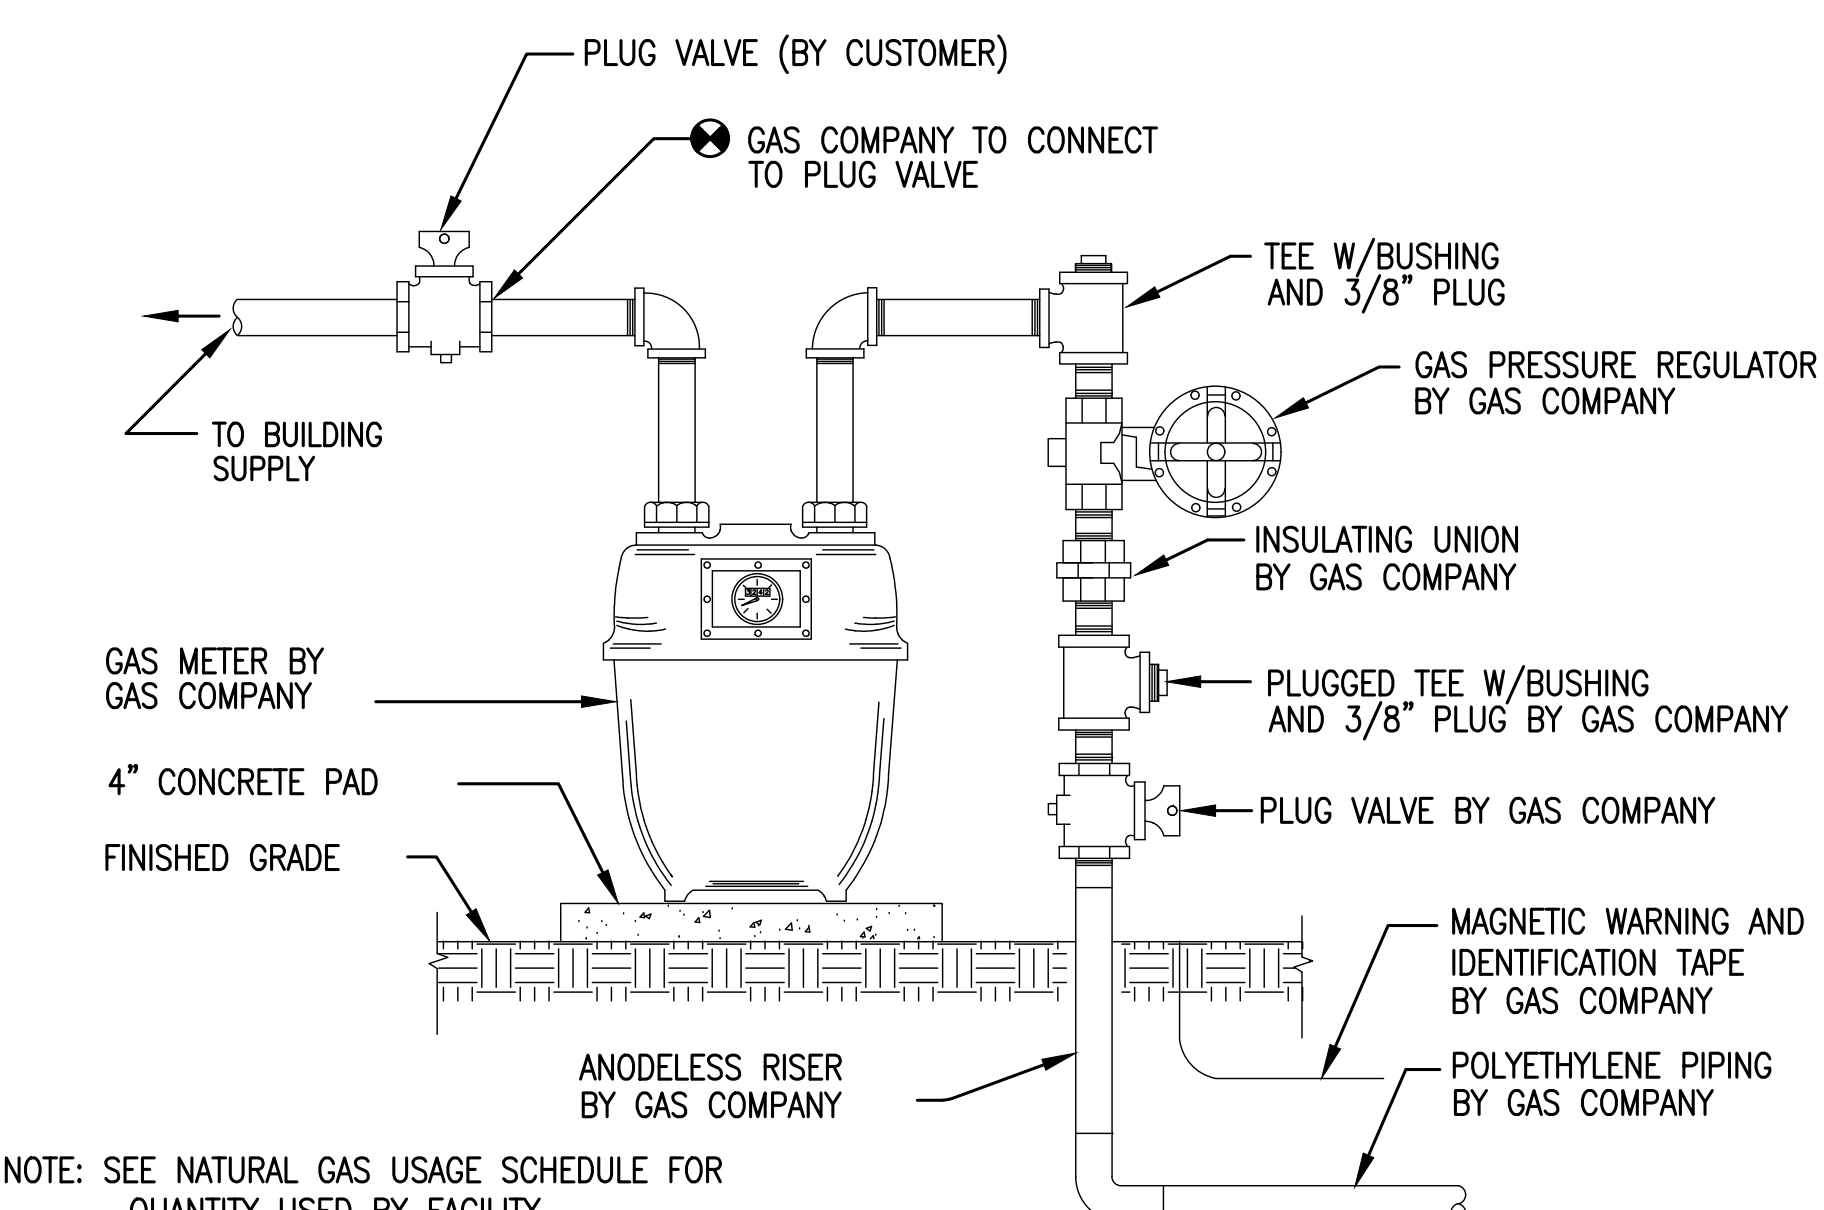


9 TYPICAL GAS SERVICE DETAIL
SCALE: NTS

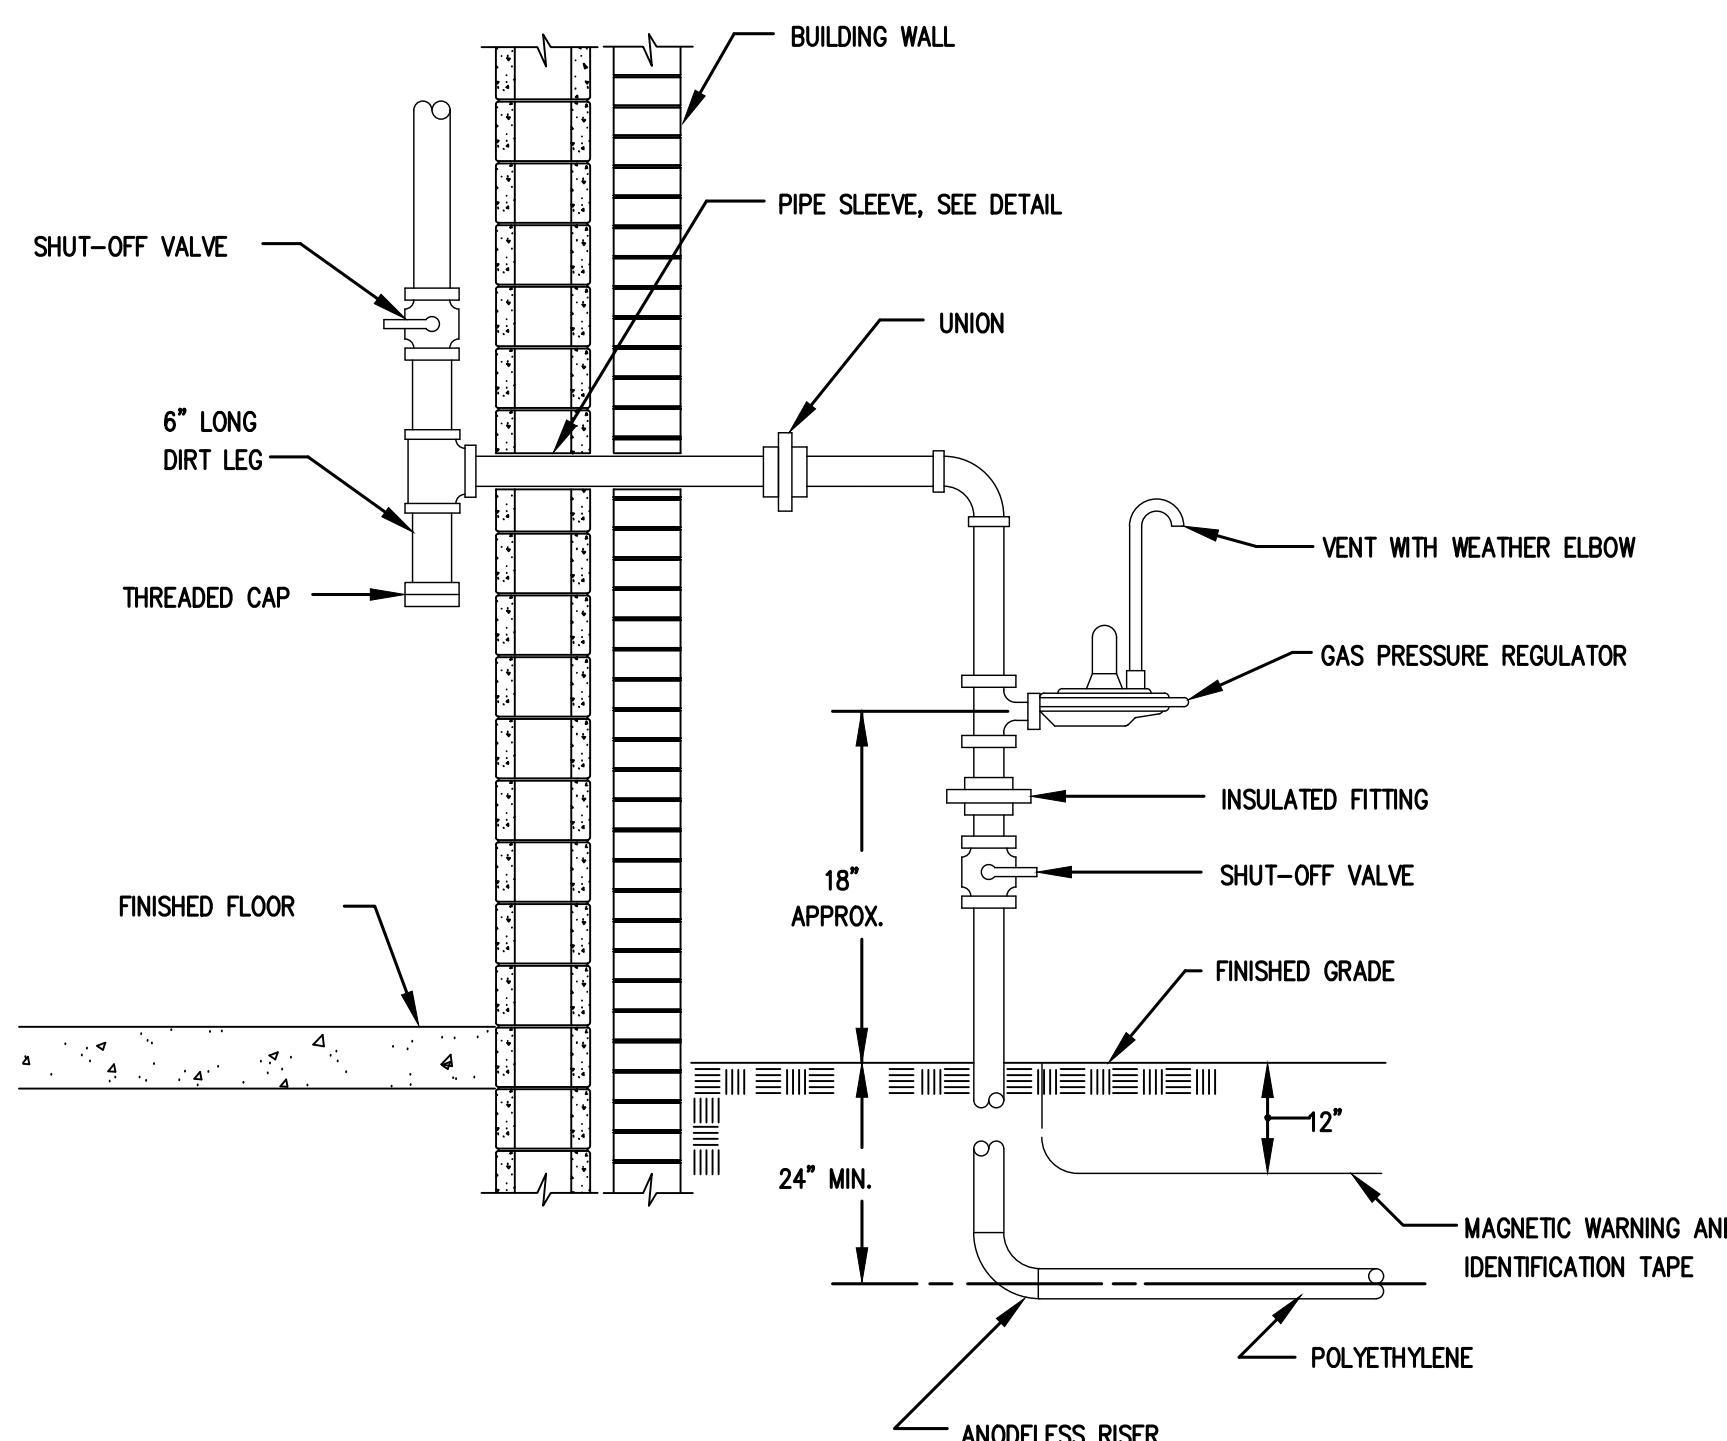


8 GAS PRESSURE REGULATOR AND PENETRATION DETAIL
SCALE: NTS

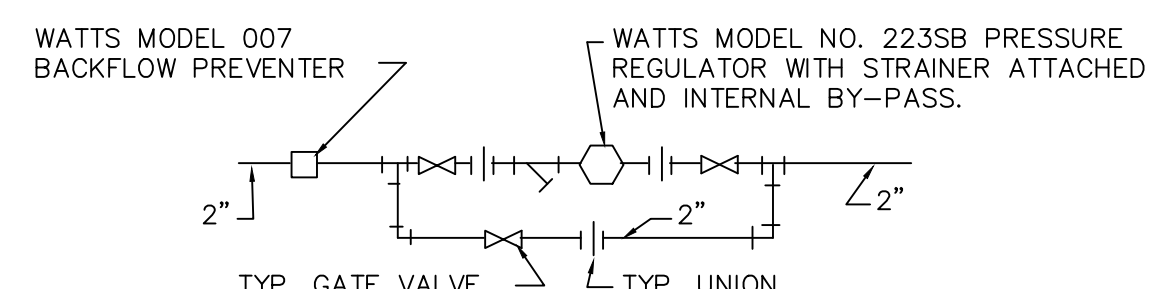


7 PRESSURE REDUCING STATION DETAIL
SCALE: NTS

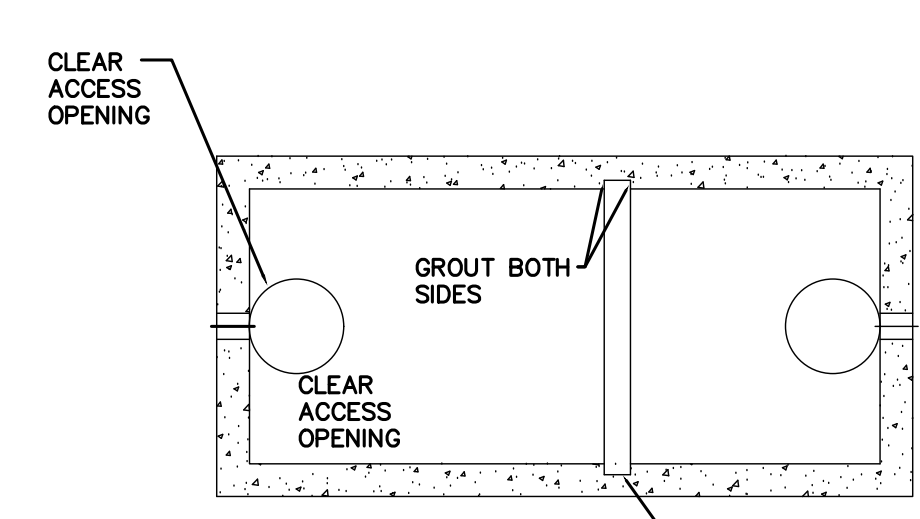

PLAN VIEW

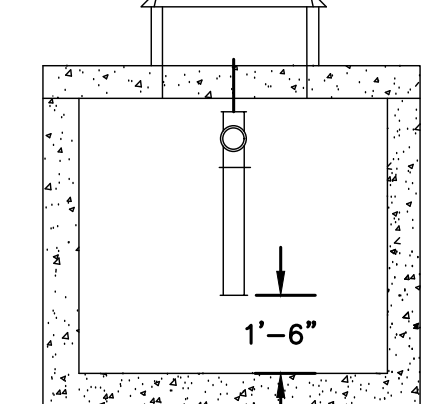


END VIEW

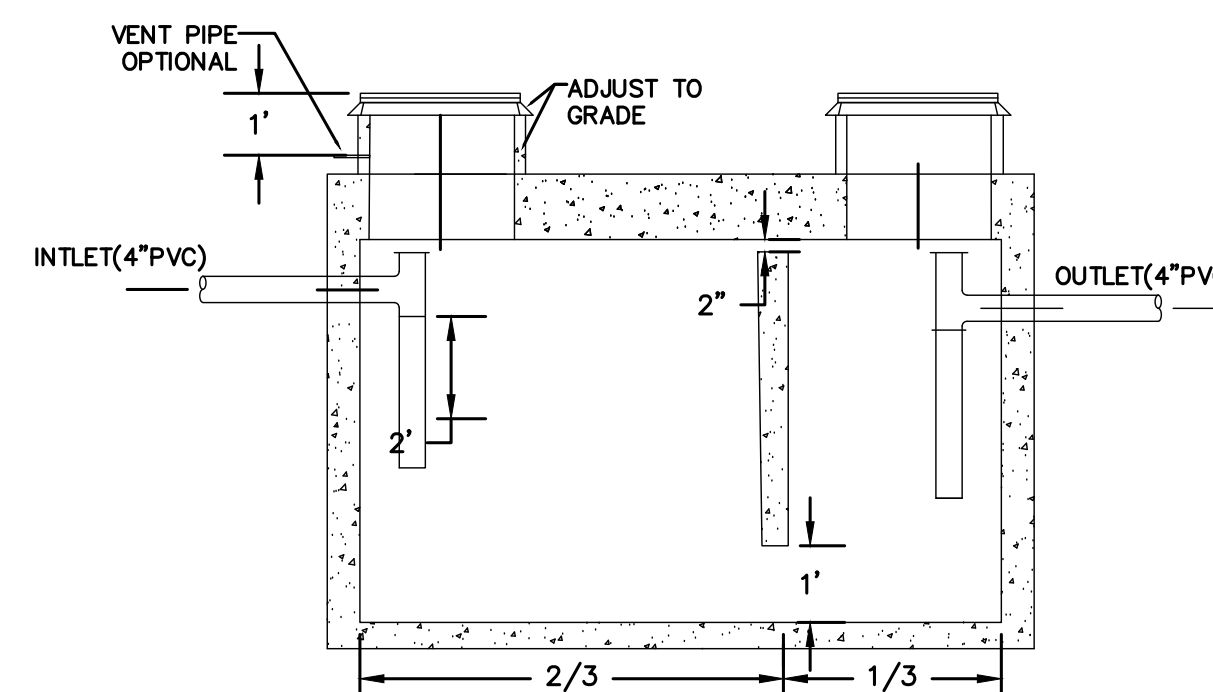


ELEVATION

ACTUAL GREASE TRAP NEEDED TO APPROVED BY LOCAL AUTHORITY


11 GREASE TRAP DETAILS
SCALE: NTS

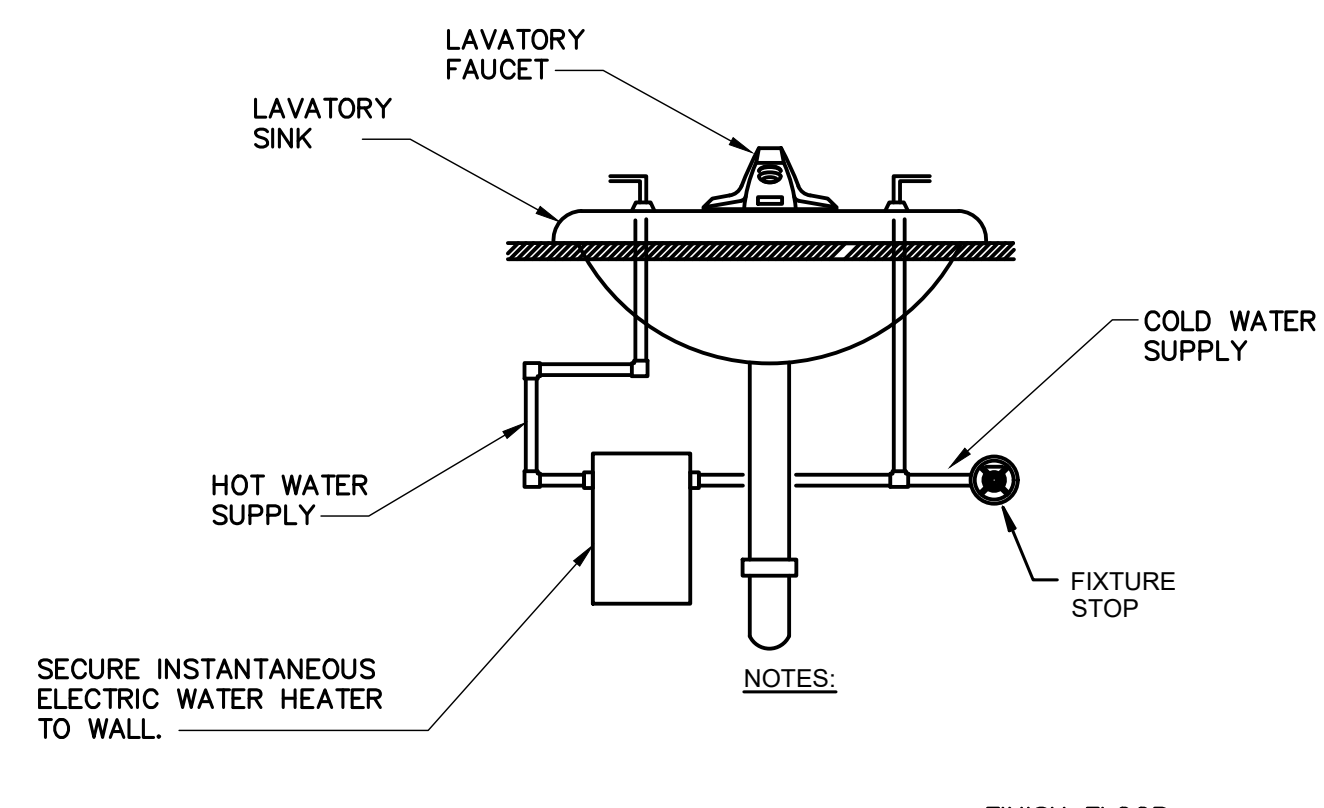

14 BELOW LAVATORY INSTANTANEOUS WATER HEATER DETAIL
SCALE: NTS

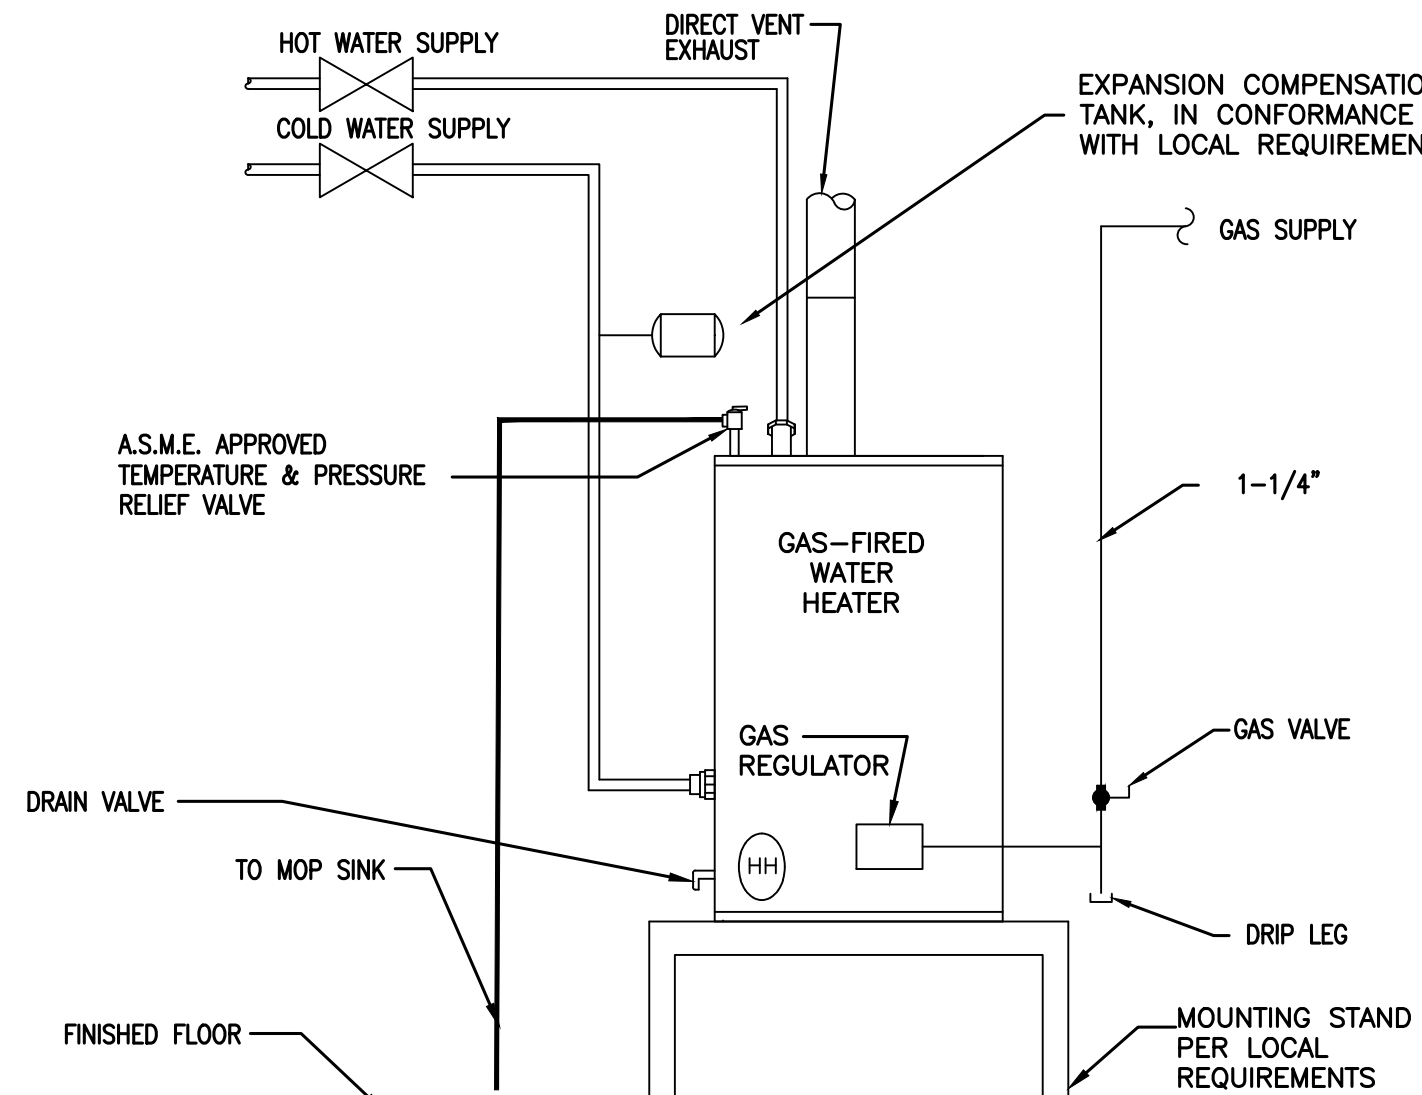

13 HOT WATER HEATER PIPING DIAGRAM
SCALE: NTS

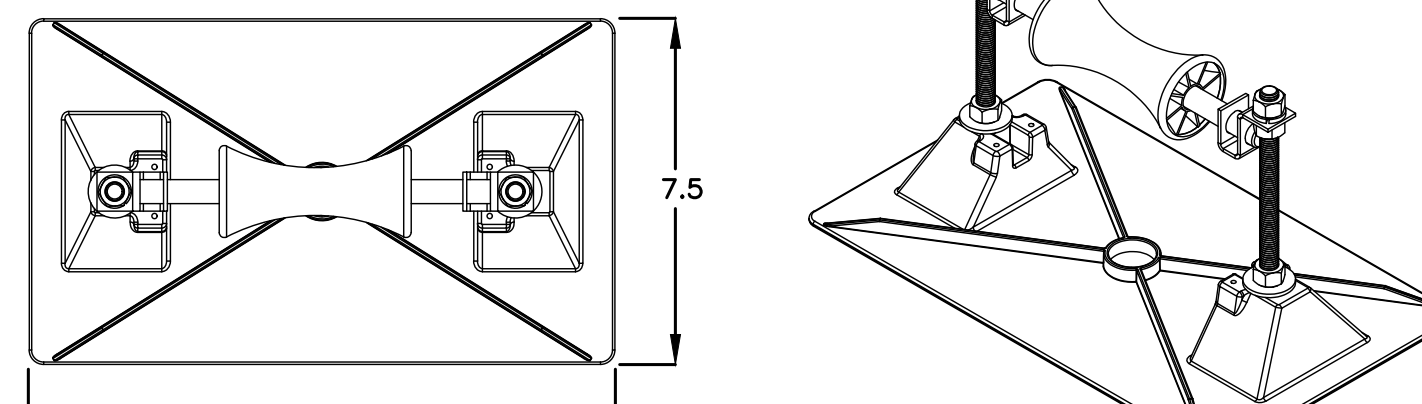

12 GAS PIPING ROOF SUPPORT
SCALE: NTS

No.	Description	Date
02	BID SET	03-14-2022
03	G.C. SHOP DRAWING COORD. 2	03-14-2022

Sheet Name: **PLUMBING DETAILS**

Proj #: 211201 Issue Date: 03-14-2022

Sheet No. **P3.2**

Drawn By: DMB Checked By: BGB